9769B # 9034

**MECKLENBURG COUNTY**
**HEALTH DEPARTMENT**

14 JUL '17 PM 3:06

**APPLICATION FOR A RESIDENTIAL SITE IMPROVEMENT PERMIT/ CONSTRUCTION AUTHORIZATION FOR AN ON-SITE WASTEWATER SYSTEM, NEW WELL INSTALLATION, OR REPAIR OF EXISTING WELL**

1. **SEPTIC / TYPE APPLICATION:** ○ N/A ○ NEW SYSTEM ○ ALTERATION ◉ REPAIR ○ MODIFIED PLOT PLAN

2. **WELL / TYPE APPLICATION:** ◉ N/A ○ NEW WELL ○ MAJOR REPAIR ○ ABANDONMENT

3. **JOB LOCATION INFORMATION:**
TAX PARCEL NUMBER: 077-272-01
STREET ADDRESS: 13520 East Rocky River Rd
CITY: Davidson
STATE: NC ZIP: 28036
SUBDIVISION NAME: N/A
LOT #: N/A LOT SIZE (acres): 3.6 acres
TOWNSHIP:
○ MECKLENBURG ○ CORNELIUS ○ HUNTERSVILLE
◉ DAVIDSON ○ CHARLOTTE ○ PINEVILLE
○ MATTHEWS ○ MINT HILL

4. **BUILDING INFORMATION:**
BUILDING TYPE:
○ SINGLE MOBILE HOME ○ MODULAR HOME
○ DOUBLE WIDE ○ MULTIPLE FAMILY
◉ HOUSE ○ OTHER
HEATED SQUARE FOOTAGE: 1,200 sq ft
NUMBER OF BEDROOMS: 2
NUMBER OF OCCUPANTS: 1
FOUNDATION TYPE:
○ CONCRETE SLAB ○ BASEMENT WITH PLUMBING
◉ CRAWL SPACE ○ BASEMENT WITH NO PLUMBING

5. **IF PLANNING TO EXPAND OR ALTER THE EXISTING SEPTIC SYSTEM PLEASE COMPLETE THE FOLLOWING SECTION:** ☑ N/A
NUMBER OF BEDROOMS TO BE ADDED: _____ NUMBER OF ADDITIONAL OCCUPANTS IN THE RESIDENCE: _____

6. **WATER SUPPLY:** ○ MUNICIPAL ◉ PRIVATE WELL ○ PUBLIC WELL ○ SHARED WELL ○ OTHER _____

7. **PROPOSED USE OF WELL:** ◉ N/A ○ IRRIGATION ○ POTABLE (DRINKING WATER) ○ OTHER _____

8. **PLEASE INDICATE AND RANK DESIRED SEPTIC SYSTEM TYPE(S) IN ORDER OF PREFERENCE** *(1-MOST DESIRED 5-LEAST DESIRED):*
☐ N/A [4] ANY TYPE [1] CONVENTIONAL [3] ACCEPTED [2] INNOVATIVE [5] ALTERNATIVE ☐ OTHER _____
8A. **RANK:** 4 1 3 2 5 ___

9. **DO ANY OF THE FOLLOWING APPLY TO THE PROPERTY IN QUESTION? IF "YES" PLEASE ATTACH SUPPORTING DOCUMENTATION.**

| | | | |
|---|---|---|---|
| BURIED CABLES, LANDFILLS, STUMPHOLES | ○ YES ◉ NO | GRADING/SOIL REMOVAL PERFORMED | ○ YES ◉ NO |
| EXISTING WASTEWATER (SEPTIC) SYSTEMS | ◉ YES ○ NO | JURISDICTIONAL WETLANDS | ○ YES ◉ NO |
| WELLS, SPRINGS, OR WATER LINES | ◉ YES ○ NO | APPROVAL REQUIRED BY ANY OTHER PUBLIC AGENCY | ○ YES ◉ NO |
| EASEMENTS OR RIGHT-OF-WAYS | ◉ YES ○ NO | WASTEWATER OTHER THAN DOMESTIC SEWAGE | ○ YES ◉ NO |
| CHEMICAL/PETROLEUM STORAGE TANKS | ○ YES ◉ NO | KNOWN UNDERGROUND CONTAMINATION | ○ YES ◉ NO |
| WASTE STORAGE | ○ YES ◉ NO | GROUNDWATER USE RESTRICTIONS/VARIANCES | ○ YES ◉ NO |

10. **WHAT DATE WAS THE PROPERTY ORIGINALLY DEEDED AND RECORDED?** _____ ☑ UNKNOWN

11. **WHAT IS THE ANTICIPATED CLOSING DATE FOR THIS PROPERTY?** _____ ☑ N/A

12. **PROPERTY OWNER:**
NAME: James F. Wyatt III / JFW Realty Inc.
ADDRESS: 435 E. Morehead St
CITY: Charlotte
STATE: NC ZIP: 28202
WORK PHONE: 704-331-0767
MOBILE PHONE: 704-576-0828
FAX: 704-331-0773
E-MAIL: jfw@wyattlaw.net

13. **OWNER'S LEGAL REPRESENTATIVE, IF APPLICABLE:**
NAME: _____
ADDRESS: _____
CITY: _____
STATE: _____ ZIP: _____
WORK PHONE: _____
MOBILE PHONE: _____
FAX: _____
E-MAIL: _____

**14. SEPTIC SYSTEM PERMIT APPLICATION:**

If the information in this application is falsified, changed, or the site is altered, then the Improvement Permit and Authorization to Construct shall become invalid. I have read this application and certify that the information provided herein is true, complete and correct. Authorized county and state officials are granted right of entry to conduct necessary inspections to determine compliance with applicable laws and rules. I understand that I am solely responsible for the proper identification and labeling of all property lines and corners and making the site accessible so that a complete site evaluation can be performed. The permit is valid for either sixty (60) months or is non-expiring depending upon the documentation submitted: complete site plan = 60 months, complete plat = non-expiring.

JBW (Initial here for septic system applications)

**15. WELL PERMIT APPLICATION:**

If the information in this application is falsified, changed, or the site is altered, then the Well Permit shall become invalid. I have read this application and certify that the information provided herein is true, complete and correct. Authorized county and state officials are granted right of entry to conduct necessary inspections to determine compliance with applicable laws and rules. I understand that I am solely responsible for the proper identification and labeling of all property lines and corners and making the site accessible so that a complete site evaluation can be performed. The permit is valid for a period of twelve (12) months from the date of issuance.

MA (Initial here for well applications)

**16. APPLICATION SIGNATURE SECTION:**

**ONLY COMPLETE APPLICATIONS WILL BE PROCESSED.** A proper signature is required in order to process your application. Please review the application carefully and sign in the space provided below. A PROPOSED PLOT PLAN is required to be submitted with each application.

James F. Wyatt IV — Property Owner's or Owner's Legal Representative Signature

7/14/17 — Date

---

*OFFICE USE ONLY*

O SURVEY PLAT TO SCALE SUBMITTED O SCALED SITE PLAN SUBMITTED O UN-SCALED SITE PLAN SUBMITTED

SEPTIC APPLICATION FEE RECEIVED: $ _____ DATE FEE RECEIVED: _____

WELL APPLICATION FEE RECEIVED: $ _____ DATE FEE RECEIVED: _____

APPLICATION PROCESSED BY: _____

GWS FILE NUMBER ASSIGNED: _____

APPLICATION ID NUMBER ASSIGNED: _____

COMMENTS:


File #: _____

## PROPOSED PLOT PLAN

A drawing showing the locations of the following items is required: existing and proposed property lines with dimensions, easements or right-of-ways, proposed building pad(s) or existing building footprint(s), all appurtenances (garage, driveway, deck, pool, etc.), location of existing or proposed well(s), location of existing or proposed sewer lines and sewage disposal systems, surface water bodies, and any aboveground or underground storage tanks. Provide names for all roads that adjoin the property.

Street Address: 13520 East Rocky River Rd  Tax Parcel #: 007-272-01

Subdivision Name: _____  Lot #: _____

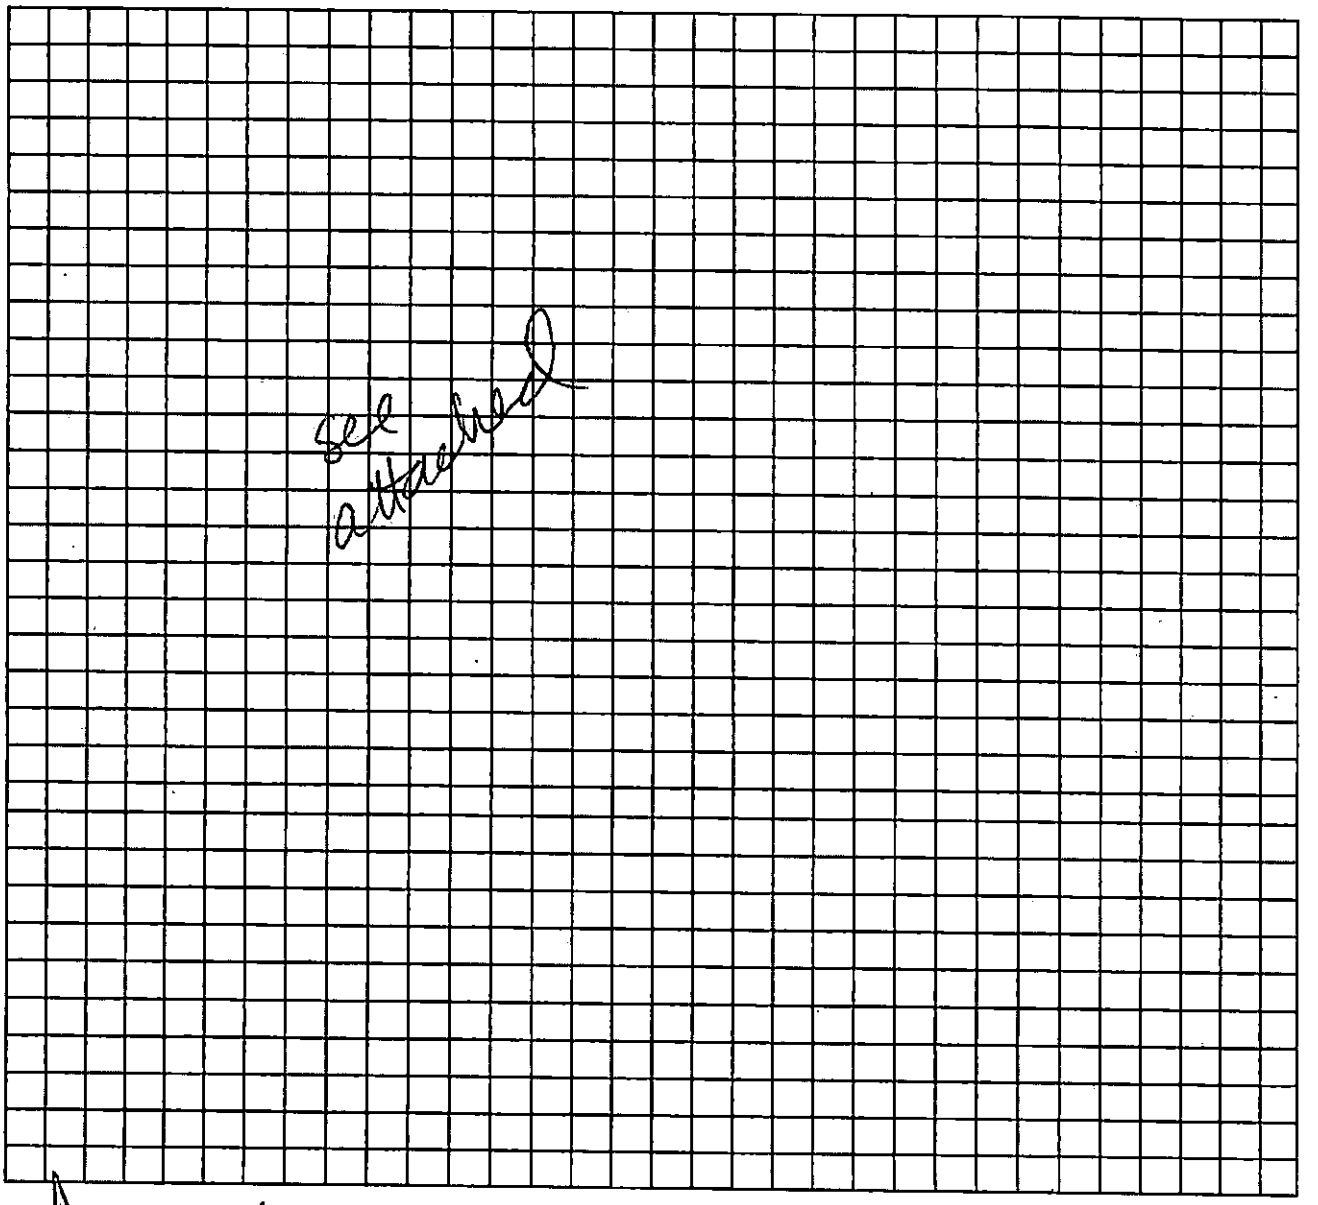


James F. Wyatt


Property Owner's or Owner's Legal Representative Signature

7/14/17
Date




MECKLENBURG COUNTY – GROUNDWATER & WASTEWATER SERVICES
700 N. TRYON ST. SUITE 211 CHARLOTTE, NC 28202, OFFICE: 980-314-1680, FAX: 704-336-6894
Email: Wellreg@MecklenburgCountyNC.gov

Revised on: 4/20/17

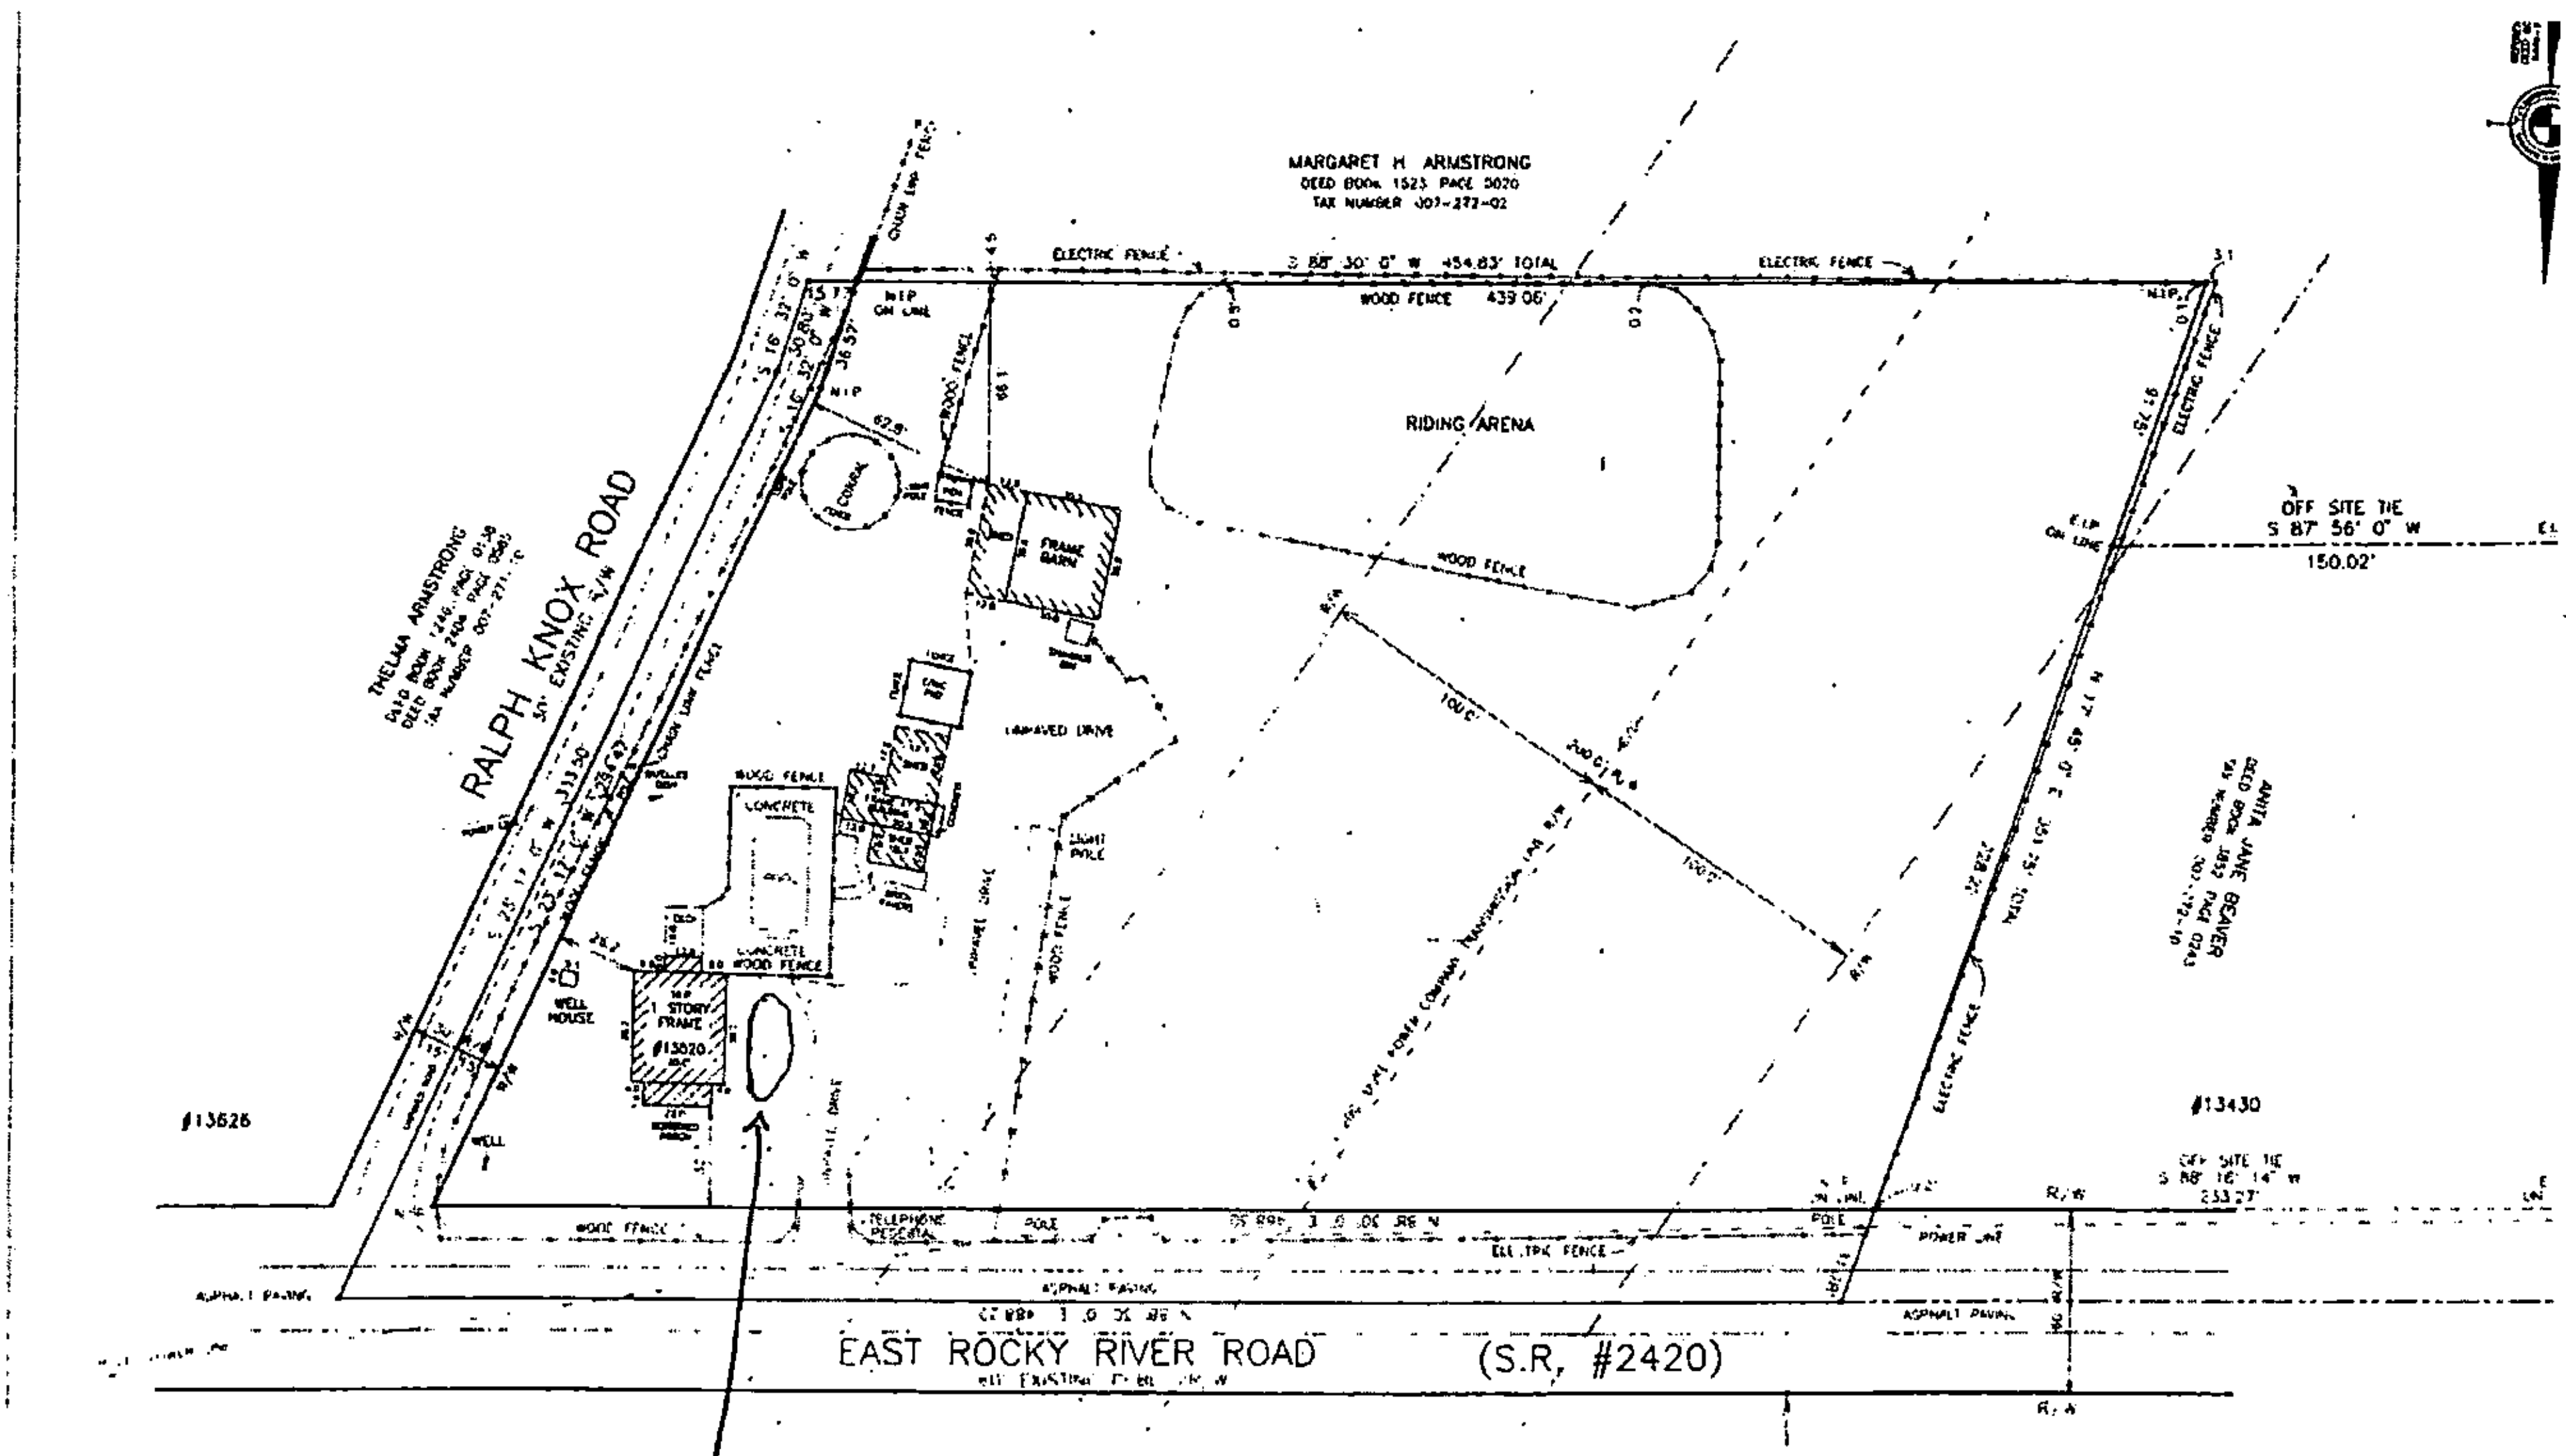


septic tank location – current septic tank is collapsing and needs replacement

136,416.14 SQ.FT. OR 3.1317 ACRES TO ROAD
19,562.36 SQ.FT. OR 0.4491 ACRE ON R/W
155,978.50 SQ.FT. OR 3.5808 ACRES TOTAL

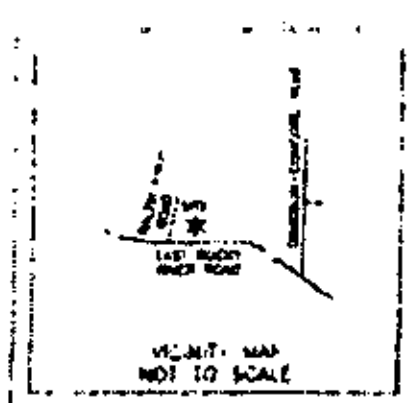


**FLOOD CERTIFICATION**

THIS IS TO CERTIFY THAT THE SUBJECT PROPERTY IS NOT LOCATED IN A SPECIAL FLOOD HAZARD AREA AS SHOWN ON MAPS PREPARED BY THE FEDERAL EMERGENCY MANAGEMENT AGENCY, FEDERAL INSURANCE ADMINISTRATION DATED FEBRUARY 1, 1993.

THIS IS TO CERTIFY THAT ON THE 5TH DAY OF MAY 19 98 AN ACTUAL SURVEY WAS MADE UNDER MY SUPERVISION OF THE PROPERTY SHOWN ON THIS PLAT AND THAT THE BOUNDARY LINES AND THE IMPROVEMENTS, IF ANY, ARE AS SHOWN HEREON. THIS PLAT MEETS THE MINIMUM STANDARDS OF PRACTICE FOR LAND SURVEYING IN NORTH CAROLINA, BOARD RULE .1600 (21 NCAC 56) AND THE ERROR OF CLOSURE FOR THIS PARCEL DOES NOT EXCEED ONE (1) FOOT PER 10,000 FEET OF PERIMETER SURVEYED NOR 20 SECONDS TIMES THE SQUARE ROOT OF THE NUMBER OF ANGLES TURNED.

SIGNED *Michael J. Lucas*

NORTH CAROLINA REGISTERED LAND SURVEYOR SEAL L-3807 MICHAEL J. LUCAS

REVISIONS

SURVEY PREPARED FOR

**JAMES F. WYATT, III**

REFERENCE: DEED BOOK 9852, PAGE 243
DEWEESE TOWNSHIP, MECKLENBURG COUNTY, N.C.

TAX NUMBER 007-272-01

R.B. PHARR & ASSOCIATES, P.A.
SURVEYING & MAPPING
19801 S. MAIN STREET CORNELIUS, N.C. 28031

| CREW | DRAWN | REVISED | SCALE | DATE | FILE NO. |
|---|---|---|---|---|---|
| C | Tr | | 1" = 40' | MAY 5TH, 1998 | UN – |

Mecklenburg County Groundwater & Wastewater Services
700 N. Tryon St., Suite 211 Charlotte, NC 28202
Phone: (980) 314-1680 Fax: (704) 336-6894

NC DHHS
Division of Environmental Health
On-Site Wastewater Section

# IMPROVEMENT PERMIT/CONSTRUCTION AUTHORIZATION for an ON-SITE WASTEWATER TREATMENT & DISPOSAL SYSTEM

File #: 9769 B  Permit #: 30009034  Tax Parcel #: 077-272-01

Property Owner: JFW Realty Inc.

Job Location Address: 13520 E Rocky River Rd

City: Davidson  State: NC  Zip Code: 28036

**Improvement Permit Issuance Date:** _____  **Construction Authorization Issuance Date** 7/24/17

Permission is hereby given to ☐ install ☐ alter ☒ repair an on-site wastewater treatment & and disposal system, with subsurface soil absorption and effluent discharge, as specified herein at the described location. This permit is granted based upon the application information submitted to our office. This permit expires 5 years from the date it was issued. The system shall meet all of the construction requirements of 15A NCAC 18A. 1900 which are in effect on the date of granting this approval. An **Operation Permit** must be obtained from the Mecklenburg County Health Department before any system can be covered up or placed into service. The issuance of this permit does not in any way guarantee that the system anticipated to be constructed will operate properly, or relieve any person now of hereafter owning, controlling or using such system from any liability resulting from the failure of the system to operate properly.

***NOTICE: This system shall not be installed while soils are in a wet condition.**

Permitted Design Flow: 240 GPD  Site LTAR: n/a GPD/ft² (For new installations only.)

Liquid Capacity of Septic Tank: existing gallons  Liquid Capacity of Dosing Tank: n/a gallons

Drainfield Design ☒ N/A

Trench Depth: _____ inches

Trench Width: _____ feet

Line Spacing: _____ feet (O.C.)

Total line length: _____ feet

# of Lines: _____ @ _____ feet

Depth of Media: _____ inches (Type) _____

Distribution Device: _____

Bed Design *(For Repair Installations ONLY.)* ☒ N/A

Bed Depth: _____ inches

Bed Width: _____ feet

Total line length: _____ feet

# of Lines: _____ @ _____ feet

Depth of Media: _____ inches (Type) _____

Distribution Device: _____

Water Supply Source

☐ Municipal ☒ Private Well ☐ Community Well

☐ Other _____


Minimum System Setbacks

Distance from Building Foundation: >5 feet

Distance from Property Line: >10 feet

Distance from Water Supply Source: >50 feet

SKETCH OF SYSTEM LAYOUT
(Proposed Layout)

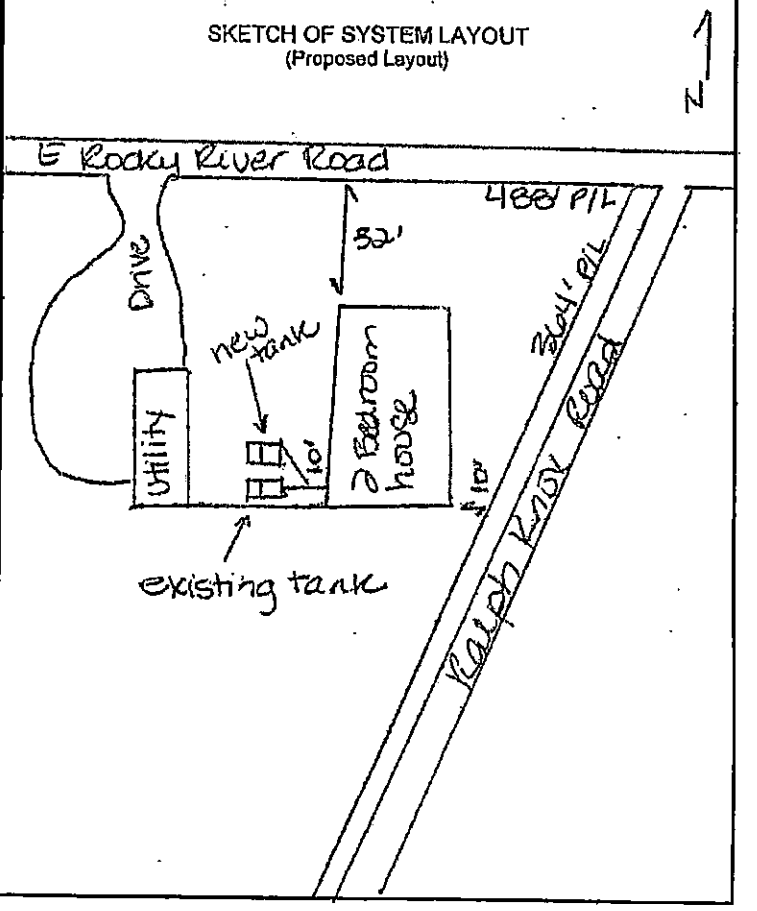


Comments: System Classification & Type: Repair - install new 1000g tank, pump, crush & fill in existing tank

Authorized Agent: Kim Garrett, REHS  Signature: Kim Garrett, REHS

Owner Signature: James E. Wyatt III  Date: 7/28/17

Pres. Stan Realty Inc

Mecklenburg County Groundwater & Wastewater Services
700 N. Tryon St., Suite 211 Charlotte, NC 28202
Phone: (980) 314-1680 Fax: (704) 336-6894

NC DHHS
Division of Environmental Health
On-Site Wastewater Section

# IMPROVEMENT PERMIT/CONSTRUCTION AUTHORIZATION for an ON-SITE WASTEWATER TREATMENT & DISPOSAL SYSTEM

File #: 9769 B Permit #: 30009034 Tax Parcel #: 077-272-01

Property Owner: JFW Realty Inc

Job Location Address: 13520 E Rocky River Rd

City: Davidson State: NC Zip Code: 28036

**Improvement Permit Issuance Date:** _____ **Construction Authorization Issuance Date** 7/24/17

Permission is hereby given to ☐ install ☐ alter ☒ repair an on-site wastewater treatment & and disposal system, with subsurface soil absorption and effluent discharge, as specified herein at the described location. This permit is granted based upon the application information submitted to our office. This permit expires 5 years from the date it was issued. The system shall meet all of the construction requirements of 15A NCAC 18A. 1900 which are in effect on the date of granting this approval. An **Operation Permit** must be obtained from the Mecklenburg County Health Department before any system can be covered up or placed into service. The issuance of this permit does not in any way guarantee that the system anticipated to be constructed will operate properly, or relieve any person now of hereafter owning, controlling or using such system from any liability resulting from the failure of the system to operate properly.

***NOTICE: This system shall not be installed while soils are in a wet condition.**

Permitted Design Flow: 240 GPD

Liquid Capacity of Septic Tank: existing gallons

Site LTAR: n/a GPD/ft² (For new installations only.)

Liquid Capacity of Dosing Tank: n/a gallons

Drainfield Design ☒ N/A

Trench Depth: _____ inches

Trench Width: _____ feet

Line Spacing: _____ feet (O.C.)

Total line length: _____ feet

# of Lines: _____ @ _____ feet

Depth of Media: _____ inches (Type) _____

Distribution Device: _____

Bed Design *(For Repair Installations ONLY.)* ☒ N/A

Bed Depth: _____ inches

Bed Width: _____ feet

Total line length: _____ feet

# of Lines: _____ @ _____ feet

Depth of Media: _____ inches (Type) _____

Distribution Device: _____

Water Supply Source

☐ Municipal ☒ Private Well ☐ Community Well

☐ Other _____


Minimum System Setbacks

Distance from Building Foundation: >5 feet

Distance from Property Line: >10 feet

Distance from Water Supply Source: >50 feet

SKETCH OF SYSTEM LAYOUT
(Proposed Layout)

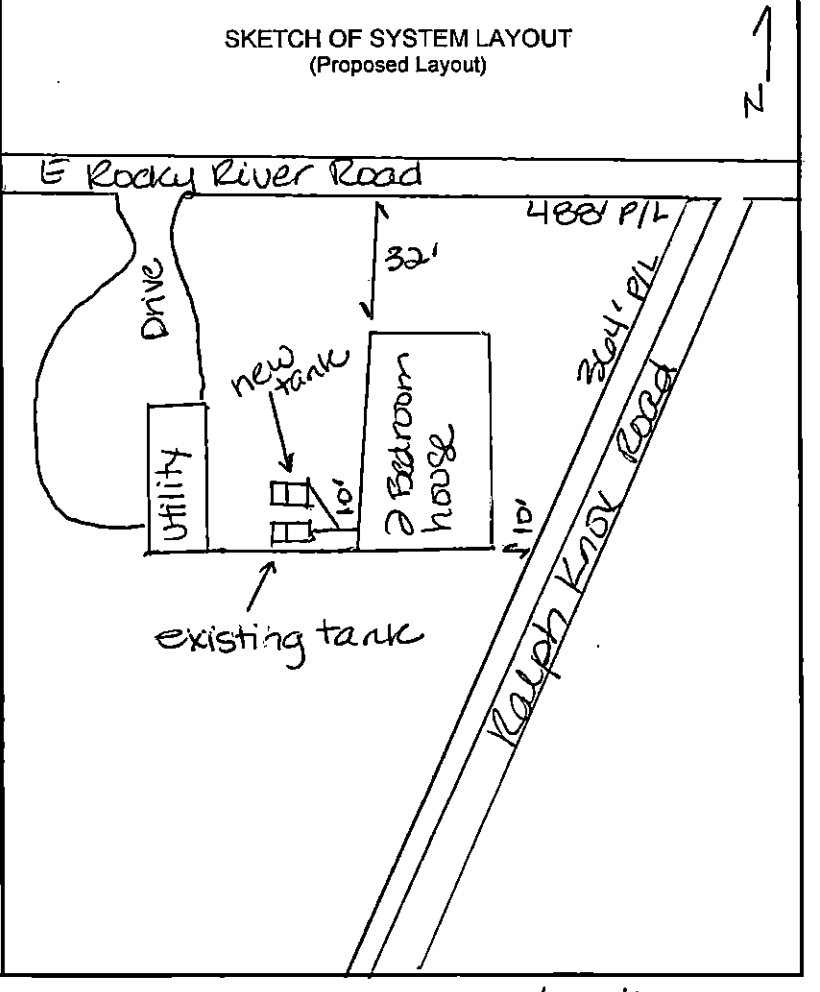


Comments: System Classification & Type: Repair - install new 1000g tank, pump, crush & fill in existing tank

Authorized Agent: Kim Garrett, REHS Signature: Kim Garrett, REHS

Owner Signature: _____ Date: _____

**Ginny Wooten**

**From:** James Wyatt
**Sent:** Monday, July 24, 2017 4:05 PM
**To:** Ginny Wooten
**Subject:** Fwd: repair permit
**Attachments:** 13520 E Rocky River Rd.pdf; ATT00001.htm

Print all

James

Begin forwarded message:

> **From:** "Garrett, Kimberly" <Kimberly.Garrett@mecklenburgcountync.gov>
> **To:** "James Wyatt" <JWyatt@wyattlaw.net>
> **Subject: repair permit**
>
> Jeff,
>
> Please find attached the repair permit to replace the septic tank. Please sign the permit and return a copy to me for our files. Once you have signed the permit it is considered valid and you can forward a copy to the septic contractor so the work can be scheduled. We will need to make a site visit when the tank is being replaced so please forward my contact information to your septic contractor. Thank you.
>
> Sincerely,
> Kim
>
> Kim Garrett, REHS
> Environmental Specialist
> Environmental Health Program
> Mecklenburg County Public Health
> 980-721-2054 (cell)
> *kimberly.garrett@mecklenburgcountync.gov*

***CONFIDENTIALITY NOTICE:*** *This message and any attachments included are from the Mecklenburg County Health Department and are for sole use by the intended recipient(s). The information contained herein may include confidential or privileged information. Unauthorized review, forwarding, printing, copying, distributing, or using such information is strictly prohibited and may be unlawful. If you received this message in error, or have reason to believe you are not authorized to receive it, please contact the sender by reply email and destroy all copies of the original message. Thank you!*

Mecklenburg County Groundwater & Wastewater Services
700 N. Tryon St., Suite 211 Charlotte, NC 28202
Phone: (980) 314-1680 Fax: (704) 336-6894

# Septic System Pre-Construction Meeting Checklist

File # 9769B App # 9084 Tax Parcel # 077-272-01

Property Owner: JFW Realty, Inc.

Job Location Address: 18520 E. Rocky River Road

City: Davidson State: NC Zip Code: 28036

1. **Does System design match facility, flow & wastewater characteristics?**

   ☒ YES ☐ NO

   Comments: _____

2. **Is there sufficient available space for the septic systems initial and repair areas?**

   ☒ YES ☐ NO

   Comments: _____

3. **Can the septic system be installed per the permit conditions and drawing on file?**

   ☒ YES ☐ NO

   Comments: _____

* If "NO" is checked for any of the above the existing permit may need to be revoked.

**Permission is hereby given to ☐ install ☐ alter ☐ repair an on-site wastewater treatment & and disposal system, with subsurface soil absorption and effluent discharge meeting all of the construction requirements of 15A NCAC 18A .1900 which are in effect on the date of granting this approval. System shall not be installed while soils are in wet condition.**

Authorized Agent — Date: 8/15/17

Others Present: DARRIN LENTZ

Mecklenburg County Groundwater & Wastewater Services
700 N. Tryon St., Suite 211 Charlotte, NC 28202
Phone: (980) 314-1680 Fax: (704) 336-6894

NC DHHS
Division of Environmental Health
On-Site Wastewater Section

# OPERATION PERMIT for an ON-SITE WASTEWATER TREATMENT & DISPOSAL SYSTEM

File #: 97698 Permit #: 9034 Tax Parcel #: 077-272-01

Property Owner: JFW Realty Inc.

Job Location Address: 13520 E. Rocky River Road

City: Davidson State: NC Zip Code: 28036

**Operation Permit Issuance Date:** 8/15/17 Contractor Name: LENTZ WASTEWATER

Permitted Design Flow: 240 GPD Liquid Capacity of Dosing Tank: — gallons

Liquid Capacity of Septic Tank: 1000 gallons Manufacture SHOAF Effluent Pump Model: —

Drainfield Installation ☒ N/A

Trench Depth: _____ inches

Trench Width: _____ feet

Line Spacing: _____ feet (O.C.)

Total line length: _____ feet

# of Lines: _____ @ _____ feet

Depth of Media: _____ inches (Type) _____

Depth of Cover: _____ inches

Distribution Device: _____

Bed Installation *(For Repair Installations ONLY.)* ☒ N/A

Bed Depth: _____ inches

Bed Width: _____ feet

Total line length: _____ feet

# of Lines: _____ @ _____ feet

Depth of Media: _____ inches (Type) _____

Depth of Cover: _____ inches

Distribution Device: _____

Water Supply Source

☐ Municipal ☒ Private Well ☐ Community Well

☐ Other _____

System Installation Setbacks

Distance from Building Foundation: 7' feet

Distance from Property Line: >10' feet

Distance from Water Supply Source: >50' feet


Inspection Dates

Tank(s) Inspected: 8/15/17

Excavation Inspected: —

Pump & Controls Inspected: —

SKETCH OF SYSTEM INSTALLATION
(As-Built Drawing)

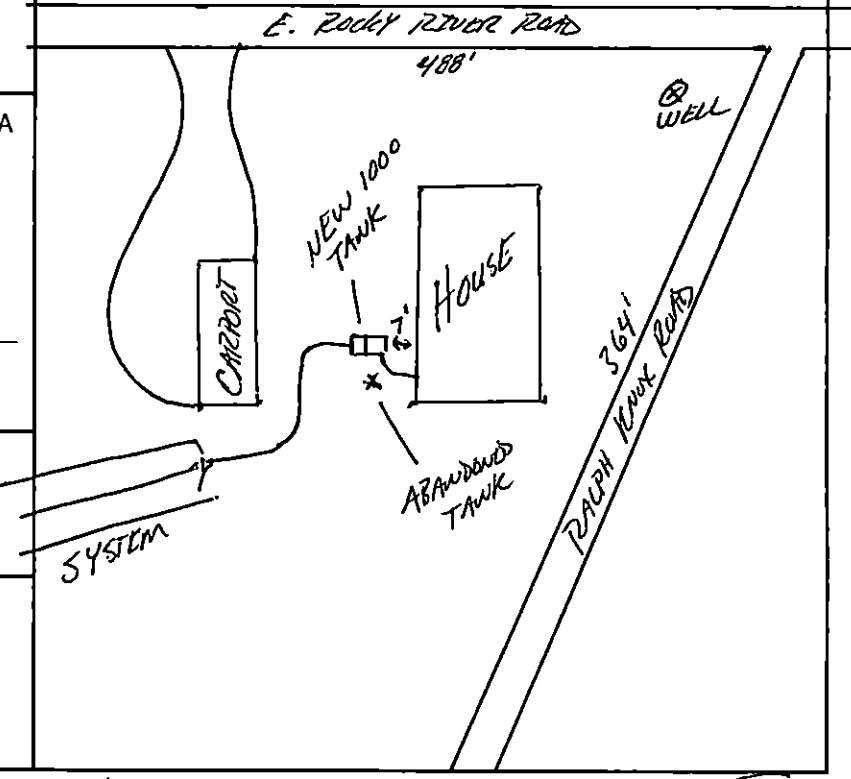


The undersigned has inspected the Septic Tank System described above, and certifies it has been ☐ installed ☐ altered ☒ repaired ☒ as detailed in the plot above ☐ in accordance with the permit issued and meets the provisions of 15A NCAC 18A. 1900, "Laws and Rules for Sewage Treatment and Disposal Systems" in effect on the date of issuance of the permit. The issuance of this Operation Permit does not in any way guarantee that the system will operate properly or relieve any person now or hereafter owning, controlling, or using such system from any liability resulting from the failure of the system to operate properly. This document is issued subject to those restrictions and conditions shown on the permit(s) and the provisions of 15A NCAC 18A. 1900 in addition to those listed below under "Comments." This document shall be null and void if any information contained in the application is untrue or if any additions are made to the property which would increase the requirements for said system.

**Notice: Disturbance of the designated repair area may result in the Suspension or Revocation of this permit.**

Comments: System Classification & Type: IIa, GTR, GRAVITY, NA, NA

NEW 1000 SEPTIC TANK Replaced

DHHS Authorized Agent: Jeremy Michelsen REHS Signature: Jeremy Michelsen, REHS

Mecklenburg County Groundwater & Wastewater Services
700 N. Tryon St., Suite 211 Charlotte, NC 28202
Phone: (980) 314-1680 Fax: (704) 336-6894

NC DENR
Division of Environmental Health
On-Site Wastewater Section

**OPERATION PERMIT for an**
**ON-SITE WASTEWATER TREATMENT & DISPOSAL SYSTEM**

File #: 97698 Permit #: 9034 Tax Parcel #: 077-272-01

Property Owner: SFW Realty, INC.

Job Location Address: 13520 E. Rocky River Road

City: Davidson State: NC Zip Code: 28036

**OPERATION PERMIT CONDITIONS:**

I. Performance: System shall perform in accordance with 15A NCAC 18A .1961.

II. Monitoring: System shall be monitored as required by 15A NCAC 18A .1961.

III. Maintenance: Ground absorption sewage treatment and disposal systems shall be checked, and the contents of the septic tank removed, periodically from all compartments, to ensure proper operation of the system. The contents shall be pumped whenever the solids level is found to be more than 1/3 of the liquid depth in any compartment.

IV. Operation: System shall be operated in accordance with 15A NCAC 18A .1961.

System Classification: IIa

*Operation Permits for Type V and VI systems expire five (5) years from the date of issuance (in accordance with Table V(a)). The system owner must contact GWS six (6) months prior to expiration for permit renewal.

Subsurface system operator required: Yes ☐ No ☒

☐ This type of system requires the system owner to maintain a contract with a certified operator to perform system inspection, maintenance, and reporting as required in 15A NCAC 18A .1961. and Table V(a). The system owner is responsible for all fees associated with these services.

☒ System does not require inspection by GWS on a routine frequency.

☐ System requires inspection by GWS once every five (5) years. The system owner is responsible for all fees associated with the inspection.

☐ System requires inspection by GWS once every three (3) years. The system owner is responsible for all fees associated with the inspection.

☐ System requires inspection by GWS once every twelve (12) months. The system owner is responsible for all fees associated with the inspection.

☐ System requires inspection by GWS once every six (6) months. The system owner is responsible for all fees associated with the inspection.

V. Other: 2017 New Tank Replaced (1000)

DENR Authorized Agent: Jeremy Mickler, REHS Date: 8/15/17

Signature: Jeremy Mickler REHS