
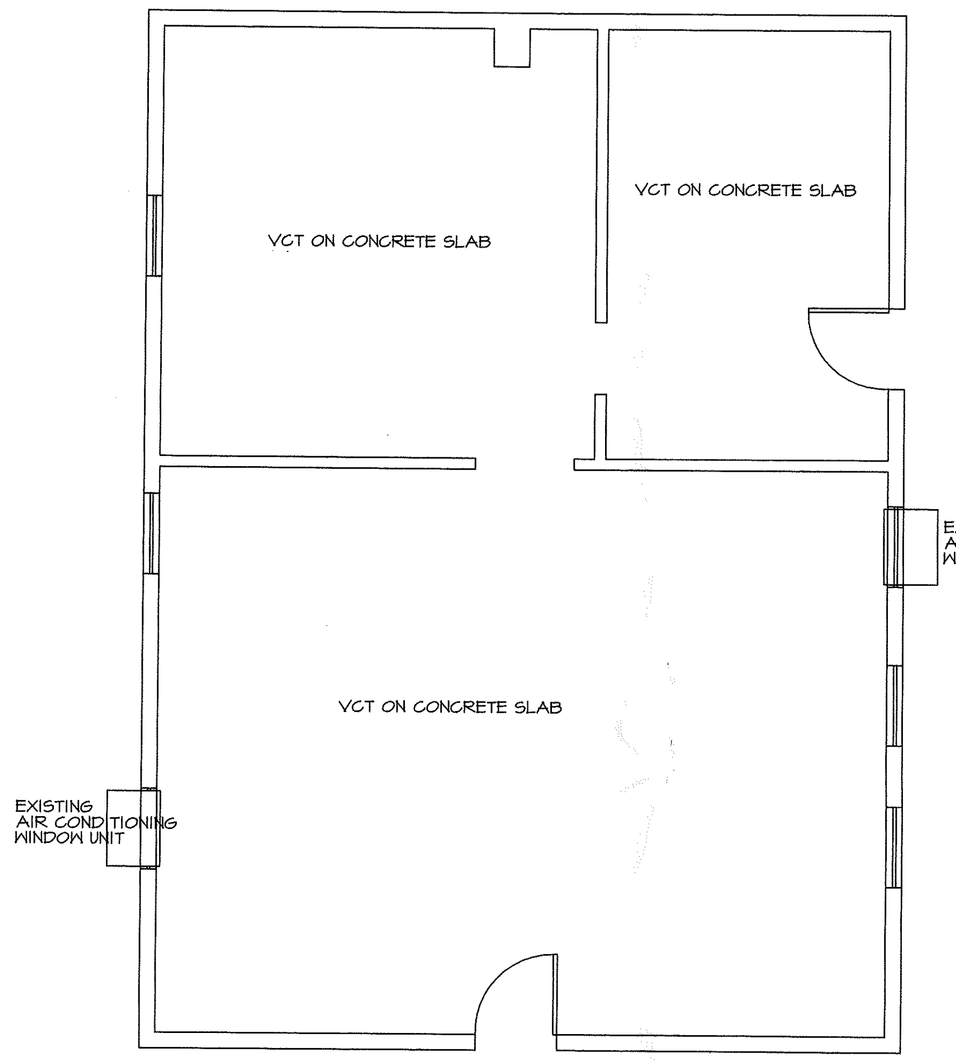


1 A2.1 EXISTING FLOOR PLAN
1/4" = 1'-0" EXPLAN

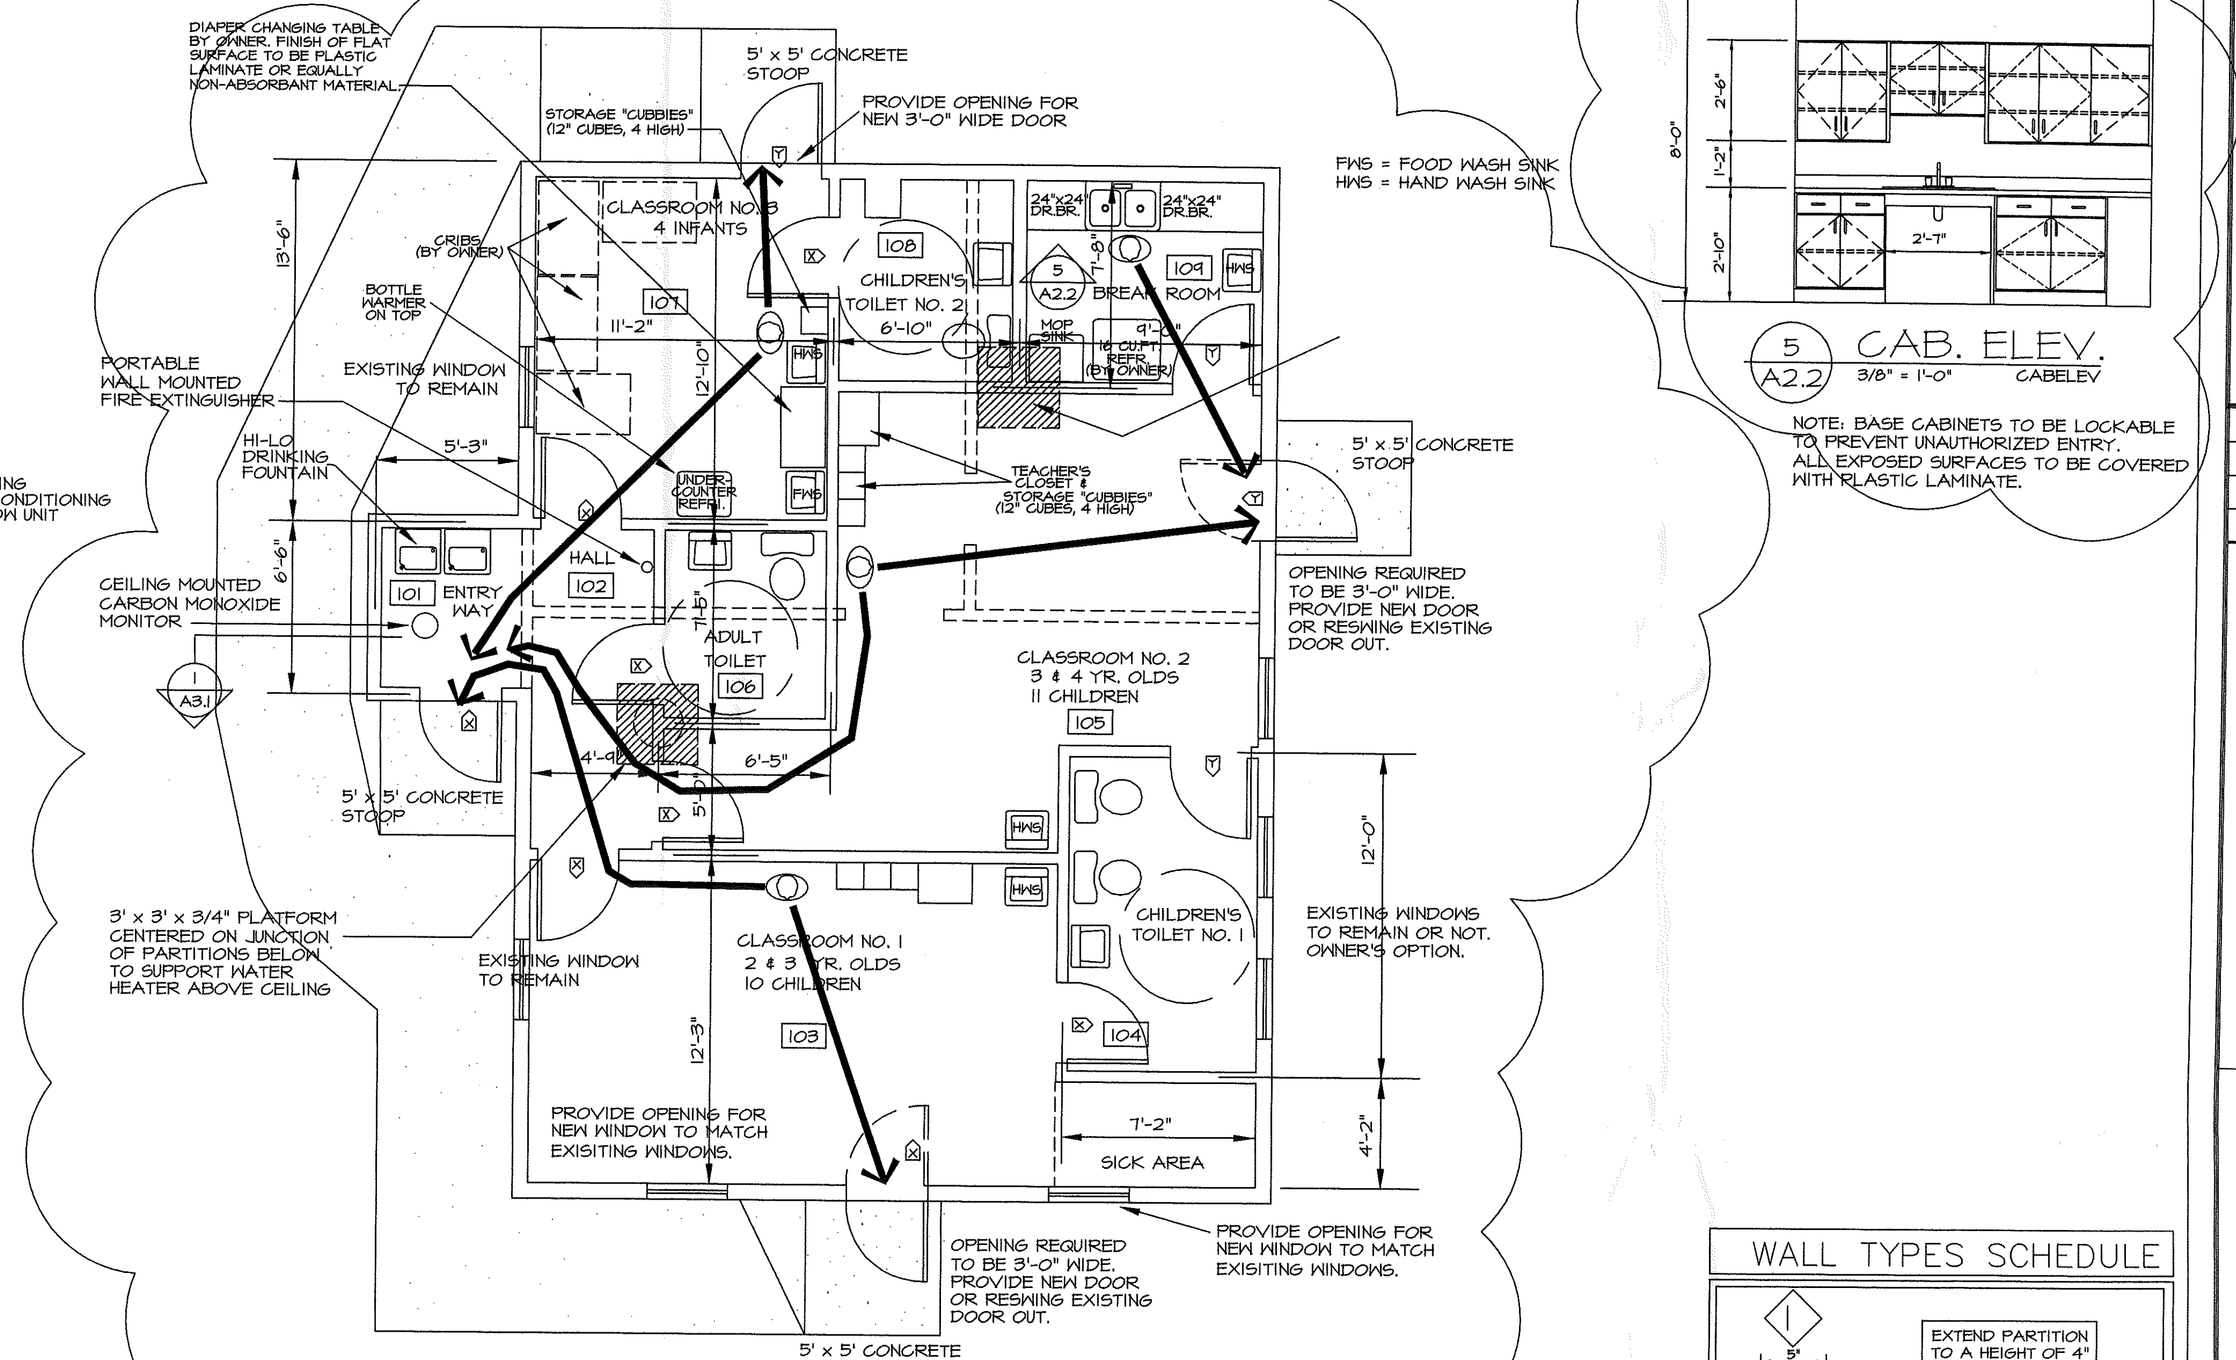


2 A2.2 FLOOR PLAN & LIFE SAFETY PLAN
1/4" = 1'-0" NEWPLANS

NOTE TO CONTRACTOR: PROVIDE FILL AT EACH NEW EXIT TO SUPPORT NEW 5'x 5' CONCRETE STOOP WITH SLOPE FROM BUILDING AT NO MORE THAN 1/4" PER FOOT FOR DRAINAGE. STOOPS TO BE LEVEL WITH FLOOR TO ALLOW HANDICAPPED EXITING.


FWS = FOOD WASH SINK
HWS = HAND WASH SINK

5 A2.2 CAB. ELEV.
3/8" = 1'-0" CABELEV

NOTE: BASE CABINETS TO BE LOCKABLE TO PREVENT UNAUTHORIZED ENTRY. ALL EXPOSED SURFACES TO BE COVERED WITH PLASTIC LAMINATE.

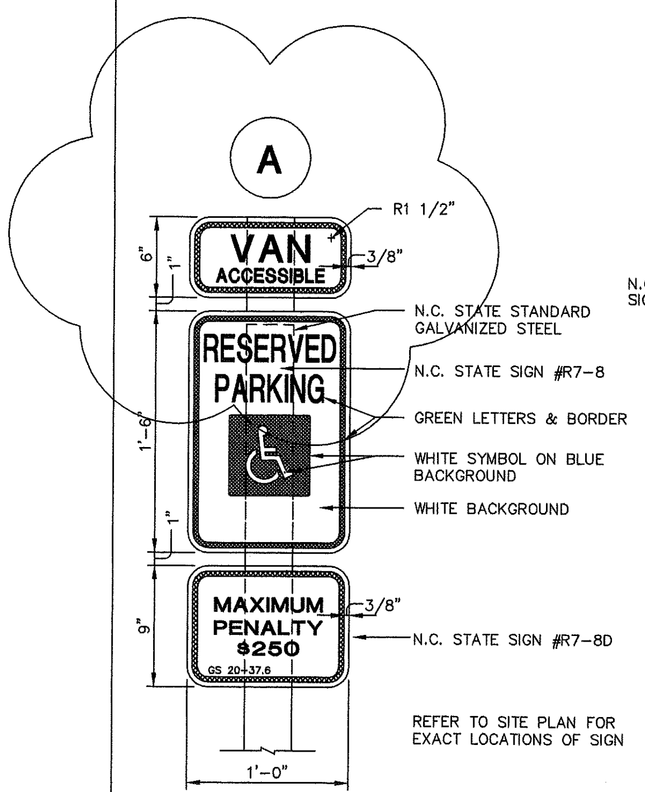


3 A2.2 HANDICAP SIGNS
1 1/2" = 1'-0" HCSIGNVAN

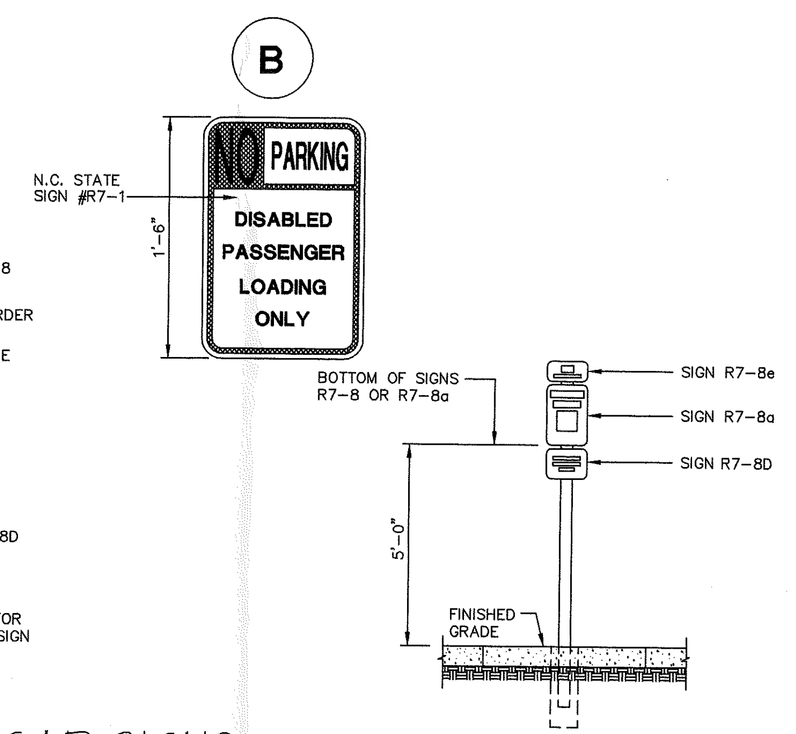

4 A2.2 H.C.SIGN & POST
3/8" = 1'-0" HCSIGN03

WALL TYPES SCHEDULE

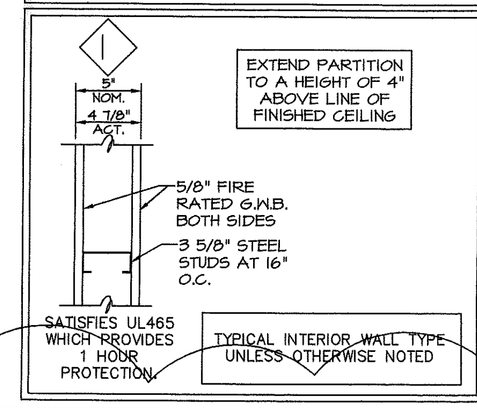

FINISH SCHEDULE

NO.	ROOM NAME	FLOOR							BASE				WALLS								CEILING								HT.	REMARKS
		VINYL COMPOSITION TILE	CERAMIC TILE	CARPET	CONCRETE W/SEALER	CONCRETE W/SPEC. FIN.	BAMBOO	QUARRY TILE	VINYL	CERAMIC	QUARRY TILE	NONE	GYP. BD.(PAINTED & WASHABLE)	VINYL WALL FABRIC	C.M.U.(PAINTED)	CONCRETE(PAINTED)	EXP. STRUCTURE				LAY-IN-TILE	GYPSUM BD.(PAINTED)	EXP. STRUCTURE(PAINTED)	EXP. STRUCTURE						
101	ENTRY WAY	●	○	○	○	○	○	○	●	○	○	○	●	○	○	○	○	○	○	○	●	○	○	○	○	○	○	○	8'-0"	
102	HALL	●	○	○	○	○	○	○	●	○	○	○	●	○	○	○	○	○	○	○	●	○	○	○	○	○	○	○	8'-0"	
103	CLASSROOM NO. 1	●	○	○	○	○	○	○	●	○	○	○	●	○	○	○	○	○	○	○	●	○	○	○	○	○	○	○	8'-0"	
104	CHILDRENS TOILET NO. 1	●	○	○	○	○	○	○	●	○	○	○	●	○	○	○	○	○	○	○	●	○	○	○	○	○	○	○	8'-0"	
105	CLASSROOM NO. 2	●	○	○	○	○	○	○	●	○	○	○	●	○	○	○	○	○	○	○	●	○	○	○	○	○	○	○	8'-0"	
106	ADULT TOILET	●	○	○	○	○	○	○	●	○	○	○	●	○	○	○	○	○	○	○	●	○	○	○	○	○	○	○	8'-0"	
107	CLASSROOM NO. 3	●	○	○	○	○	○	○	●	○	○	○	●	○	○	○	○	○	○	○	●	○	○	○	○	○	○	○	8'-0"	
108	CHILDRENS TOILET NO. 2	●	○	○	○	○	○	○	●	○	○	○	●	○	○	○	○	○	○	○	●	○	○	○	○	○	○	○	8'-0"	
109	BREAK ROOM	●	○	○	○	○	○	○	●	○	○	○	●	○	○	○	○	○	○	○	●	○	○	○	○	○	○	○	8'-0"	

CLARY ARCHITECTS, INC.
4130 PARK ROAD - SUITE C
CHARLOTTE, NORTH CAROLINA
28209
(704) 527-5123
info@claryarchitects.com

PHASE —
DRAWN BY —
CHECKED BY —
APPROVED BY —

RENOVATION OF EXISTING BUILDING FOR
GOOD NEWS HOUSE
13123 ALEXANDERANA ROAD
HUNTERSVILLE, NORTH CAROLINA

FLOOR PLANS

REVISIONS

NO.	DATE	
1	OCTOBER 31, 2008	INCORPORATED REVIEW COMMENTS

JOB NO. 5044.020
FILE NO.
DATE
PLATE NO.
SHEET NO. A2.2 OF 3

© COPYRIGHT 2008 CA