Date Received 9/18/79

RECEIVED
SEP 18 1979

APT No. 16174

T. C. No. 217-041-12

Map Date

MECKLENBURG COUNTY
DEPARTMENT OF ENVIRONMENTAL HEALTH

APPLICATION FOR SOIL INVESTIGATION

1) NAME OF OWNER Thomas (LAST) C. (FIRST) L. (MIDDLE)

2) ADDRESS OF OWNER Rt 4 Box 122 Fort Mill, SC ZIP 29715

3) PHONE NO. Home 803-548-3051 Office 704-392-7345


4) LOCATION OF PROPERTY Thomas Road (STREET OR COUNTY ROAD)

5) SUBDIVISION _____ LOT NO _____ BLOCK NO. _____

MAP BOOK NO 217 PAGE NO 04

6) DEED REFERENCE DEED BOOK 2883 PAGE NO 183

Application is hereby made to the Mecklenburg County Department of Environmental Health for the conduct of a soil investigation and an on site inspection of the lot hereinabove described for the purpose of determining if the lot is suitable for the installation of an individual septic tank wastewater treatment system with subsurface, soil absorption, effluent discharge

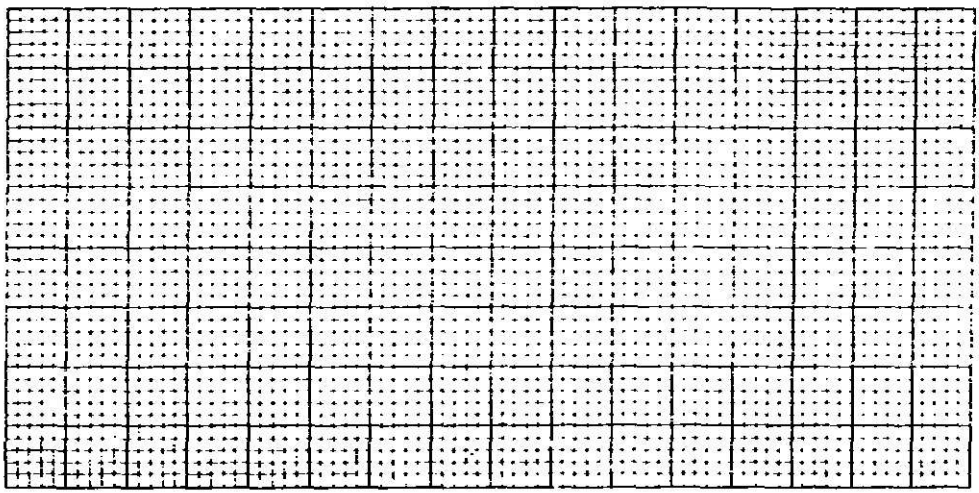

7) ACCURATELY DIAGRAM & DIMENSION LOT

SEND COPY TO:
W. D. THOMPSON
6740 MARLBROOK DRIVE
CHARLOTTE, N.C. 28212

C. L. Thomas
OWNER

EHO-5-76

Environmental Health Department's Copy

S. I. R. NO. 16174

NORTH CAROLINA
DEPARTMENT OF HUMAN RESOURCES
DIVISION OF HEALTH SERVICES
RALEIGH, NORTH CAROLINA

APPENDIX II
SITE EVALUATION

T. C. # 317-341-12

(Ground Absorption Sewage Disposal)


DATE REQUESTED:
PLAT NO.:
LOT SIZE: Normal 35,000

FACTORS	AREA 1	AREA 2	AREA 3	AREA 4
1. SLOPE (%)	(S) PS U 2-5%	(S) PS U 2-8%	S PS U	S PS U
2. SOIL TEXTURE (12-36 in.) (Sandy, loamy, clayey, Note 2:1 Clay)	S (PS) Clay U	S PS 2:1 clay (U)	S PS U	S PS U
3. SOIL STRUCTURE (12.36 in.) (Clayey Soils)	S (PS) Blocky U	S PS Massive (U)	S PS U	S PS U
4. SOIL DEPTH (In.)	(S) 40" PS U	(S) PS 40" U	S PS U	S PS U
5. RESTRICTIVE HORIZONS (In.) (Impervious Strata Rock)	(S) None PS U	(S) None PS U	S PS U	S PS U
6. SOIL DRAINAGE/GROUNDWATER (External & internal)	(S) 76" to PS ground U water	S Seasonal PS perched (U) water table	S PS U	S PS U
7. SOIL PERMEABILITY (Percolation Rate)	S (PS) moderate U	S PS slow → (U) slow	S PS U	S PS U
8. OTHER (Specify)	S PS See Note U	S PS U	S PS U	S PS U
9. SITE CLASSIFICATION	Provisionally Suitable	unsuitable		
SOIL SERIES	Appling	Helena		

S - Suitable PS - Provisionally Suitable U - Unsuitable


* See Diagram on Back (Include: Soil areas, property lines, roads, streams, gullies wet areas, fill areas, wells, water bodies, slope patterns, etc.

Recommendations/Comments: House site & system location to be given on-site check & approval before permit for system is issued

Described By: William R. Marlin

Title: Soil Scientist Date: 1-18-79

DHS Form 2601
Sanitation
EHD 539 (3/79)

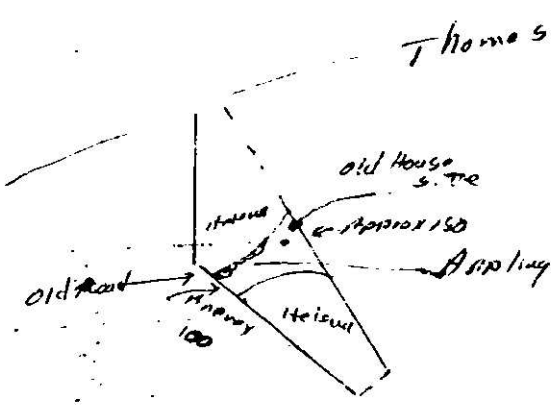
Thomas R
old House site
Approx 150
Old Road
Heisul

Serial No. 3141

PTR No. 16174

T C No 217-041-12

Date Issued Sept. 28 1979

Map Date


MECKLENBURG COUNTY
DEPARTMENT OF ENVIRONMENTAL HEALTH
SOIL INVESTIGATION REPORT

NAME OF OWNER Thomas, C.L.
(LAST, FIRST, MIDDLE)

ADDRESS OF OWNER Route 4, Box 122 Fort Mill, South Carolina ZIP 29715

LOCATION OF PROPERTY Thomas ROAD
(STREET OR COUNTY ROAD)

SUBDIVISION LOT NO. BLOCK NO

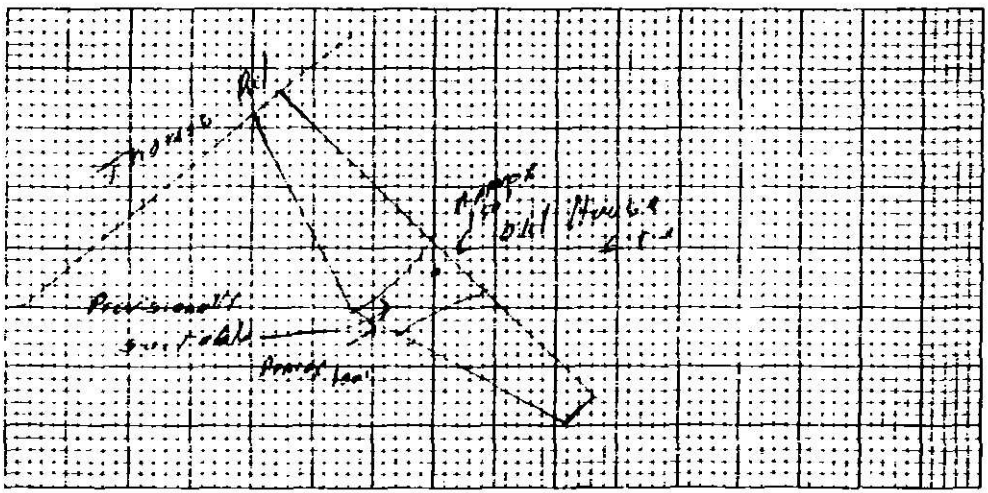

PLOT PLAN

This is to certify that a soil investigation and on-site investigation was made by the Mecklenburg County Department of Environmental Health on the lot described above. The said investigation was conducted on that portion of the lot as indicated on the above plot. The permeability rate determined by the investigation was **Provisionally Suitable**. The said lot is approved for the installation of an individual septic tank wastewater treatment system with subsurface soil absorption of sanitary sewage subject to the following terms and conditions:

1. Approval must be obtained from the Mecklenburg County Department of Environmental Health prior to the issuance of a construction permit for the wastewater treatment system to be installed.
2. The size of the septic tank and wastewater treatment system absorption area shall be determined by the Mecklenburg County Department of Environmental Health at the time of application for permit in accordance with the permeability rate obtained above and on the basis of the number of bedrooms in the dwelling to be served thereby.
3. This approval is valid only for the system as installed on the immediate area indicated as acceptable for system installation on the above plot.
4. This approval is void if any grading, filling or other construction activity affecting the soil characteristics of the area indicated as acceptable for system installation is performed on the lot which in the opinion of the Mecklenburg County Department of Environmental Health renders the area indicated as acceptable for system installation unsuitable for installation. Construction of a new system and/or repair of such a system.

This approval is granted based on the laws of the State of North Carolina and the rules and regulations of the North Carolina Department of Human Resources, Division of Health Services and the Mecklenburg County Health Commission which were in effect on the date of issuance and is void if at any time in the future, prior to completion of the system, these laws, rules and regulations are changed such that this approval would not have been granted had the new or revised laws, rules, and regulations been in effect on the issue date.

William H. Martin
Soil Scientist

John D. Johnson
Environmental Health Director or Authorized Section Head

EHD-5-76

Environmental Health Department's Copy