Date Received 1/9/84

RECEIVED
JAN 9 1984
ENVIRONMENTAL HEALTH

ICAR (S) Application No. 20486.

T. C. No. 227-171-04

Map Date _____

MECKLENBURG COUNTY
DEPARTMENT OF ENVIRONMENTAL HEALTH

Application for an
Installation, Construction, Alteration, and/or Repair Permit
(Individual Septic Tank System with Subsurface, Soil Absorption, Effluent Discharge)

The owner of that property described hereinafter hereby applies to the Mecklenburg County Department of Environmental Health for a permit to:

1) Install or Construct 2) X Alter or Repair an individual septic tank wastewater treatment system with a subsurface, soil absorption, effluent discharge.

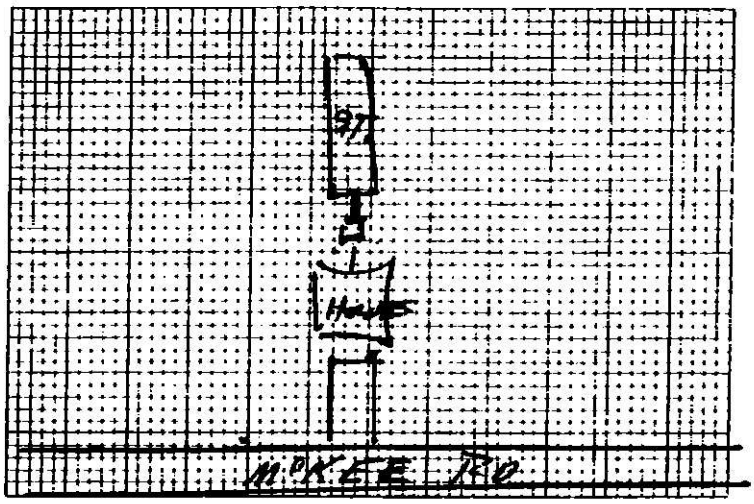

3) PLOT PLAN (ACCURATELY DIMENSIONED)

4) Mobile Home Yes X No
Residence X Yes No
4) No of Bedrooms 2/
5) Business Use -- Max No Employees
6) Washing Machine X Yes No
7) Garbage Disposal Yes X No
8) Dishwasher Yes X No
9) Water Supply
Individual Well A
B Governmental System
C) Community System
1 Well source
2 Governmental source
10) Sewage System
House located within 200 feet of public sewer Yes X No
House located within 200 feet of community sewer Yes X No
11) FHA Case No
12) VA Case No

13) NAME OF OWNER Fincher (LAST) Herbert (FIRST) Wilson (MIDDLE)

14) ADDRESS OF OWNER P O Box 842 Mathews, N.C.

15) PHONE NO. Home 847-6360 Office

16) LOCATION OF SYSTEM 1708 McKee Rd (STREET OR COUNTY ROAD)

17) SUBDIVISION _____ Lot No. _____ Block No. _____

Map Book No. _____ Page No. _____

18) DEED REFERENCE — DEED BOOK _____ AT PAGE _____

19) HAS A SOIL INVESTIGATION BEEN RUN? YES X NO DATE RUN

20) PTR NUMBER (See Instructions)

The undersigned person hereby agrees that he has read the foregoing application and that the contents of same are true. It is understood that any permit applied for herein shall be void and of no effect if any of the above facts are not true.

1-9-84
DATE OF APPLICATION

Herbert Fincher
OWNER

EHD-5-76

ENVIRONMENTAL HEALTH DEPARTMENT'S COPY

Serial No. 6842

ICAR(S) Permit No. 20486

Date Issued 1-9-84

T C No. 227-171-04

Map Date

MECKLENBURG COUNTY
DEPARTMENT OF ENVIRONMENTAL HEALTH
INSTALLATION, CONSTUCTION, ALTERATION, AND/OR REPAIR PERMIT
(Individual Septic Tank System with Subsurface, Soil Absorption, Effluent Discharge)

Permission is hereby given to ___ Install or Construct, ✓ Alter or Repair the individual septic tank wastewater treatment system with subsurface soil absorption, effluent discharge as specified herein at the described location. This permit is granted based upon the information supplied in application 20486, dated 1-9-84 and this permit shall be void and of no effect if the information provided in the application is not true or is erroneous. All work shall be completed on or before JAN 23rd 1983 after which date this permit shall be null and void.

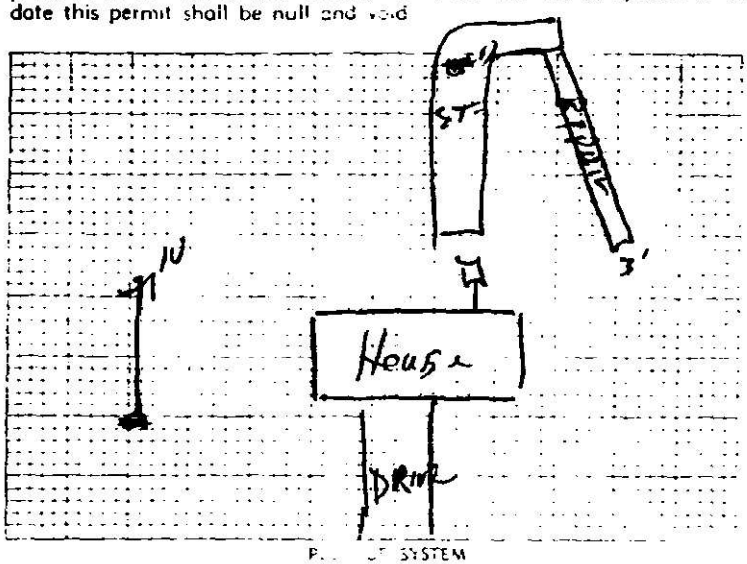

PLAN OF SYSTEM

Permeability Rate PS IVA

Liquid Capacity of Tank Repair

Tank Construction Repair

Total Line Length 100 lin FT

Number of Lines ONE

Distance from House 10 FT

Distance from Property Line 40 FT

Distance from Well 600 FT

NAME OF OWNER FINCHER, HERBERT

LOCATION OF PROPERTY 1708 McKEE ROAD

The system shall meet all of the construction requirements as set forth in the Regulations of the Mecklenburg County Health Commission which are in effect on the date of the granting of this permit. A certificate of approval must be issued by the Environmental Health Director before any system can be covered up or otherwise rendered uninspectable or can be used. The issuance of this permit does not in any way guarantee that the system anticipated to be constructed will operate properly, or relieve any person now or hereafter owning, controlling or using such system from any liability resulting from the failure of the system to operate properly.

ON trench to be 100 FX 3 FT x 18 stone bay or straw cover - grade bd.

Comments

Division or Section Head

W. B. Ramsey
Environmentalist

* If this permit is for the installation or construction of a new system, it must be signed by the division or a section head of the Department of Environmental Health in order to be valid. Only the signature of the Environmentalist is required where an existing system is being altered or repaired.

EHD-5-76

ST 1-23-84

C of A (s) No. 20486

Date Issued 1-20-84 **Serial** 6401 T C. No. 227-171-C4

MECKLENBURG COUNTY
DEPARTMENT OF ENVIRONMENTAL HEALTH
CERTIFICATE OF COMPLETION

CERTIFICATE OF APPROVAL
(Individual Septic Tank System with Subsurface, Soil Absorption, Effluent Discharge)

Name of Owner Fincher (LAST) Herbert (FIRST) (MIDDLE)

Location of Property 1702 Mallard Rd

Application Number 20486 Permit Number 20486

Inspection Data:

Liquid Capacity of Tank 1 Tank Material NA

Total Length of Drain Tile 160 Number of Lines 1

Depth of Filter Material 12 Cover Depth 20

Water Supply Source Well Distance from Water Source 100

Excavation Inspected 1-20-84 (DATE) Tank Inspected NA (DATE)

Nitrification Field Inspected 1-20-84 (DATE)

Washing Machine Line Inspected, If Applicable NA (DATE)

The undersigned has inspected the Individual Septic Tank System with subsurface, soil absorption, effluent discharge as described above and it has been X installed or constructed, altered or repaired in accordance with the permit issued and the regulations of the Mecklenburg County Health Commission in effect on the date of issuance of the permit. The issuance of this Certificate of Approval does not in any way guarantee that the system will operate properly or relieve any person now or hereafter owning, controlling, or using such system from any liability resulting from the failure of the system to operate properly. This Certificate of Approval is issued subject to those restrictions and conditions shown on the permit(s) in addition to those listed below under comments. This Certificate of Approval shall be null and void if any information contained in the application is untrue or if any additions are made to the property which would increase the requirements for said system

Comments 100 ft Repair Line

W. B. Kinney
Environmentalist

EHD-5-76

ENVIRONMENTAL [illegible]