Groundwater & Wastewater Services
Septic Project File & Data Review Worksheet

GWS File #: 7940 B WASPS App #: 3926

Primary ES assigned to project: _____

Secondary ES assigned to project: _____

Project Type: New System ☐ Alteration ☑ Repair ☐ Modified Plot Plan ☐

I. File Review:

Rule or Law	Permit Application			
.1937(d)	Is the Application complete	Yes ☑	No ☐	N/A ☐
.1937(d)	Is there a Site plan/Plat with application	Yes ☑	No ☐	N/A ☐
.1937(d)	Is the Facility shown?	Yes ☑	No ☐	N/A ☐
.1937(d)	Are appurtenances shown	Yes ☑	No ☐	N/A ☐
	Site Evaluation Information			
.1939 (a)(1)	Topography and Landscape Position Recorded?	Yes ☑	No ☐	N/A ☐
.1940 (a-g)	Slope % Recorded?	Yes ☑	No ☐	N/A ☐
.1939 (a)(2)	Texture Class Recorded?	Yes ☑	No ☐	N/A ☐
.1939 (a)(2)	Structure type Recorded?	Yes ☑	No ☐	N/A ☐
.1939 (a)(2)	Consistence Recorded?	Yes ☑	No ☐	N/A ☐
.1939 (a)(2)	Mineralogy Recorded?	Yes ☑	No ☐	N/A ☐
.1939 (a)(3)	Soil Wetness Condition Recorded?	Yes ☐	No ☐	N/A ☑
.1939 (a)(4)	Soil Depth to Rock or Parent Material Recorded When Encountered	Yes ☐	No ☐	N/A ☑
.1939 (a)(5)	Depth to Restrictive Horizons Recorded When Encountered?	Yes ☐	No ☐	N/A ☑
.1939 (a)(6)	Sufficient Available Space Recorded?	Yes ☑	No ☐	N/A ☐
.1937(m)	Are the Profile Locations Shown?			
.1939(a)	Are the S/PS Profiles in system & in repair area?	Yes ☑	No ☐	N/A ☐
& .1945(b)	Number of auger borings made: _____ Were sufficient auger borings made?	Yes ☑	No ☐	N/A ☐
.1939(d), .1955, .1956, .1957	LTAR	Yes ☑	No ☐	N/A ☐
	Improvement Permit/Construction Authorization			
.1937(g) 130A-336(a)	Proposed System Type stated-Initial	Yes ☑	No ☐	N/A ☐
.1945(b)	Proposed System Type stated-Repair	Yes ☑	No ☐	N/A ☐
130A-336 (a)(3)	System location identifiable by setbacks - Initial	Yes ☑	No ☐	N/A ☐
.1937(g) .1945(b)	System components shown – Initial	Yes ☑	No ☐	N/A ☐
.1945(b)	Repair area shown	Yes ☑	No ☐	N/A ☐
.1937 (f)(g)	Does System design match facility, flow & WWcharacteristics?	Yes ☑	No ☐	N/A ☐
.1937 (f)(g)	Is System design consistent with soil/site conditions?	Yes ☑	No ☐	N/A ☐
.1937 (f)(g)	Is the System located in the approved area?	Yes ☑	No ☐	N/A ☐
130A-336(a)	Is the Design flow (gpd) indicated?	Yes ☐	No ☐	N/A ☐

130A-336(a)	Number of Bedrooms, employees, seats, etc. indicated?	Yes ☑	No ☐	N/A ☐
.1937(g)	Trench depth indicated?	Yes ☑	No ☐	N/A ☐
.1937(g)	Trench width indicated?	Yes ☑	No ☐	N/A ☐
.1937(g)	Trench length indicated?	Yes ☑	No ☐	N/A ☐
130A-336(a)(1)	Proposed/existing well shown?	Yes ☑	No ☐	N/A ☑
130A-336(a)(1)	Property line lengths shown?	Yes ☑	No ☐	N/A ☐
130A-336(a)	Facility/appurtenance setbacks shown from fixed points?	Yes ☑	No ☐	N/A ☐

Operation Permit

.1937(i)	System type as described in table V(a) of rule .1961	Yes ☑	No ☐	N/A ☐
.1937(i)	Conditions for system performance, operation, maintenance, monitoring and reporting.	Yes ☑	No ☐	N/A ☐

II. WASPS Review:

Construction authorization issued	Yes ☐	No ☐	N/A ☐
Installation approval issued	Yes ☐	No ☐	N/A ☐
Operation permit issued	Yes ☐	No ☐	N/A ☐
Other related documentation	Yes ☐	No ☐	N/A ☐

Items requiring correction/modification: _____

Comments:

IA issued date: 11-12 08

OP issued date: 11-20 08

Review performed by: IR Date performed: 11-12 08

7940B

MECKLENBURG COUNTY
GROUNDWATER & WASTEWATER SERVICES

3976

APPLICATION FOR A RESIDENTIAL SITE IMPROVEMENT PERMIT/ CONSTRUCTION AUTHORIZATION FOR AN ON-SITE WASTEWATER SYSTEM, NEW WELL INSTALLATION, OR REPAIR OF EXISTING WELL

1. SEPTIC / TYPE APPLICATION: ☐ N/A ☐ NEW SYSTEM ☑ ALTERATION ☐ REPAIR ☐ MODIFIED PLOT PLAN

2. WELL / TYPE APPLICATION: ☐ N/A ☐ NEW WELL ☐ MAJOR REPAIR ☐ ABANDONMENT

3. JOB LOCATION INFORMATION:
TAX PARCEL NUMBER: 105-131-34
STREET ADDRESS: 8610 HOLIDAY DRIVE
CITY: CHARLOTTE
STATE: NC ZIP: 28215
SUBDIVISION NAME:
LOT #: 24 LOT SIZE (acres):
TOWNSHIP:
☑ 0-MECKLENBURG ☐ 3-CORNELIUS ☐ 6-HUNTERSVILLE
☐ 1-CHARLOTTE ☐ 4-PINEVILLE ☐ 7-MINT HILL
☐ 2-DAVIDSON ☐ 5-MATTHEWS

4. BUILDING INFORMATION:
BUILDING TYPE:
☐ SINGLE MOBILE HOME ☐ MODULAR HOME
☐ DOUBLE WIDE ☐ MULTIPLE FAMILY
☑ HOUSE ☐ OTHER _____
HEATED SQUARE FOOTAGE: 1508
NUMBER OF BEDROOMS: 3
NUMBER OF OCCUPANTS: 2
FOUNDATION TYPE:
☐ CONCRETE SLAB ☐ BASEMENT WITH PLUMBING
☑ CRAWL SPACE ☐ BASEMENT WITH NO PLUMBING

5. IF PLANNING TO EXPAND OR ALTER THE EXISTING SEPTIC SYSTEM PLEASE COMPLETE THE FOLLOWING SECTION: ☐ N/A

NUMBER OF BEDROOMS TO BE ADDED: 0 NUMBER OF ADDITIONAL OCCUPANTS IN THE RESIDENCE: 0

6. WATER SUPPLY: ☑ MUNICIPAL ☐ PRIVATE WELL ☐ PUBLIC WELL ☐ SHARED WELL ☐ OTHER _____

7. PROPOSED USE OF WELL: ☐ N/A ☐ IRRIGATION ☐ POTABLE (DRINKING WATER) ☐ OTHER _____

8. PLEASE INDICATE AND RANK DESIRED SEPTIC SYSTEM TYPE(S) IN ORDER OF PREFERENCE (1-MOST DESIRED 6-LEAST DESIRED)
☐ N/A ☑ ANY TYPE ☐ CONVENTIONAL ☐ ACCEPTED ☐ INNOVATIVE ☐ ALTERNATIVE ☐ OTHER _____

8A. RANK: _____ _____ _____ _____ _____

9. DO ANY OF THE FOLLOWING APPLY TO THE PROPERTY IN QUESTION? IF "YES" PLEASE ATTACH SUPPORTING DOCUMENTATION.

BURIED CABLES, LANDFILLS, STUMPHOLES	☑ YES ☐ NO	GRADING/SOIL REMOVAL PERFORMED	☐ YES ☐ NO
EXISTING WASTEWATER (SEPTIC) SYSTEMS	☑ YES ☐ NO	JURISDICTIONAL WETLANDS	☐ YES ☐ NO
WELLS, SPRINGS, OR WATER LINES	☐ YES ☐ NO	APPROVAL REQUIRED BY ANY OTHER PUBLIC AGENCY	☐ YES ☐ NO
EASEMENTS OR RIGHT-OF-WAYS	☐ YES ☐ NO	WASTEWATER OTHER THAN DOMESTIC SEWAGE	☐ YES ☐ NO
CHEMICAL/PETROLEUM STORAGE TANKS	☐ YES ☐ NO	KNOWN UNDERGROUND CONTAMINATION	☐ YES ☐ NO
WASTE STORAGE	☐ YES ☐ NO	GROUNDWATER USE RESTRICTIONS/VARIANCES	☐ YES ☐ NO

10. WHAT DATE WAS THE PROPERTY ORIGINALLY DEEDED AND RECORDED? 1967 ☐ UNKNOWN

11. WHAT IS THE ANTICIPATED CLOSING DATE FOR THIS PROPERTY? _____ ☑ N/A

12. PROPERTY OWNER:
NAME: TIMOTHY & KIMBERLY GRAYBILL
ADDRESS: 8610 HOLIDAY DR.
CITY: CHARLOTTE
STATE: NC ZIP: 28215
HOME PHONE: 704-567-8212
WORK PHONE:
MOBILE PHONE:
FAX:

13. OWNER'S LEGAL REPRESENTATIVE, IF APPLICABLE:
NAME:
ADDRESS:
CITY:
STATE: ZIP:
HOME PHONE:
WORK PHONE:
MOBILE PHONE:
FAX:

MECKLENBURG COUNTY – GROUNDWATER & WASTEWATER SERVICES
700 N. TRYON ST. SUITE 211 CHARLOTTE, NC 28202, OFFICE: 704-336-5103, FAX: 704-336-8804

Revised on 7/7/08

14. SEPTIC SYSTEM PERMIT APPLICATION:

If the information in this application is falsified, changed, or the site is altered, then the Improvement Permit and Authorization to Construct shall become invalid. I have read this application and certify that the information provided herein is true, complete and correct. Authorized county and state officials are granted right of entry to conduct necessary inspections to determine compliance with applicable laws and rules. I understand that I am solely responsible for the proper identification and labeling of all property lines and corners and making the site accessible so that a complete site evaluation can be performed. The permit is valid for either sixty (60) months or is non-expiring depending upon the documentation submitted: complete site plan = 60 months, complete plat = non-expiring.

RMS (Initial here for septic system applications)

15. WELL PERMIT APPLICATION:

If the information in this application is falsified, changed, or the site is altered, then the Well Permit shall become invalid. I have read this application and certify that the information provided herein is true, complete and correct. Authorized county and state officials are granted right of entry to conduct necessary inspections to determine compliance with applicable laws and rules. I understand that I am solely responsible for the proper identification and labeling of all property lines and corners and making the site accessible so that a complete site evaluation can be performed. The permit is valid for a period of twelve (12) months from the date of issuance.

_____ (Initial here for well applications)

16. APPLICATION SIGNATURE SECTION:

ONLY COMPLETE APPLICATIONS WILL BE PROCESSED. A proper signature is required in order to process your application. Please review the application carefully and sign in the space provided below.

+ Rm Center City Builders LLC 11/11/08

Property Owner's or Owner's Legal Representative Signature Date

OFFICE USE ONLY

☐ SURVEY PLAT TO SCALE SUBMITTED ☐ SCALED SITE PLAN SUBMITTED ☐ UN-SCALED SITE PLAN SUBMITTED

SEPTIC APPLICATION FEES RECEIVED: $ 200.00 cash DATE FEE RECEIVED: 11/12/08

WELL APPLICATION FEES RECEIVED: $ _____ DATE FEE RECEIVED: _____

APPLICATION PROCESSED BY: gc

GWS FILE NUMBER ASSIGNED: 79408

APPLICATION ID NUMBER ASSIGNED: 3976

COMMENTS:

MECKLENBURG COUNTY – GROUNDWATER & WASTEWATER SERVICES
700 N. TRYON ST. SUITE 211 CHARLOTTE, NC 28202, OFFICE: 704-336-5103, FAX: 704-336-6894

CONDITIONS OF IMPROVEMENT PERMIT for an ALTERATION TO AN EXISTING ON-SITE WASTEWATER TREATMENT & DISPOSAL SYSTEM

Permit Number: **7940B** Tax Number: **10513134**

- The IMPROVEMENT PERMIT is subject to revocation if site plans or the intended use change. There is to be **NO** grading, filling, or disturbance of the soil in the area of the septic tank system or repair area.
- CONSTRUCTION AUTHORIZATION must be obtained prior to receiving a Building Permit. The Construction Authorization is **NOT** transferable. Do not clear, grade, fill or disturb soil prior to obtaining a Construction Authorization.
- Domestic-type wastewater only. No industrial process wastewater may be discharged into the system.

Basement: ☐ Yes ☒ No ☐ Partial Basement

Primary Wastewater System

Type: ☐ I ☐ II ☒ III ☐ IV ☐ V ☐ VI

☐ Conventional
☐ Prefabricated, permeable block panel system
☐ Shallow Placed Conventional
☐ Low Pressure Pipe
☐ Large Diameter Pipe
☐ Fill
☐ Other
☒ Innovative or Experimental:

NA Long-term acceptance rate (GPD/ft^2)	**360** Max gallons/day wastewater flow	**150** Absorption Area (ft^2)	**NA** Trench spacing (min. on centers) (ft)
Serviced by private well: ☐ Yes ☒ No	**Exis** Gallon septic tank	**50** Total trench length (ft)	**36** Maximum trench depth (in) (At least 12" of provisionally suitable soil must remain between trench bottom and unsuitable soil conditions.)
3 Bedrooms in residence	**NA** Gallon pump tank	**NA** Depth of media (in)	

Any surface water present: **No** Type: Minimum separation distance (ft):

Additional conditions: **Remove existing drainline in area of proposed addition and install 3'x50' innovative drainline as shown on IP.**

Repair Area System

Type: ☐ I ☐ II ☒ III ☐ IV ☐ V ☐ VI

☐ Conventional
☐ Prefabricated, permeable block panel system
☐ Shallow Placed Conventional
☐ Low Pressure Pipe
☐ Large Diameter Pipe
☐ Fill
☐ Other
☒ Innovative or Experimental:

150 Absorption Area (ft^2) **50** Total trench length (ft)	**na** Depth of media (in)	**na** Trench spacing (min. on centers) (ft)	**36** Maximum trench depth (in)

The undersigned, an authorized agent of the MECKLENBURG COUNTY HEALTH DEPARTMENT, certifies that the Department has approved the Request for the Job Location contained in this document. The approval is granted in accordance with the provisions of Laws and Rules For Sewage Treatment, and Disposal Systems in effect at the time of issuance of the permit and is subject to the following provisions:

*** No work shall be conducted on the septic tank system until an Installation Approval is granted by this Department.

*** This Improvement permit is transferable.

11/12/08

DENR Authorized Agent Date

Owner/Agent Signature Date

MECKLENBURG COUNTY
GROUNDWATER & WASTEWATER SERVICES
700 N. TRYON ST., SUITE 211
CHARLOTTE, NC 28202
PHONE: (704) 336-5103
FAX: (704) 336-6894

NC DENR
DIVISION OF ENVIRONMENTAL HEALTH
ON-SITE WASTEWATER SECTION

PROPOSED PLOT PLAN

1"=30'

HEALTH DEPARTMENT
ENVIRONMENTAL HEALTH DIVISION
700 NORTH TRYON ST., SUITE 211
CHARLOTTE, NC 28202
PHONE (704) 336-5103

FILE: 7940B


TC: 105-131-34

Draw in and name all roads adjoining the property. Draw in and accurately dimension the lot concerned. Accurately indicate property boundaries proposed and/or existing structures and driveways, underground utilities, and wells and springs within 100 feet of the proposed building or drainfield.

ALTERATION TO EXISTING SYSTEM FOR DETACHED GARAGE ADDITION.

EXISTING LINE TO BE CUT OFF FROM SYSTEM AND SEALED WITH BENTONITE.

INSTALL 1 3'X50' DRAINLINE.

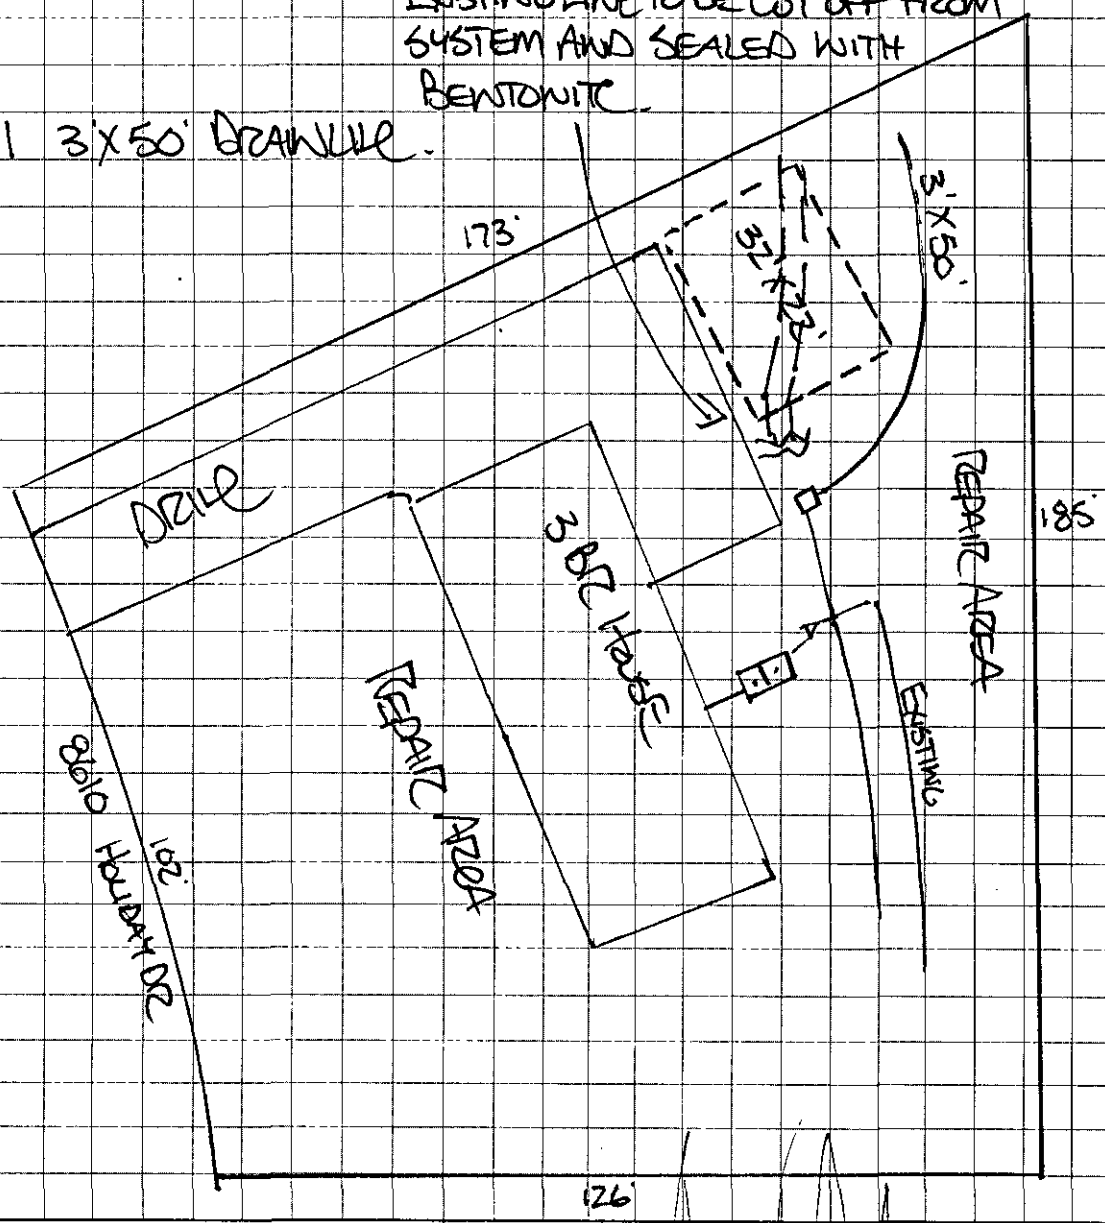

OWNER/AGENT SIGNATURE

DATE

APPROVAL DATE 11/12/08

White - Health Department's Copy Canary - E.H.S. Copy Pink - Owner's Copy

Mecklenburg County Groundwater & Wastewater Services
700 N. Tryon St., Suite 211 Charlotte, NC 28202
Phone: (704) 336-5103 Fax: (704) 336-6894

NC DENR
Division of Environmental Health
On-Site Wastewater Section

INSTALLATION APPROVAL for an ON-SITE WASTEWATER TREATMENT & DISPOSAL SYSTEM

File #: 7940B Permit #: 3976 Tax Parcel #: 105-131-34

Property Owner: TIMOTHY J. GRAYBILL

Job Location Address: 8610 HOLIDAY DR.

City: CHARLOTTE State: NC Zip Code: 28215

Installation Approval Issuance Date: 11/12/08

Permission is hereby given to ☐ install ☐ alter ☐ repair an on-site wastewater treatment & and disposal system, with subsurface soil absorption and effluent discharge, as specified herein at the described location. This approval is granted based upon the application information submitted to our office. All work shall be completed on or before 12/4/08, after which date this approval shall be null and void. The system shall meet all of the construction requirements of 15A NCAC 18A. 1900 which are in effect on the date of *granting this approval. An* ***Operation Permit*** *must be obtained from the Mecklenburg County Health Department before any system* can be covered up or placed into service. The issuance of this permit does not in any way guarantee that the system anticipated to be constructed will operate properly, or relieve any person now of hereafter owning, controlling or using such system from any liability resulting from the failure of the system to operate properly.

***NOTICE: This system shall not be installed while soils are in a wet condition.**

Permitted Design Flow: 360 GPD

Site LTAR: N/A GPD/ft² (For new installations only.)

Liquid Capacity of Septic Tank: EXISTING gallons

Liquid Capacity of Dosing Tank: N/A gallons

Drainfield Design ☐ N/A

Trench Depth: 36 inches

Trench Width: 3 feet

Line Spacing: N/A feet (O.C.)

Total line length: 50 feet

# of Lines: 1 @ 50 feet

Depth of Media: 12 inches (Type) 1110

Distribution Device:

Bed Design *(For Repair Installations ONLY.)* ☐ N/A

Bed Depth: _____ inches

Bed Width: _____ feet

Total line length: _____ feet

# of Lines: _____ @ _____ feet

Depth of Media: _____ inches (Type) _____

Distribution Device: _____

Water Supply Source

☑ Municipal ☐ Private Well ☐ Community Well

☐ Other _____


Minimum System Setbacks

Distance from Building Foundation: 5 feet

Distance from Property Line: 10 feet

Distance from Water Supply Source: >100 feet

SKETCH OF SYSTEM LAYOUT
(Proposed Layout)

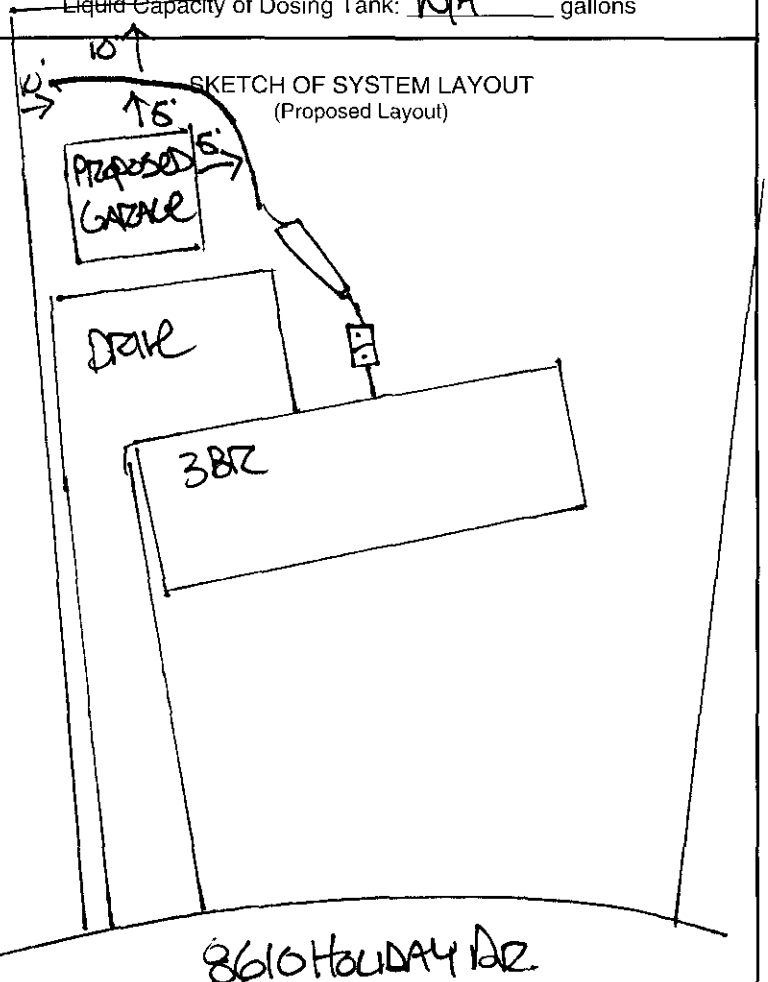

Comments: System Classification & Type: 1110, CUT FLOW FROM LINE EXISTING IN PROPOSED GARAGE AREA, SEAL W/ BENTONITE. INSTALL 3'X50' LINE, TIE INTO EXISTING SYSTEM.

DENR Authorized Agent: DAVID CORNELIUS, RS Signature: DAVID CORNELIUS, RS

Mecklenburg County Groundwater & Wastewater Services
700 N. Tryon St., Suite 211 Charlotte, NC 28202
Phone: (704) 336-5103 Fax: (704) 336-6894

NC DENR
Division of Environmental Health
On-Site Wastewater Section

OPERATION PERMIT for an ON-SITE WASTEWATER TREATMENT & DISPOSAL SYSTEM

File #: 7940B Permit #: 3976 Tax Parcel #: 10513134

Property Owner: TIMOTHY CRAY BILL

Job Location Address: 8610 HOLIDAY DR.

City: CHARLOTTE State: NC Zip Code:

Operation Permit Issuance Date: 11-17-2008 Contractor Name: STEVE AUTRY

Permitted Design Flow: _____ GPD

Liquid Capacity of Septic Tank: Existing gallons

Liquid Capacity of Dosing Tank: N/A gallons

Effluent Pump Model: N/A

Drainfield Installation ☐ N/A

Trench Depth: 36 inches

Trench Width: 3 feet

Line Spacing: N/A feet (O.C.)

Total line length: 50 feet

# of Lines: 1 @ 50 feet

Depth of Media: 12 inches (Type) EZ FLOW

Depth of Cover: 24 inches

Distribution Device: Tied into existing line stopped off line under garage

Bed Installation *(For Repair Installations ONLY.)* ☒ N/A

Bed Depth: _____ inches

Bed Width: _____ feet

Total line length: _____ feet

# of Lines: _____ @ _____ feet

Depth of Media: _____ inches (Type) _____

Depth of Cover: _____ inches

Distribution Device: _____

Water Supply Source

☒ Municipal ☐ Private Well ☐ Community Well

☐ Other _____

System Installation Setbacks

Distance from Building Foundation: 5 feet

Distance from Property Line: _____ feet

Distance from Water Supply Source: _____ feet


Inspection Dates

Tank(s) Inspected: N/A

Excavation Inspected: 11-10-08

Pump & Controls Inspected: N/A

SKETCH OF SYSTEM INSTALLATION
(As-Built Drawing)

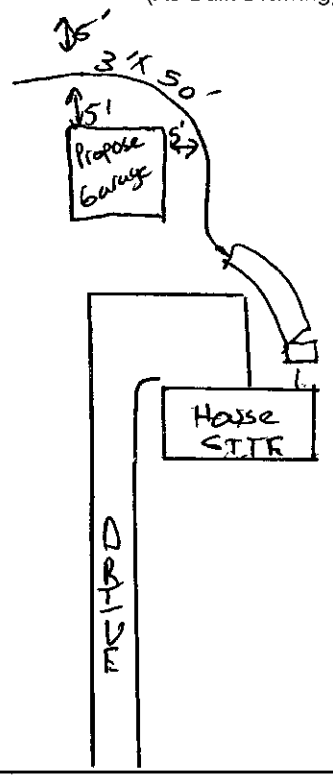

The undersigned has inspected the Septic Tank System described above, and certifies it has been ☐ installed ☒ altered ☐ repaired ☒ as detailed in the plot above ☐ in accordance with the permit issued and meets the provisions of 15A NCAC 18A. 1900, "Laws and Rules for Sewage Treatment and Disposal Systems" in effect on the date of issuance of the permit. The issuance of this Operation Permit does not in any way guarantee that the system will operate properly or relieve any person now or hereafter owning, controlling, or using such system from any liability resulting from the failure of the system to operate properly. This document is issued subject to those restrictions and conditions shown on the permit(s) and the provisions of 15A NCAC 18A. 1900 in addition to those listed below under "Comments." This document shall be null and void if any information contained in the application is untrue or if any additions are made to the property which would increase the requirements for said system.

Notice: Disturbance of the designated repair area may result in the Suspension or Revocation of this permit.

Comments: System Classification & Type: III g (EZ1203H, G, NA, NA

DENR Authorized Agent: Jeremy Michael Signature: Jeremy Michael

Mecklenburg County Groundwater & Wastewater Services
700 N. Tryon St., Suite 211 Charlotte, NC 28202
Phone: (704) 336-5103 Fax: (704) 336-6894

NC DENR
Division of Environmental Health
On-Site Wastewater Section

OPERATION PERMIT for an
ON-SITE WASTEWATER TREATMENT & DISPOSAL SYSTEM

File #: 7940 B Permit #: 3976 Tax Parcel #: 10513134


Job Location Address: 8616 Holiday Dr

City: Charlotte State: NC Zip Code:

OPERATION PERMIT CONDITIONS:

I. Performance: System shall perform in accordance with 15A NCAC 18A .1961.

II. Monitoring: System shall be monitored as required by 15A NCAC 18A .1961.

III. Maintenance: Ground absorption sewage treatment and disposal systems shall be checked, and the contents of the septic tank removed, periodically from all compartments, to ensure proper operation of the system. The contents shall be pumped whenever the solids level is found to be more than 1/3 of the liquid depth in any compartment.

IV. Operation: System shall be operated in accordance with 15A NCAC 18A .1961.

System Classification: IIIg

*Operation Permits for Type V and VI systems expire five (5) years from the date of issuance (in accordance with Table V(a)). The system owner must contact GWS six (6) months prior to expiration for permit renewal.

Subsurface system operator required: Yes ☐ No ☒

☐ This type of system requires the system owner to maintain a contract with a certified operator to perform system inspection, maintenance, and reporting as required in 15A NCAC 18A .1961. and Table V(a). The system owner is responsible for all fees associated with these services.

☐ System does not require inspection by GWS on a routine frequency.

☐ System requires inspection by GWS once every five (5) years. The system owner is responsible for all fees associated with the inspection.

☐ System requires inspection by GWS once every three (3) years. The system owner is responsible for all fees associated with the inspection.

☐ System requires inspection by GWS once every twelve (12) months. The system owner is responsible for all fees associated with the inspection.

☐ System requires inspection by GWS once every six (6) months. The system owner is responsible for all fees associated with the inspection.

V. Other:

DENR Authorized Agent: Jeremy Mitchell Date: 11-12-08

Signature: Jeremy Mitchell

Request for location of existing septic upfit 287028 & Garage 287027

FEE: 100
DATE: 10/23/08
CRT # 1

APPLICATION FOR APPROVAL TO USE AN EXISTING ON-SITE WASTEWATER TREATMENT & DISPOSAL SYSTEM
MECKLENBURG COUNTY - GROUNDWATER & WASTEWATER SERVICES
700 N. Tryon St., Suite 211 Charlotte, NC 28202
Phone: (704) 336-5103 Fax: (704) 336-6894

GWS – UES.APP 06/07

FILE #: 7940B

X42784

DC 3943

TYPE APPLCATION:

- [ ] ADDITION - INCREASE ROOMS/OCCUPANCY/MOBILE HOME SIZE (A / M)
- [X] ADDITION - RENOVATION OR GARAGE WITH NO MAJOR CHANGES (X)
- [ ] EXCHANGE MOBILE HOME - SAME # BEDROOMS (Y)
- [ ] COMMERCIAL OR INDUSTRIAL (N)

PERSON FILING APPLICATION:
NAME: Center City Builders, LLC
ADDRESS: 1800 Camden Rd Suite 107-12
CITY: Charlotte
STATE: NC ZIP: 28203
PHONE: 704 831-5324
ALTERNATE PHONE: 704 770-7500

PROPERTY OWNER:
NAME: Timothy & Kimberly Graybill
ADDRESS: 8610 Holliday dr
CITY: Charlotte
STATE: NC ZIP: 28215
PHONE: 704 567 8212
ALTERNATE PHONE:

JOB LOCATION INFORMATION
TAX/PARCEL #: 10513134
STREET ADDRESS: 8610 Holliday dr
CITY: Charlotte NC
STATE: NC ZIP: 28215
SUBDIVISION OR MOBILE HOME PARK NAME:
LOT #: 24 1967

TOWNSHIP:

- [X] 0-MECKLENBURG
- [ ] 1-CHARLOTTE
- [ ] 2-DAVIDSON
- [ ] 3-CORNELIUS
- [ ] 4-PINEVILLE
- [ ] 5-MATTHEWS
- [ ] 6-HUNTERSVILLE
- [ ] 7-MINT HILL

WATER SUPPLY:

- [X] MUNICIPAL (M)
- [ ] COMMUNITY (C)
- [ ] PRIVATE WELL (P)
- [ ] SHARED WELL (S)
- [ ] OTHER 'SPRINGS' (O)

RESIDENTIAL PROPERTY TYPE:

- [X] HOUSE (H)
- [ ] MODULAR HOME (M)
- [ ] MULTIPLE FAMILY (U)
- [ ] SINGLE MOBILE HOME (S)
- [ ] DOUBLE WIDE (D)
- [ ] OTHER (O)

OCCUPANCY (both fields are required):
NUMBER OF BEDROOMS: 3
NUMBER OF OCCUPANTS: 3

COMMERCIAL / INDUSTRIAL PROPERTY TYPE:
TYPE OF BUSINESS:
EMPLOYEES PER SHIFT:
OF SHIFTS:
INDUSTRIAL WASTES? [ ] YES [ ] NO
UNDERGROUND STORAGE TANKS? [ ] YES [ ] NO

ADDITION TYPE ATTACHED TO EXISTING STRUCTURE:

- [ ] BEDROOM
- [ ] BATHROOM
- [ ] KITCHEN
- [ ] DINING ROOM
- [ ] LIVING ROOM
- [ ] DEN
- [ ] GARAGE
- [ ] SUNROOM
- [ ] PORCH
- [ ] DECK
- [ ] OTHER

ADDITION TYPE DETACHED FROM EXISTING STRUCTURE:

- [X] DETACHED GARAGE
- [ ] DETACHED GARAGE WITH PLUMBING
- [ ] POOL HOUSE
- [ ] SHOP
- [ ] BARN
- [ ] STORAGE SHED
- [ ] DETACHED PORCH / DECK
- [ ] OTHER

*The undersigned, owner, or legal agent for the owner, of the property described above as the "Job Location" has read the foregoing application, acknowledges that the contents of same are true, and authorizes the Mecklenburg County Health Department to enter onto the property for the purpose of processing this request.

Owner's/Agent's Signature — Date: 10/22/08


*The undersigned, an authorized agent of the Mecklenburg County Health Department, certifies that the Department has approved the Request for the Job Location contained in this document. This approval is granted in accordance with the provisions of Laws and Rules for Sanitary Sewage Collection, Treatment and Disposal in effect at the time of issuance of the permit and is subject to the following provisions:

- No work shall be conducted on the septic tank system until an installation, construction, alteration and/or repair approval is granted y this Department.
- This permit is not transferable.

- [ ] ADDITION / RENOVATION APPROVAL - VALID 1 YEAR FROM ISSUANCE
- [ ] MOBILE HOME EXCHANGE APPROVAL - VALID 6 MONTHS FROM ISSUANCE

UES DENIED. EXISTING DRAINFIELD IN PROPOSED ADDITION AREA.

EHS Signature — Date: 10/23/08

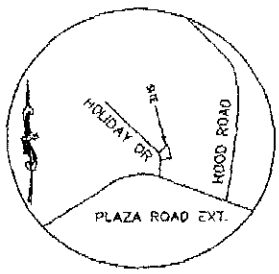


LOCATION MAP
NOT TO SCALE

CRAIG L. LONG P.L.S.
132 KEEL CT.
MOORESVILLE, N.C. 28117
(704) 799-2292

NORTH CAROLINA PROFESSIONAL SEAL L-2993 LAND SURVEYOR CRAIG L. LONG

NORTH PER MAP BOOK 12 PAGE 331

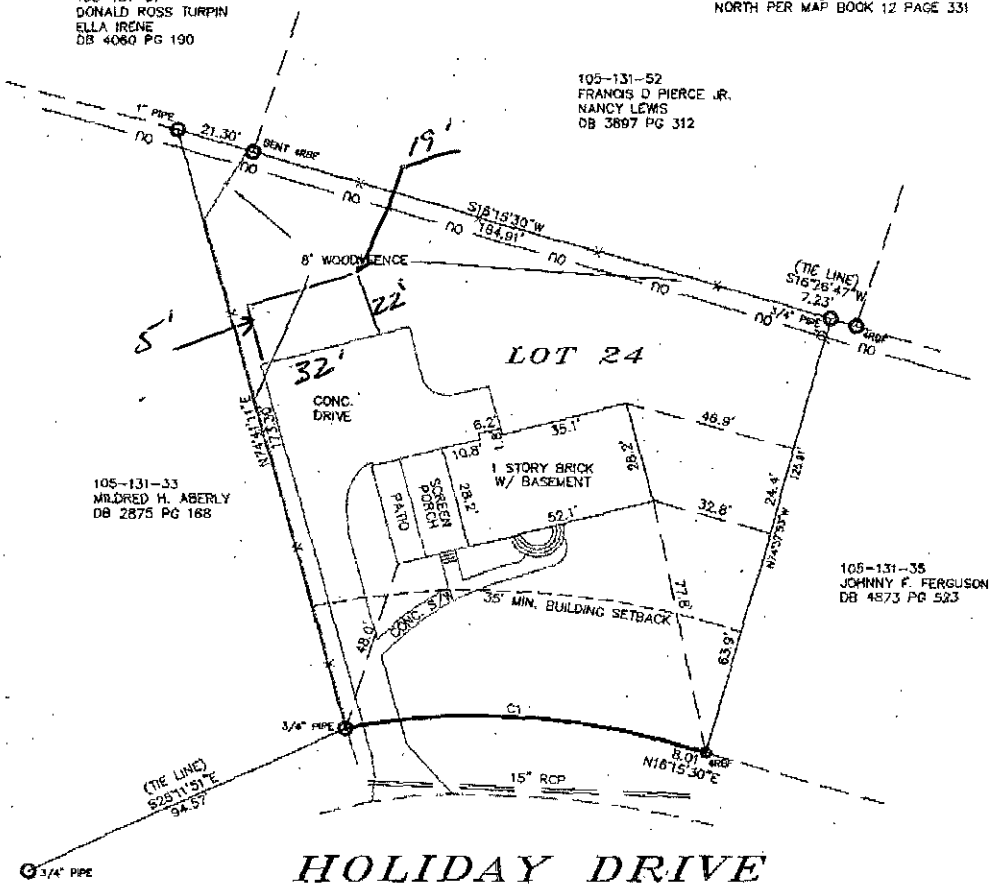

HOLIDAY DRIVE

60' R/W 20' E/P TO E/P

NOTES:

1. NO NCGS MONUMENT FOUND WITHIN 2000'
2. PROPERTY MAY BE SUBJECT TO OTHER COVENANTS, RESTRICTIONS, EASEMENTS OR RIGHTS-OF-WAY THAT MAY BE OF RECORD.

LEGEND

IRON FOUND ○
POWER POLE ⌀

CURVE TABLE

CURVE	LENGTH	RADIUS	CHORD	BEARING	DELTA
C1	91.65	189.67	90.77	N02°23'11"E	27°41'14"

PHYSICAL SURVEY OF

LOT 24 OF HOLIDAY PARK

PROPERTY OF TIMOTHY AND KIMBERLY GRAYBILL

SCALE: 1"=40' CHARLOTTE, MECKLENBURG CO., NC DATE: 12//12/2004

AS RECORDED IN:M.B. 12, PG 331 PID# 105-131-34


8610 HOLIDAY DRIVE EOC >=1:10,000

Mecklenburg County
Land Use & Environmental Service Agency
Groundwater & Wastewater Services
700 N. Tryon St., Suite 211
Charlotte, NC 28202
Phone: (704) 336-5103
Fax: (704) 336-6894

File #_____
Date_____

PROPOSED PLOT PLAN

A map showing existing and proposed property lines and easements with dimensions, the location of the single family residence, non-single family residence, or other facility, and appurtenances, the site for the proposed well, and the location of existing or proposed sewer lines and/or sewage disposal systems, surface water bodies, aboveground or underground storage tanks. Name all roads adjoining the property. If this a repair indicate the type of repair.

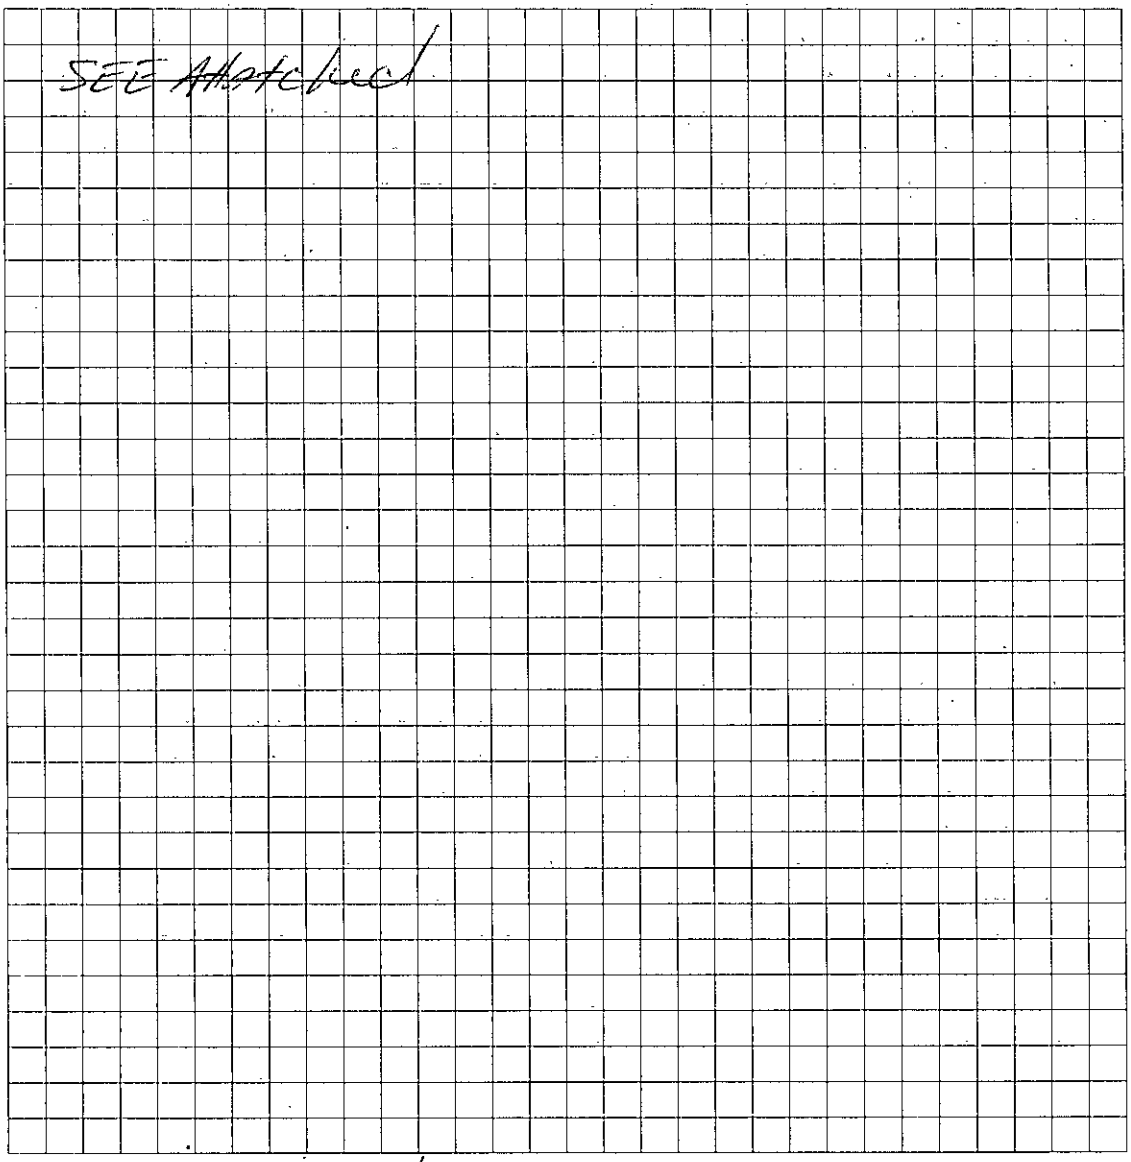

Owner/Agent Signature Ron Hoff Central City Builders LLC

Date 10/22/08

LBC 12/15/04

MECKLENBURG COUNTY
LAND USE AND ENVIRONMENTAL SERVICES
Payment Receipt

Receipt Information

Date:	10/23/08	**Amount:**	100.00
Receipt #:	59396	**Tendered:**	0.00
Check / Auth #:	CHARGE	**Returned:**	0.00
Received By:	CRAIGGY		

Account Information

Account #:	X42784
Contractor:	CENTER CITY BUILDERS LLC
Attn:	
Address:	1800 CAMDEN RD
Address:	
City/State/Zip:	CHARLOTTE, NC 28203

Item	Description	Permit#	Quantity	Unit Price	Total Price
0705	MH Exc/Add/Repl w/o System Mod 8610 Holiday Drive		1	100.00	100.00

Outstanding Balances

Month-To-Date	Prior Month	30 Days	60 Days	90 Days	Balance
100.00	211.00				

MECKLENBURG COUNTY
LAND USE AND ENVIRONMENTAL SERVICES
Payment Receipt

Receipt Information

Date:	11/12/08	**Amount:**	200.00
Receipt #:	59619	**Tendered:**	0.00
Check / Auth #:	CHARGE	**Returned:**	0.00
Received By:	CRAIGGY		

Account Information

Account #: X42784
Contractor: CENTER CITY BUILDERS LLC
Attn:
Address: 1800 CAMDEN RD
Address:
City/State/Zip: CHARLOTTE, NC 28203

Item	Description	Permit#	Quantity	Unit Price	Total Price
0706	MH Exc/Add/Repl w/System Mod 8610 Holiday Drive/file 7940B		1	200.00	200.00

Outstanding Balances

Month-To-Date	Prior Month	30 Days	60 Days	90 Days	Balance
358.25	102.11				