SUPERVISOR/ADMINISTRATIVE PROFESSIONAL CHECKLIST

☐ NEW SEPTIC ☑ REPAIR ☐ USE EXISTING ☐ MODIFIED PLOT PLAN ☐ ALTERATION

File Number: 6298A

Assigned Inspector: Braedon

☐ IP $250.00: _____ Initial/Date

☐ IP Commercial $450.00: _____ Initial/Date

☐ CA & OP $400.00: _____ Initial/Date

☐ Alteration Fees $300: _____ Initial/Date

☐ Modified Plot Plan Fees $100.00: _____ Initial/Date

☐ Use Existing Fees $100.00: _____ Initial/Date

☐ Use Existing Approved ☐ Use Existing Denied

☐ Send IP permit for signature: _____ ☐ Signature received: _____

☐ Floor plans reviewed

☐ Generate CA ☐ Approve as Noted in Winchester

☐ This site is served by septic and well. Verify each is complete before final hold is released

☐ This septic system requires a certified operation contract before final hold is released

☐ Certified operator contract is on file: _____

☑ Septic file complete: 8/23/23

☐ Release final hold in Winchester: _____

Comments:

Tank Replacement Only

Completed

L 298A
14026

MECKLENBURG COUNTY
HEALTH DEPARTMENT

25 JUL '23 AM10:17

APPLICATION FOR A RESIDENTIAL SITE IMPROVEMENT PERMIT/ CONSTRUCTION AUTHORIZATION FOR AN ON-SITE WASTEWATER SYSTEM, NEW WELL INSTALLATION, OR REPAIR OF EXISTING WELL

1. SEPTIC / TYPE APPLICATION: ○ N/A ○ NEW SYSTEM ○ ALTERATION ✓ REPAIR MODIFIED PLOT PLAN

2. WELL / TYPE APPLICATION: ○ N/A ○ NEW WELL ○ MAJOR REPAIR ○ ABANDONMENT

3. JOB LOCATION INFORMATION:

TAX PARCEL NUMBER: 11112486
STREET ADDRESS: 8400 Junction Ct
CITY: Charlotte
STATE: NC ZIP: 28215-4500
SUBDIVISION NAME: First Run
LOT #: 1 LOT SIZE (acres): 0.72
TOWNSHIP:

○ MECKLENBURG	○ CORNELIUS	HUNTERSVILLE
○ DAVIDSON	CHARLOTTE	PINEVILLE
○ MATTHEWS	MINT HILL	

4. BUILDING INFORMATION:

BUILDING TYPE:

○ SINGLE MOBILE HOME	MODULAR HOME
○ DOUBLE WIDE	MULTIPLE FAMILY
HOUSE	OTHER

HEATED SQUARE FOOTAGE: 2020
NUMBER OF BEDROOMS: 3
NUMBER OF OCCUPANTS: 2
FOUNDATION TYPE:

○ CONCRETE SLAB	BASEMENT WITH PLUMBING
✓ CRAWL SPACE	BASEMENT WITH NO PLUMBING

5. IF PLANNING TO EXPAND OR ALTER THE EXISTING SEPTIC SYSTEM PLEASE COMPLETE THE FOLLOWING SECTION: ☑ N/A

NUMBER OF BEDROOMS TO BE ADDED: _____ NUMBER OF ADDITIONAL OCCUPANTS IN THE RESIDENCE: _____

6. WATER SUPPLY: ○ MUNICIPAL ✓ PRIVATE WELL PUBLIC WELL SHARED WELL OTHER _____

7. PROPOSED USE OF WELL: ○ N/A ○ IRRIGATION ✓ POTABLE (DRINKING WATER) OTHER _____

8. PLEASE INDICATE AND RANK DESIRED SEPTIC SYSTEM TYPE(S) IN ORDER OF PREFERENCE *(1-MOST DESIRED 5-LEAST DESIRED):*

☑ N/A ☐ ANY TYPE ☐ CONVENTIONAL ☐ ACCEPTED ☐ INNOVATIVE ☐ ALTERNATIVE ☐ OTHER _____

8A. RANK: ____ ____ ____ ____ ____

9. DO ANY OF THE FOLLOWING APPLY TO THE PROPERTY IN QUESTION? IF "YES" PLEASE ATTACH SUPPORTING DOCUMENTATION.

BURIED CABLES, LANDFILLS, STUMPHOLES	○ YES	✓ NO	GRADING/SOIL REMOVAL PERFORMED	○ YES	✓ NO
EXISTING WASTEWATER (SEPTIC) SYSTEMS	◉ YES	NO	JURISDICTIONAL WETLANDS	○ YES	✓ NO
WELLS, SPRINGS, OR WATER LINES	◉ YES	NO	APPROVAL REQUIRED BY ANY OTHER PUBLIC AGENCY	○ YES	✓ NO
EASEMENTS OR RIGHT-OF-WAYS	YES	✓ NO	WASTEWATER OTHER THAN DOMESTIC SEWAGE	○ YES	✓ NO
CHEMICAL/PETROLEUM STORAGE TANKS	○ YES	✓ NO	KNOWN UNDERGROUND CONTAMINATION	○ YES	✓ NO
WASTE STORAGE	○ YES	✓ NO	GROUNDWATER USE RESTRICTIONS/VARIANCES	○ YES	✓ NO

10. WHAT DATE WAS THE PROPERTY ORIGINALLY DEEDED AND RECORDED? 1990 ☐ UNKNOWN

11. WHAT IS THE ANTICIPATED CLOSING DATE FOR THIS PROPERTY? _____ ☑ N/A

12. PROPERTY OWNER:

NAME: CTRRR LLC, KIWI HOMES LLC
ADDRESS: 1216 Brionne Ct
CITY: Waxhaw
STATE: NC ZIP: 28173
WORK PHONE: _____
MOBILE PHONE: 813-481-5258
FAX: _____
E-MAIL: lychagina.re@gmail.com

13. OWNER'S LEGAL REPRESENTATIVE, IF APPLICABLE:

Owner's Authorization form is required if legal representative is submitting application

NAME: Tatiana Lychagina
ADDRESS: 1216 Brionne Ct
CITY: Waxhaw
STATE: NC ZIP: 28173
WORK PHONE: _____
MOBILE PHONE: 813-481-5258
FAX: _____
E-MAIL: lychagina.re@gmail.com

MECKLENBURG COUNTY – GROUNDWATER & WASTEWATER SERVICES
3205 Freedom Drive, Suite 8000, Charlotte, NC 28208
OFFICE: 980-314-1680, FAX: 704-336-6894 Email: Wellreg@MecklenburgCountyNC.gov

Revised on: 4/20/17

14. SEPTIC SYSTEM PERMIT APPLICATION:

If the information in this application is falsified, changed, or the site is altered, then the Improvement Permit and Authorization to Construct shall become invalid. I have read this application and certify that the information provided herein is true, complete and correct. Authorized county and state officials are granted right of entry to conduct necessary inspections to determine compliance with applicable laws and rules. I understand that I am solely responsible for the proper identification and labeling of all property lines and corners and making the site accessible so that a complete site evaluation can be performed. The permit is valid for either sixty (60) months or is non-expiring depending upon the documentation submitted: complete site plan = 60 months, complete plat = non-expiring.

TL
_____ (Initial here for septic system applications)

15. WELL PERMIT APPLICATION:

If the information in this application is falsified, changed, or the site is altered, then the Well Permit shall become invalid. I have read this application and certify that the information provided herein is true, complete and correct. Authorized county and state officials are granted right of entry to conduct necessary inspections to determine compliance with applicable laws and rules. I understand that I am solely responsible for the proper identification and labeling of all property lines and corners and making the site accessible so that a complete site evaluation can be performed. The permit is valid for a period of twelve (12) months from the date of issuance.

_____ (Initial here for well applications)

16. APPLICATION SIGNATURE SECTION:

ONLY COMPLETE APPLICATIONS WILL BE PROCESSED. A proper signature is required in order to process your application. Please review the application carefully and sign in the space provided below. A PROPOSED PLOT PLAN is required to be submitted with each application.

Tatiana Lychagina _____ July 24, 2023

Property Owner's or Owner's Legal Representative Signature _____ Date

---

OFFICE USE ONLY

○ SURVEY PLAT TO SCALE SUBMITTED ○ SCALED SITE PLAN SUBMITTED ○ UN-SCALED SITE PLAN SUBMITTED

SEPTIC APPLICATION FEE RECEIVED: $ _____ DATE FEE RECEIVED: _____

WELL APPLICATION FEE RECEIVED: $ _____ DATE FEE RECEIVED: _____

APPLICATION PROCESSED BY: _____

GWS FILE NUMBER ASSIGNED: _____

APPLICATION ID NUMBER ASSIGNED: _____

COMMENTS:

MECKLENBURG COUNTY – GROUNDWATER & WASTEWATER SERVICES
3205 Freedom Drive, Suite 8000, Charlotte, NC 28208
OFFICE: 980-314-1680, FAX: 704-336-6894 Email: Wellreg@MecklenburgCountyNC.gov


File #: _____

PROPOSED PLOT PLAN

A drawing showing the locations of the following items is required: existing and proposed property lines with dimensions, easements or right-of-ways, proposed building pad(s) or existing building footprint(s), all appurtenances (garage, driveway, deck, pool, etc.), location of existing or proposed well(s), location of existing or proposed sewer lines and sewage disposal systems, surface water bodies, and any aboveground or underground storage tanks. Provide names for all roads that adjoin the property.

Street Address: _____ Tax Parcel #: _____

Subdivision Name: _____ Lot #: _____

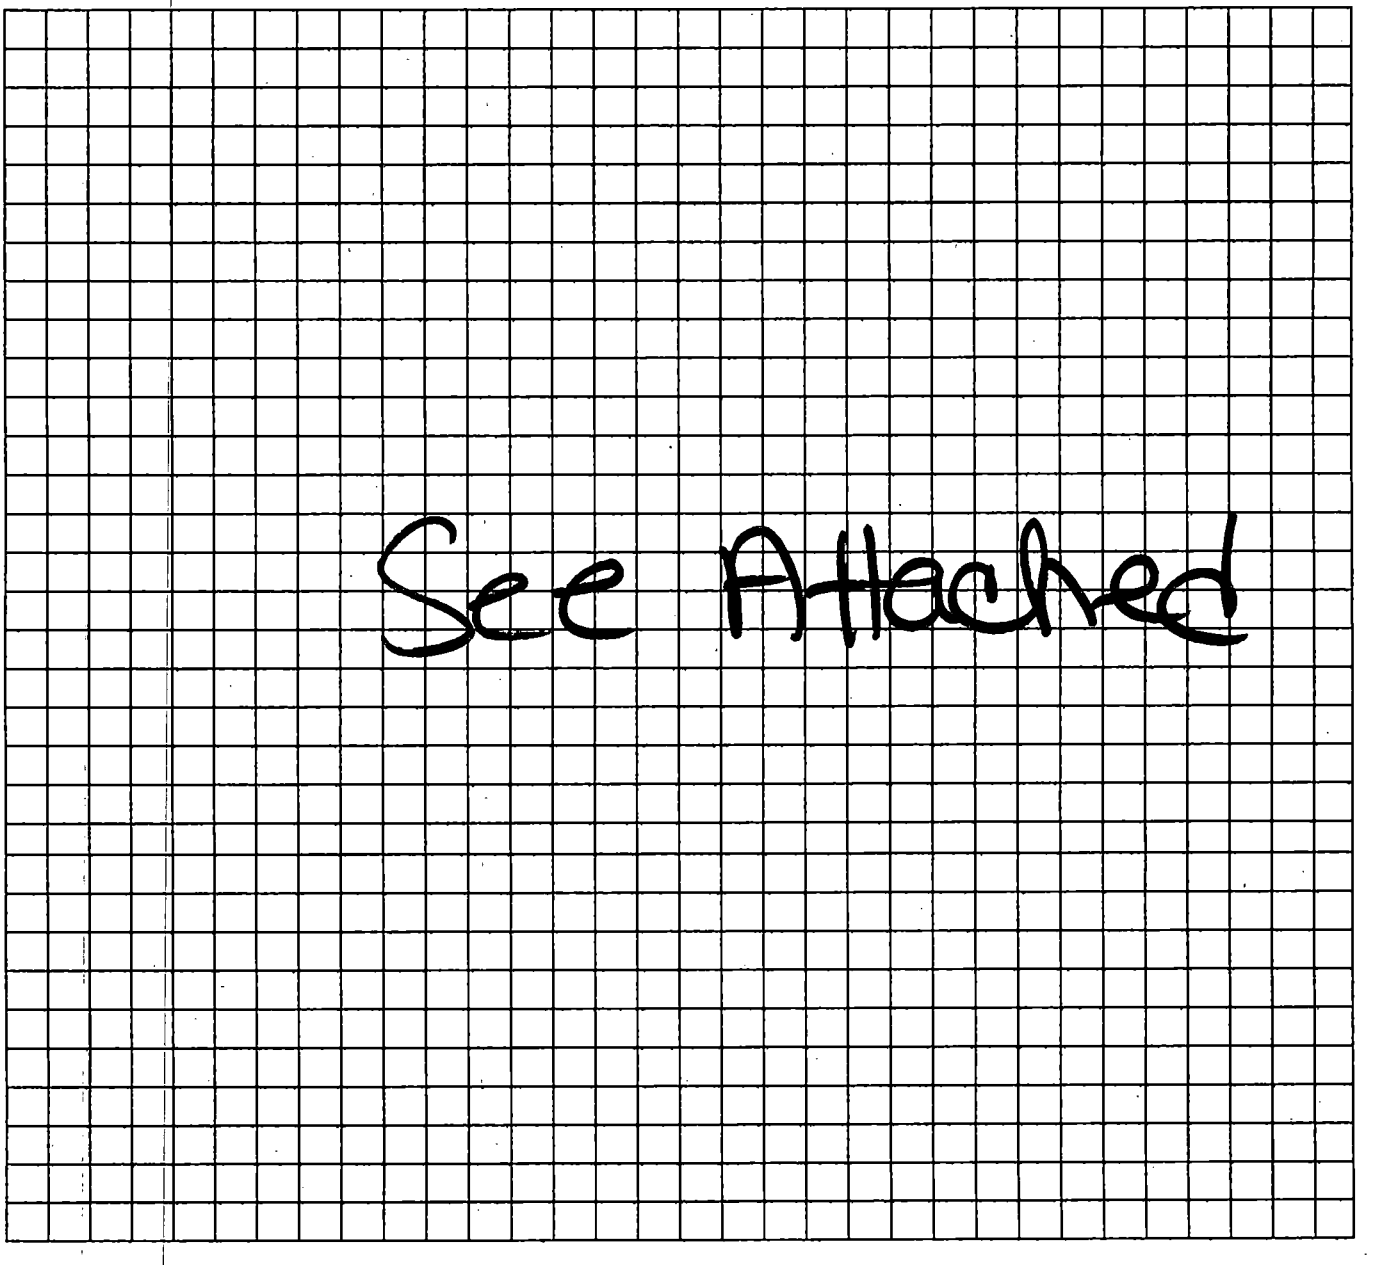

_____ _____

Property Owner's or Owner's Legal Representative Signature Date

MECKLENBURG COUNTY – GROUNDWATER & WASTEWATER SERVICES
3205 Freedom Drive, Suite 8000, Charlotte, NC 28208
OFFICE: 980-314-1680, FAX: 704-336-6894 Email: Wellreg@MecklenburgCountyNC.gov

Revised on: 4/20/17

INSTALLATION, CONSTRUCTION, ALTERATION, AND/OR REPAIR APPROVAL


HEALTH DEPARTMENT
ENVIRONMENTAL HEALTH DIVISION
700 NORTH TRYON ST., SUITE 211
CHARLOTTE, NC 28202
PHONE (704) 336-5102

FILE: 6298 A DATE: 2-1-99

TC: 111-124-86 ☒ L

SERIAL Nº 18035

Permission is hereby given to _____ Install or Construct, _____ Alter or Repair the individual septic tank wastewater treatment system with subsurface, soil absorption, effluent discharge as specified herein at the described location. This permit is granted based upon the information supplied in the application dated _____. All work shall be completed on or before _____, after which date this permit shall be null and void. The system shall meet all of the construction requirements of 15A NCAC 18A. 1900 which are in effect on the date of the granting of this permit. A Certificate of Completion or an Operation Permit must be obtained from the Mecklenburg County Health Department before any system can be covered up or placed into service. The issuance of this permit does not in any way guarantee that the system anticipated to be constructed will operate properly, or relieve any person now or hereafter owning, controlling or using such system from any liability resulting from the failure of the system to operate properly.

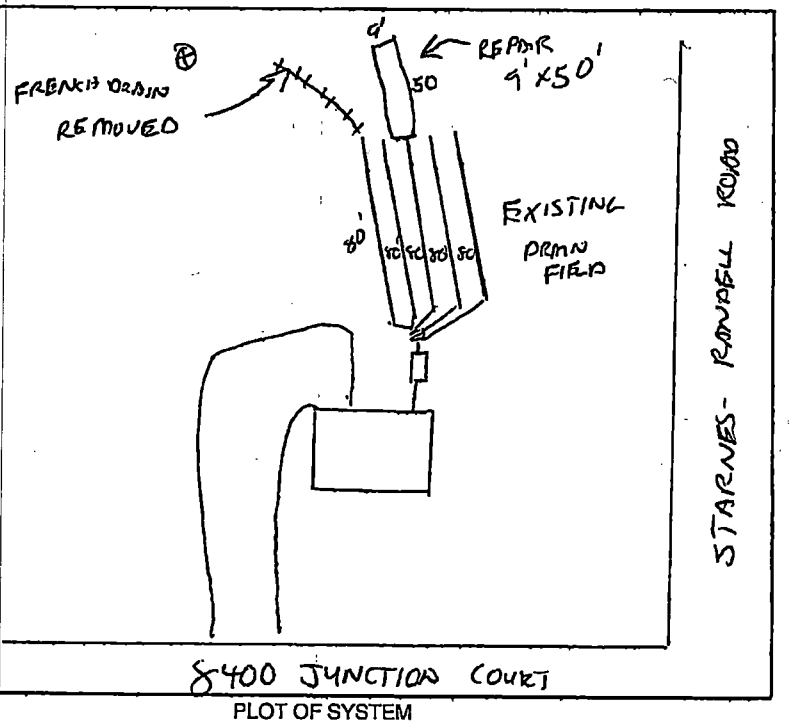

PLOT OF SYSTEM

Liquid Capacity of Septic Tank REPAIR EXISTING gallons

Liquid Capacity of Dosing Tank NA gallons

Tank Construction PCC

Trench Depth 30"

Absorption and/or Nitrification Lines:

Trench Width 3' feet

Trench Walls Scored and Porous OFS

Total Line Length 150' feet

Number of Lines 1

Depth of Stone 12" inches

Distance from House 25' feet

Distance from Property Line 10' feet

Distance from Well >50' feet

NOTICE: This system shall not be installed while soils are in a wet condition.


NAME OF OWNER MARY JUNE NESHAT

LOCATION OF PROPERTY 8400 JUNCTION COURT

Comments: (1) EXISTING BED 3' x 50' w/ 12" STONE

Environmental Health Specialist

WHITE - HEALTH DEPARTMENT's COPY • CANARY - E.H.S. COPY • PINK - OWNER OR AGENT's COPY

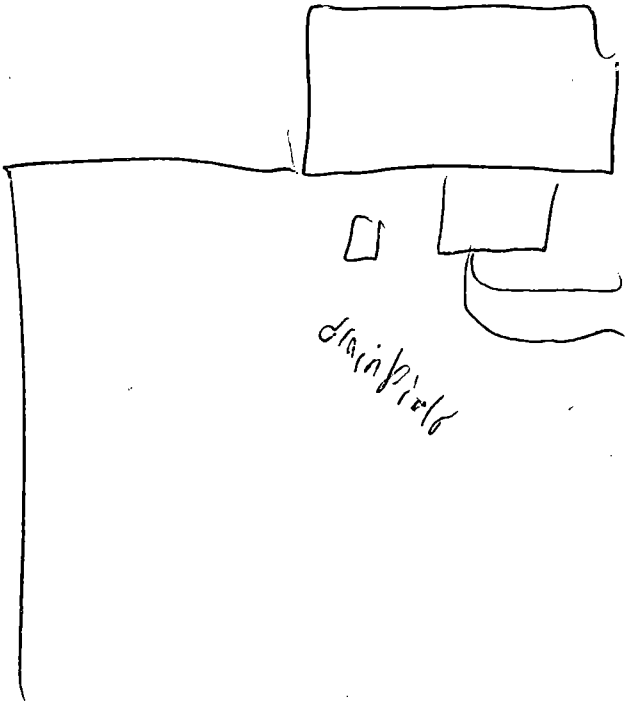

Mecklenburg County Groundwater & Wastewater Services
3205 Freedom Dr. Suite 8000 Charlotte, NC 28208
Phone: (980) 314-1680 Fax: (704) 336-6894

Septic System Pre-Construction Meeting Checklist

File # 6298 A App# 14026 1420 Tax Parcel# 111-124-86

Property Owner: CTRR

Job Location Address: 8400 Junction Ct

City: Charlotte State: NC Zip Code: 28215

1. Does System design match facility, flow & wastewater characteristics?

   ☑ YES ☐ NO

   Comments: _____

2. Is there sufficient available space for the septic systems initial and repair areas?

   ☑ YES ☐ NO

   Comments: _____

3. Can the septic system be installed per the permit conditions and drawing on file?

   ☑ YES ☐ NO

   Comments: _____

*If "NO" is checked for any of the above the existing permit may need to be revoked.

Permission is hereby given to ☑ install ☐ alter ☐ repair an on-site wastewater treatment & and disposal system, with subsurface soil absorption and effluent discharge meeting all of the construction requirements of 15A NCAC 18A .1900 which are in effect on the date of granting this approval. **System shall not be installed while soils are in wet condition.**

B. Davenport
Authorized Agent

8/18/23
Date

Union Septic
Others Present

Mecklenburg County Groundwater & Wastewater Services
700 N. Tryon St., Suite 211 Charlotte, NC 28202
Phone: (704) 336-5103 Fax: (704) 336-6894

NC DHHS
Division of Environmental Health
On-Site Wastewater Section

IMPROVEMENT PERMIT/CONSTRUCTION AUTHORIZATION for an ON-SITE WASTEWATER TREATMENT & DISPOSAL SYSTEM

File #: 6298A Permit #: 14026 Tax Parcel #: 1111 2486

Property Owner: CTRR LLC

Job Location Address: 8400 Junction ct

City: Charlotte State: NC Zip Code: 28215

Improvement Permit Issuance Date: 8/2/23 **Construction Authorization Issuance Date** 8/2/23

Permission is hereby given to ☒ install ☐ alter ☐ repair an on-site wastewater treatment & and disposal system, with subsurface soil absorption and effluent discharge, as specified herein at the described location. This permit is granted based upon the application information submitted to our office. This permit expires 5 years from the date it was issued. The system shall meet all of the construction requirements of 15A NCAC 18A. 1900 which are in effect on the date of granting this approval. An **Operation Permit** must be obtained from the Mecklenburg County Health Department before any system can be covered up or placed into service. The issuance of this permit does not in any way guarantee that the system anticipated to be constructed will operate properly, or relieve any person now of hereafter owning, controlling or using such system from any liability resulting from the failure of the system to operate properly.

***NOTICE: This system shall not be installed while soils are in a wet condition.**

Permitted Design Flow: Existing GPD

Liquid Capacity of Septic Tank: 1000 gallons

Site LTAR: — GPD/ft² (For new installations only.)

Liquid Capacity of Dosing Tank: — gallons

Drainfield Design ☒ N/A

Trench Depth: _____ inches

Trench Width: _____ feet

Line Spacing: _____ feet (O.C.)

Total line length: _____ feet

# of Lines: _____ @ _____ feet

Depth of Media: _____ inches (Type) _____

Distribution Device: _____

Existing drain field (Re-connect)

Bed Design *(For Repair Installations ONLY.)* ☒ N/A

Bed Depth: _____ inches

Bed Width: _____ feet

Total line length: _____ feet

# of Lines: _____ @ _____ feet

Depth of Media: _____ inches (Type) _____

Distribution Device: _____

Water Supply Source

☐ Municipal ☐ Private Well ☐ Community Well


☐ Other _____

Minimum System Setbacks

Distance from Building Foundation: _____ feet

Distance from Property Line: _____ feet

Distance from Water Supply Source: _____ feet

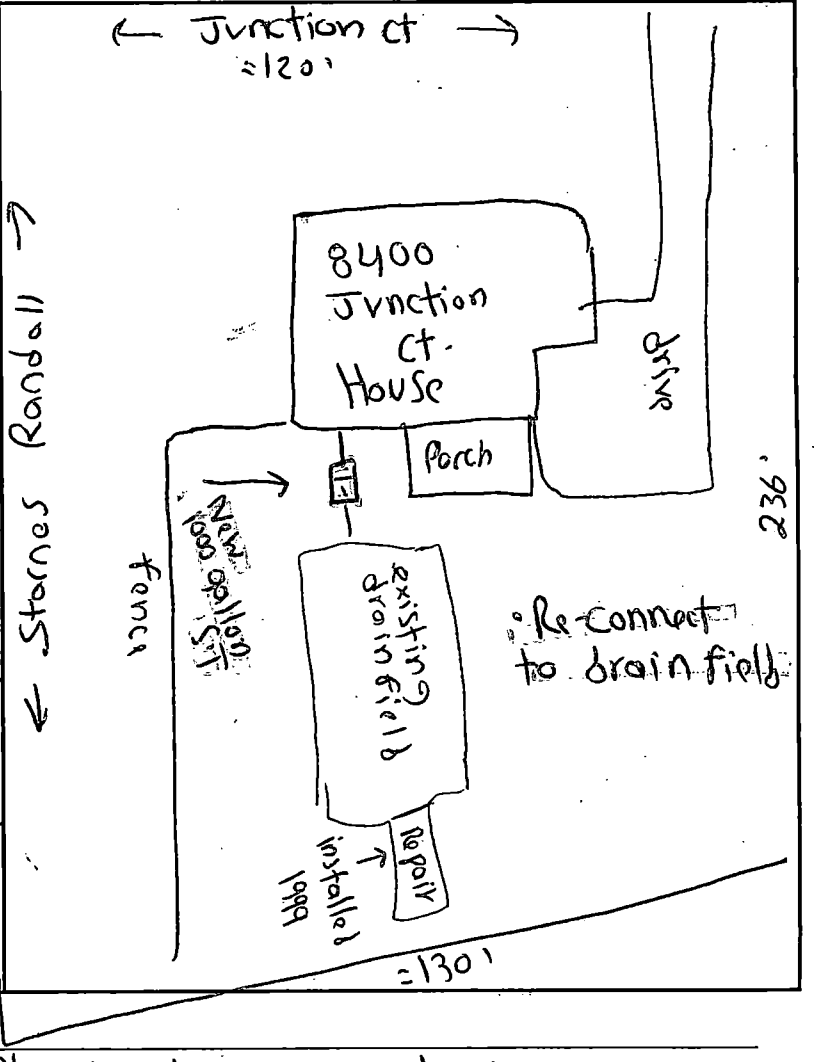

Comments: System Classification & Type:

New 1000 Septic tank, Abandon the existing tank,

Authorized Agent: Braedon Shelton Signature: Braedon Shelton

Owner Signature: _____ Date: _____

Mecklenburg County Groundwater & Wastewater Services
3205 Freedom Dr. Suite 8000, Charlotte, NC 28208
Phone: (980) 314-1680 | Fax: (704) 336-6894

NC DHHS
Division of Environmental Health
On-Site Wastewater Section

OPERATION PERMIT for an ON-SITE WASTEWATER TREATMENT & DISPOSAL SYSTEM

File #: 6298A Permit #: 14026 Tax Parcel #: 111-124-86

Property Owner: CTRR

Job Location Address: 8400 Junction ct

City: Charlotte State: NC Zip Code: 28215

Operation Permit Issuance Date: 8/18/23 Contractor Name: Union Septic

Permitted Design Flow: existing GPD Liquid Capacity of Dosing Tank: NA gallons

Liquid Capacity of Septic Tank: 1000 gallons Tank Manufacture J/S Effluent Pump Model: NA

STB-57 1000 gal J/S 5/11/23

Drainfield Installation ☑ N/A

Trench Depth: _____ inches

Trench Width: _____ feet

Line Spacing: _____ feet (O.C.)

Total line length: _____ feet

# of Lines: _____ @ _____ feet

Depth of Media: _____ inches (Type) _____

Depth of Cover: _____ inches

Distribution Device: _____

Bed Installation *(For Repair Installations ONLY.)* ☑ N/A

Bed Depth: _____ inches

Bed Width: _____ feet

Total line length: _____ feet

# of Lines: _____ @ _____ feet

Depth of Media: _____ inches (Type) _____

Depth of Cover: _____ inches

Distribution Device: _____

Water Supply Source

☑ Municipal ☐ Private Well ☐ Community Well

☐ Other _____

System Installation Setbacks

Distance from Building Foundation: 7 feet

Distance from Property Line: 50* feet

Distance from Water Supply Source: 10 feet


Inspection Dates

Tank(s) Inspected: 8/18/23

Excavation Inspected: 8/18/23

Pump & Controls Inspected: NA

SKETCH OF SYSTEM INSTALLATION
(As-Built Drawing)

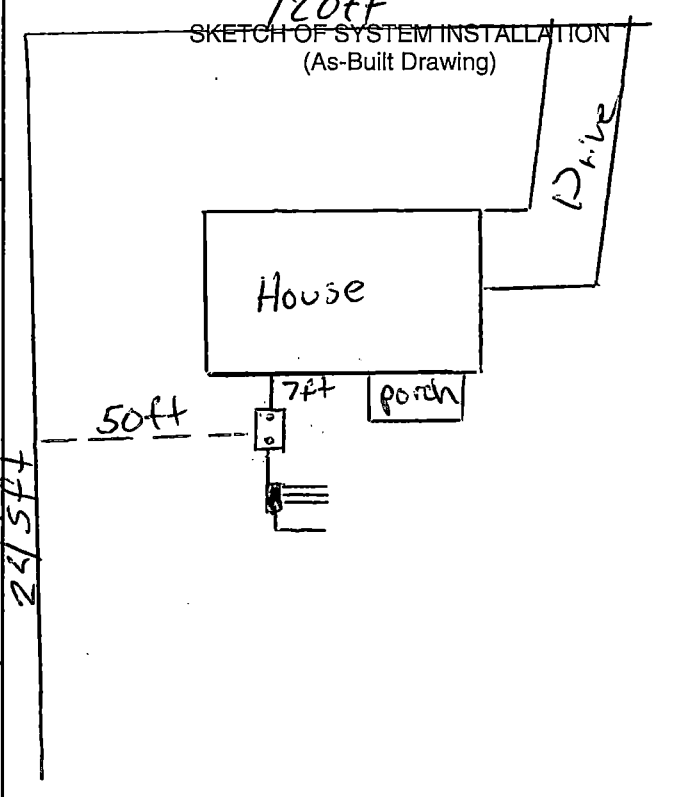

The undersigned has inspected the Septic Tank System described above, and certifies it has been ☐ installed ☐ altered ☑ repaired ☐ as detailed in the plot above ☑ in accordance with the permit issued and meets the provisions of 15A NCAC 18A. 1900, "Laws and Rules for Sewage Treatment and Disposal Systems" in effect on the date of issuance of the permit. The issuance of this Operation Permit does not in any way guarantee that the system will operate properly or relieve any person now or hereafter owning, controlling, or using such system from any liability resulting from the failure of the system to operate properly. This document is issued subject to those restrictions and conditions shown on the permit(s) and the provisions of 15A NCAC 18A. 1900 in addition to those listed below under "Comments." This document shall be null and void if any information contained in the application is untrue or if any additions are made to the property which would increase the requirements for said system.

Notice: Disturbance of the designated repair area may result in the Suspension or Revocation of this permit.

Comments: System Classification & Type: Tank | G | NA | NA

DENR Authorized Agent: BDavenport Signature: B. Davenport

Mecklenburg County Groundwater & Wastewater Services
3205 Freedom Dr. Suite 8000, Charlotte, NC 28208
Phone: (980) 314-1680 Fax: (704) 336-6894

NC DHHS
Division of Environmental Health
On-Site Wastewater Section

OPERATION PERMIT for an
ON-SITE WASTEWATER TREATMENT & DISPOSAL SYSTEM

File #: 6298A Permit #: 14026 Tax Parcel #: 111-124-86

Property Owner: CTRR

Job Location Address: 8400 Junction Ct

City: Charlotte State: NC Zip Code: 28215

OPERATION PERMIT CONDITIONS:

I. Performance: System shall perform in accordance with 15A NCAC 18A .1961.

II. Monitoring: System shall be monitored as required by 15A NCAC 18A .1961.

III. Maintenance: Ground absorption sewage treatment and disposal systems shall be checked, and the contents of the septic tank removed, periodically from all compartments, to ensure proper operation of the system. The contents shall be pumped whenever the solids level is found to be more than 1/3 of the liquid depth in any compartment.

IV. Operation: System shall be operated in accordance with 15A NCAC 18A .1961.

System Classification: Tank

*Operation Permits for Type V and VI systems expire five (5) years from the date of issuance (in accordance with Table V(a)). The system owner must contact GWS six (6) months prior to expiration for permit renewal.

Subsurface system operator required: Yes ☐ No ☐

☐ This type of system requires the system owner to maintain a contract with a certified operator to perform system inspection, maintenance, and reporting as required in 15A NCAC 18A .1961. and Table V(a). The system owner is responsible for all fees associated with these services.

☒ System does not require inspection by GWS on a routine frequency.

☐ System requires inspection by GWS once every five (5) years. The system owner is responsible for all fees associated with the inspection.

☐ System requires inspection by GWS once every three (3) years. The system owner is responsible for all fees associated with the inspection.

☐ System requires inspection by GWS once every twelve (12) months. The system owner is responsible for all fees associated with the inspection.

☐ System requires inspection by GWS once every six (6) months. The system owner is responsible for all fees associated with the inspection.


V. Other:


DENR Authorized Agent: B. Davenport Date: 8/18/23


Signature: Bryan Davenport

Davenport, Bryan C.

From: Davenport, Bryan C.
Sent: Wednesday, August 23, 2023 12:04 PM
To: Davenport, Bryan C.

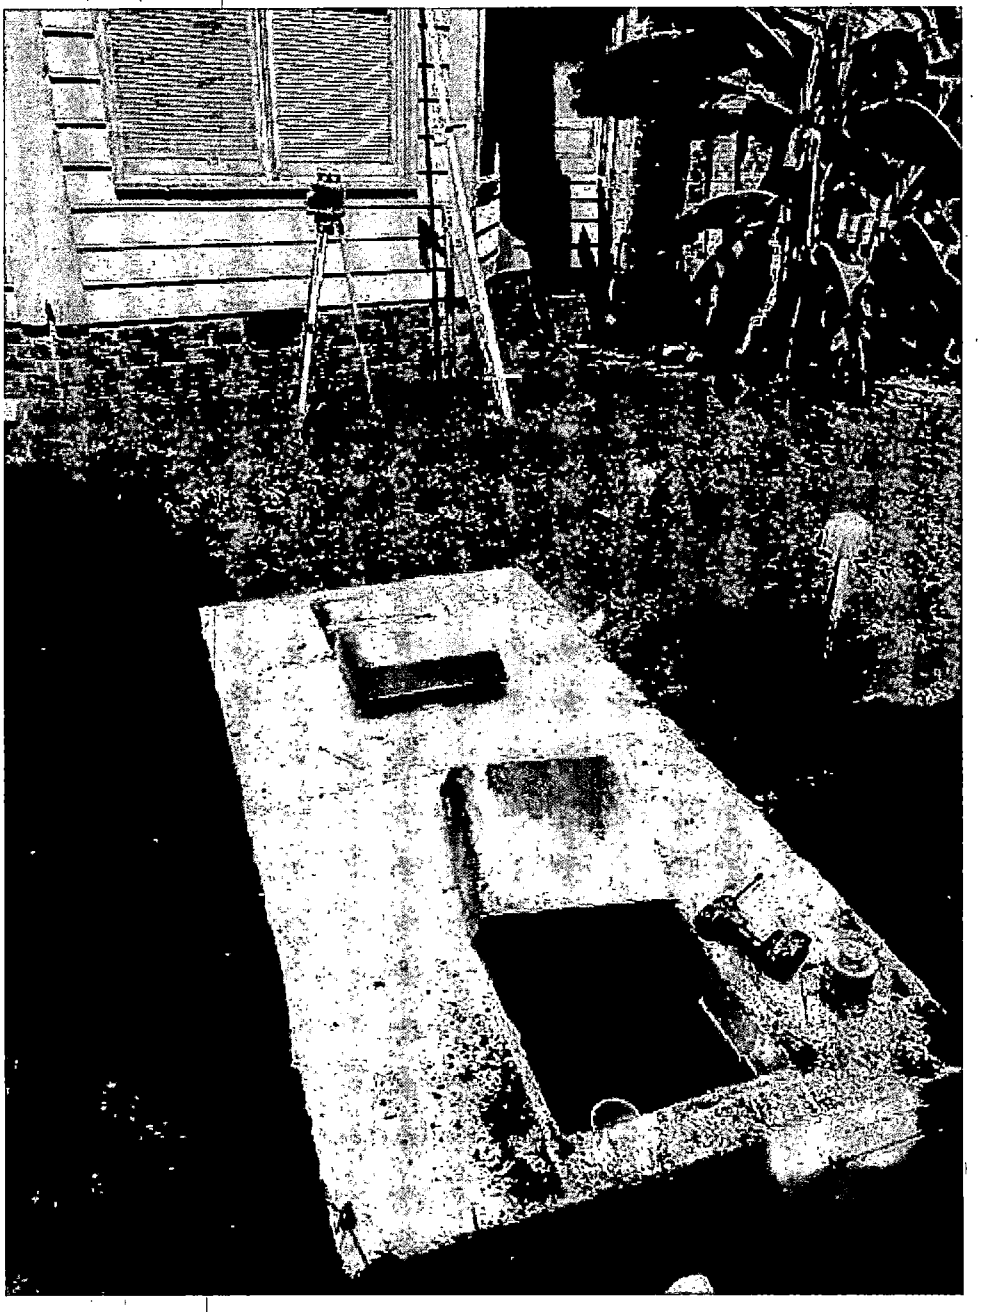

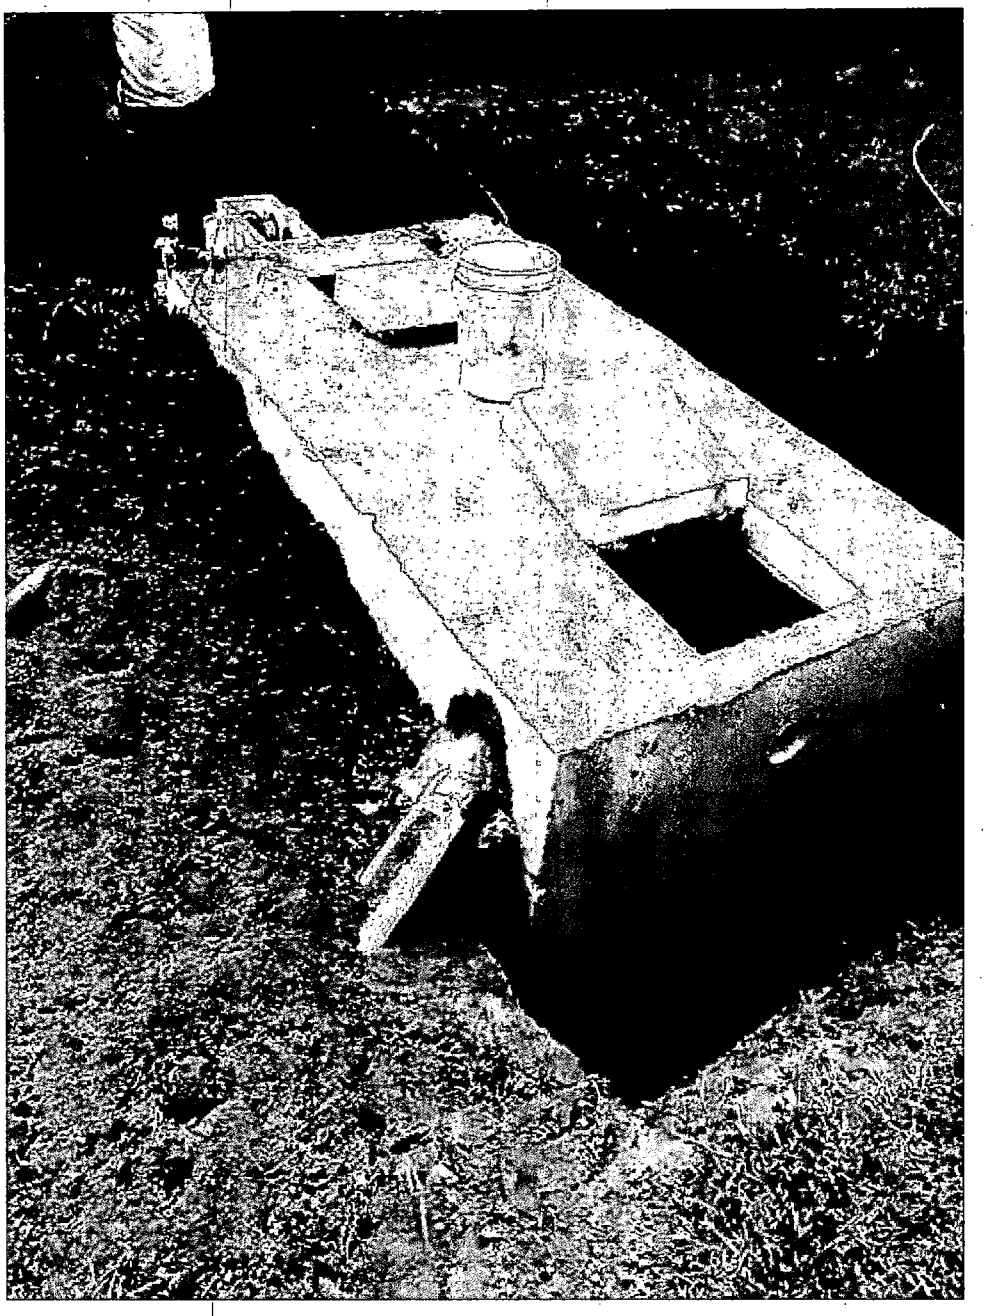

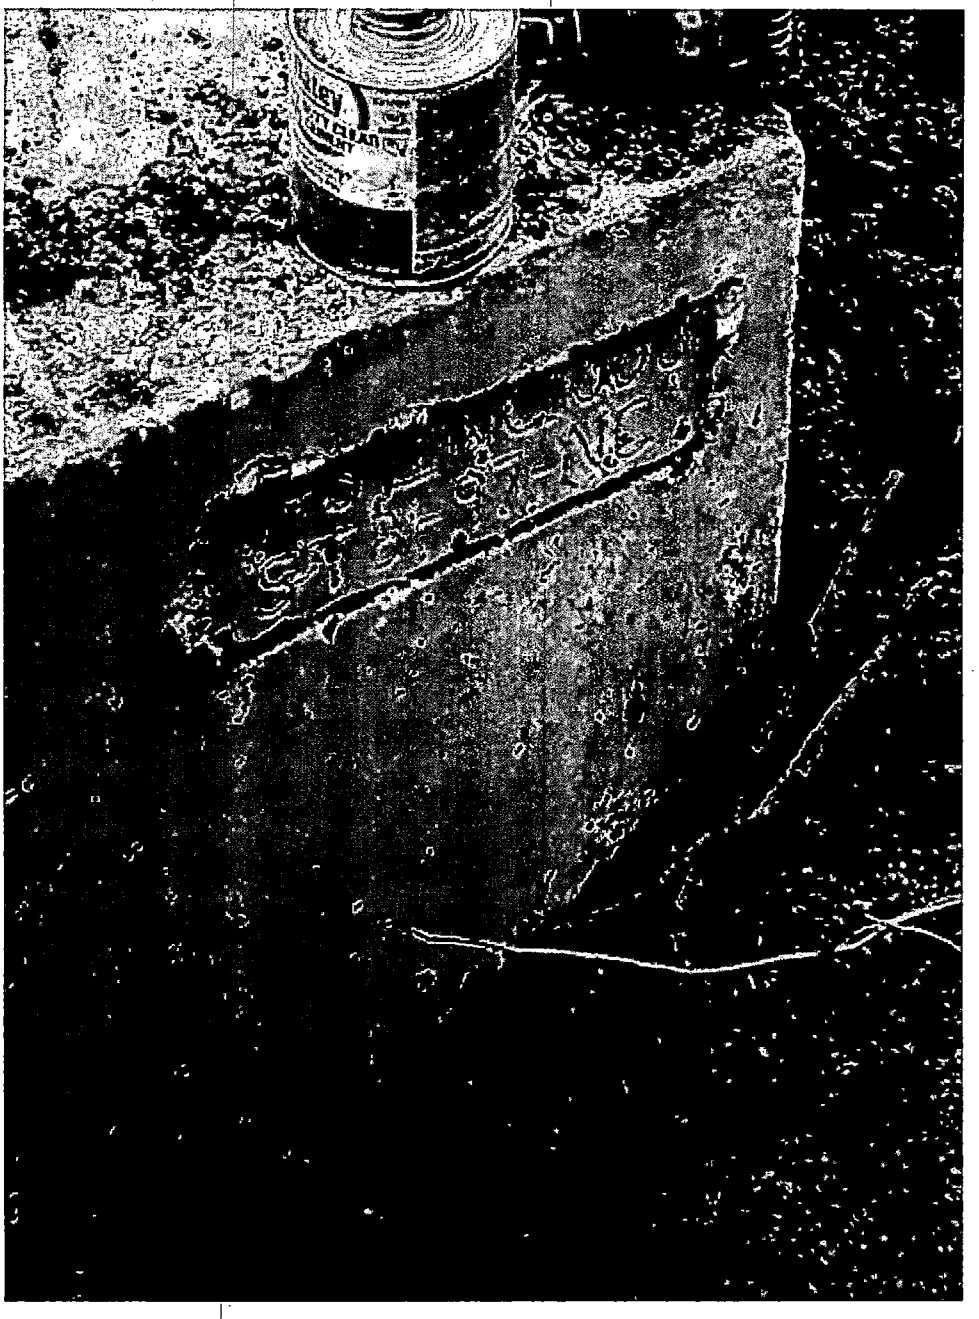

Sent from my iPhone