Date Received 7/2/79

RECEIVED
JUN 28 1979
MECKLENBURG COUNTY DEPARTMENT OF ENVIRONMENTAL HEALTH

(CARIS) Application No. 15834

T. C. No. 061-221-01


Map Date 9/9/74

MECKLENBURG COUNTY
DEPARTMENT OF ENVIRONMENTAL HEALTH

Application for an
Installation, Construction, Alteration, and/or Repair Permit
(Individual Septic Tank System with Subsurface, Soil Absorption, Effluent Discharge)

The owner of that property described hereinafter hereby applies to the Mecklenburg County Department of Environmental Health for a permit to:

1) ___ Install or Construct 2) X Alter or Repair an individual septic tank wastewater treatment system with a subsurface, soil absorption, effluent discharge.

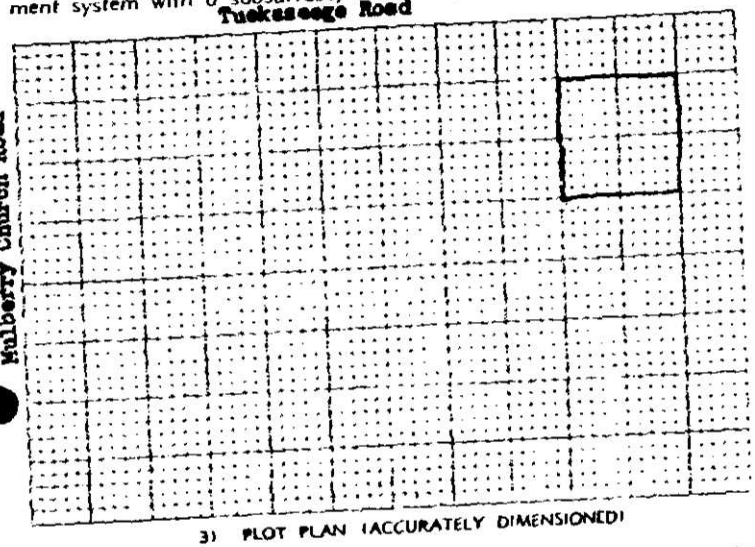

3) PLOT PLAN (ACCURATELY DIMENSIONED)

Mobile Home ___ Yes ___ No
Residence X Yes ___ No

4) No of Bedrooms 3
5) Business Use — Max No Employees ___
6) Washing Machine X Yes ___ No
7) Garbage Disposal ___ Yes X No
8) Dishwasher ___ Yes X No
9) Water Supply
A) Individual Well X
B) Governmental System ___
C) Community System
1 Well source ___
2 Governmental source ___
10) Sewage System
House located within 200 feet of public sewer ___ Yes X No
House located within 200 feet of community sewer ___ Yes X No
11) FHA Case No ___
12) VA Case No ___

13) NAME OF OWNER Mulberry Presbyterian Church (Manse)
LAST FIRST MIDDLE

14) ADDRESS OF OWNER 5600 Tuckaseege Road, Charlotte, N. C.

15) PHONE NO. Home 394 1796 Office 392 1030

16) LOCATION OF SYSTEM 5601 Tuckaseege Road
STREET OR COUNTY ROAD

17) SUBDIVISION ___ Lot No. ___ Block No. ___

Map Book No. ___ Page No. ___

18) DEED REFERENCE — DEED BOOK ___ AT PAGE ___

19) HAS A SOIL INVESTIGATION BEEN RUN? ___ YES ___ NO DATE RUN ___

20) PTR NUMBER (See Instructions) ___

The undersigned person hereby agrees that he has read the foregoing application and that the contents of same are true. It is understood that any permit applied for herein shall be void and of no effect if any of the above facts are not true.

June 27, 1979
DATE OF APPLICATION

Mulberry Presbyterian Church
OWNER

CHD-S-76

ENVIRONMENTAL HEALTH DEPARTMENT'S COPY

Date Issued 7-6-79 Serial No. 2916


ICAR(S) Permit No. 15834

T C No. 061-221-01

Map Date

MECKLENBURG COUNTY
DEPARTMENT OF ENVIRONMENTAL HEALTH
INSTALLATION, CONSTUCTION, ALTERATION, AND/OR REPAIR PERMIT
(Individual Septic Tank System with Subsurface, Soil Absorption, Effluent Discharge)

Permission is hereby given to ___Install or Construct, ✓ Alter or Repair the individual septic tank wastewater treatment system with subsurface, soil absorption, effluent discharge as specified herein at the described location. This permit is granted based upon the information supplied in application 15834 dated 7-2-79 and this permit shall be void and of no effect if the information provided in the application is not true or is erroneous. All work shall be completed on or before 8-2-79, after which date this permit shall be null and void.

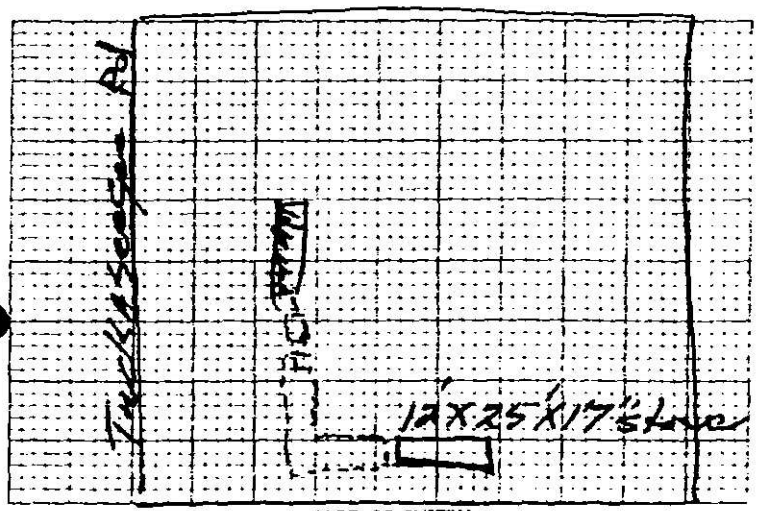

PLOT OF SYSTEM

Permeability Rate P/S

Liquid Capacity of Tank Existing

Tank Construction P/C

Absorption and or Nitrification Lines:

Total Line Length 100' E

Number of Lines 4

Distance from House 10'+

Distance from Property Line 10'+

Distance from Well City Water

NAME OF OWNER Muhlenberg Presbyterian Church

LOCATION OF PROPERTY 5604 Tuckaseege Rd. (Manse)

The system shall meet all of the construction requirements as set forth in the Regulations of the Mecklenburg County Health Commission which are in effect on the date of the granting of this permit. A certificate of approval must be issued by the Environmental Health Director before any system can be covered up or otherwise rendered uninspectable or can be used.

THE ISSUANCE OF THIS PERMIT DOES NOT IN ANY WAY GUARANTEE THAT THE SYSTEM AS INSTALLED TO BE CONSTRUCTED WILL OPERATE PROPERLY OR RELIEVE ANY PERSON NOW OR HEREAFTER OWNING, CONTROLLING OR USING SUCH SYSTEM FROM ANY LIABILITY RESULTING FROM THE FAILURE OF THE SYSTEM TO OPERATE PROPERLY.

Comments:

Division or Section Head

Environmentalist Mahlon Edwards

* If this permit is for the installation or construction of a new system, it must be signed by the division or a section head of the Department of Environmental Health in order to be valid. Only the signature of the Environmentalist is required where an existing system is being altered or repaired.

EHD-5-76

Environmental Health Department's Copy

J Date Issued 7-11-79 Serial No. 2809 C of A (s) No. 15834

Q.C. No. 96-221-01

MECKLENBURG COUNTY
DEPARTMENT OF ENVIRONMENTAL HEALTH

ENVIRONMENTAL HEALTH DIVISION

CERTIFICATE OF COMPLETION

CERTIFICATE OF APPROVAL

(Individual Septic Tank System with Subsurface, Soil Absorption, Effluent Discharge)

Name of Owner Mulberry Presbyterian Church
(LAST FIRST MIDDLE)

Location of Property 5601 Tuckaseegee Rd

Application Number 15834 Permit Number 15834

Inspection Data:

Liquid Capacity of Tank Existing Tank Material Existing

Total Length of Drain Tile 100' Number of Lines 5

Depth of Filter Material 17" Cover Depth 24"

Water Supply Source City water Distance from Water Source 10'+


Excavation Inspected 7-11-79 (DATE) Tank Inspected 7-11-79 (DATE)

Nitrification Field Inspected 7-11-79 (DATE)

Washing Machine Line Inspected, If Applicable N.A (DATE)

The undersigned has inspected the Individual Septic Tank System with subsurface, soil absorption, effluent discharge as described above and it has been ___ installed or constructed, ✓ altered or repaired in accordance with the permit issued and the regulations of the Mecklenburg County Health Commission in effect on the date of issuance of the permit. The issuance of this Certificate of Approval does not in any way guarantee that the system will operate properly or relieve any person now or hereafter owning, controlling, or using such system from any liability resulting from the failure of the system to operate properly. This Certificate of Approval is issued subject to those restrictions and conditions shown on the permit(s) in addition to those listed below under comments. This Certificate of Approval shall be null and void if any information contained in the application is untrue or if any additions are made to the property which would increase the requirements for said system

Comments

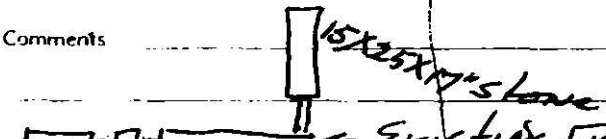

Tuckaseegee Rd

Environmentalist

EHD-5-76

Environmental Health Department's Copy