

17800 SNUG HARBOR RD

21717235

5/13/08

marliwr

Groundwater and Wastewater Services File Imaging Project
May 2007
Barcode Font = IDAutomationHC39M

Date Received 12-13-70

ICAR(S) Application No. 2-21

T C No. _____


MECKLENBURG COUNTY HEALTH DEPARTMENT

ENVIRONMENTAL HEALTH DIVISION

Application for an
Installation, Construction, Alteration, and/or Repair Permit
(Individual Septic Tank System with Subsurface, Soil Absorption, Effluent Discharge)

The owner of that property described hereinafter hereby applies to the Mecklenburg County Health Department for a permit to:

1) ✓ Install or Construct 2) _____ Alter or Repair an individual septic tank wastewater treatment system with a subsurface, soil absorption, effluent discharge.

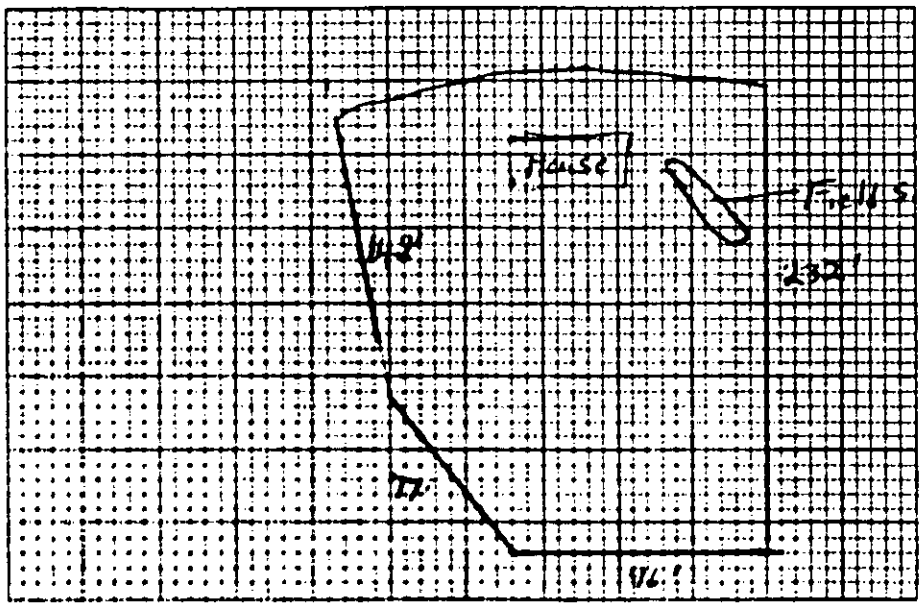

3) PLOT PLAN (ACCURATELY DIMENSIONED)

4) No. of Bedrooms 4

5) Business Use — Max No Employees _____

6) Washing Machine ____ Yes ✓ No

7) Garbage Disposal ✓ Yes ____ No

8) Dishwasher ✓ Yes ____ No

9) Water Supply:
A) Individual Well ✓
B) Governmental System _____
C) Community System:
1. Well source _____
2. Governmental source _____

10) Sewage System:
House located within 200 feet of public sewer ____ Yes ✓ No
House located within 200 feet of community sewer ____ Yes ✓ No

11) FHA Case No. _____

12) VA Case No. _____

13) NAME OF OWNER Biddix (LAST) Clarence (FIRST) Finley (MIDDLE)

14) ADDRESS OF OWNER 232 N. Tennessee St Charlotte, N.C.

15) PHONE NO. Home 376-7111 Office 332-2089

16) LOCATION OF SYSTEM Steele Creek Harbor Road
(Name of Development) (STREET OR COUNTY ROAD)

17) SUBDIVISION Hill Royle Tract Lot No. 49 Block No. _____

Map Book No _____ Page No. _____

18) DEED REFERENCE -- DEED BOOK 3021 AT PAGE 197

19) HAS A PERCOLATION TEST BEEN RUN? ✓ YES ____ NO DATE RUN 10-7-70

The undersigned person hereby agrees that he has read the foregoing application and that the contents of same are true. It is understood that any permit applied for herein shall be void and of no effect if any of the above facts are not true.

12-13-70
DATE OF APPLICATION

Clarence F. Biddix
OWNER

FORM NO E-4-7-1-70

HEALTH DEPARTMENT'S COPY

Date Issued 9/30/73

Serial No. 4273

ICAR(S) Permit No. 221

T. C. No.

Map Date


MECKLENBURG COUNTY HEALTH DEPARTMENT

ENVIRONMENTAL HEALTH DIVISION

INSTALLATION, CONSTRUCTION, ALTERATION, AND/OR REPAIR PERMIT

(Individual Septic Tank System with Subsurface, Soil Absorption, Effluent Discharge)

Permission is hereby given to X Install or Construct, ____ Alter or Repair the individual septic tank wastewater treatment system with subsurface, soil absorption, effluent discharge as specified herein at the described location. This permit is granted based upon the information supplied in application 221, dated 10/13/72 and this permit shall be void and of no effect if the information provided in the application is not true or is erroneous. All work shall be completed on or before 10/1/73, after which date this permit shall be null and void.

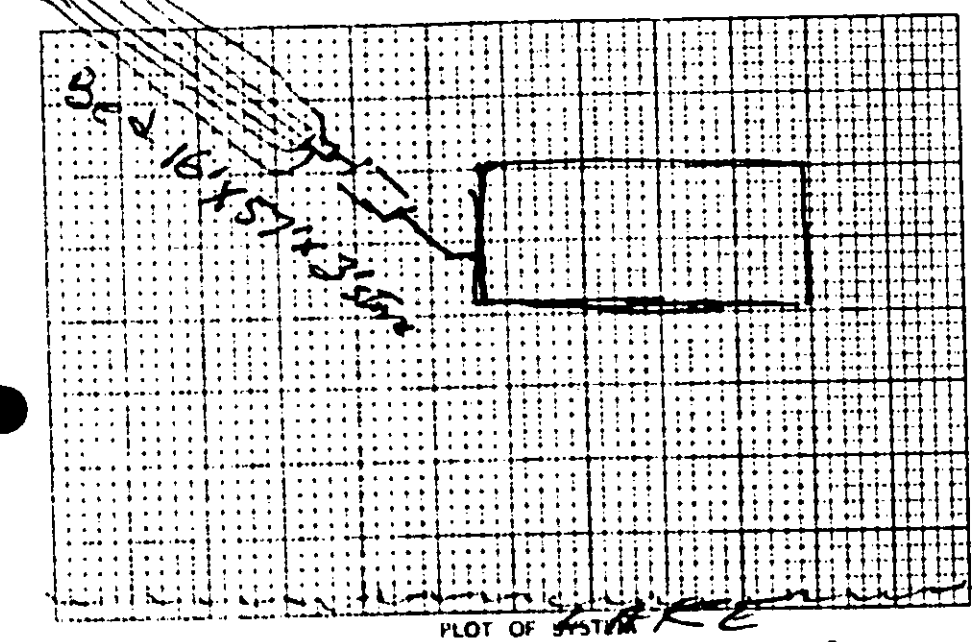

PLOT OF SYSTEM

Percolation Rate 45

Liquid Capacity of Tank 1500

Tank Construction PC

Absorption and/or Nitrification Lines:

Total Line Lenght 720'

Number of Lines 6/57'x16'x

Distance from House 10'

Distance from Property Line 10'

Distance from Well 50'+

NAME OF OWNER Clarence F. Biddix

LOCATION OF PROPERTY Snug Harbor Rd.

The system shall meet all of the construction requirements as set forth in the Regulations of the Mecklenburg County Board of Health which are in effect on the date of the granting of this permit. A certificate of approval must be issued by the Health Director before any system can be covered up or otherwise rendered uninspectable or can be used.

Comments: ~~Septic~~ drain can be split To Dive cedar tree.

L. P. Bridgeman
Environmentalist

Division or Section Head

* If this permit is for the installation or construction of a new system, it must be signed by the division or section head of the Environmental Health Division in order to be valid. Only the signature of the Environmentalist is required where an existing system is being altered or repaired.

FORM NO. E 5-4-1-71

HEALTH DEPARTMENT'S COPY

221
1/73B

INDIVIDUAL WATER AND WASTEWATER SYSTEMS PROGRAM
APPLICATION FOR SERVICES

Pd 50.00 ck# 7173 6/27/96 CRT

Mecklenburg County Health Dept.
Environmental Health Division
c/o Hal Marshall Ctr., Suite 211
700 N. Tryon St.
Charlotte, NC 28202

(704)336-5102

Date: 6/27/96

PERSON FILING APPLICATION:
NAME: Cochrane (last) Paul (first) O. (mi)
ADDRESS: 2911 Matt-Mint Hwy PHONE: 704 847-9782
CITY: Matthews STATE: NC ZIPCODE: 28105

PROPERTY INFORMATION (FROM ENGINEERING FORM):
TAX/PARCEL NUMBER: 217-171-01
STREET ADDRESS: 17800 Snug Harbor Rd.
ZONING:

PROPERTY OWNER:
NAME: Williams (last) Charles (first) M (mi)
ADDRESS: 17800 Snug Harbor Rd PHONE: 704 588-3534
CITY: Charlotte STATE: NC ZIPCODE: 28278

SUBDIVISION OR MOBILE HOME PARK NAME:

Township (check one):
[x] 0 Mecklenburg County [ ] 2 Davidson [ ] 4 Pineville [ ] 6 Huntersville
[ ] 1 Charlotte [ ] 3 Cornelius [ ] 5 Matthews [ ] 7 Mint Hill

LOT NUMBER: 49 LOT SIZE (in acres): .80

TYPE APPLICATION (check one):
[ ] EXCHANGE MOBILE HOME - SAME # BEDROOMS (Y)
[x] ADDITION - INCREASE ROOMS/OCCUPANCY/MOBILE HOME SIZE (A or M) Bedrm Ord
[ ] COMMERCIAL OR INDUSTRIAL (N)
[ ] ADDITION - GARAGE OR RENOVATION/NO MAJOR CHANGES (X)

RESIDENTIAL PROPERTY (Type Building, check one):
[ ] SINGLE MOBILE HOME (S) [x] HOUSE (H) [ ] MULTIPLE FAMILY (U)
[ ] DOUBLE WIDE (D) [ ] MODULAR HOME (M) [ ] OTHER _____ (O)

NUMBER BEDROOMS: 2 NUMBER OCCUPANTS: 2
SYSTEM CLASSIFICATION:

COMMERCIAL/INDUSTRIAL PROPERTY:
Type Business _____ # Employees ___ Per Shift ___ ___ ___
Industrial Wastes (Y/N) ___
Underground Storage Tanks On Property (Y/N) ___ Type _____

WATER SUPPLY (check one):
[ ] Community (C) [ ] Shared Well (S)
[ ] Municipal (M) [ ] Other 'spring' (O)
[x] Private Well (P)

FUTURE ADDITIONS - ALL PLANNED ADDITIONS MUST BE ENTERED (check all that apply):
[ ] Swimming Pool [ ] Jacuzzi [ ] Stable/Barn [ ] Workshop [ ] None
[ ] Garage [ ] Storage Building [ ] Deck/Patio [ ] Bedrooms [ ] Other

The undersigned, owner, or legal agent for the owner, of the property described above as the "JOB LOCATION" has read the foregoing application, acknowledges that the contents of same are true, and authorizes agents of the MECKLENBURG COUNTY HEALTH DEPARTMENT to enter onto the property for the purpose of processing this request.

Signed: Paul O. Cochrane Date: 6/27/96

NOTICE:

The undersigned, an authorized agent of the MECKLENBURG COUNTY HEALTH DEPARTMENT, certifies that the Department has approved the the Request for the Job Location contained in this document. This approval is granted in accordance with the provisions of Laws And Rules For Sanitary Sewage Collection, Treatment And Disposal in effect at the time of issuance of the permit and is subject to the following provisions:

...No work shall be conducted on the septic tank system until an installation, Construction, Alteration and/or Repair approval is granted by this Department.

...This permit is not transferable.


[ ] IMPROVEMENT PERMIT - VALID 60 MONTHS FROM ISSUANCE
[ ] MOBILE HOME EXCHANGE APPROVAL - VALID 6 MONTHS FROM ISSUANCE
[X] ADDITION/RENOVATION APPROVAL - VALID 1 YEAR FROM ISSUANCE

(See released) ...As per records on file and house visit today with a 2-bedroom. The records shows that the existing septic system may be under a part of the existing driveway. This authorization will only allow to use existing system for a 3 bedroom residence total.

Jane Higgins Bunny RS 7-10-96
Environmentalist Date

Director or Authorized Section Head Date

WATER : 122791

 


PROPOSED PLOT PLAN

HEALTH DEPARTMENT
ENVIRONMENTAL HEALTH DIVISION
700 NORTH TRYON STREET
CHARLOTTE, NC 28202
PHONE (704) 336-5102

FILE: 1473B

TC: 217-171-01

Draw in and name all roads adjoining the property. Draw in and accurately dimension the lot concerned. Accurately indicate property boundaries proposed and/or existing structures and driveways, underground utilities, and wells and springs within 100 feet of the proposed building or drainfield.

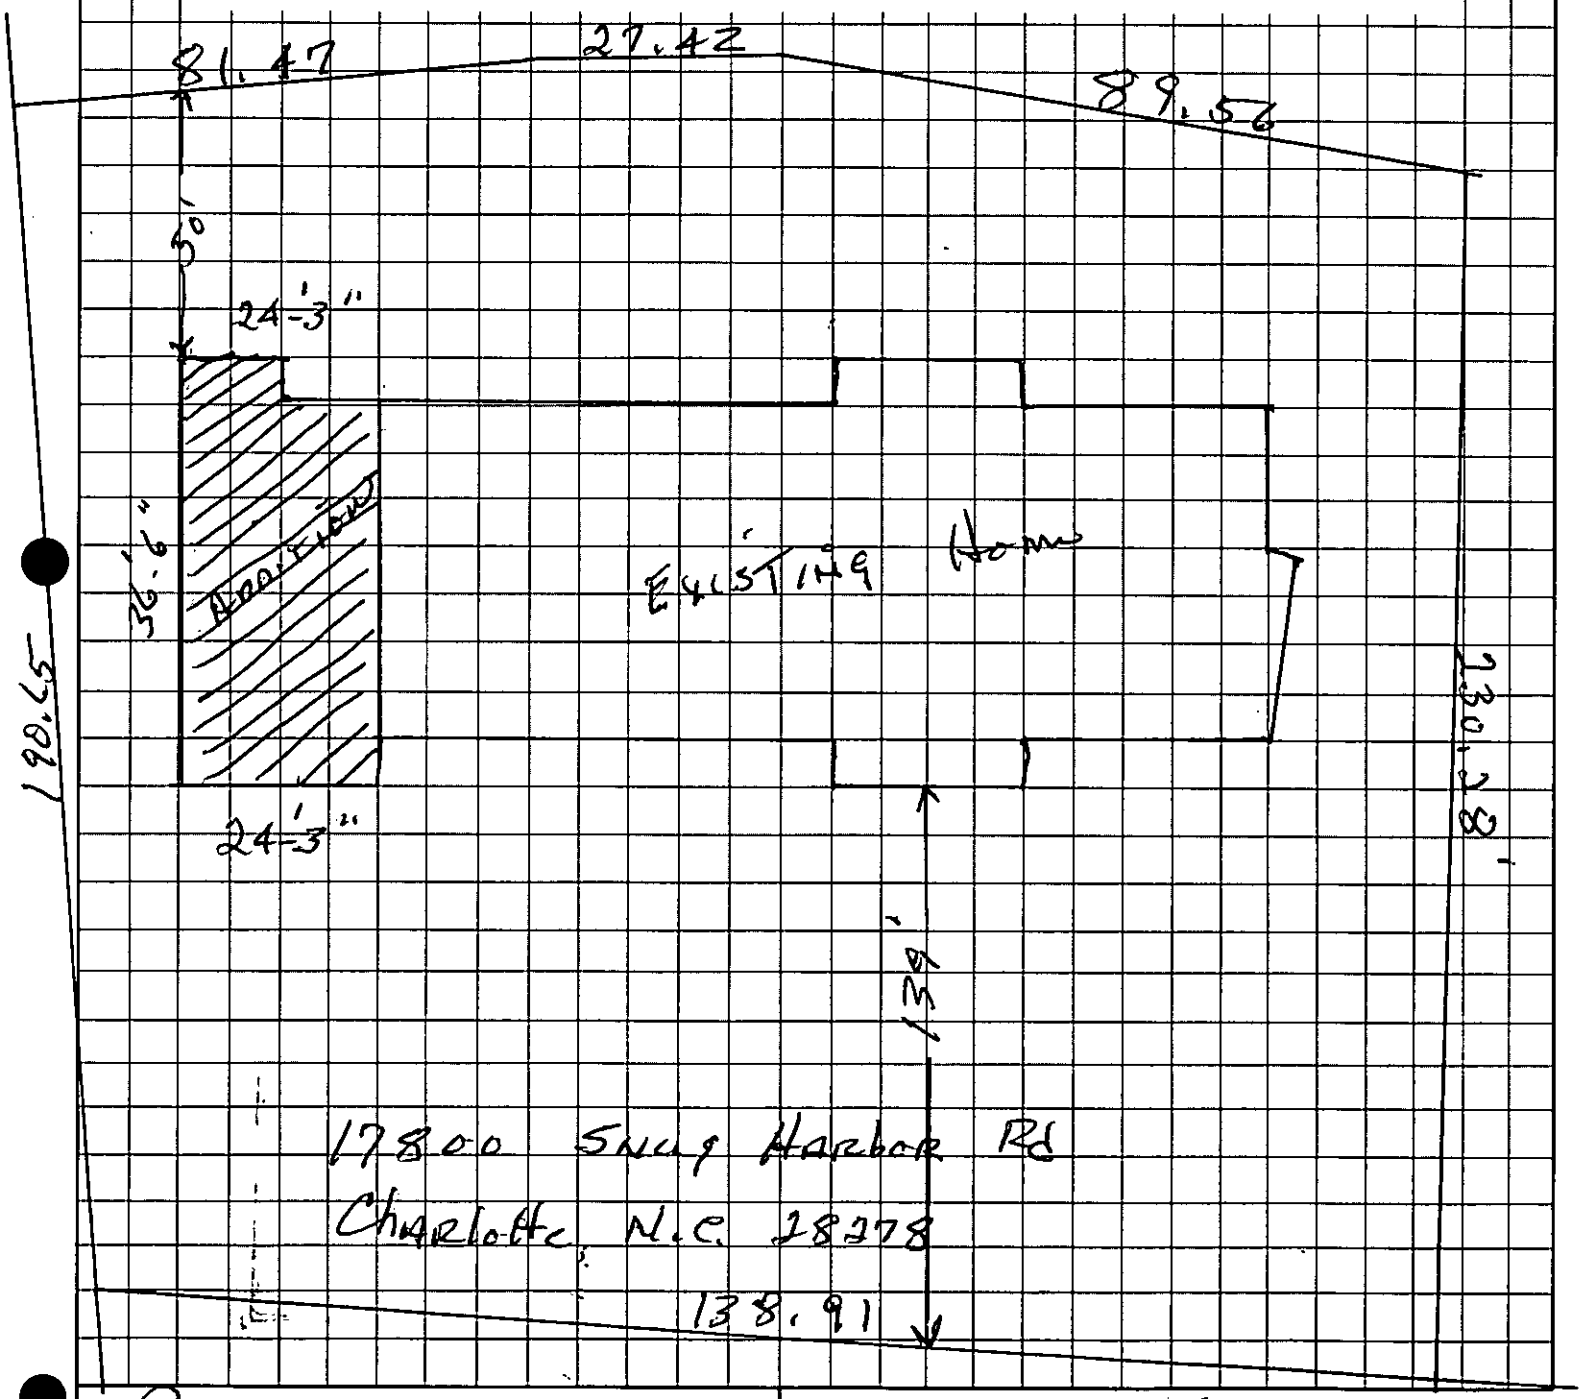


Paul D. Cochrane
OWNER/AGENT SIGNATURE

DATE 6/27/96

APPROVAL DATE 7-10-96

White - Health Department's Copy Canary - E.H.S. Copy Pink - Owner's Copy

 

PROPOSED PLOT PLAN


173B

HEALTH DEPARTMENT
ENVIRONMENTAL HEALTH DIVISION
700 NORTH TRYON STREET
CHARLOTTE, NC 28202
PHONE (704) 336-5102

FILE: 14/73B

TC: 217-171-01

Draw in and name all roads adjoining the property. Draw in and accurately dimension the lot concerned. Accurately indicate property boundaries proposed and/or existing structures and driveways, underground utilities, and wells and springs within 100 feet of the proposed building or drainfield.

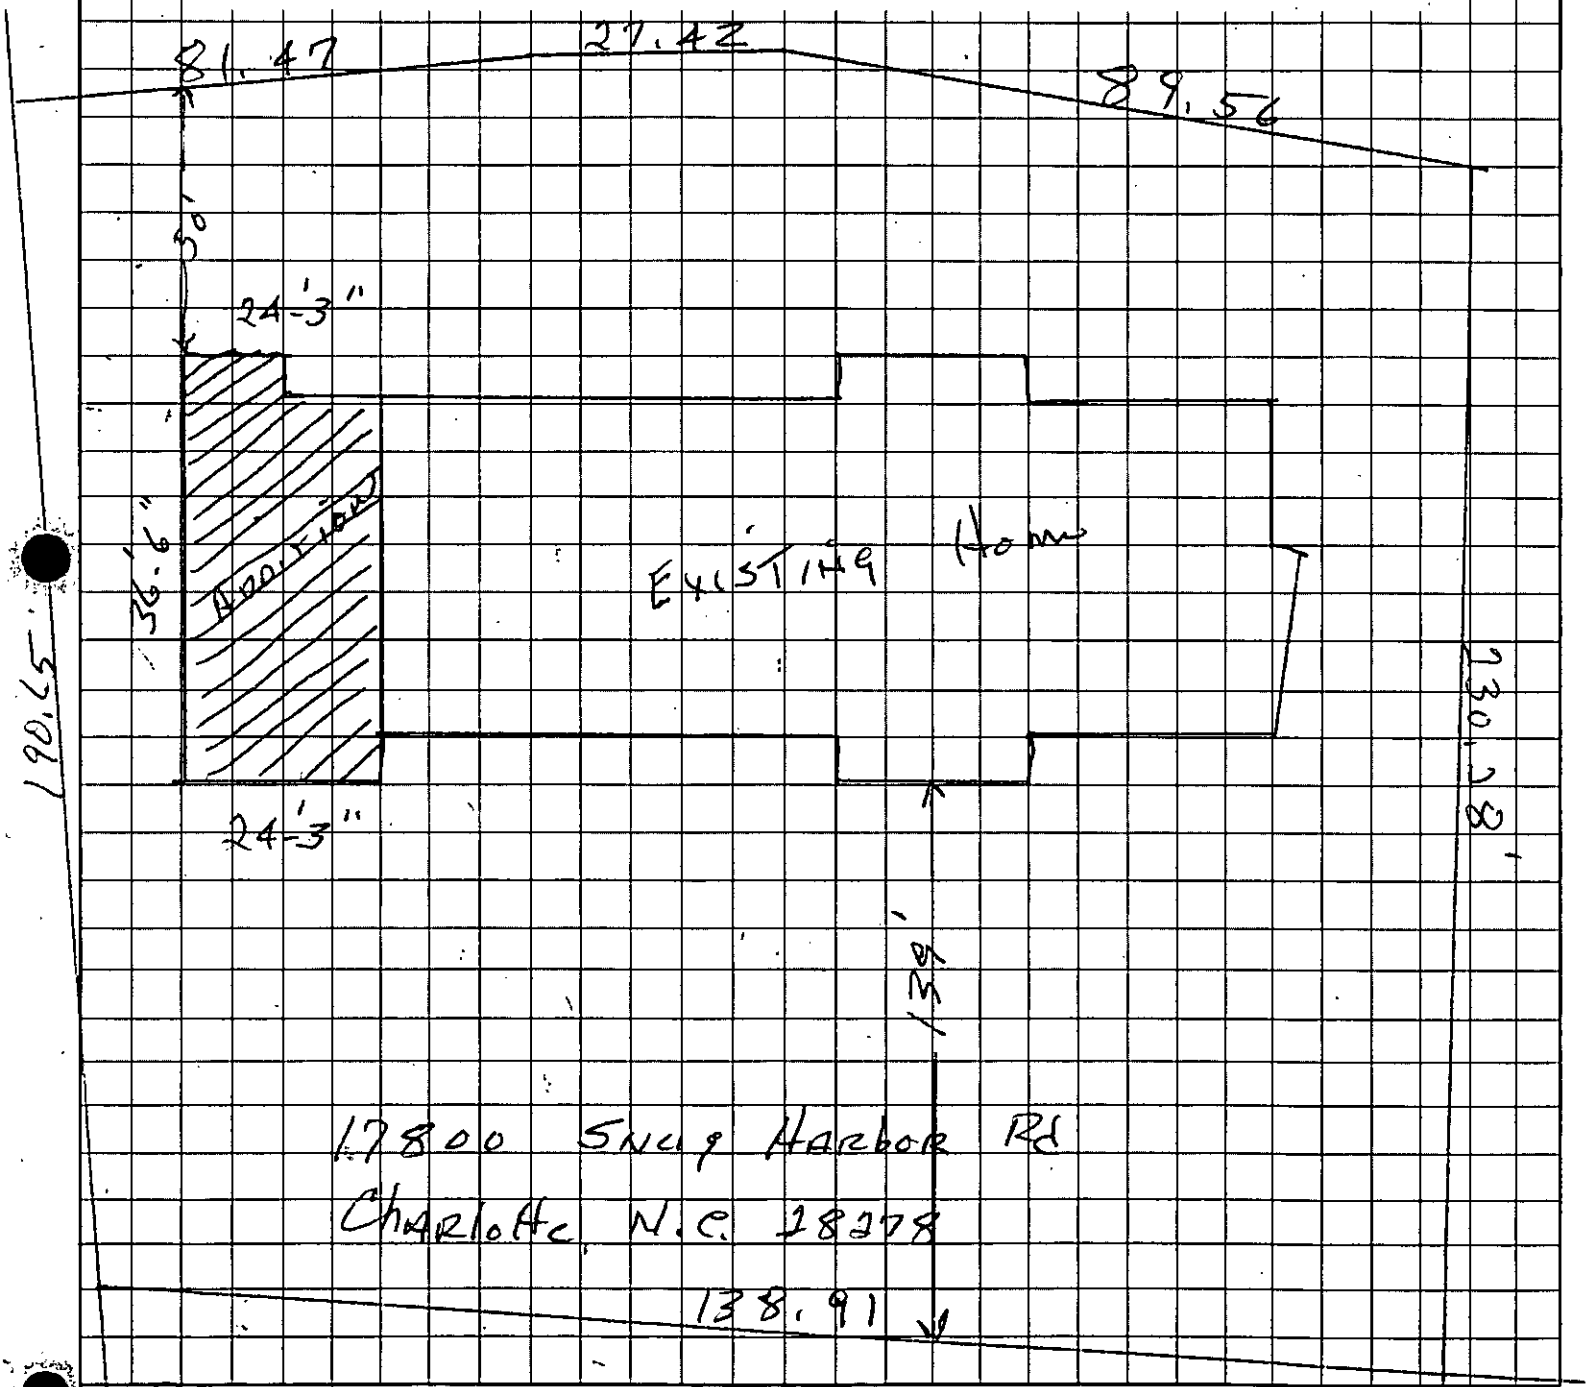

Paul D. Cochrane
OWNER/AGENT SIGNATURE

DATE 6/27/96

APPROVAL DATE 7-10-96

White - Health Department's Copy

Canary - E.H.S. Copy

Pink - Owner's Copy


PROPOSED PLOT PLAN

HEALTH DEPARTMENT
ENVIRONMENTAL HEALTH DIVISION
700 NORTH TRYON STREET
CHARLOTTE, NC 28202
PHONE (704) 336-5102

FILE: 14/73B

TC: 217-171-01

Draw in and name all roads adjoining the property. Draw in and accurately dimension the lot concerned. Accurately indicate property boundaries proposed and/or existing structures and driveways, underground utilities, and wells and springs within 100 feet of the proposed building or drainfield.

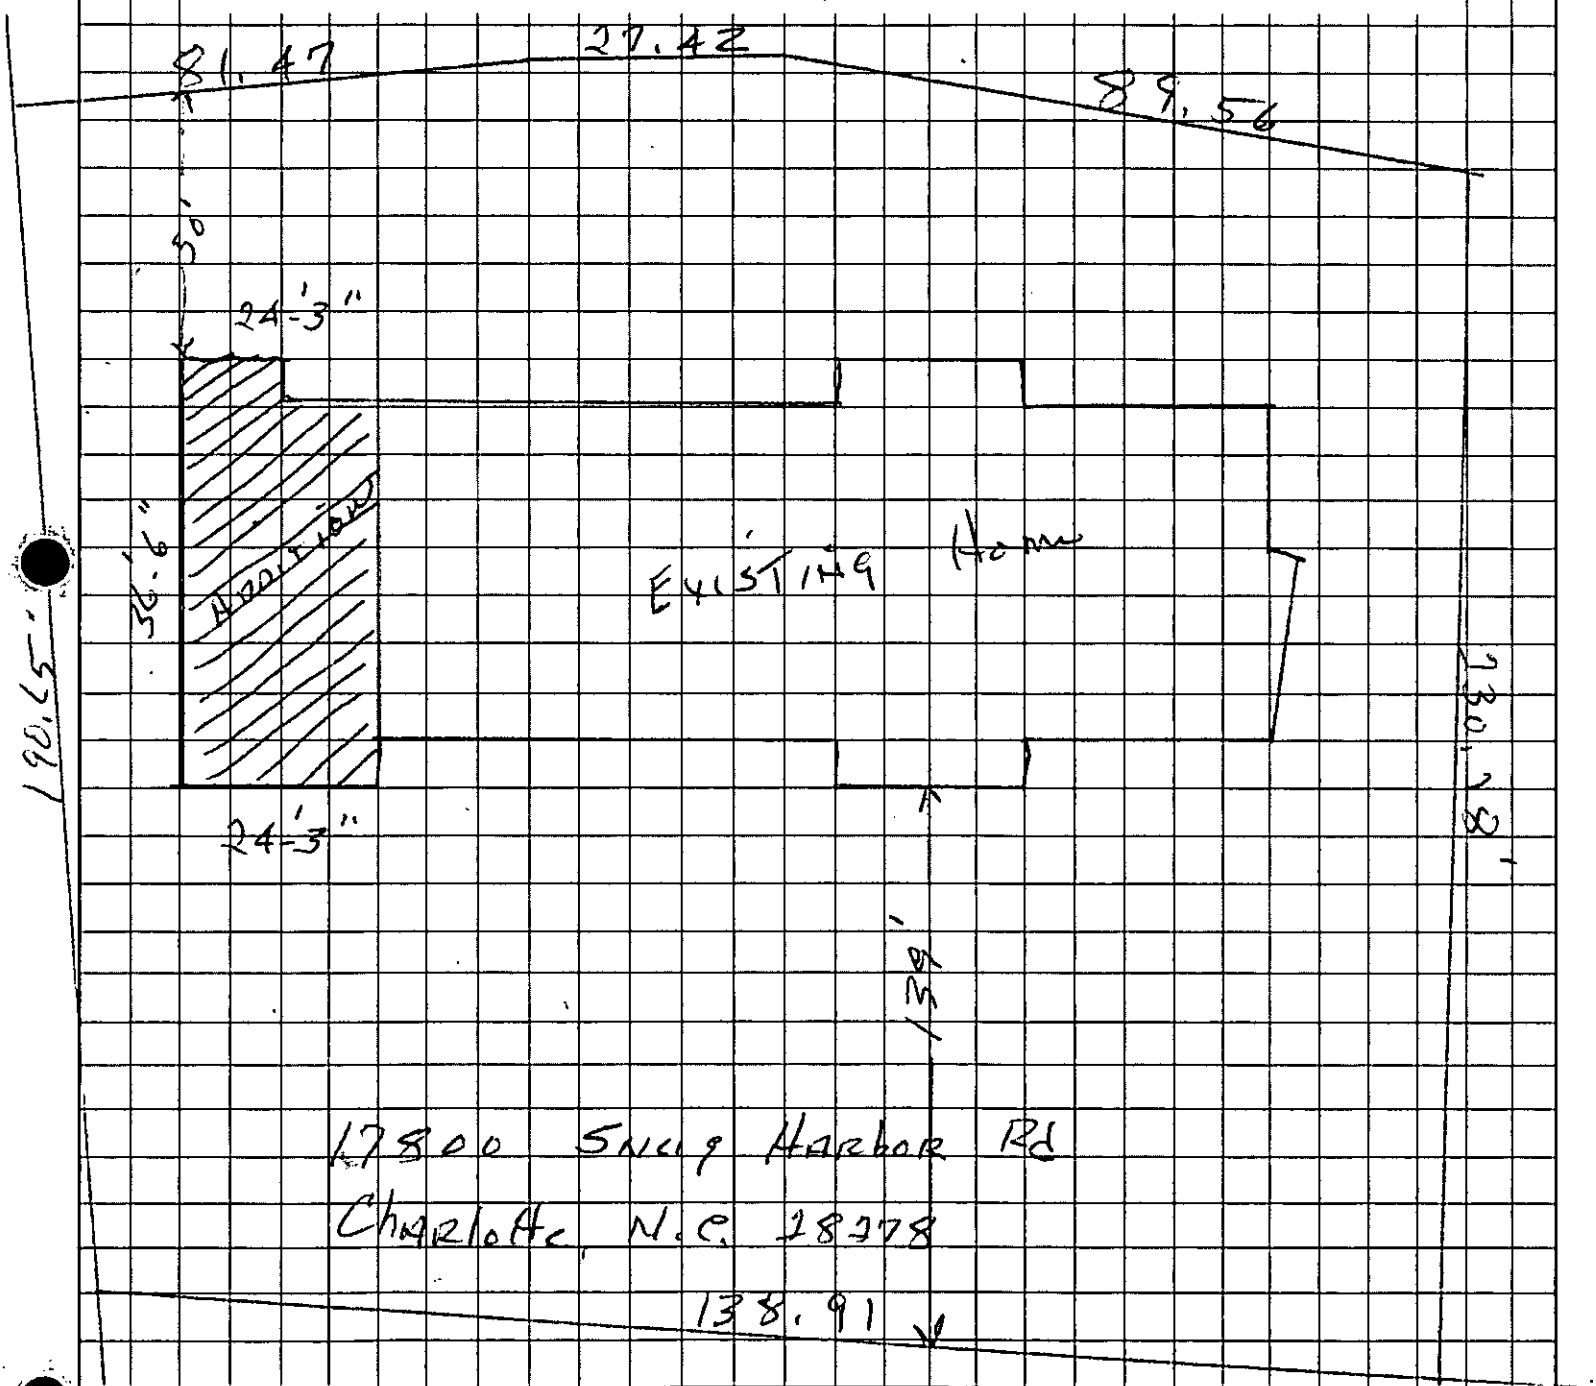

Paul D. Cochrane
OWNER/AGENT SIGNATURE

DATE 6/27/96

APPROVAL DATE 7-10-96

White - Health Department's Copy | Canary - E.H.S. Copy | Pink - Owner's Copy


1473B

THIS IS TO CERTIFY THAT ON THE 27th DAY OF August 1976. I SURVEYED THE PROPERTY SHOWN ON THIS PLAT, AND THAT THE PROPERTY LINES, WALLS, AND BUILDINGS ARE AS SHOWN HEREON: THAT THE BUILDINGS LOCATED ON SAID LOT DO NOT ENCROACH OR PROJECT ON ADJACENT STREETS OR PROPERTY: AND THAT NO ADJACENT BUILDINGS OR WALLS ENCROACH OR PROJECT ON SAID PREMISES.

ROBERT EARL STEPHENSON

SIGNED: Robert Earl Stephenson

N. C. REG. LAND SURVEYOR 1.742

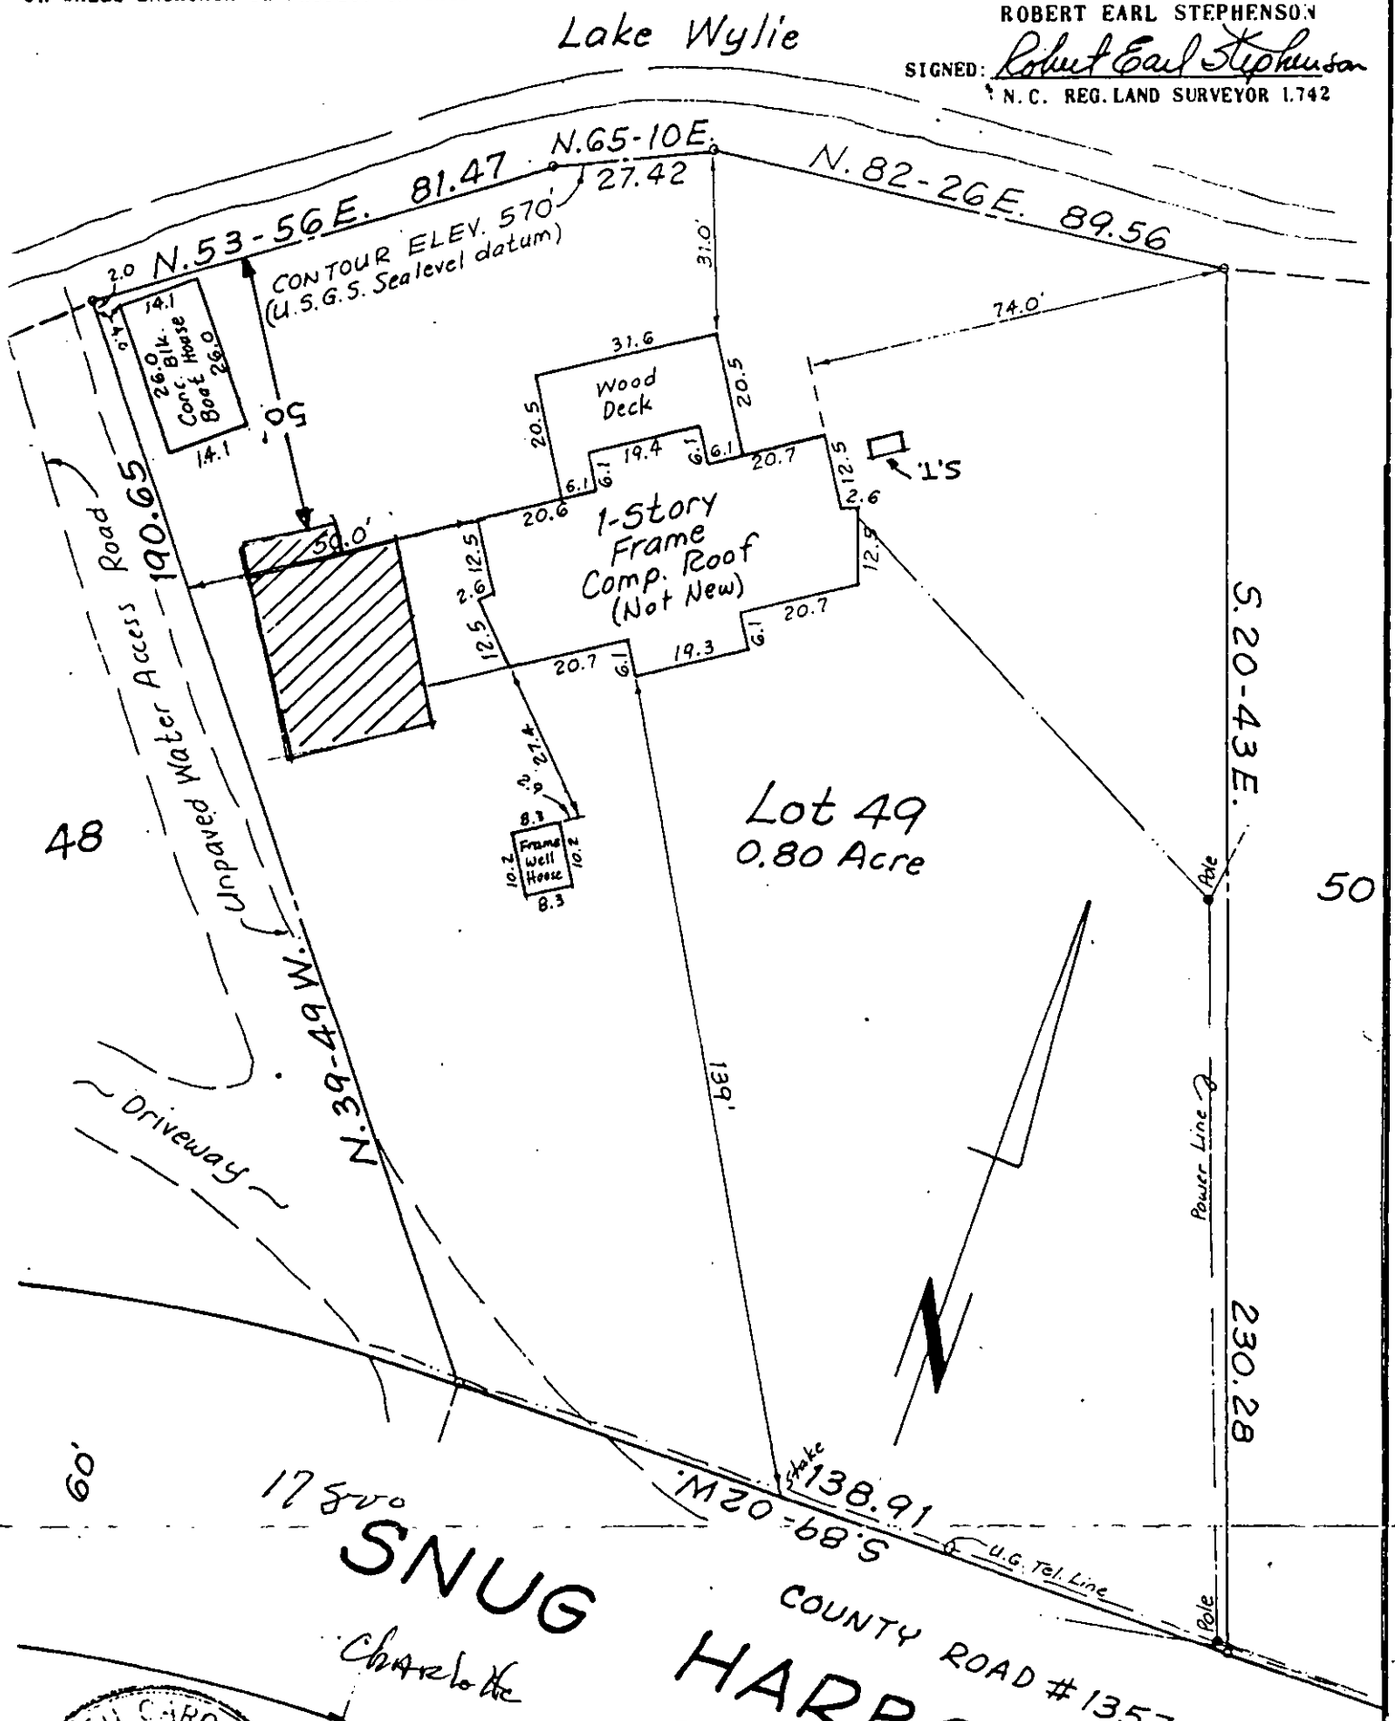

NORTH CAROLINA REGISTERED LAND SURVEYOR SEAL

PHYSICAL SURVEY

OF

Lot 49, Section 43, Crescent Land & Timber Corp.

CHARLOTTE, MECKLENBURG COUNTY, NORTH CAROLINA

PROPERTY OF

Charles M. Williams & wife, Dorothy M.

SCALE: 1" = 30'

DEED BOOK: 3227 PAGE: 197

MAP BOOK: 17 PAGE: 512

~~1733~~
221

DATE 6/27/96

TO: CHARLOTTE-MECKLENBURG BUILDING STANDARDS
PERMIT ISSUING SECTION

FROM: MECKLENBURG COUNTY ENGINEERING

JURISDICTION Meck

217-171-01
PARCEL NUMBER

17800 Lucy Harbor Rd
ASSIGNED STREET ADDRESS (ADDRESS OF RECORD)

EXISTING STREET ADDRESS (IF DIFFERENT FROM ASSIGNED)

NA
PROJECT NAME (IF APPLICABLE)

THE ABOVE DESCRIBED LOCATION HAS BEEN CHECKED CONCERNING:

1. SUBDIVISION REGULATIONS	**APPROVED**	**NOT APPROVED**
2. FLOODWAY REGULATIONS	**APPROVED**	**NOT APPROVED**
3. WATERSHED PROTECTION	**APPROVED**	**NOT APPROVED**
4. COMMERCIAL DRAINAGE PLAN	**APPROVED**	**NOT APPROVED**
5. PUBLIC UTILITY EASEMENT	**PRESENT**	**NOT PRESENT**
6. PROPERTY FRONTS ON THOROUGHFARE	**YES**	**NO**
7. DRIVEWAY PERMIT REQUIRED	**YES**	**NO**
8. DOES PROJECT CONFLICT WITH ROAD PROJECT?	**YES**	**NO**

REMARKS: Addition

NOTE: THIS FORM MUST BE TURNED IN AT THE CASHIERS OFFICE WHEN PAYING PERMIT FEE. CERTIFICATE OF OCCUPANCY WILL NOT BE GRANTED UNTIL TRANSPORTATION DIVISION GRANTS FINAL APPROVAL ON DRIVEWAY(S).

ALL OTHER FORMS OBSOLETE

☐ NEW ADDRESS

SIGNED: Pme

REVISED 1/91



221


~~473B~~

THIS IS TO CERTIFY THAT ON THE 27th DAY OF August 1976. I SURVEYED THE PROPERTY SHOWN ON THIS PLAT, AND THAT THE PROPERTY LINES, WALLS, AND BUILDINGS ARE AS SHOWN HEREON: THAT THE BUILDINGS LOCATED ON SAID LOT DO NOT ENCROACH OR PROJECT ON ADJACENT STREETS OR PROPERTY: AND THAT NO ADJACENT BUILDINGS OR WALLS ENCROACH OR PROJECT ON SAID PREMISES.

ROBERT EARL STEPHENSON

SIGNED: Robert Earl Stephenson

N. C. REG. LAND SURVEYOR L.742

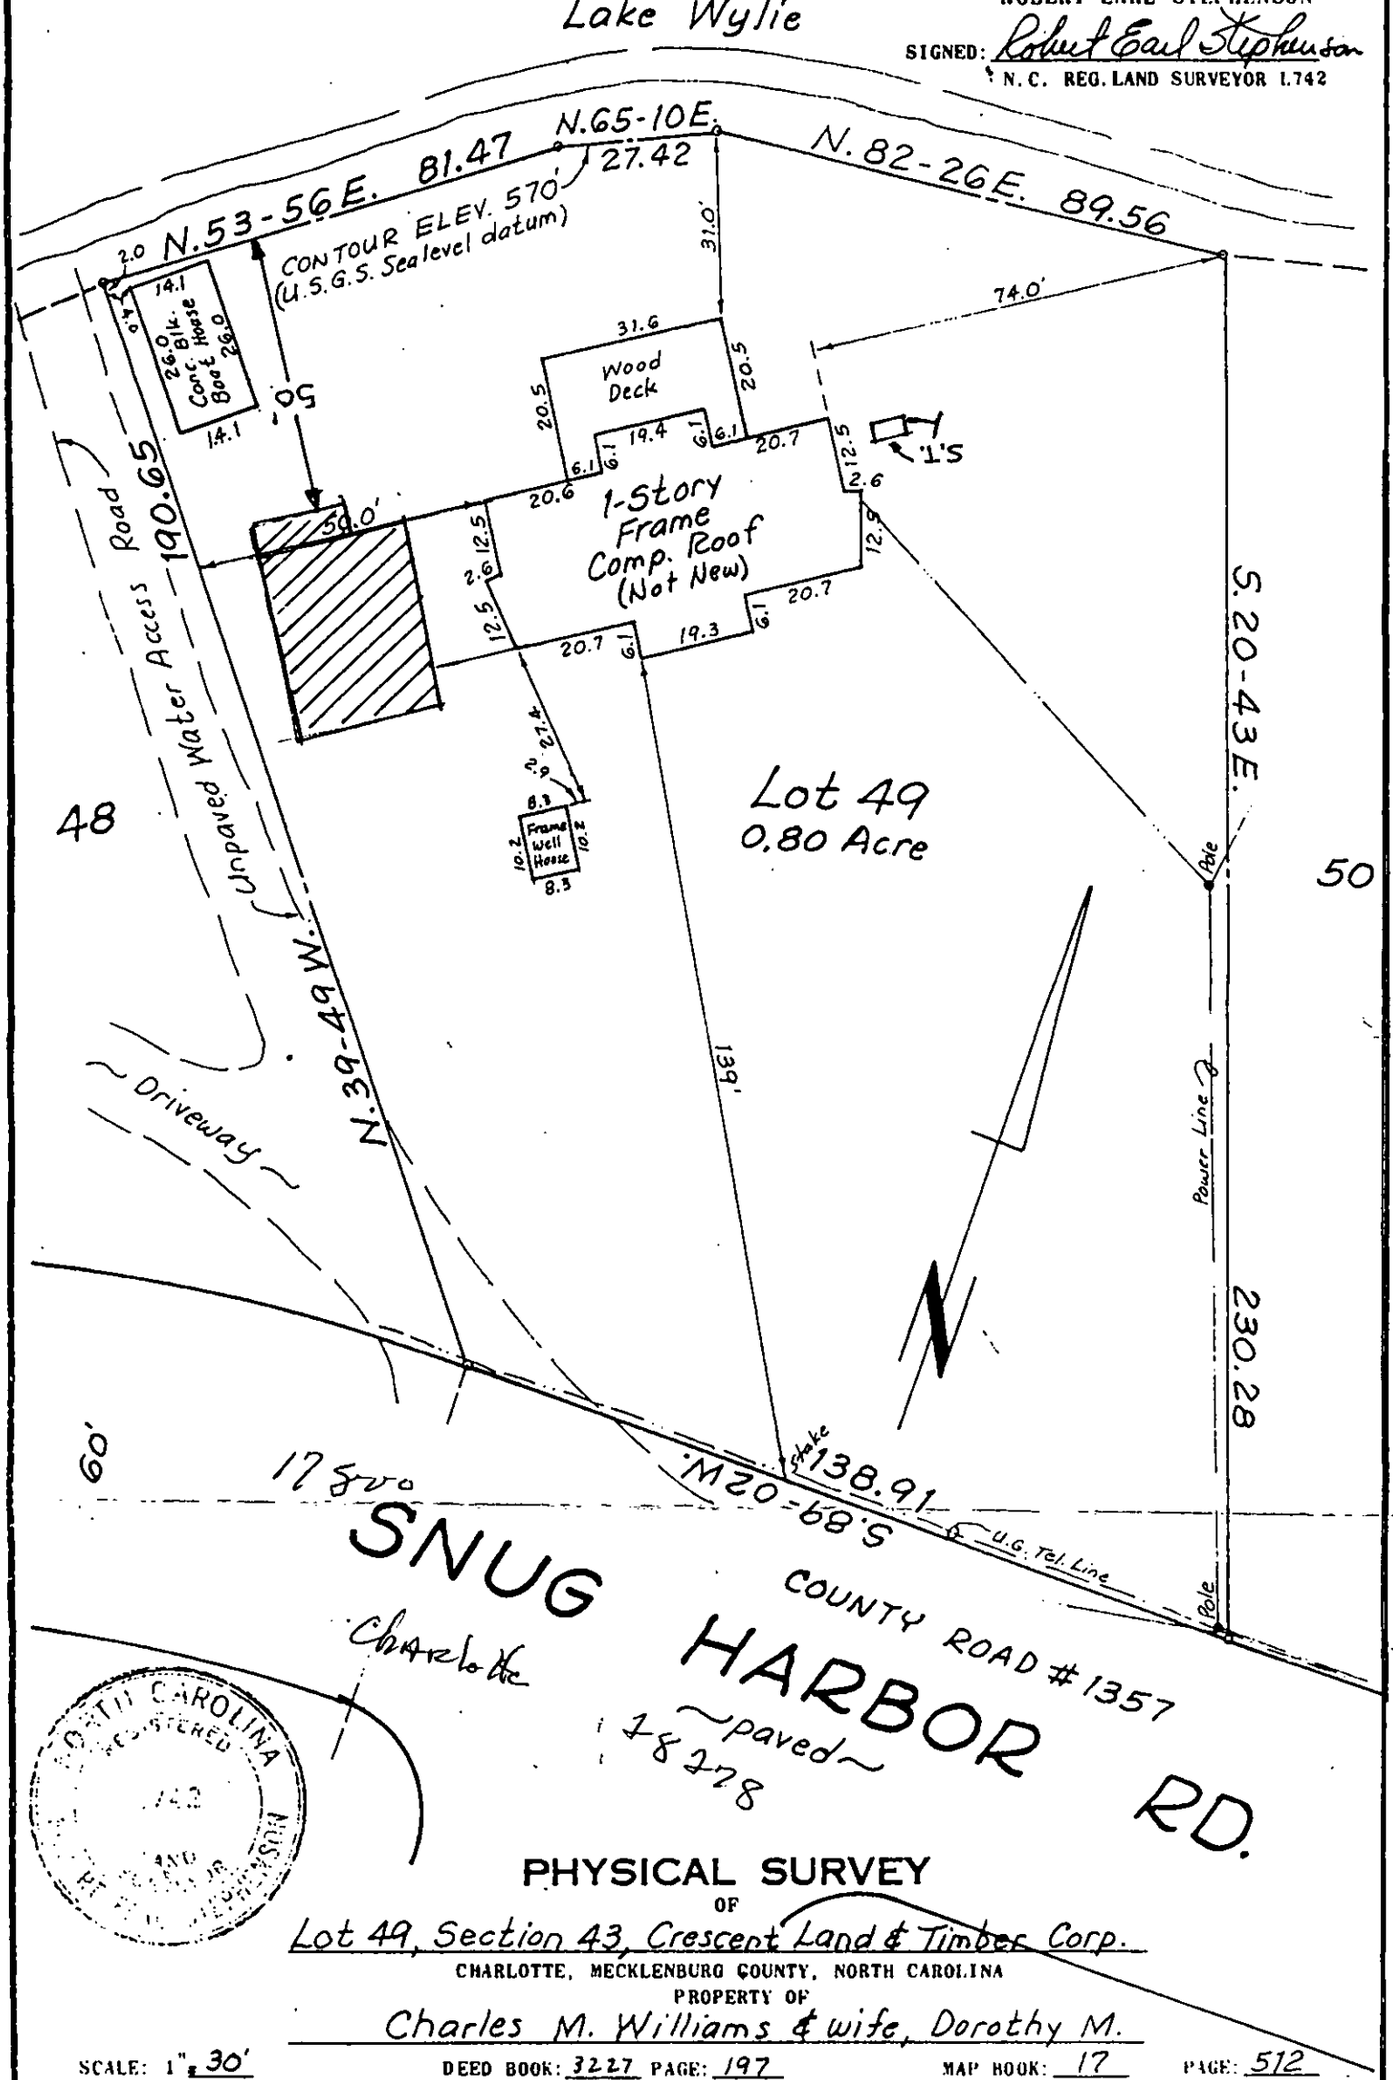

NORTH CAROLINA REGISTERED L-742 LAND SURVEYOR SEAL

PHYSICAL SURVEY

OF

Lot 49, Section 43, Crescent Land & Timber Corp.

CHARLOTTE, MECKLENBURG COUNTY, NORTH CAROLINA

PROPERTY OF

Charles M. Williams & wife, Dorothy M.

SCALE: 1" = 30'

DEED BOOK: 3227 PAGE: 197

MAP BOOK: 17 PAGE: 512

