

14214 BLACK FARMS RD

01115122

1/2/2008

duponbj

Groundwater and Wastewater Services File Imaging Project
May 2007
Barcode Font = IDAutomationHC39M

PROPOSED PLOT PLAN


HEALTH DEPARTMENT
ENVIRONMENTAL HEALTH DIVISION
700 NORTH TRYON STREET
CHARLOTTE, NC 28202
PHONE (704) 336-5102

FILE: 2918B

TC: 011-151-03

Draw in and name all roads adjoining the property. Draw in and accurately dimension the lot concerned. Accurately indicate property boundaries proposed and/or existing structures and driveways, underground utilities, and wells and springs within 100 feet of the proposed building or drainfield.

COMMENTS:
- 1" = 60'
- Keep lines level and on Contour
- keep lines shallow
- keep the Minimum Distances from the Following
  - 10 feet from all Property lines
  - 5 feet from foundation
  - 100 feet from all wells
- Keep trenches shallow - 36" maximum.

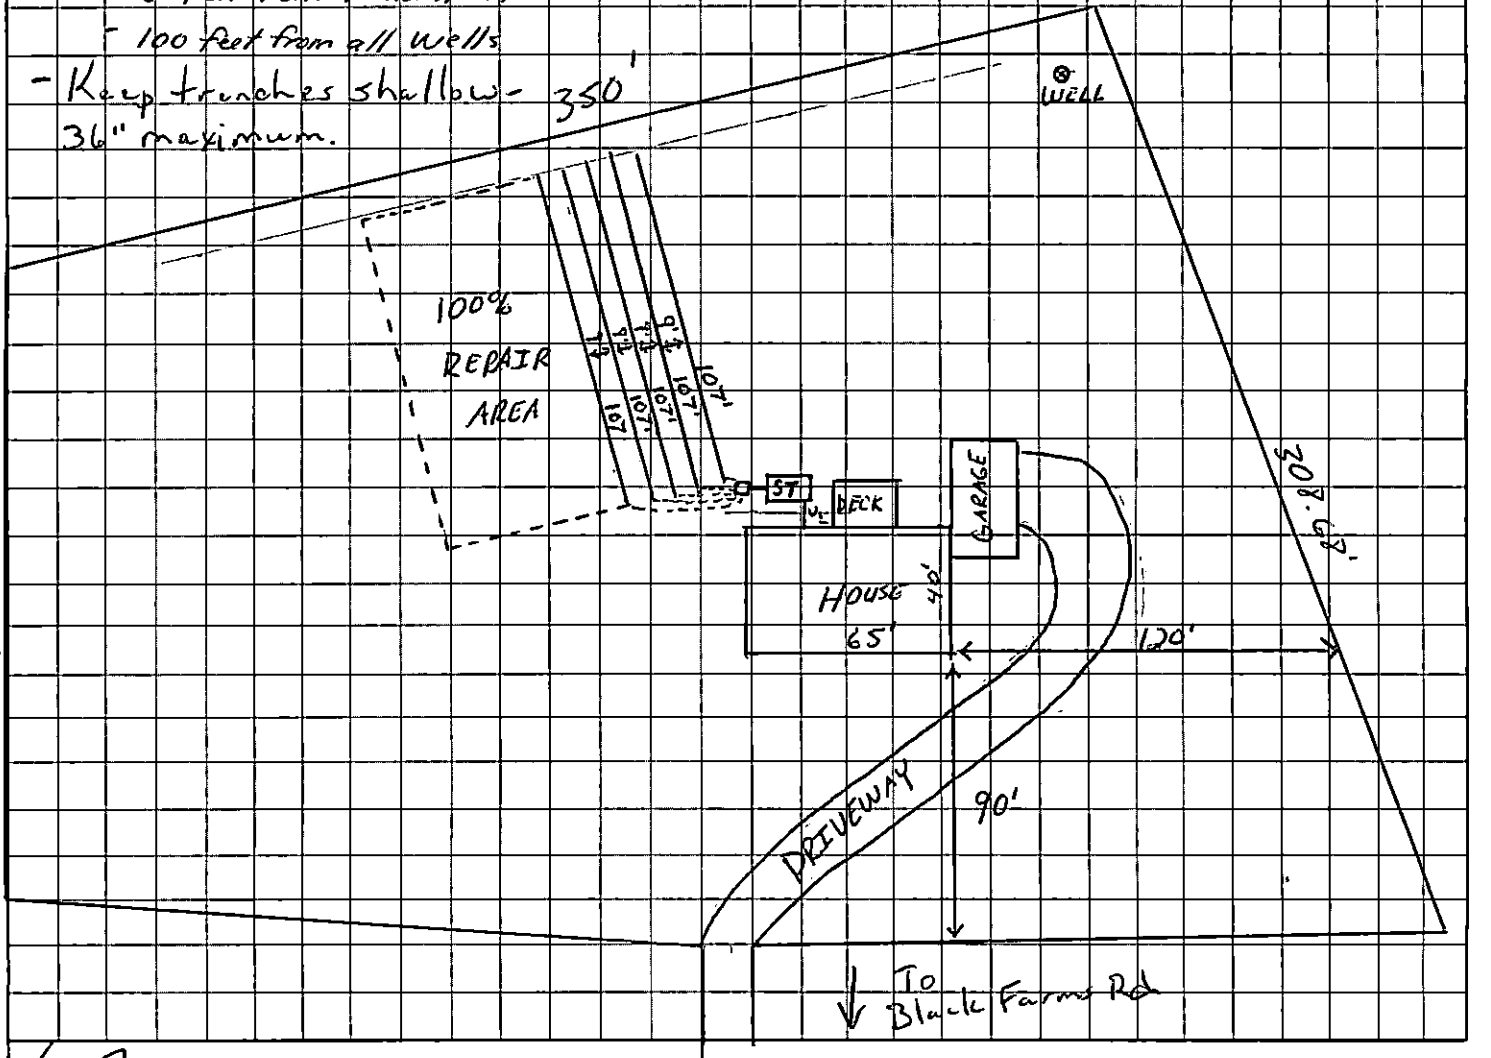

195-1

X Russell Wallace
OWNER/AGENT SIGNATURE

DATE 6-11-99

APPROVAL DATE _____

White - Health Department's Copy Canary - E.H.S. Copy Pink - Owner's Copy

INSTALLATION, CONSTRUCTION, ALTERATION, AND/OR REPAIR APPROVAL


HEALTH DEPARTMENT
ENVIRONMENTAL HEALTH DIVISION
700 NORTH TRYON ST., SUITE 211
CHARLOTTE, NC 28202
PHONE (704) 336-5102

FILE: 2918B DATE: 9/24/02

TC: 011-151 ☐ L

SERIAL No 18663

Permission is hereby given to ___ (Install) or Construct, ___ Alter or Repair the individual septic tank wastewater treatment system with subsurface, soil absorption, effluent discharge as specified herein at the described location. This permit is granted based upon the information supplied in the application dated 4-6-99. All work shall be completed on or before 10/24/02, after which date this permit shall be null and void. The system shall meet all of the construction requirements of 15A NCAC 18A. 1900 which are in effect on the date of the granting of this permit. A Certificate of Completion or an Operation Permit must be obtained from the Mecklenburg County Health Department before any system can be covered up or placed into service. The issuance of this permit does not in any way guarantee that the system anticipated to be constructed will operate properly, or relieve any person now or hereafter owning, controlling or using such system from any liability resulting from the failure of the system to operate properly.

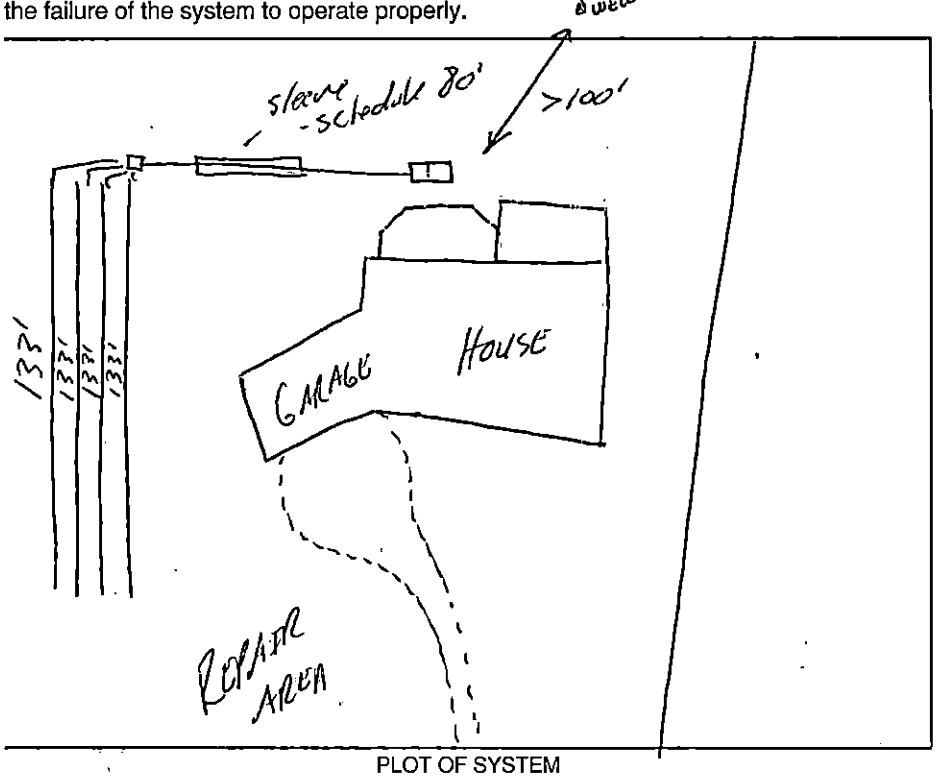

PLOT OF SYSTEM

Liquid Capacity of Septic Tank 1500 gallons

Liquid Capacity of Dosing Tank N/A gallons

Tank Construction PCC

Trench Depth 30"

Absorption and/or Nitrification Lines:

Trench Width 3' feet

Trench Walls Scored and Porous yes

Total Line Length 533' feet

Number of Lines 4 x 133'

Depth of Stone 12" inches

Distance from House >5' feet

Distance from Property Line >10' feet

Distance from Well >100' feet

NOTICE: This system shall not be installed while soils are in a wet condition.

NAME OF OWNER Russell Wallace

LOCATION OF PROPERTY 14214 Black Farms Road

Comments: Four Bedroom Residence

Install 4 lines x 133' x 3' x 12" stone

Type II Conventional System

Tracy Mitchell R.S.

Environmental Health Specialist

WHITE - HEALTH DEPARTMENT's COPY • CANARY - E.H.S. COPY • PINK - OWNER OR AGENT's COPY

clr# 3749 Pd in full

FEE: 200.00 / AUTHORIZATION FOR WASTEWATER SYSTEM CONSTRUCTION
DATE: 6/11/99 VOID SIXTY (60) MONTHS FROM DATE OF ISSUANCE

DATE: _____ PERMIT NO: 2918 B 22

PARCEL NO: 011-151-05

JOB LOCATION ADDRESS: 14214 Black Farms Rd

PROPERTY OWNER: Russell Wallace

BUILDING CONTRACTOR: _____

SUBDIVISION NAME: _____

AUTHORIZATION ISSUED BY: Jeff A. Knight DATE: 5/17/99

DEHNR AUTHORIZED AGENT

AUTHORIZATION CONDITIONS

1. WASTEWATER SYSTEM CONSTRUCTION AND INSTALLATION MUST MEET ALL CONDITIONS AND SPECIFICATIONS AS SET FORTH IN IMPROVEMENT PERMIT NO. 2918 B, AND THE ATTACHED SITE PLAN WITH SYSTEM DETAILS. CONSTRUCTION AND INSTALLATION MUST ALSO MEET ALL REQUIREMENTS SET FORTH IN THE RULES GOVERNING SANITARY SEWAGE COLLECTION, TREATMENT, AND DISPOSAL AND ANY OTHER APPLICABLE RULES AND LAWS.

2. AN INSTALLATION, CONSTRUCTION, ALTERATION AND/OR REPAIR APPROVAL MUST BE SECURED PRIOR TO INSTALLATION OF THE SEPTIC TANK SYSTEM. THE INSTALLER OF THE SYSTEM SHALL BE A REGISTERED SEPTIC TANK CONTRACTOR WITH MECKLENBURG COUNTY HEALTH DEPARTMENT.

3. ANY ALTERATION IN SITE OR SOIL CONDITIONS (INCLUDING LOCATION OF STRUCTURES AND APPURTENANCES) OR MODIFICATION IN USE, DESIGN WASTEWATER FLOW, OR WASTEWATER CHARACTERISTICS AS SPECIFIED IN THE ASSOCIATED IMPROVEMENT PERMIT AND APPLICATION, MAY SUBJECT THIS AUTHORIZATION AND ASSOCIATED PERMIT(S) TO REVOCATION.

4. OTHER CONDITIONS: *1) See plot plan. 2) A riser should be placed over the outlet end of the septic tank to facilitate filter maintenance.

OWNER CERTIFICATION

I CERTIFY THAT THERE HAVE BEEN NO ALTERATIONS IN SITE OR SOIL CONDITIONS OR MODIFICATIONS TO FACILITY, WASTEWATER FLOW, OR WASTEWATER CHARACTERISTICS FROM THOSE SPECIFIED IN THE ORIGINAL APPLICATION OR ASSOCIATED IMPROVEMENT PERMIT UNLESS AUTHORIZED IN WRITING BY THE MECKLENBURG COUNTY HEALTH DEPARTMENT. I ALSO UNDERSTAND THAT ANY SUCH ALTERATIONS, MODIFICATIONS, OR FALSE INFORMATION ARE GROUNDS FOR REVOCATION OF PERMITS AND AUTHORIZATION TO CONSTRUCT.

X Russell Wallace 6-11-99

SIGNATURE OF OWNER/OWNER'S REPRESENTATIVE DATE

Permit Number: 2918 B

Tax Number: 011-151-05

- The IMPROVEMENT PERMIT is subject to revocation if site plans or the intended use change. There is to be NO grading, filling or disturbance of the soil in the area of the septic tank system or repair area.
- CONSTRUCTION AUTHORIZATION must be obtained prior to receiving a Building Permit. The Construction Authorization is NOT transferable. Do not clear, grade, fill or disturb soil prior to obtaining a Construction Authorization.
- Domestic-type wastewater only. No industrial process wastewater may be discharged into the system.

Basement	___ Yes	X No	___ Partial Basement	
Type Primary Wastewater System Type (circle one): I (II) III IV V VI	X Conventional ___ Prefabricated, permeable block panel system ___ Shallow Placed Conventional	___ Low Pressure Pipe ___ Large Diameter Pipe ___ Fill ___ Other	___ Innovative or Experimental: ___ IWWS-93-1 ___ IWWS-93-2 ___ IWWS-94-1	
.3 Long-term acceptance rate	480 Max gallons/day wastewater flow	1600 Absorption Area (sq ft)	9' Trench spacing (min. on centers)	
Yes Serviced by private well	1500 Gallon septic tank	535 Total trench length (ft)	36" Maximum trench depth (At least 12" of provisionally suitable soil must remain between trench bottom and unsuitable soil conditions)	
4 Bedrooms in residence	N/A Gallon pump tank	12" Depth of stone		
Any surface waters present: No Type:		Minimum separation distance:		
Site modifications required:				
Additional Conditions: *1) See plot plan 2) A riser should be placed over the outlet end of the septic tank to facilitate filter maintenance.				
Repair Area System Type Type (circle one): I (II) III IV V VI	X Conventional ___ Prefabricated, permeable block panel system ___ Shallow Placed Conventional	___ Low Pressure Pipe ___ Large Diameter Pipe ___ Fill ___ Other	___ Innovative or Experimental: ___ IWWS-93-1 ___ IWWS-93-2 ___ IWWS-94-1	
1600 Absorption Area (Sq ft) 535 Total Trench Length (Ft)	12" Depth of Stone Trench	9' Trench spacing (min. on centers)	36" Maximum Trench Depth	
For existing system, enter the year originally installed:				

The undersigned, an authorized agent of the MECKLENBURG COUNTY HEALTH DEPARTMENT, certifies that the Department has approved the Request for the Job Location contained in this document. This approval is granted in accordance with the provisions of Laws and Rules For Sewage, Treatment and Disposal in effect at the time of issuance of the permit and is subject to the following provisions:

- No work shall be conducted on the septic tank system until an Installation, Construction, Alteration and/or Repair Approval is granted by this Department.
- This Improvement permit is transferable.

Jeff A. Knight 5/17/99
DEHNR Authorized Agent — Date

X Russell Wallace 6-11-99
Owner/Agent Signature — Date

MECKLENBURG COUNTY
HEALTH DEPARTMENT
ENVIRONMENTAL HEALTH DIVISION
c/o HAL MARSHALL CTR.
SUITE 211
700 N. TRYON ST.
CHARLOTTE, N.C. 28202.
(704) 336-5102

NORTH CAROLINA DEPARTMENT OF
ENVIRONMENTAL, HEALTH,
AND NATURAL RESOURCES
DIVISION OF ENVIRONMENTAL HEALTH
ON-SITE WASTEWATER SECTION

DEPARTMENT OF ENVIRONMENT, HEALTH, AND NATURAL RESOURCES
DIVISION OF ENVIRONMENTAL HEALTH
ON-SITE WASTEWATER SECTION

400 #1

Sheet: _____
Property ID: PO 011-151-65
Lot #: 3
File #: 29163

SOIL/SITE EVALUATION
for ON-SITE WASTEWATER SYSTEM

OWNER: Faye McLeod Estate APPLICANT: Ted McLeod
ADDRESS: 132 Holly Rd Atlantic Beach, N.C. DATE EVALUATED: 4-27-99
PROPOSED FACILITY: residence PROPOSED DESIGN FLOW (.1949) 460 gpd PROPERTY SIZE: 2.19
LOCATION OF SITE: Bleach Farm Road PROPERTY RECORDED: _____
WATER SUPPLY: ☑Private ☐Public ☐Well ☐Spring ☐Other _____
EVALUATION METHOD: ☑Augur Boring ☐Pit ☐Cut
TYPE OF WASTEWATER: ☑Sewage ☐Industrial Process ☐Mixed

PROFILE #	.1940 Landscape Position/ Slope % (S/40-15 2-6%)	Horizon Depth (IN.)	SOIL MORPHOLOGY (.1941) .1941 STRUCTURE/ TEXTURE	.1941 CONSISTENCE MINERALOGY	OTHER PROFILE FACTORS .1942 SOIL WETNESS/ COLOR	.1943 SOIL DEPTH	.1956 SAPRO CLASS	.1944 RESTR HORIZ	PROFILE CLASS &LTAR
1	LS	0-4"	gr/sl	Fr/SEXP/SS/SP	746" TO soil wetness	46"	N/A	None	PS .391 Fz IV
		4-33"	SBK/ SC	Fi/ SEXP/ SIP					
		33-46"	SBK/ SCl	Fr/SEXP/ SS/SP					
2	LS	0-5"	gr/scl	Fr/SEXP/SS/SP	746" TO soil wetness	46"	N/A	None	PS .391 Fz IV
		5-40"	SBK/C	Fi/SEXP/SIP					
		40-46"	SBK/SCl	Fr/SEXP/SS/SP					
3	LS	0-3"	gr/scl	Fr/SEXP/SS/SP	746" TO soil wetness	46"	N/A	None	PS .391 Fz IV
		3-37"	SBK/ C	Fi/SEXP/SIP					
		37-46"	SBK/ Cl	Fr/SEXP/ SS/SP					
4	LS	0-4"	gr/scl	Fr/SEXP/SS/SP	746" TO soil wetness	46"	N/A	None	PS .391 Fz III
		4-29"	SBK/ C	Fi/SEXP/ SIP					
		29-46"	SBK/ Cl	Fr/SEXP/SS/SP					
5	LS	0-4"	gr/sl	Fr/SEXP/SS/SP	746" TO soil wetness	746" TO soil wetness	N/A	None	PS .391 Fz IV
		4-39"	SBK/C	Fi/SEXP/SIP					
		39-46"	SBK/Cl	Fr/SEXP/SS/SP					

DESCRIPTION	INITIAL SYSTEM	REPAIR SYSTEM
Available Space (.1945)	PS	PS
System Type(s)		
Site LTAR		


OTHER FACTORS (.1946): _____
SITE CLASSIFICATION (.1948): Provisionally Suitable
EVALUATED BY: W.A. Mullin LSS 4-28-99
OTHER(S) PRESENT: _____

FILE # 2916P

COMMENTS 100% Report

LANDSCAPE POSITION	GROUP	TEXTURE	.1955 LTAR	CONSISTENCE MOIST	CONSISTENCE WET
R-RIDGE	I	S-SAND	1.2-0.8		
S-SHOULDER SLOPE		LS-LOAMY SAND		VFR-VERY FRIABLE	NS-NON-STICKY
L-LINEAR SLOPE				FR-FRIABLE	SS-SLIGHTLYSTICKY
FS-FOOT SLOPE	II	SL-SANDY LOAM	0.8-0.6	FI-FIRM	S-STICKY
N-NOSE SLOPE		L-LOAM		VFI-VERY FIRM	VS-VERY STICKY
H-HEAD SLOPE				EFI-EXTREMELY FIRM	NP-NON-PLASTIC
CC-CONCLAVE SLOPE	III	SI-SILT	0.6-0.3		SP-SLIGHTLYSTICKY
CV-CONVEX SLOPE		SICL-SILTY CLAY LOAM			P-PLASTIC
T-TERRACE		CL-CLAY LOAM			VP-VERY PLASTIC
FP-FLOOD PLAIN		SCL-SANDY CLAY LOAM			
	IV	SC-SANDY CLAY	0.4-0.1		
		SIC-SILTY CLAY			
		O-ORGANIC			

STRUCTURE	MINERALOGY
SG-SINGLE GRAIN	SLIGHTLY EXPANSIVE
M-MASSIVE	
CR-CRUMB	EXPANSIVE
GR-GRANULAR	
SBK-SUBANGULAR BLOCKY	
ABK-ANGULAR BLOCKY	
PL-PLATY	
PR-PRISMATIC	

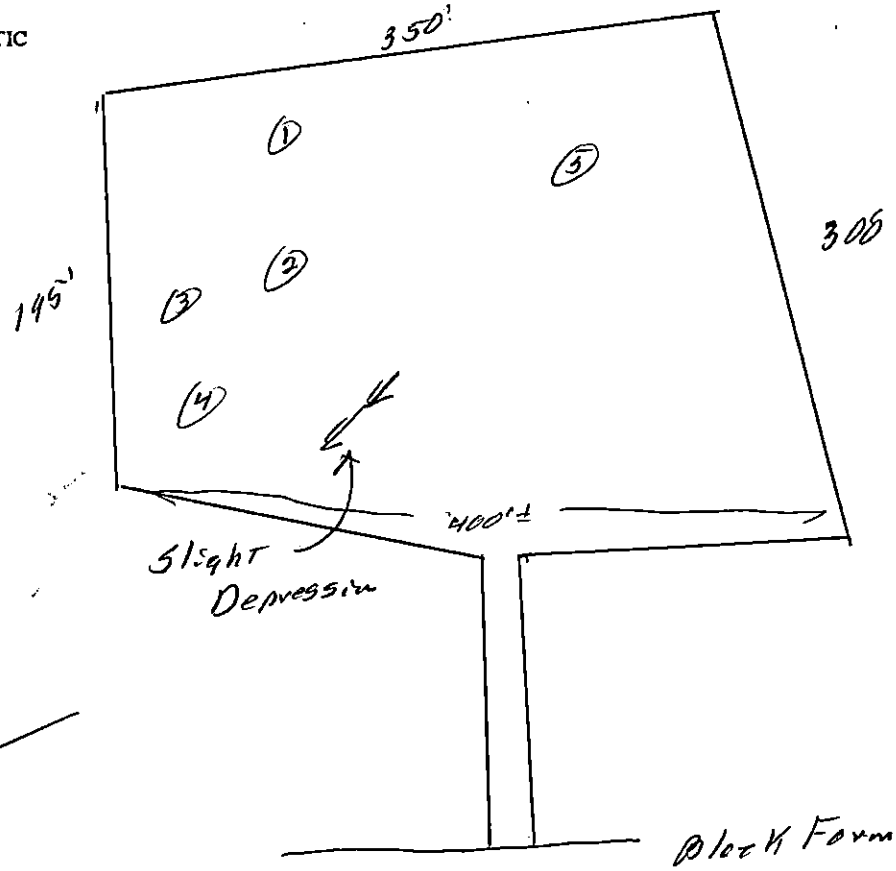

FEE: 230.00 Ck #3923 DATE: 4/6/99 JC

APPLICATION FOR IMPROVEMENT PERMIT FOR RESIDENTIAL SITE INDIVIDUAL WATER AND WASTEWATER SYSTEMS PROGRAM

[ ] CRT

TYPE APPLICATION: ___ NEW SYSTEM ___ EXPANSION/ ALTERATION OF EXISTING SYSTEM ___ REPAIR OF EXISTING SYSTEM

NORTH CAROLINA
DEPARTMENT OF ENVIRONMENT,
HEALTH, AND NATURAL RESOURCES
DIVISION OF ENVIRONMENTAL HEALTH
ON-SITE WASTEWATER SECTION

FILE #: 29189

PROPERTY INFORMATION (FROM ENGINEERING FORM) FOR JOB LOCATION:

TAX/PARCEL NUMBER: 011-151-35 PT

STREET ADDRESS: Black Farm Rd-at-McCord Rd.

SUBDIVISION OR MOBILE HOME PARK NAME:

LOT NUMBER:

TYPE OF BUILDING (CHECK ONE):

___ SINGLE MOBILE HOME(S)
___ DOUBLE WIDE (D)
X HOUSE (H)
___ MODULAR HOME (M)
___ MULTIPLE FAMILY (U)
___ OTHER (O)

TOWNSHIP (CHECK ONE):

___ 0 MECKLENBURG
___ 1 CHARLOTTE
___ 2 DAVIDSON
___ 3 CORNELIUS
___ 4 PINEVILLE
___ 5 MATTHEWS
X 6 HUNTERSVILLE
___ 7 MINT HILL

HEATED SQUARE FOOTAGE: 2200 - 2800

NUMBER OF BEDROOMS: 3-4 NUMBER OF OCCUPANTS: 2

CLOSING DATE: Waiting For Loop Test

FOUNDATION FOR RESIDENCE:

___ WITHOUT BASEMENT
X ON SLAB
X CRAWL SPACE
___ WITH BASEMENT /PLUMBING
___ WITH BASEMENT /NO PLUMBING

IF EXPANSION/ALTERATION OF EXISTING SYSTEM, DESCRIBE THE PROPOSED BUILDING ADDITION:

WILL THERE BE A HOME BUSINESS IN THE RESIDENCE: ___ YES X NO TYPE: _____

WATER SUPPLY (CHECK ONE):

___ COMMUNITY (C)
___ MUNICIPAL (M)
X PRIVATE WELL (P)
___ SHARED WELL (S)
___ OTHER 'SPRINGS' (O)

IF ANY OF THE FOLLOWING ARE LOCATED ON THE PROPERTY, PLEASE SHOW LOCATION ON PLAT:

BURIED CABLES, LANDFILLS, STUMPHOLES	___ YES ___ NO	WELL, SPRINGS OR WATERLINES	___ YES ___ NO
EXISTING WASTEWATER SYSTEMS	___ YES ___ NO	DESIGNATED WETLANDS	___ YES ___ NO
EASTMENTS OR RIGHT-OF-WAYS	___ YES ___ NO		

PROPERTY OWNER:	LEGAL AGENT FOR PROPERTY OWNER, IF APPLICABLE:
NAME: Portion of Faye McCord Estate	NAME:
(LAST) % McCord (FIRST) Lloyd (MI) Jr	(LAST) McCord (FIRST) Loyd (MI) Ted
ADDRESS: 132 Holly Rd	DAYTIME PHONE: ( ) 252 - 247-6467
CITY: Atlantic Beach STATE: NC ZIP: 28512	
DAYTIME PHONE: ( ) —	

WHAT DATE WAS THE PROPERTY ORIGINALLY DEEDED AND RECORDED? _____

An Improvement Permit is subject to suspension or revocation if site plans or the intended use change or if information submitted in this application is falsified or changed. The undersigned, owner, or legal agent for the owner, of the property described above as the "Job Location" has read the foregoing application, acknowledges that the contents of same are true, and authorizes agents of the Mecklenburg County Health Department to enter onto the property for the purpose of processing this request.

SIGNED: Russell Wallace DATE: 4-6-99

MECKLENBURG COUNTY HEALTH DEPARTMENT
ENVIRONMENTAL HEALTH DIVISION
c/o HAL MARSHALL CTR., SUITE 211, 700 N. TRYON ST., CHARLOTTE, N.C. 28202., (704) 336-5102


PROPOSED PLOT PLAN

HEALTH DEPARTMENT
ENVIRONMENTAL HEALTH DIVISION
700 NORTH TRYON STREET
CHARLOTTE, NC 28202
PHONE (704) 336-5102

FILE: 2918B

TC: 0.11-15-05 RL

Draw in and name all roads adjoining the property. Draw in and accurately dimension the lot concerned. Accurately indicate property boundaries proposed and/or existing structures and driveways, underground utilities, and wells and springs within 100 feet of the proposed building or drainfield.

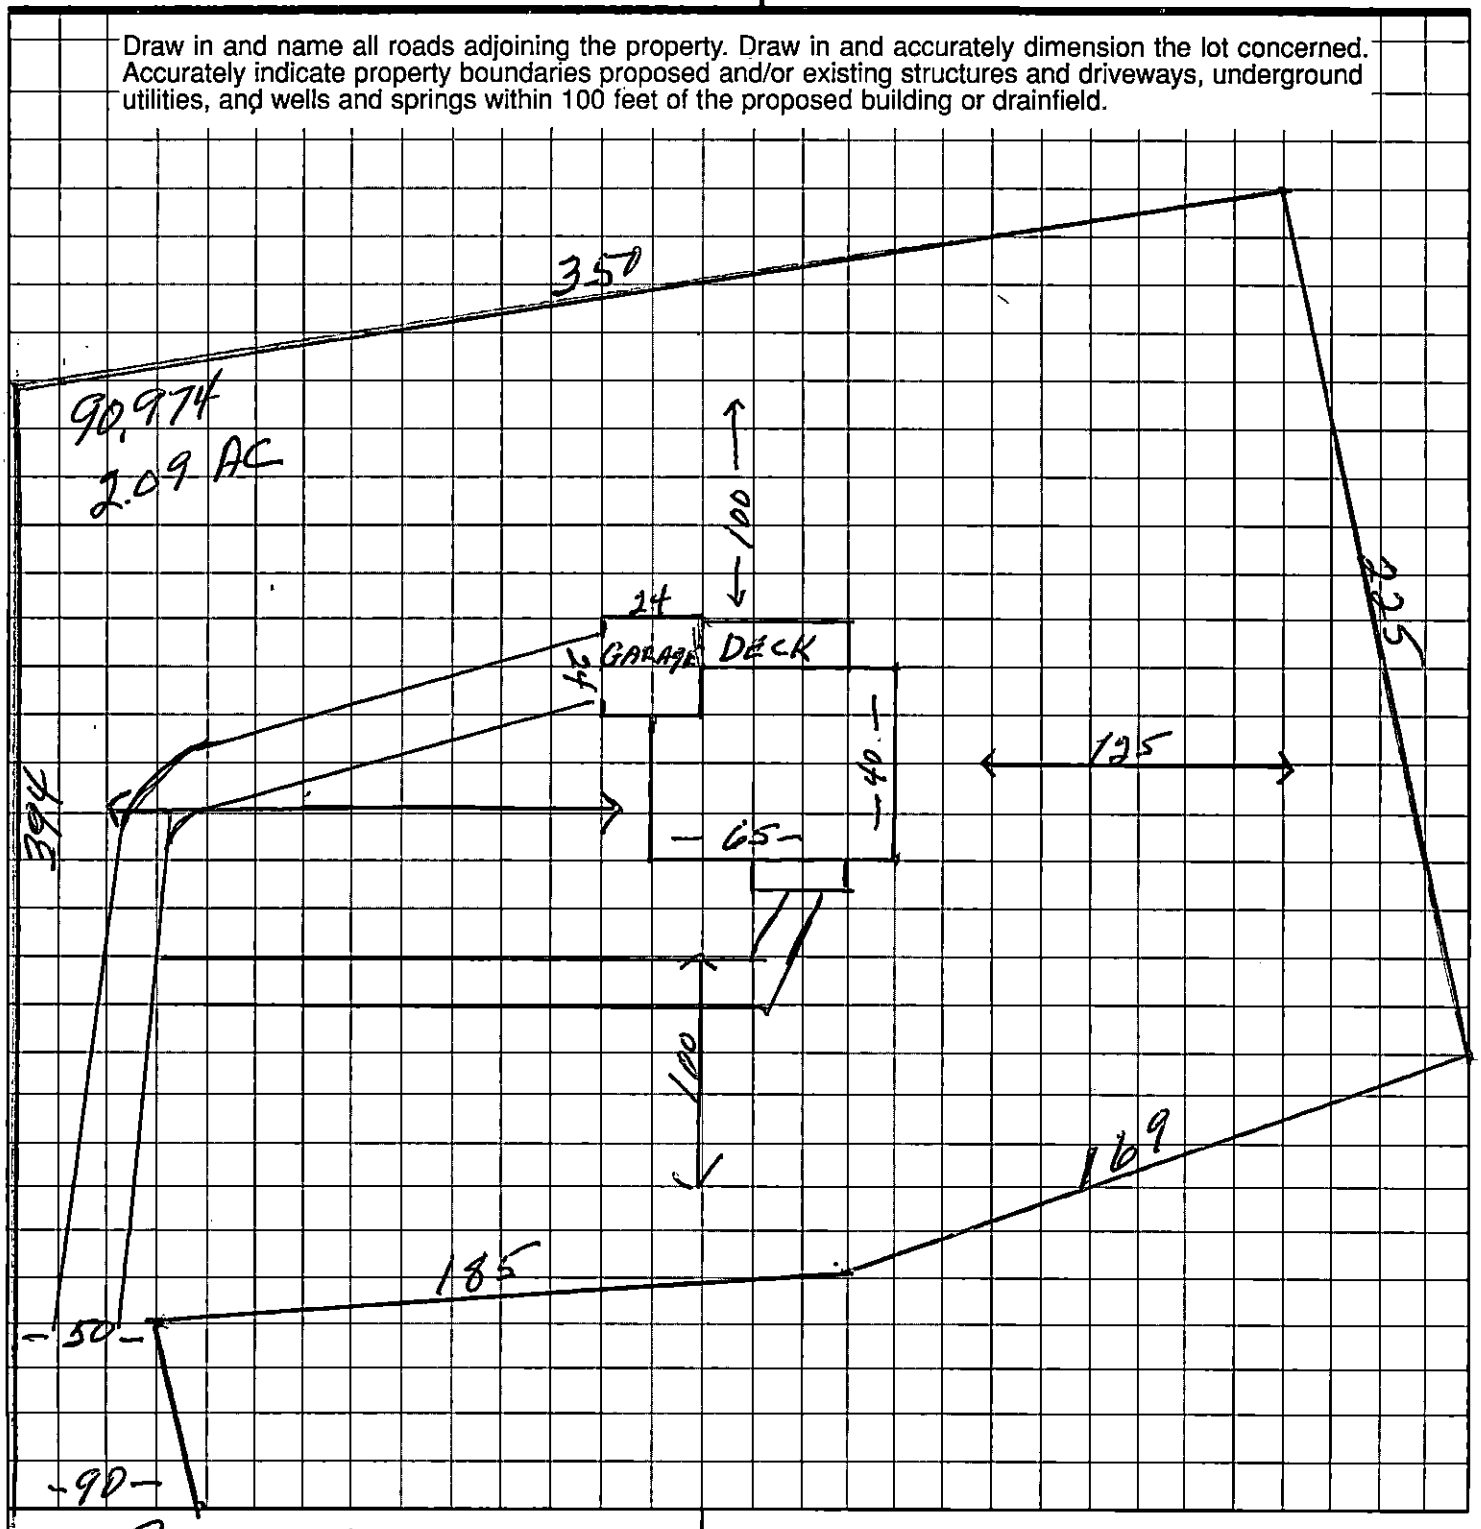

Donald Wallace
OWNER/AGENT SIGNATURE

DATE 4-6-99

APPROVAL DATE _____

White - Health Department's Copy Canary - E.H.S. Copy Pink - Owner's Copy


PROPOSED PLOT PLAN

HEALTH DEPARTMENT
ENVIRONMENTAL HEALTH DIVISION
700 NORTH TRYON STREET
CHARLOTTE, NC 28202
PHONE (704) 336-5102

FILE: 23HB

TC: 611-151-05PC

Draw in and name all roads adjoining the property. Draw in and accurately dimension the lot concerned. Accurately indicate property boundaries proposed and/or existing structures and driveways, underground utilities, and wells and springs within 100 feet of the proposed building or drainfield.

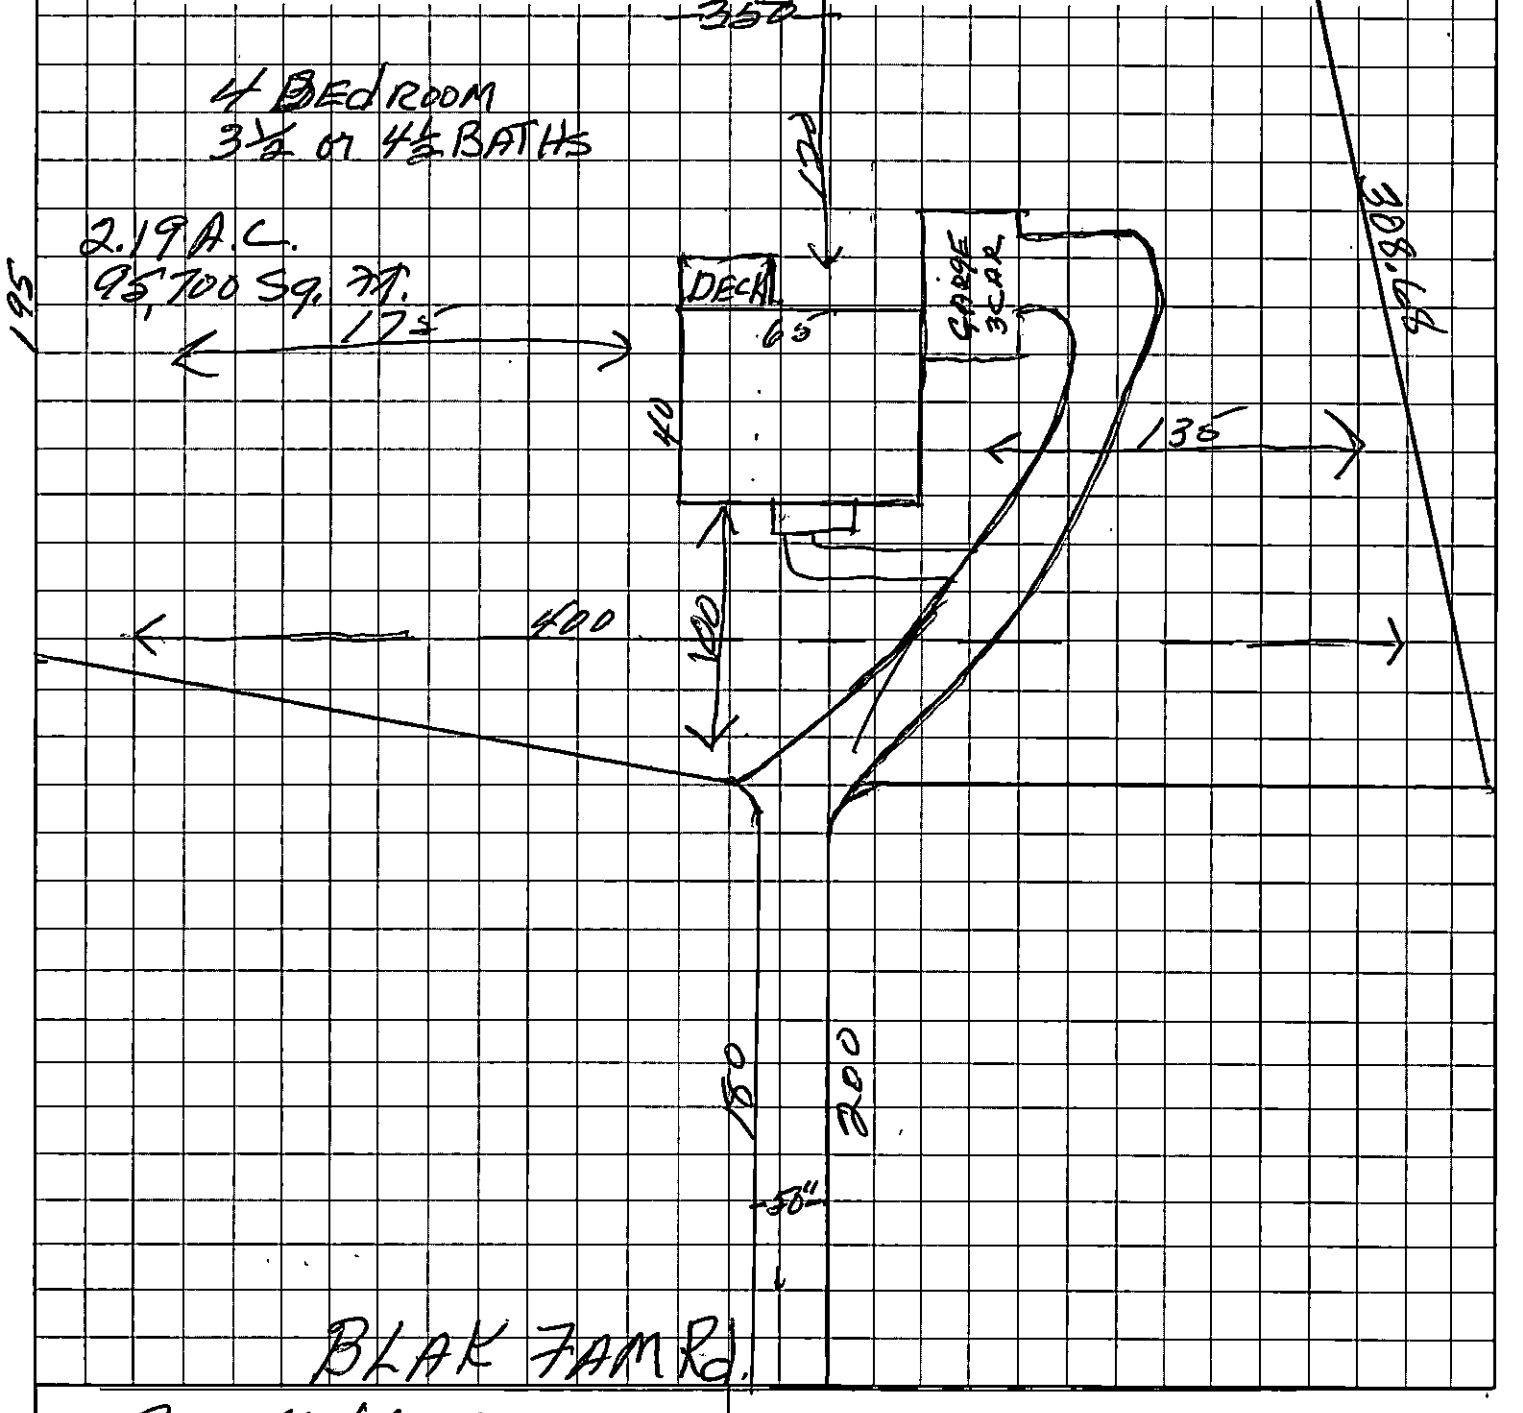

Russell Wallace
OWNER/AGENT SIGNATURE

DATE 4-26-99

APPROVAL DATE _____

White - Health Department's Copy Canary - E.H.S. Copy Pink - Owner's Copy

CERTIFICATE OF COMPLETION/OPERATION PERMIT

HEALTH DEPARTMENT
ENVIRONMENTAL HEALTH DIVISION
700 NORTH TRYON ST., SUITE 211
CHARLOTTE, NC 28202
PHONE (704) 336-5102

FILE: 2918B DATE: 10/9/02

TC: 011-151-05 ☒ L ☒ CRT

SERIAL Nº 18947

Name of Owner RUSSELL WALLACE Juris.:

Address of Property 14214 Black Farms Road

Inspection Data:

Tank Material PCC

Total Length of Drainfield 535'

Number of Lines 4 @ 133'

Cover Depth 12"

Water Supply Source well


Distance to Water Source >100'

Excavation Inspected 10/9/02

Tank(s) Inspected 10/9/02

Wash Line Inspected N/A

High Water Alarm Inspected N/A

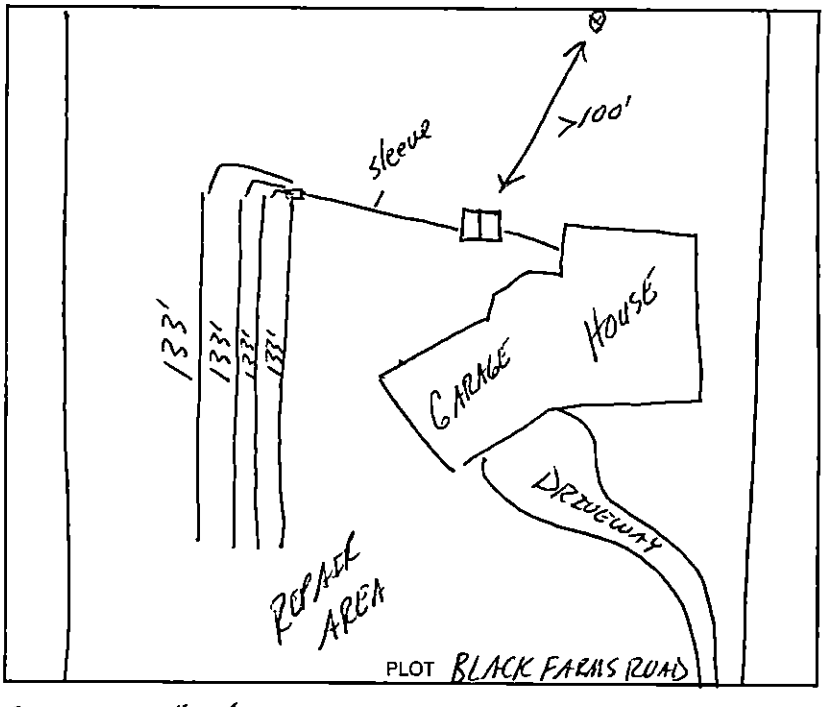

Design 1500ST, 1600SFT, CON, 12"Stone CTR# Larry Henkle

The undersigned has inspected the Septic Tank System described above, and certifies it has been

☒ installed or constructed ☐ altered or repaired

☐ in accordance with the permit issued ☒ as detailed in the plot above

and meets the provisions of I5A NCAC 18A. 1900, "Laws And Rules For Sewage Treatment and Disposal Systems" in effect on the date of issuance of the permit. This issuance of this

☐ Certificate of Completion ☒ Operation Permit

does not in any way guarantee that the system will operate properly or relieve any person now or hereafter owning, controlling, or using such system from any liability resulting from the failure of the system to operate properly. This document is issued subject to those restrictions and conditions shown on the permit(s) and the provisions of I5A NCAC 18A. 1990 in addition to those listed below under "COMMENTS." This document shall be null and void if any information contained in the application is untrue or if any additions are made to the property which would increase the requirements for said system.

Notice: Disturbance of the designated repair area may result in the suspension/revocation of this permit.

COMMENTS: Four Bedroom House
4 lines x 133' x 3' x 12" Stone
Type II Conventional System

Larry Mickler R.S.
Environmental Health Specialist

Mecklenburg County services are available without regard to ethnic origin, sex, or disability.