Date Received 10-25-82

MECK COUNTY DEPARTMENT OF RECEIVED

SIR No. 19066

T, C. No. 035-232-21

Map Date

MECKLENBURG COUNTY
DEPARTMENT OF ENVIRONMENTAL HEALTH

APPLICATION FOR SOIL INVESTIGATION

1) NAME OF OWNER [illegible] (LAST) [illegible] (FIRST) [illegible] (MIDDLE)

2) ADDRESS OF OWNER 4328 Mann Rd Charlotte, N.C. ZIP 28213

3) PHONE NO. Home 596 6993 Office


4) LOCATION OF PROPERTY Mann Rd. (STREET OR COUNTY ROAD)

5) SUBDIVISION [illegible] LOT NO 11 BLOCK NO.

MAP BOOK NO PAGE NO. 174

6) DEED REFERENCE DEED BOOK 1177 PAGE NO. 174

Application is hereby made to the Mecklenburg County Department of Environmental Health for the conduct of a soil investigation and an on site inspection of the lot hereinabove described for the purpose of determining if the lot is suitable for the installation of an individual septic tank wastewater treatment system with subsurface, soil absorption, effluent discharge

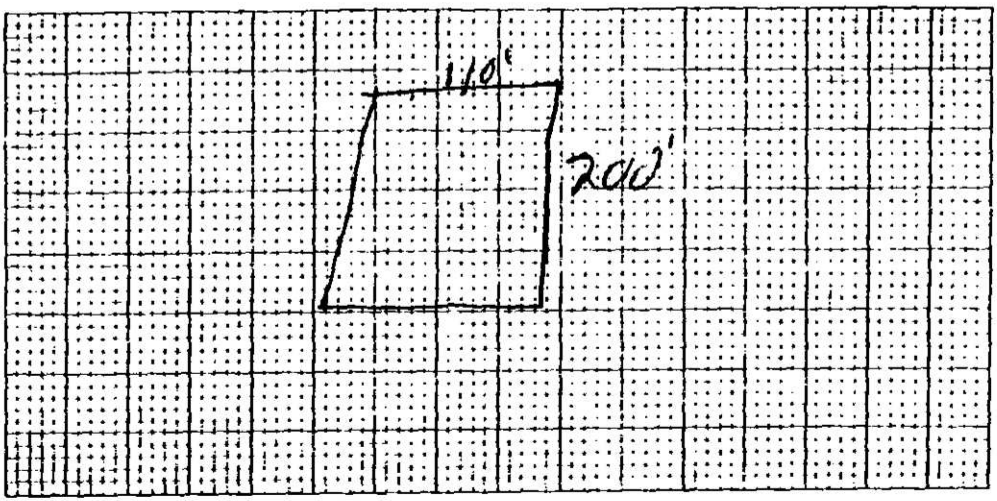

7) ACCURATELY DIAGRAM & DIMENSION LOT

[illegible]
OWNER

EHD-5-76

Environmental Health Department's Copy

Serial No. 4745

PTR No. 19066

Date Issued 10-27-82

T. C No. PO 035-232-21

Map Date


MECKLENBURG COUNTY
DEPARTMENT OF ENVIRONMENTAL HEALTH
SOIL INVESTIGATION REPORT

NAME OF OWNER Thompson, (LAST) James (FIRST) Clyde (MIDDLE)

ADDRESS OF OWNER 4328 Nevin Road, Charlotte, NC ZIP 28213

LOCATION OF PROPERTY Nevin Road (STREET OR COUNTY ROAD)

SUBDIVISION LOT NO 11 BLOCK NO.

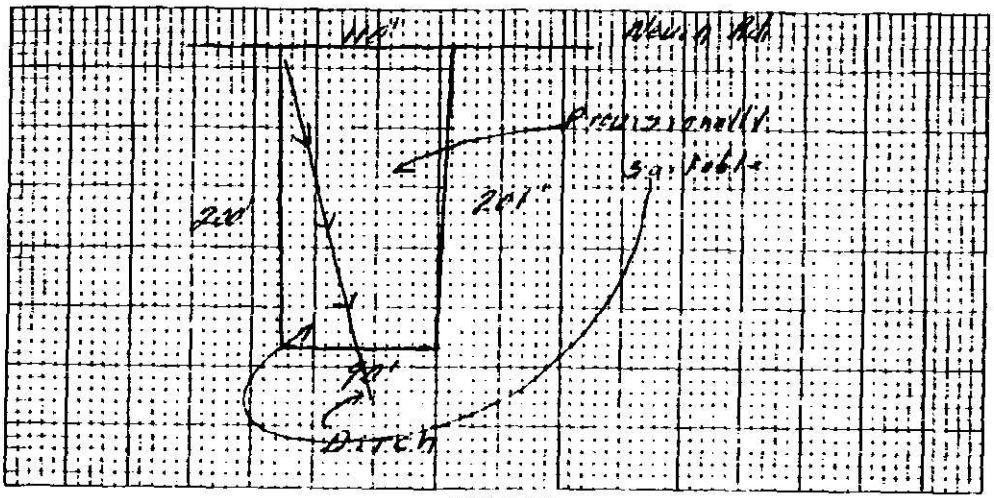

PLOT PLAN

This is to certify that a soil investigation and on-site investigation was made by the Mecklenburg County Department of Environmental Health on the lot described above. The said investigation was conducted on that portion of the lot as indicated on the above plot

The permeability rate determined by the investigation was **Provisionally Suitable** The said lot is approved for the installation of an individual septic tank wastewater treatment system with subsurface, soil absorption effluent discharge subject to the following terms and conditions

1. A permit [illegible] shall be obtained from the Mecklenburg County Department of Environmental Health prior to the construction [illegible] of the wastewater treatment system on the said lot.
2. The size of the septic tank and wastewater treatment system which may be installed will be determined by the Mecklenburg County Department of Environmental Health in accordance with the permeability rate obtained above, and on the size and type of building to be constructed thereon.
3. This approval [illegible] only for the system as installed on the [illegible] as indicated as acceptable for system installation on the above plot.
4. This approval [illegible] shall be void [illegible] unless [illegible] shall be performed on the lot which, in the opinion of the Mecklenburg County Department of Environmental Health renders the area indicated as acceptable for system installation unsuitable for installation [illegible] or repair of such a system.

This approval is granted based on the laws of the State of North Carolina and the rules and regulations of the North Carolina Department of Human Resources, Division of Health Services and the Mecklenburg County Health Commission which were in effect on the date of issuance and is void if at any time in the future, prior to completion of the system, these laws, rules and regulations are changed such that this approval would not have been granted had the new or revised laws, rules and regulations been in effect on the issue date.

W. R. Martin for W. R. Ramsey
Soil Scientist

Mike Sexton
Environmental Health Director or Authorized Section Head

EHD-5-76

Environmental Health Department's Copy

DEPARTMENT OF ENVIRONMENTAL HEALTH MECKLENBURG COUNTY, NORTH CAROLINA

SITE EVALUATION

S.I.R. NO. 19066

T.C. NO. PO 055-232-21

(Ground Absorption Sewage Disposal)

OWNER: JAMES Clyde T Thompson LAT NO:

ADDRESS: 4329 Nevin Rd LOT SIZE: .46A

Charlotte, N.C. 28213

LOCATION OF SITE: Nevin Rd Lot 11

FACTORS	AREA 1	AREA 2	AREA 3	AREA 4
1. SLOPE (%)	S (PS) 2-10 U	S PS U	S PS U	S PS U
2. SOIL TEXTURE (12-36 inches) Sandy, Loamy, Clayey (Note 2-1 Clay)	S (PS) Clayey U	S PS U	S PS U	S PS U
3. SOIL STRUCTURE (12-36 inches)	S (PS) Blocky U	S PS U	S PS U	S PS U
4. SOIL DEPTH (inches)	S (PS) 36+ U	S PS U	S PS U	S PS U
5. RESTRICTIVE HORIZONS (Inches) (Impervious strata, Rock)	S (PS) none U	S PS U	S PS U	S PS U
6. SOIL DRAINAGE/GROUNDWATER (external and internal)	S (PS) Adequate U	S PS U	S PS U	S PS U
7. OTHER (Specify)	S PS U	S PS U	S PS U	S PS U
8. SOIL GROUP	IVa			
9. SITE CLASSIFICATION	P, Suitable			
10. SOIL SERIES	Cecil			

S - Suitable PS - Provisionally Suitable U - Unsuitable

**See Diagram on Back (includes: soil areas, property lines, roads, streams, gullies, wet areas, fill areas, wells, water bodies, slopes)


Recommendations/Comments: Ditch Across This Lot - See Map

Described by: Wm B. Ramsey

Title: Soil Scientist

Date: 10-26-82

EHD 539 (Revised: 6/82)

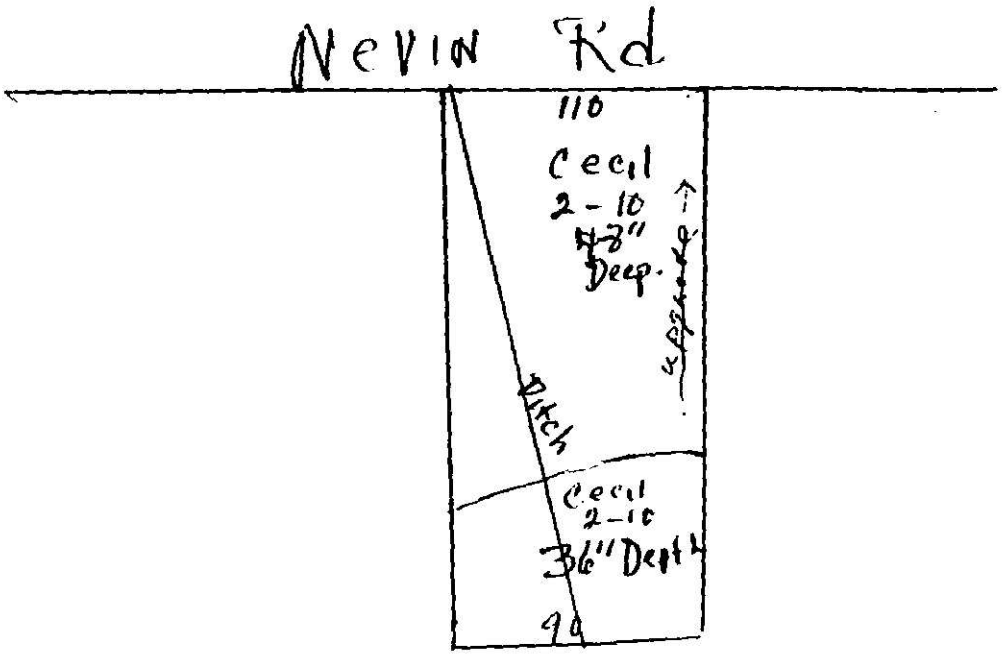
Nevin Rd
110
Cecil
2-10
42"
Deep.
Ditch
Cecil
2-10
36" Depth
90