MECKLENBURG COUNTY
HEALTH DEPARTMENT

HSIA #9051
97768

20 JUL '17 PM 1:57

APPLICATION FOR A RESIDENTIAL SITE IMPROVEMENT PERMIT/ CONSTRUCTION AUTHORIZATION FOR AN ON-SITE WASTEWATER SYSTEM, NEW WELL INSTALLATION, OR REPAIR OF EXISTING WELL

1. SEPTIC / TYPE APPLICATION: ○ N/A ○ NEW SYSTEM ○ ALTERATION ◉ REPAIR ○ MODIFIED PLOT PLAN

2. WELL / TYPE APPLICATION: ◉ N/A ○ NEW WELL ○ MAJOR REPAIR ○ ABANDONMENT

3. JOB LOCATION INFORMATION:
TAX PARCEL NUMBER: 19957102
STREET ADDRESS: 10600 Knox Farm Rd
CITY: Charlotte
STATE: NC ZIP: 28278
SUBDIVISION NAME: N/A
LOT #: _____ LOT SIZE (acres): 2.6 acres
TOWNSHIP:
◉ MECKLENBURG ○ CORNELIUS ○ HUNTERSVILLE
○ DAVIDSON ○ CHARLOTTE ○ PINEVILLE
○ MATTHEWS ○ MINT HILL

4. BUILDING INFORMATION:
BUILDING TYPE:
○ SINGLE MOBILE HOME ○ MODULAR HOME
○ DOUBLE WIDE ○ MULTIPLE FAMILY
◉ HOUSE ○ OTHER _____
HEATED SQUARE FOOTAGE: 2076
NUMBER OF BEDROOMS: 3
NUMBER OF OCCUPANTS: 2
FOUNDATION TYPE:
○ CONCRETE SLAB ◉ BASEMENT WITH PLUMBING
○ CRAWL SPACE ○ BASEMENT WITH NO PLUMBING

5. IF PLANNING TO EXPAND OR ALTER THE EXISTING SEPTIC SYSTEM PLEASE COMPLETE THE FOLLOWING SECTION: ◉ N/A

NUMBER OF BEDROOMS TO BE ADDED: _____ NUMBER OF ADDITIONAL OCCUPANTS IN THE RESIDENCE: _____

6. WATER SUPPLY: ○ MUNICIPAL ◉ PRIVATE WELL ○ PUBLIC WELL ○ SHARED WELL ○ OTHER _____

7. PROPOSED USE OF WELL: ○ N/A ○ IRRIGATION ◉ POTABLE (DRINKING WATER) ○ OTHER _____

8. PLEASE INDICATE AND RANK DESIRED SEPTIC SYSTEM TYPE(S) IN ORDER OF PREFERENCE *(1-MOST DESIRED 5-LEAST DESIRED)*:

☒ N/A ☐ ANY TYPE ☐ 1 CONVENTIONAL ☐ ACCEPTED ☐ INNOVATIVE ☐ ALTERNATIVE ☐ OTHER _____

8A. RANK: ____ ____ ____ ____ ____

9. DO ANY OF THE FOLLOWING APPLY TO THE PROPERTY IN QUESTION? IF "YES" PLEASE ATTACH SUPPORTING DOCUMENTATION.

BURIED CABLES, LANDFILLS, STUMPHOLES	○ YES ◉ NO	GRADING/SOIL REMOVAL PERFORMED	○ YES ◉ NO
EXISTING WASTEWATER (SEPTIC) SYSTEMS	◉ YES ○ NO	JURISDICTIONAL WETLANDS	○ YES ◉ NO
WELLS, SPRINGS, OR WATER LINES	◉ YES ○ NO	APPROVAL REQUIRED BY ANY OTHER PUBLIC AGENCY	○ YES ◉ NO
EASEMENTS OR RIGHT-OF-WAYS	○ YES ◉ NO	WASTEWATER OTHER THAN DOMESTIC SEWAGE	○ YES ◉ NO
CHEMICAL/PETROLEUM STORAGE TANKS	○ YES ◉ NO	KNOWN UNDERGROUND CONTAMINATION	○ YES ◉ NO
WASTE STORAGE	○ YES ◉ NO	GROUNDWATER USE RESTRICTIONS/VARIANCES	○ YES ◉ NO

10. WHAT DATE WAS THE PROPERTY ORIGINALLY DEEDED AND RECORDED? 1986 ☐ UNKNOWN

11. WHAT IS THE ANTICIPATED CLOSING DATE FOR THIS PROPERTY? 7/28/17 ☐ N/A

12. PROPERTY OWNER:
NAME: Thomas L. Gillis
ADDRESS: 10600 Knox Farm
CITY: Charlotte
STATE: NC ZIP: 28278
WORK PHONE: _____
MOBILE PHONE: 704-591-1932
FAX: _____
E-MAIL: maxfieldrealestate@yahoo.com
(Email Permit)

13. OWNER'S LEGAL REPRESENTATIVE, IF APPLICABLE: Agent
NAME: Karen Glenn
ADDRESS: 11040 S Tryon Ste 202
CITY: Charlotte
STATE: NC ZIP: 28273
WORK PHONE: _____
MOBILE PHONE: 704-996-8804
FAX: _____
E-MAIL: Karenglenn@bellsouth.net

MECKLENBURG COUNTY – GROUNDWATER & WASTEWATER SERVICES
700 N. TRYON ST. SUITE 211 CHARLOTTE, NC 28202, OFFICE: 980-314-1680, FAX: 704-336-6894
Email: Wellreg@MecklenburgCountyNC.gov

Revised on: 4/20/17

14. SEPTIC SYSTEM PERMIT APPLICATION:

If the information in this application is falsified, changed, or the site is altered, then the Improvement Permit and Authorization to Construct shall become invalid. I have read this application and certify that the information provided herein is true, complete and correct. Authorized county and state officials are granted right of entry to conduct necessary inspections to determine compliance with applicable laws and rules. I understand that I am solely responsible for the proper identification and labeling of all property lines and corners and making the site accessible so that a complete site evaluation can be performed. The permit is valid for either sixty (60) months or is non-expiring depending upon the documentation submitted: complete site plan = 60 months, complete plat = non-expiring.

_____ (Initial here for septic system applications)

15. WELL PERMIT APPLICATION:

If the information in this application is falsified, changed, or the site is altered, then the Well Permit shall become invalid. I have read this application and certify that the information provided herein is true, complete and correct. Authorized county and state officials are granted right of entry to conduct necessary inspections to determine compliance with applicable laws and rules. I understand that I am solely responsible for the proper identification and labeling of all property lines and corners and making the site accessible so that a complete site evaluation can be performed. The permit is valid for a period of twelve (12) months from the date of issuance.

_____ (Initial here for well applications)

16. APPLICATION SIGNATURE SECTION:

ONLY COMPLETE APPLICATIONS WILL BE PROCESSED. A proper signature is required in order to process your application. Please review the application carefully and sign in the space provided below. A PROPOSED PLOT PLAN is required to be submitted with each application.

Karen Glenn _____ 7-20-17

Property Owner's or Owner's Legal Representative Signature — Date

---

OFFICE USE ONLY

O SURVEY PLAT TO SCALE SUBMITTED O SCALED SITE PLAN SUBMITTED O UN-SCALED SITE PLAN SUBMITTED

SEPTIC APPLICATION FEE RECEIVED: $ _____ DATE FEE RECEIVED: _____

WELL APPLICATION FEE RECEIVED: $ _____ DATE FEE RECEIVED: _____

APPLICATION PROCESSED BY: _____

GWS FILE NUMBER ASSIGNED: _____

APPLICATION ID NUMBER ASSIGNED: _____

COMMENTS:

MECKLENBURG COUNTY – GROUNDWATER & WASTEWATER SERVICES
700 N. TRYON ST. SUITE 211 CHARLOTTE, NC 28202, OFFICE: 980-314-1680, FAX: 704-336-6894
Email: Wellreg@MecklenburgCountyNC.gov

DocuSign Envelope ID: 37D8F738-A2E8-485E-99E3-DFC5AFDA4A98

Mecklenburg County Groundwater & Wastewater Services
700 N. Tryon St., Suite 211 Charlotte, NC 28202
Phone: (980) 314-1680 Fax: (704) 336-6894

NC DHHS
Division of Environmental Health
On-Site Wastewater Section

IMPROVEMENT PERMIT/CONSTRUCTION AUTHORIZATION
for an ON-SITE WASTEWATER TREATMENT & DISPOSAL SYSTEM

File #: 97763 Permit #: ~~97763~~ Both 9051 Tax Parcel #: 189-571-02

Property Owner: Thomas L. Gillis

Job Location Address: 10600 Knox Farm Rd.

City: Charlotte State: NC Zip Code: 28278

Improvement Permit Issuance Date: NA **Construction Authorization Issuance Date** 8/14/17

Permission is hereby given to ☐ install ☐ alter ☒ repair an on-site wastewater treatment & and disposal system, with subsurface soil absorption and effluent discharge, as specified herein at the described location. This permit is granted based upon the application information submitted to our office. This permit expires 5 years from the date it was issued. The system shall meet all of the construction requirements of 15A NCAC 18A. 1900 which are in effect on the date of granting this approval. An **Operation Permit** must be obtained from the Mecklenburg County Health Department before any system can be covered up or placed into service. The issuance of this permit does not in any way guarantee that the system anticipated to be constructed will operate properly, or relieve any person now of hereafter owning, controlling or using such system from any liability resulting from the failure of the system to operate properly.

***NOTICE: This system shall not be installed while soils are in a wet condition.**

Permitted Design Flow: 360 GPD

Liquid Capacity of Septic Tank: 1000 new gallons

Site LTAR: .25 GPD/ft² (For new installations only.)

Liquid Capacity of Dosing Tank: NA gallons

Drainfield Design ☒ N/A

Trench Depth: _____ inches

Trench Width: _____ feet

Line Spacing: _____ feet (O.C.)

Total line length: _____ feet

# of Lines: _____ @ _____ feet

Depth of Media: _____ inches (Type) _____

Distribution Device: _____

Bed Design *(For Repair Installations ONLY.)* ☒ N/A

Bed Depth: _____ inches

Bed Width: _____ feet

Total line length: _____ feet

# of Lines: _____ @ _____ feet

Depth of Media: _____ inches (Type) _____

Distribution Device: _____

Water Supply Source

☐ Municipal ☒ Private Well ☐ Community Well

☐ Other _____

Minimum System Setbacks

Distance from Building Foundation: 5' min feet

Distance from Property Line: 10' min feet

Distance from Water Supply Source: 100' + feet

SKETCH OF SYSTEM LAYOUT
(Proposed Layout)

See attached site plan for new septic Tank

Comments: System Classification & Type: Replace existing tank w/new 1000gal

Authorized Agent: Bradley W. Hallman Signature: [signature]

Owner Signature: DocuSigned by: [signature] 7762413710DF454... Date: 8/16/2017

Mecklenburg County Groundwater & Wastewater Services
700 N. Tryon St., Suite 211 Charlotte, NC 28202
Phone: (980) 314-1680 Fax: (704) 336-6894

NC DHHS
Division of Environmental Health
On-Site Wastewater Section

IMPROVEMENT PERMIT/CONSTRUCTION AUTHORIZATION for an ON-SITE WASTEWATER TREATMENT & DISPOSAL SYSTEM

File #: 97763 Permit #: ~~97763~~ Bob 9051 Tax Parcel #: 199-571-02

Property Owner: Thomas L. Gillis

Job Location Address: 10600 Knox Farm Rd.

City: Charlotte State: NC Zip Code: 28278

Improvement Permit Issuance Date: NA **Construction Authorization Issuance Date** 5/14/17

Permission is hereby given to ☐ install ☐ alter ☒ repair an on-site wastewater treatment & and disposal system, with subsurface soil absorption and effluent discharge, as specified herein at the described location. This permit is granted based upon the application information submitted to our office. This permit expires 5 years from the date it was issued. The system shall meet all of the construction requirements of 15A NCAC 18A. 1900 which are in effect on the date of granting this approval. An **Operation Permit** must be obtained from the Mecklenburg County Health Department before any system can be covered up or placed into service. The issuance of this permit does not in any way guarantee that the system anticipated to be constructed will operate properly, or relieve any person now of hereafter owning, controlling or using such system from any liability resulting from the failure of the system to operate properly.

***NOTICE: This system shall not be installed while soils are in a wet condition.**

Permitted Design Flow: 360 GPD

Site LTAR: 0.25 GPD/ft² (For new installations only.)

Liquid Capacity of Septic Tank: 1000 new gallons

Liquid Capacity of Dosing Tank: NA gallons

Drainfield Design ☒ N/A

Trench Depth: _____ inches

Trench Width: _____ feet

Line Spacing: _____ feet (O.C.)

Total line length: _____ feet

# of Lines: _____ @ _____ feet

Depth of Media: _____ inches (Type) _____

Distribution Device: _____

Bed Design *(For Repair Installations ONLY.)* ☒ N/A

Bed Depth: _____ inches

Bed Width: _____ feet

Total line length: _____ feet

# of Lines: _____ @ _____ feet

Depth of Media: _____ inches (Type) _____

Distribution Device: _____

Water Supply Source

☐ Municipal ☒ Private Well ☐ Community Well

☐ Other _____

Minimum System Setbacks

Distance from Building Foundation: 5' min feet

Distance from Property Line: 10' min feet

Distance from Water Supply Source: 100' + feet

SKETCH OF SYSTEM LAYOUT
(Proposed Layout)

See attached site plan for new septic Tank


Comments: System Classification & Type: Replace existing tank w/new 1000 gal

Authorized Agent: Bradley W. Hallman Signature: [signature]

Owner Signature: _____ Date: _____

DocuSign Envelope ID: 37D8F738-A2E8-485E-99E3-DFC5AFDA4A98

On-site Wastewater Improvement Permit Diagram

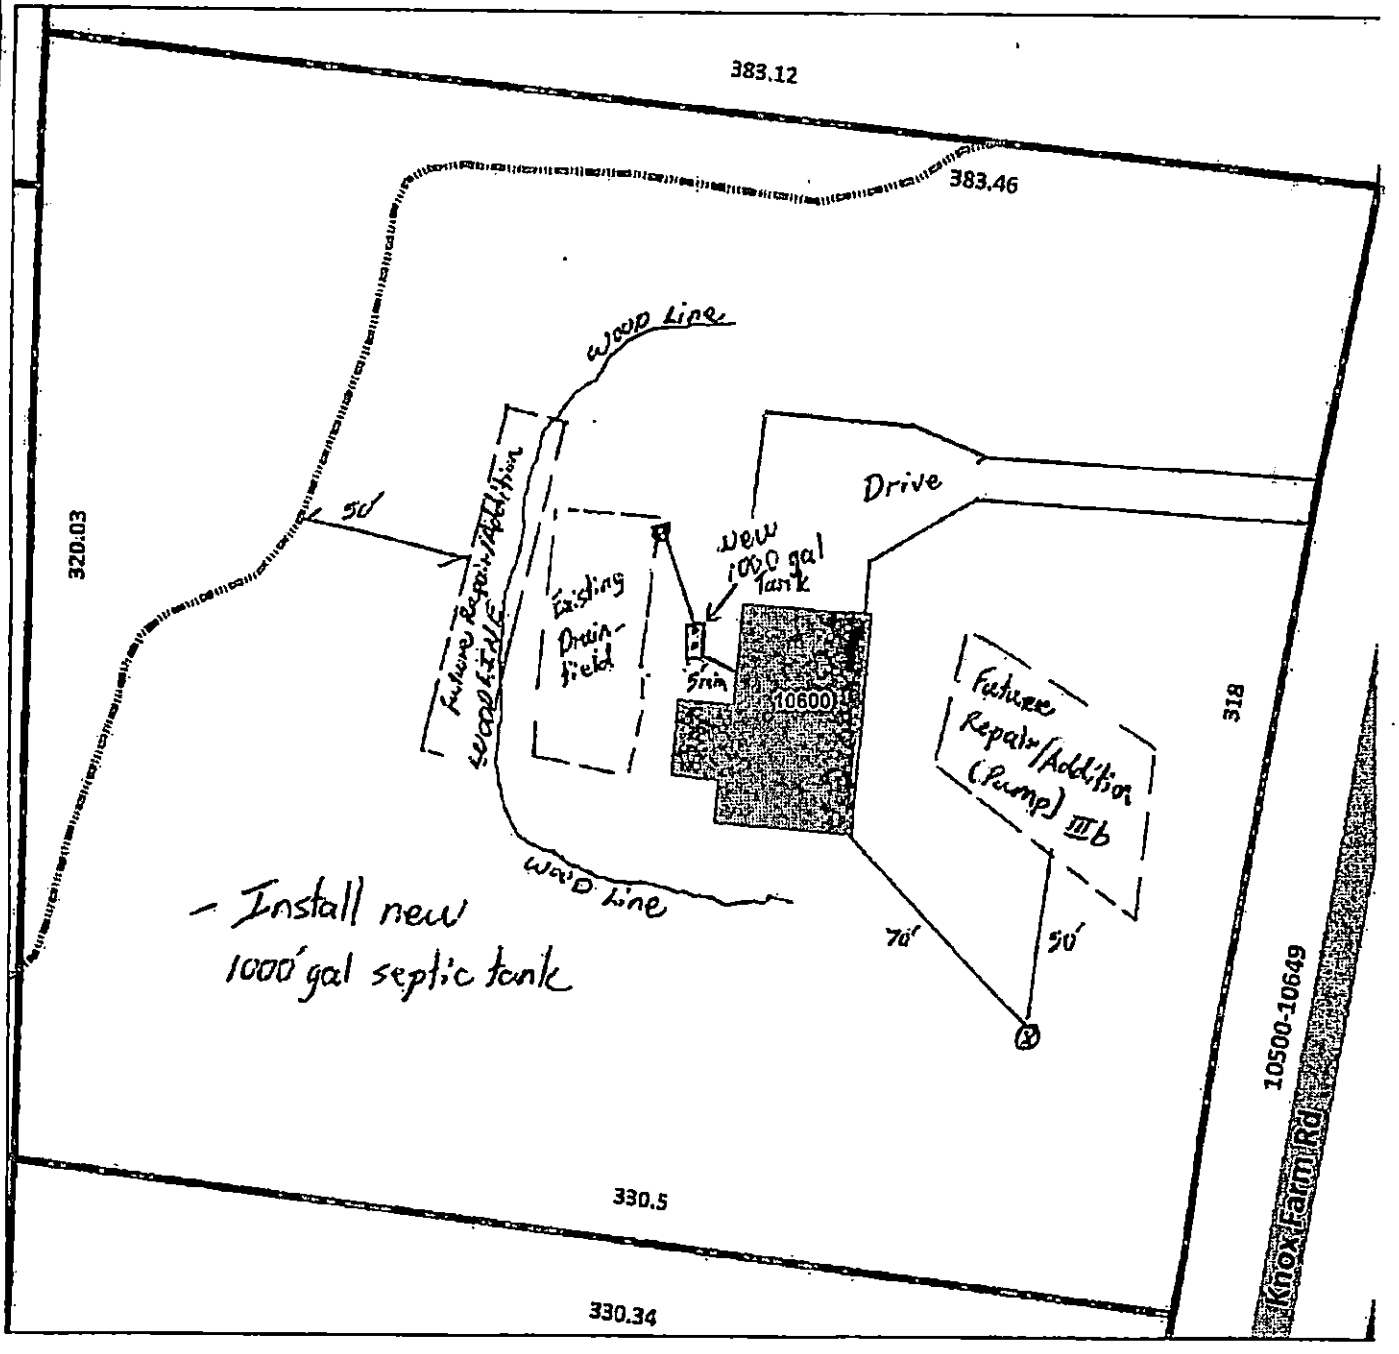

Mecklenburg County Health Department
Environmental Health - Groundwater and Wastewater Services


Permit #: 9051
PID #: 199-571-02
File #: 9776B

Authorized Agent: Bradley M. Hallman Date: 8/14/17

Owner/ Legal Agent: DocuSigned by: [signature] 77624137 10DF454... Date: 8/16/2017

1 inch = 50 fee

On-site Wastewater Improvement Permit Diagram

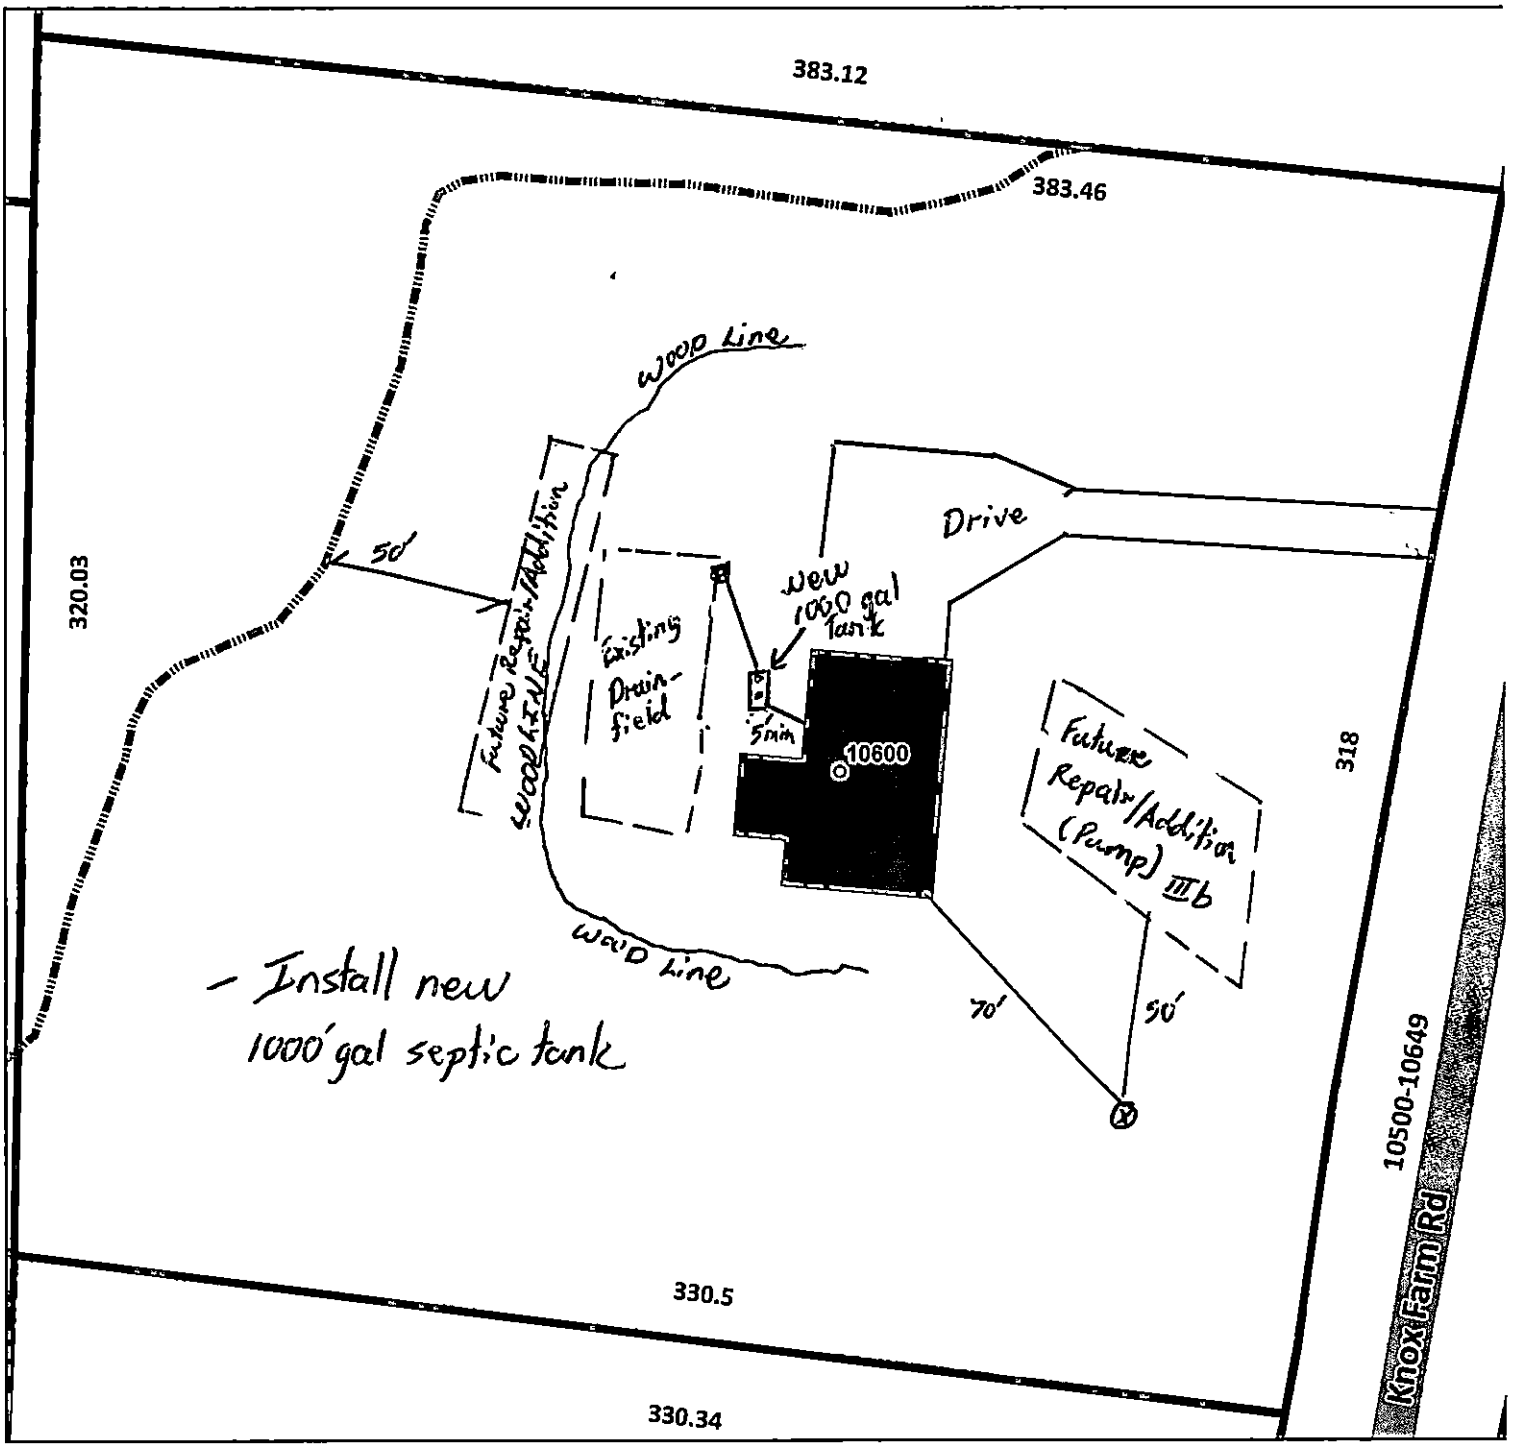

Mecklenburg County Health Department
Environmental Health - Groundwater and Wastewater Services

Permit #: 9051
PID #: 199-571-02
File #: 9776B

Authorized Agent: Bradley W. Hallman Date: 8/14/17

Owner/ Legal Agent: _____ Date: _____

1 inch = 50 fee

Mecklenburg County Groundwater & Wastewater Services
700 N. Tryon St., Suite 211 Charlotte, NC 28202
Phone: (980) 314-1680 Fax: (704) 336-6894

NC DHHS
Division of Environmental Health
On-Site Wastewater Section

OPERATION PERMIT for an ON-SITE WASTEWATER TREATMENT & DISPOSAL SYSTEM

File #: 9776B Permit #: 9151 Tax Parcel #: 199 571 02

Property Owner: Thomas L Gillis

Job Location Address: 10600 Knox Farm Rd

City: Charlotte State: NC Zip Code: 28278

Operation Permit Issuance Date: ~~9/13/17~~ 9/13/17 Contractor Name: John Watts

Permitted Design Flow: 360 GPD Liquid Capacity of Dosing Tank: NA gallons

Liquid Capacity of Septic Tank: 1000 new gallons Manufacture Dellinger Effluent Pump Model: NA

Drainfield Installation ☒ N/A

Trench Depth: _____ inches

Trench Width: _____ feet

Line Spacing: _____ feet (O.C.)

Total line length: _____ feet

# of Lines: _____ @ _____ feet

Depth of Media: _____ inches (Type) _____

Depth of Cover: _____ inches

Distribution Device: _____

Bed Installation *(For Repair Installations ONLY.)* ☒ N/A

Bed Depth: _____ inches

Bed Width: _____ feet

Total line length: _____ feet

# of Lines: _____ @ _____ feet

Depth of Media: _____ inches (Type) _____

Depth of Cover: _____ inches

Distribution Device: _____

Water Supply Source

☐ Municipal ☒ Private Well ☐ Community Well

☐ Other _____

System Installation Setbacks

Distance from Building Foundation: 5 feet

Distance from Property Line: 10 feet

Distance from Water Supply Source: 50' feet


Inspection Dates

Tank(s) Inspected: 7/13/17

Excavation Inspected: NA

Pump & Controls Inspected: NA

SKETCH OF SYSTEM INSTALLATION
(As-Built Drawing)

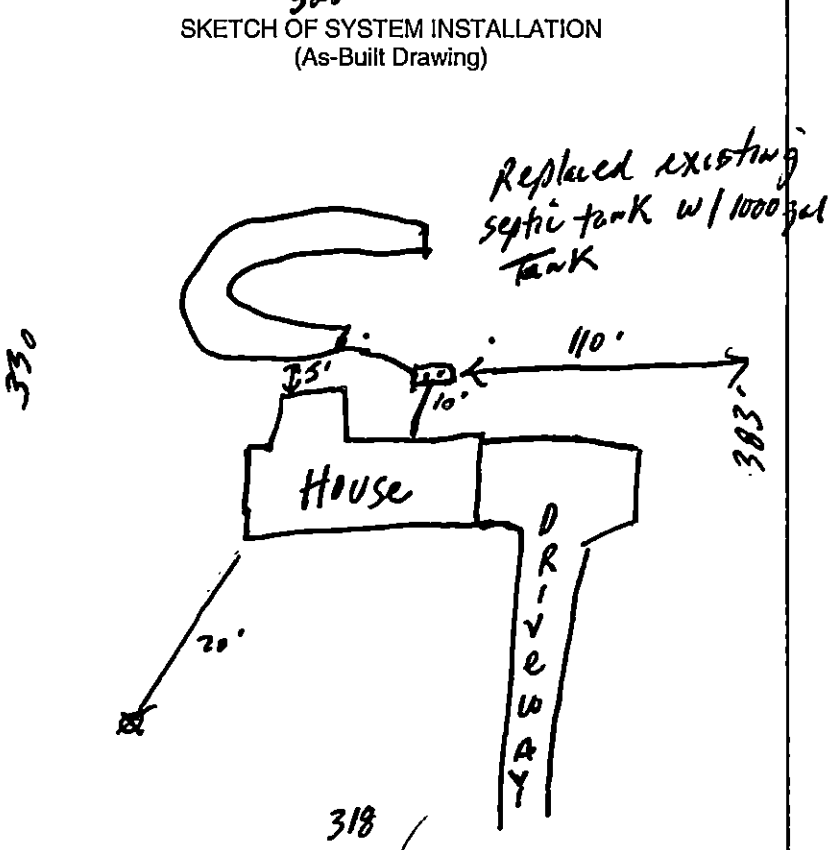


The undersigned has inspected the Septic Tank System described above, and certifies it has been ☒ installed ☐ altered ☐ repaired ☐ as detailed in the plot above ☐ in accordance with the permit issued and meets the provisions of 15A NCAC 18A. 1900, "Laws and Rules for Sewage Treatment and Disposal Systems" in effect on the date of issuance of the permit. The issuance of this Operation Permit does not in any way guarantee that the system will operate properly or relieve any person now or hereafter owning, controlling, or using such system from any liability resulting from the failure of the system to operate properly. This document is issued subject to those restrictions and conditions shown on the permit(s) and the provisions of 15A NCAC 18A. 1900 in addition to those listed below under "Comments." This document shall be null and void if any information contained in the application is untrue or if any additions are made to the property which would increase the requirements for said system.

Notice: Disturbance of the designated repair area may result in the Suspension or Revocation of this permit.

Comments: System Classification & Type: IIa Replaced existing tank w/ 1000 gal septic tank

DHHS Authorized Agent: Philo Walker Signature: Philo Walker REHS

 

Mecklenburg County Groundwater & Wastewater Services
700 N. Tryon St., Suite 211 Charlotte, NC 28202
Phone: (980) 314-1680 Fax: (704) 336-6894

NC DENR
Division of Environmental Health
On-Site Wastewater Section

OPERATION PERMIT for an
ON-SITE WASTEWATER TREATMENT & DISPOSAL SYSTEM

File #: 9776B Permit #: 9051 Tax Parcel #: 199 571 02

Property Owner: Thomas L. Gillis

Job Location Address: 10600 Knox Farm Rd

City: Charlotte State: NC Zip Code: 28278

OPERATION PERMIT CONDITIONS:

I. Performance: System shall perform in accordance with 15A NCAC 18A .1961.

II. Monitoring: System shall be monitored as required by 15A NCAC 18A .1961.

III. Maintenance: Ground absorption sewage treatment and disposal systems shall be checked, and the contents of the septic tank removed, periodically from all compartments, to ensure proper operation of the system. The contents shall be pumped whenever the solids level is found to be more than 1/3 of the liquid depth in any compartment.

IV. Operation: System shall be operated in accordance with 15A NCAC 18A .1961.

System Classification: IIa

*Operation Permits for Type V and VI systems expire five (5) years from the date of issuance (in accordance with Table V(a)). The system owner must contact GWS six (6) months prior to expiration for permit renewal.

Subsurface system operator required: Yes ☐ No ☒

☐ This type of system requires the system owner to maintain a contract with a certified operator to perform system inspection, maintenance, and reporting as required in 15A NCAC 18A .1961. and Table V(a). The system owner is responsible for all fees associated with these services.

☒ System does not require inspection by GWS on a routine frequency.

☐ System requires inspection by GWS once every five (5) years. The system owner is responsible for all fees associated with the inspection.

☐ System requires inspection by GWS once every three (3) years. The system owner is responsible for all fees associated with the inspection.


☐ System requires inspection by GWS once every twelve (12) months. The system owner is responsible for all fees associated with the inspection.

☐ System requires inspection by GWS once every six (6) months. The system owner is responsible for all fees associated with the inspection.

V. Other: Replace septic only

DENR Authorized Agent: Philo Walker Date: 9/13/17

Signature: Philo Walker REHS

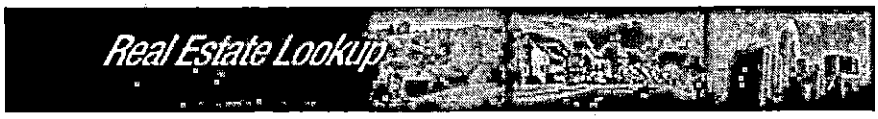

Print

Close

Parcel Information

Parcel ID	Account	Parent	Previous
19957102	INDIVIDUAL		

Owner(s)

Owner Name	Mailing Address	City/State
GILLIS THOMAS LACY	10600 KNOX FARM RD	CHARLOTTE NC 28278
MARCIA T GILLIS (H/W)	10600 KNOX FARM RD	CHARLOTTE NC 28278

Legal Information

Legal	Municipality	Date Annexed	Special District	Fire District	Acreage
NA	CHARLOTTE	06/30/2005		CITY OF CHARLOTTE	2.6

Total Parcel Assessment

Building	Land	Features	Total
139900	88400	700	229000

Exemptions

Exemption	Year Approved	Review Date	Amount

Sales Information

Sale	Price	Stamps	Qualify	VI	Type	Legal Ref.	Grantor
Oct 21 1980	14500			VAC	DEED STAMPS	04360-728	

Land Use

Use	Units	Type	Neighborhood	Assessment
R120	2.6	AC	T901	88400

Building Information

Bldg	Description	Type	Year	Property Location
1	Single-Fam	RES	1986	10600 KNOX FARM RD CHARLOTTE

Bldg	Story	Units	Total SqFt	Heated SqFt	Foundation	Ext. Wall	Grade	Value
1	1 STORY	1	4496	2076	CRAWL SPACE	FACE BRICK -	AVERAGE 01	139900

Bldg	Heat	Fuel	Fire Place	AC	Fixtures	Bedrooms	Full Baths	3/4 Baths	1/2 Baths
1	AIR-DUCTED	ELECTRIC	1 - FP3	AC-CENTRAL	0	3	2	0	1

Sub Area

Bldg	Description	Size
1	BASEMENT - UNFINISHED	2076
1	PORCH - OPEN - FINISHED	24
1	PORCH - SCREENED - FINISHED	320
1	BASE (FIRST FLOOR)	2076

Depreciation

Bldg	Physical	Functional	Economic	Special	Override
1	AV - 21.00%	- 0.00%	- 0.00%	- 0.00%	- 0.00%

Special Features & Yard Items

Bldg	Built	Type	Quantity	Units	Value
1	1986	DECK	1	130.00000	700

Notes


Tax Year	Notes	Note Date
2011	Informal Review Request Received	02/22/2011

Value Changes

Notice Date	Tax Year	Reason	Changed To	Deferred
Feb 8 2011	2011	Countywide Revaluation	230000	0
Jan 17 2003	2003	Countywide Revaluation	224800	0

Polaris 3G Map – Mecklenburg County, North Carolina


Date Printed: 7/31/2017 1:37:47 PM

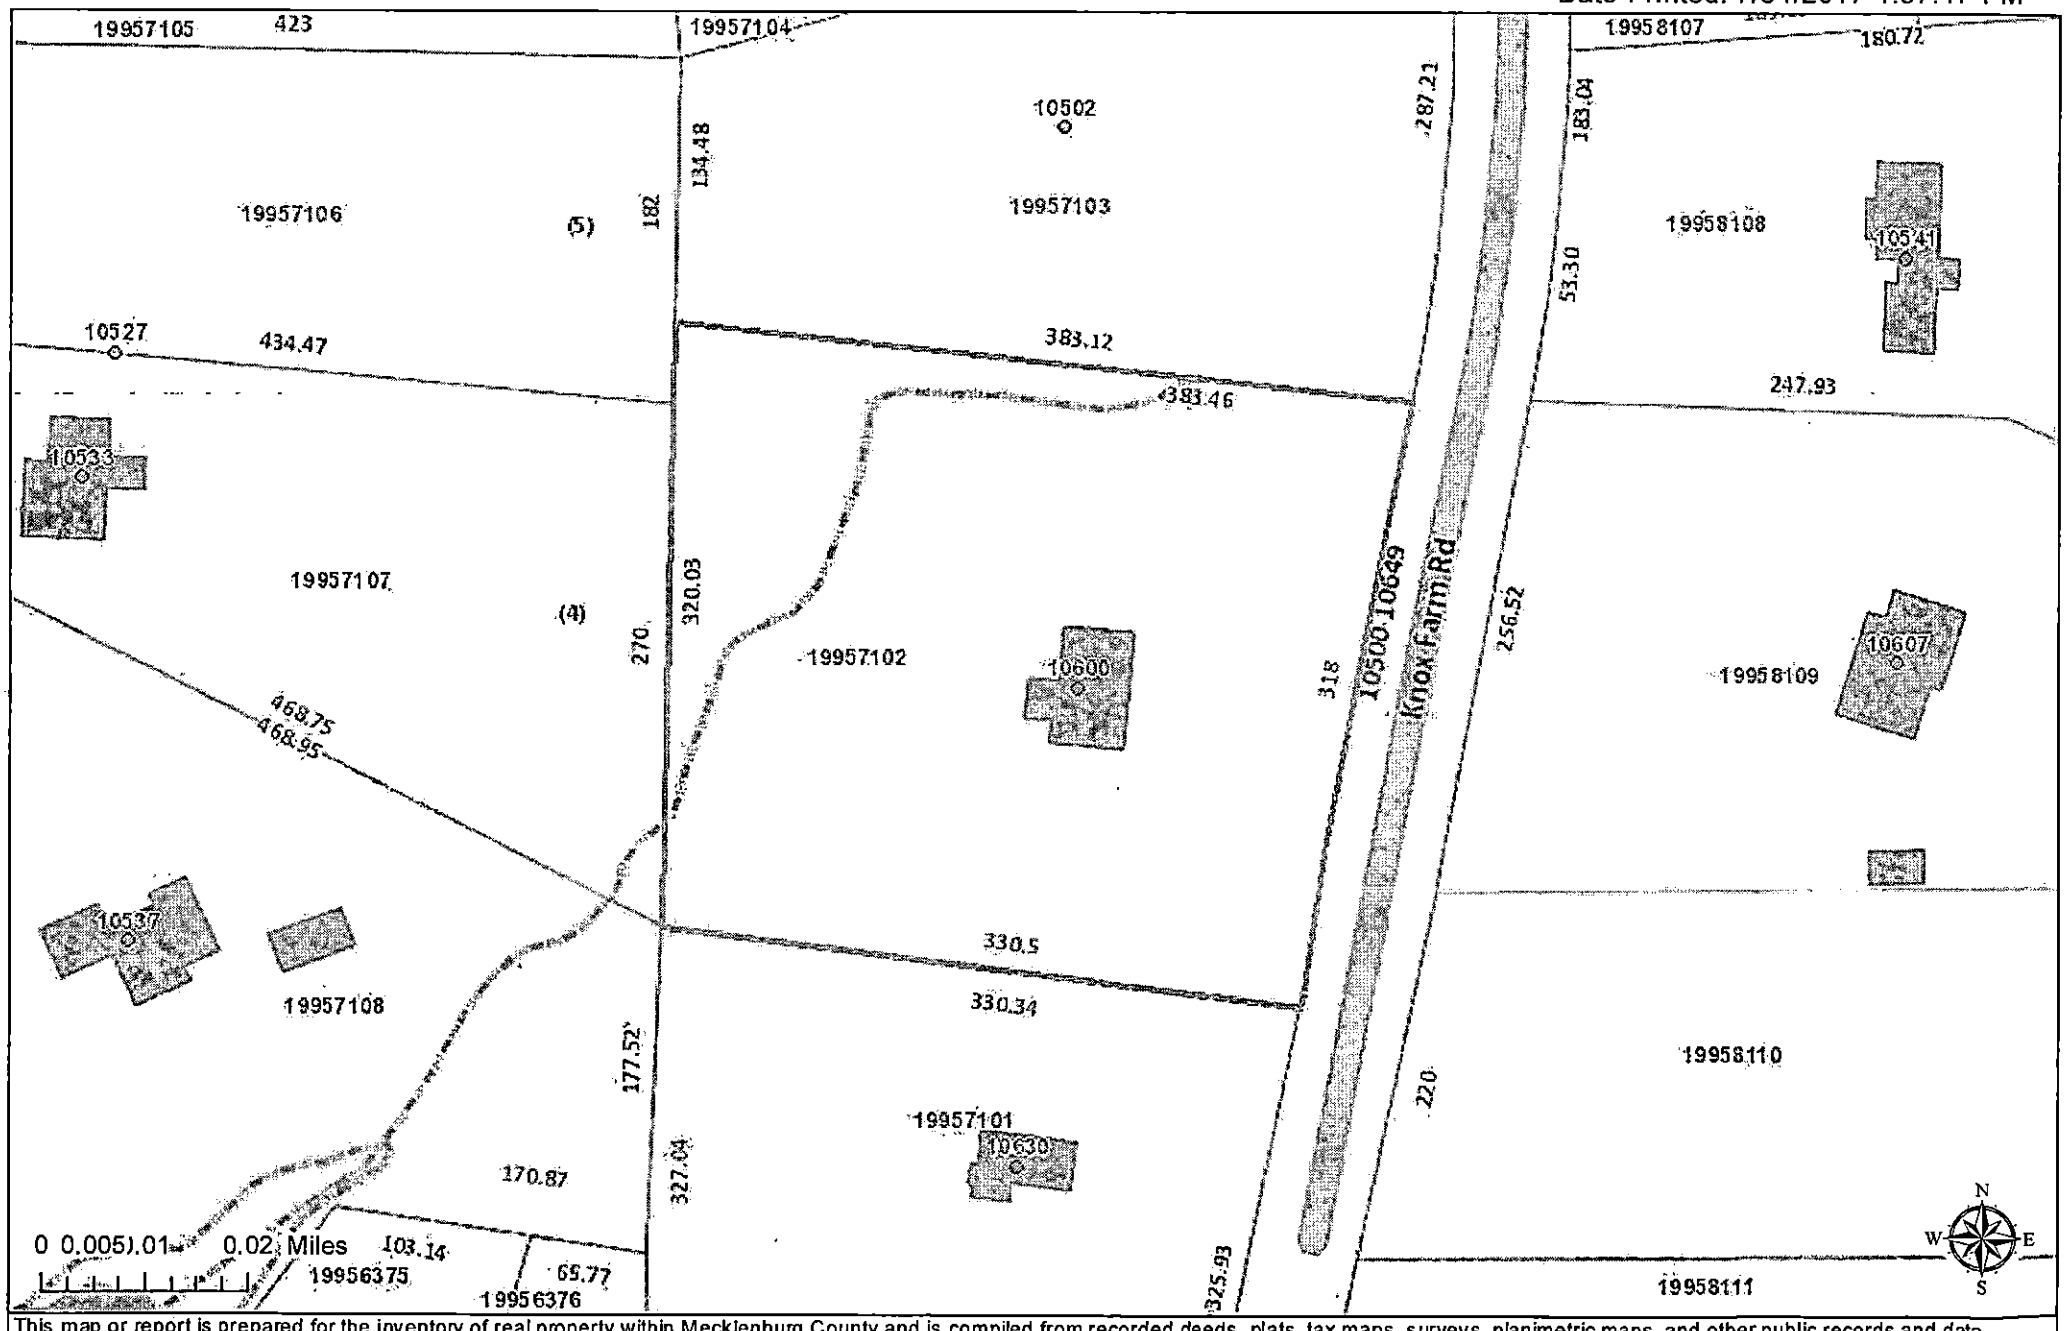

This map or report is prepared for the inventory of real property within Mecklenburg County and is compiled from recorded deeds, plats, tax maps, surveys, planimetric maps, and other public records and data. Users of this map or report are hereby notified that the aforementioned public primary information sources should be consulted for verification. Mecklenburg County and its mapping contractors assume no legal responsibility for the information contained herein.

DocuSign Envelope ID: 37D8F738-A2E8-485E-99E3-DFC5AFDA4A98

On-site Wastewater Improvement Permit Diagram

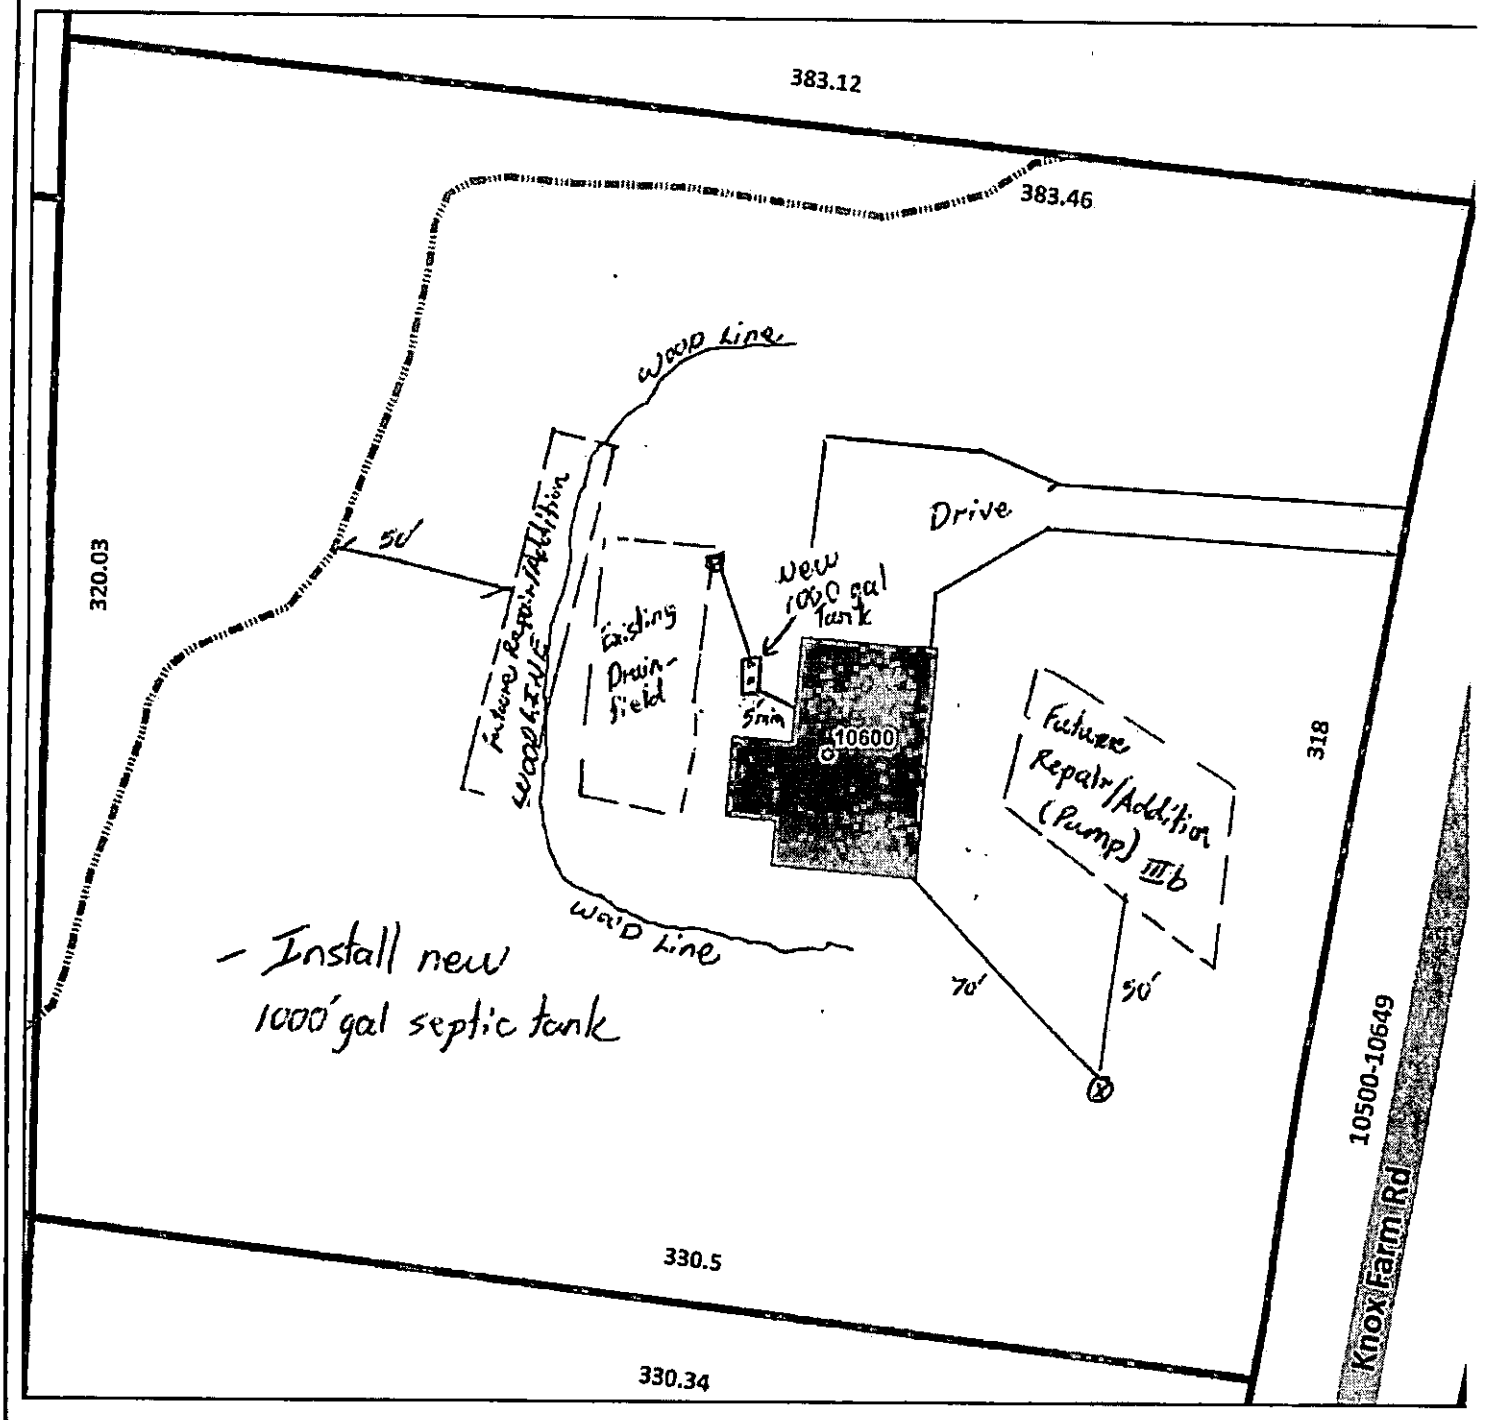

Mecklenburg County Health Department
Environmental Health - Groundwater and Wastewater Services

Permit #: 9051
PID #: 199-571-02
File #: 9776B

Authorized Agent: Bradley W. Hallman Date: 8/14/17

Owner/ Legal Agent: DocuSigned by: 7762413710DF454... Date: 8/16/2017

1 inch = 50 fee


File #: _____

PROPOSED PLOT PLAN

A drawing showing the locations of the following items is required: existing and proposed property lines with dimensions, easements or right-of-ways, proposed building pad(s) or existing building footprint(s), all appurtenances (garage, driveway, deck, pool, etc.), location of existing or proposed well(s), location of existing or proposed sewer lines and sewage disposal systems, surface water bodies, and any aboveground or underground storage tanks. Provide names for all roads that adjoin the property.

Street Address: 10600 Knox Farm Rd Tax Parcel #: 19957102

Subdivision Name: N/A Lot #: _____

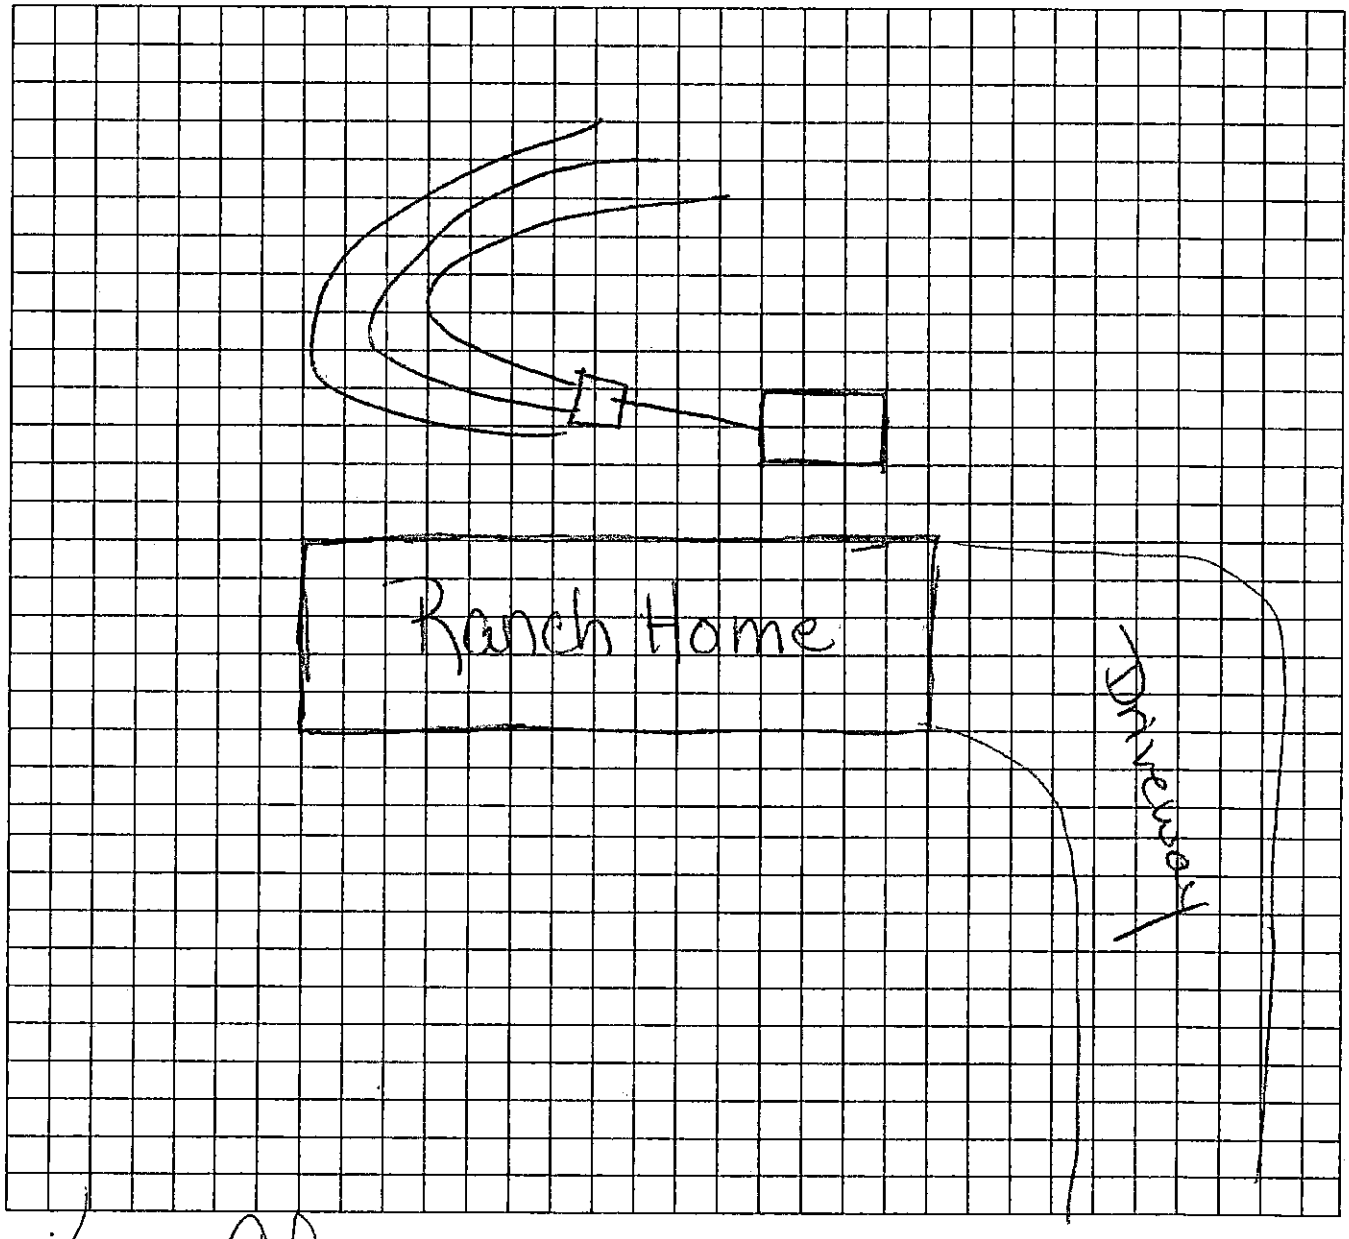

Karen Glenn
Property Owner's or Owner's Legal Representative Signature

7-20-17
Date

MECKLENBURG COUNTY – GROUNDWATER & WASTEWATER SERVICES
700 N. TRYON ST. SUITE 211 CHARLOTTE, NC 28202, OFFICE: 980-314-1680, FAX: 704-336-6894
Email: Wellreg@MecklenburgCountyNC.gov

Revised on: 4/20/17

DocuSign Envelope ID: EA7E0689-6CF2-4386-A298-A27482ED3C1D

MECKLENBURG COUNTY
Health Department

E. Winters Mabry, MD
Director

(704) 432-3199

Addendum to Application for
New Well or Septic System Installation
Abandonment or Repair of Existing Well or Septic System

Your signature below confirms the following:

1. The information on the application is true, complete and accurate.
2. Authorized county and state officials are granted right of entry to conduct necessary inspections to determine compliances with applicable laws and rules.
3. I acknowledge that Karen Glenn is acting as my legal representative (agent) in the submittal of the application for a water supply well or septic permit located at

10600 Knox Farm Rd Charlotte
Number Street Town
(Or Parcel Number)

Thomas Gillis
Property Owner (print name)

DocuSigned by:
Property Owner (signature)
17624137E10DF454...

7/20/17
Date

Department of Environment, Health, and Natural Resources
Division of Environmental Health
On-site Wastewater Section

Sheet: 1 of 2
Property ID: 199-571-02
Lot #: NA
File #: 9776B
AppID: 9051

SOIL/SITE EVALUATION for ON-SITE WASTEWATER SYSTEM

Property Owner: Thomas L. Gillis
Address: 10600 Knox Farm Rd, Charlotte, NC 28278
Proposed Facility: 3 Bedroom House Repair
Design Flow (.1949): 360 GPD
Location of Site: 10600 Knox Farm Rd, Charlotte, NC 28278
Water Supply: [ ] Public [X] Individual [X] Well [ ] Spring [ ] Municipal
Evaluation Method: [X] Auger Boring [ ] Pit [ ] Cut
Type of Wastewater: [X] Sewage [ ] Industrial Process [ ] Mixed

Applicant: Karen Glenn
Date Evaluated: 8/2/2017
Property Size: 2.6 ac
Property Recorded: 1986

PROFILE #	.1940 Landscape Position/ Slope%	Horizon Depth (IN.)	SOIL MORPHOLOGY .1941 .1941 Structure/ Texture	.1941 Consistence Mineralogy	b PROFILE FACTORS .1942 Soil Wetness/ Color	.1943 Soil Depth (IN.)	.1956 Sapro Class	.1944 Restr Horiz	General Comments	Profile Class & LTAR	Maximum Trench Bottom Depth for 3' Wide Conventional Trench
Boring #1	LS 11%	0 - 2	gr CL	SS SP FR SEXP	>56"	52	NA	NA		PS IV 0.25	36"
		2 - 38	sbk C	S P FI SEXP							
		38 - 52	sbk CL	SS SP FR SEXP							
		52 - 56	Saprolite								
Boring #2	LS 14%	0 - 4	gr CL	SS SP FR SEXP	>53"	53	NA	NA		PS IV 0.25	36"
		4 - 42	sbk C	S P FI SEXP							
		42 - 53	sbk CL	SS SP FR SEXP							

Description	Initial System	Repair System
Available Space (.1945)		
System Type(s)		
Site LTAR (gpd/sq ft)		0.25

Other Factors (.1946):
Soil Evaluation By: Jacob Presley, REHS, LSS
Others Present:
Site Classification (.1948):
Site Evaluation By:
Others Present:

COMMENTS:

Sheet: 2 of 2
File #: 9776B
AppID: 9051

Landscape Position	Group	Texture	.1955 LTAR	Structure
R-Ridge	I	S-Sand	1.2 - 0.8	sg-Single Grain
SS-Shoulder Slope		LS-Loamy Sand		mass-Massive
LS-Linear Slope				cr-Crumb
FS-Foot Slope	II	SL-Sandy Loam	0.8 - 0.6	gr-Granular
NS-Nose Slope		L-Loam		sbk-Subangular Blocky
HS-Head Slope				abk-Angular Blocky
CC-Concave Slope	III	Si-Silt	0.6 - 0.3	pl-Platy
CV-Convex Slope		SiCL-Silty Clay Loam		pr-Prismatic
T-Terrace				Sap-Saprolite
FP-Flood Plain		CL-Clay Loam		**Structure Prefixes**
D-Drainage Way		SCL-Sandy Clay Loam		w-weak
				m-moderate
		SiL-Silt Loam		s-strong
				f-fine
	IV	SC-Sandy Clay	0.4 - 0.1	m-medium
		SiC-Silty Clay		c-coarse
		C-Clay		

Consistence Moist	Consistence Wet	Mineralogy
VFR-Very Friable	SS-Slightly Sticky	SEXP-Slightly Expansive
FR-Friable	S-Sticky	EXP-Expansive
FI-Firm	VS-Very Sticky	
VFI-Very Firm	NP-Non-Plastic	**Classification**
EFI-Extremely Firm	SP-Slightly Plastic	US-Unsuitable
	P-Plastic	PS-Provisionally Suitable
	VP-Very Plastic	S-Suitable
		NA-Not Applicable

Sketch of Soil Evaluation Locations

