

8611 VIOLA DR

10909119

1/10/2008

duponbj

Groundwater and Wastewater Services File Imaging Project
May 2007
Barcode Font = IDAutomationHC39M

Mecklenburg County Groundwater & Wastewater Services
700 N. Tryon St., Suite 211 Charlotte, NC 28202
Phone: (704) 336-5103 Fax: (704) 336-6894

NC DENR
Division of Environmental Health
On-Site Wastewater Section

OPERATION PERMIT for an
ON-SITE WASTEWATER TREATMENT & DISPOSAL SYSTEM

File #: 6525B Permit #: _____ Tax Parcel #: 109-09-119

Property Owner: CHARLES HELTON

Job Location Address: 8611 VIOLA DR.

City: CHARLOTTE State: NC Zip Code: 28212

Operation Permit Issuance Date: 5/22/06 Contractor Name: STANLEY SEPTIC

Permitted Design Flow: _____ GPD

Liquid Capacity of Septic Tank: 1500 gallons

Liquid Capacity of Dosing Tank: N/A gallons

Effluent Pump Model: N/A

Drainfield Installation ☑ N/A

Trench Depth: _____ inches

Trench Width: _____ feet

Line Spacing: _____ feet (O.C.)

Total line length: _____ feet

# of Lines: _____ @ _____ feet

Depth of Media: _____ inches (Type) _____

Depth of Cover: _____ inches

Distribution Device: _____

Inspection Dates

Tank(s) Inspected: 5/22/06

Excavation Inspected: 5/22/06

Pump & Controls Inspected: N/A

Bed Installation *(For Repair Installations ONLY.)* ☐ N/A

Bed Depth: 36 inches

Bed Width: 9 feet

Total line length: 50 feet


# of Lines: _____ @ _____ feet 9'X50'X18"

Depth of Media: 18 inches (Type) STONE

Depth of Cover: 18 inches

Distribution Device: D-BOX

SKETCH OF SYSTEM INSTALLATION
(As-Built Drawing)

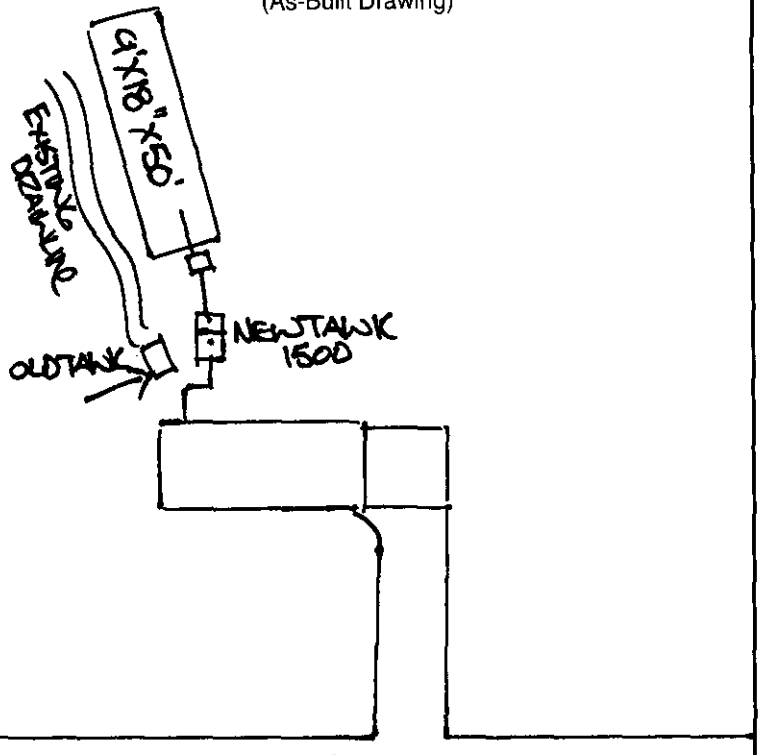

8611 VIOLA DR.

Water Supply Source

☑ Municipal ☐ Private Well ☐ Community Well

☐ Other _____

System Installation Setbacks

Distance from Building Foundation: 5 feet

Distance from Property Line: 10 feet

Distance from Water Supply Source: 7100' feet

The undersigned has inspected the *Septic Tank System described above*, and certifies it has been ☐ installed ☐ altered ☑ repaired ☑ as detailed in the plot above ☐ in accordance with the permit issued and meets the provisions of 15A NCAC 18A. 1900, "Laws and *Rules for* Sewage Treatment and Disposal Systems" in effect on the date of issuance of the permit. The issuance of this Operation Permit does not in any way guarantee that the system will operate properly or relieve any person now or hereafter owning, *controlling*, or using such system from any liability resulting from the failure of the system to operate properly. This document is issued subject to those restrictions and conditions shown on the permit(s) and *the provisions of* 15A NCAC 18A. 1900 in addition to those listed below under "Comments." This document shall be null and void if any information contained in the application is untrue or if any additions are *made to the property* which would increase the requirements for said system.

Notice: Disturbance of the designated repair area may result in the Suspension or Revocation of this permit.

Comments: System Classification & Type: TYPE II CONVENTIONAL. REPAIR BED. 9'X50'+18" GRAVEL. 1500 ST, D-BOX.

DENR Authorized Agent: MARK CORNELIUS, RS Signature: Mark Cornelius, RS

Mecklenburg County Groundwater & Wastewater Services
700 N. Tryon St., Suite 211 Charlotte, NC 28202
Phone: (704) 336-5103 Fax: (704) 336-6894

NC DENR
Division of Environmental Health
On-Site Wastewater Section

INSTALLATION APPROVAL for an
ON-SITE WASTEWATER TREATMENT & DISPOSAL SYSTEM

File #: 6525B Permit #: _____ Tax Parcel #: 109-09-119

Property Owner: CHARLES HELTON

Job Location Address: 8611 VIOLA DR.

City: CHARLOTTE State: NC Zip Code: 28212

Installation Approval Issuance Date: 5/5/06

Permission is hereby given to ☑ install ☐ alter ☐ repair an on-site wastewater treatment & and disposal system, with subsurface soil absorption and effluent discharge, as specified herein at the described location. This approval is granted based upon the application information submitted to our office. All work shall be completed on or before 5/31/06, after which date this approval shall be null and void. The system shall meet all of the construction requirements of 15A NCAC 18A. 1900 which are in effect on the date of granting this approval. An **Operation Permit** must be obtained from the Mecklenburg County Health Department before any system can be covered up or placed into service. The issuance of this permit does not in any way guarantee that the system anticipated to be constructed will operate properly, or relieve any person now of hereafter owning, controlling or using such system from any liability resulting from the failure of the system to operate properly.

***NOTICE: This system shall not be installed while soils are in a wet condition.**

Permitted Design Flow: _____ GPD

Site LTAR: _____ GPD/ft² (For new installations only.)

Liquid Capacity of Septic Tank: EXISTING gallons

Liquid Capacity of Dosing Tank: N/A gallons

Drainfield Design ☐ N/A

Trench Depth: _____ inches

Trench Width: _____ feet

Line Spacing: _____ feet (O.C.)

Total line length: _____ feet

# of Lines: _____ @ _____ feet

Depth of Media: _____ inches (Type) _____

Distribution Device: _____

Bed Design *(For Repair Installations ONLY.)* ☐ N/A

Bed Depth: 36" inches

Bed Width: 9' feet

Total line length: 50' feet

# of Lines: _____ @ _____ feet 9'X50'X18"

Depth of Media: 18 inches (Type) STONE

Distribution Device: D-BOX

Water Supply Source

☑ Municipal ☐ Private Well ☐ Community Well

☐ Other _____


Minimum System Setbacks

Distance from Building Foundation: 5 feet

Distance from Property Line: 10 feet

Distance from Water Supply Source: 7100 feet

SKETCH OF SYSTEM LAYOUT
(Proposed Layout)

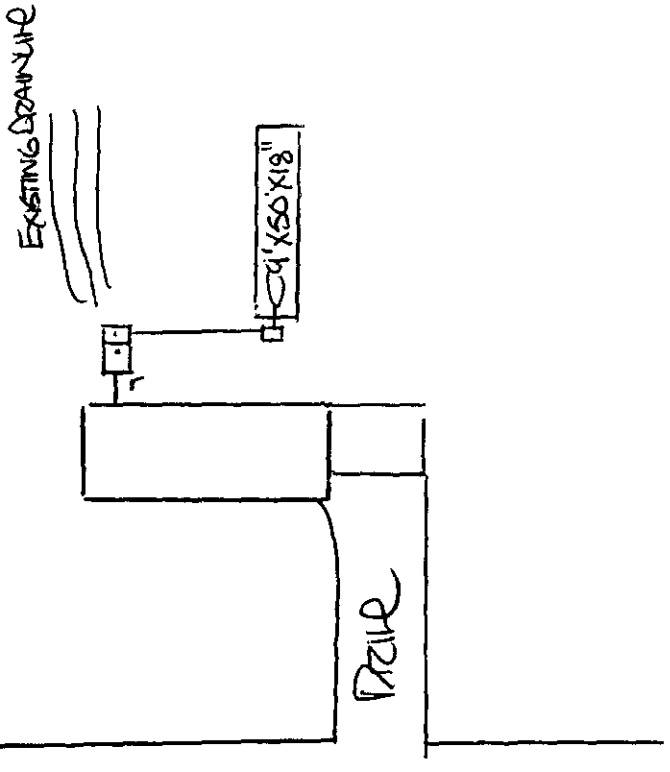

Comments: System Classification & Type: REPAIR BED TYPE II. CONVENTIONAL. INSTALL 9'X50' BED W/ 18" STONE. NEW D-BOX. KEEP DRAINLINE 75' FROM HOUSE FOUNDATION, 710' FROM PROPERTY LINE.

DENR Authorized Agent: DAVID CORNELIUS Signature: [signature] RS

#871

GWS – RES. APP 07/05

SEPTIC FEE: _____
DATE: _____
CRT [ ]

PERMIT APPLICATION FOR A RESIDENTIAL SITE IMPROVEMENT PERMIT / CONSTRUCTION AUTHORIZATION FOR ON-SITE WASTEWATER SYSTEM NEW WELL INSTALLATION OR REPAIR OF EXISTING WELL MECKLENBURG COUNTY GROUNDWATER & WASTEWATER SERVICES

WELL FEE: _____
DATE: _____
CRT [ ]

FILE # 65258

SEPTIC / TYPE APPLICATION: ☐ NONE ☐ NEW SYSTEM ☐ ALTERATION ☑ REPAIR ☐ MODIFY PLOT PLAN

WELL / TYPE APPLICATION: ☐ NONE ☐ NEW WELL ☐ MAJOR REPAIR ☐ ABANDONMENT

JOB LOCATION INFORMATION:

TAX/PARCEL #: 109-09-119
STREET ADDRESS: 8611 VIOLA DR.
CITY: CHARLOTTE
STATE: NC ZIP: 28212
SUBDIVISION OR MOBILE HOME PARK NAME:
LOT #: 12 B 1
TOWNSHIP:

☑ 0-MECKLENBURG ☐ 4-PINEVILLE
☐ 1-CHARLOTTE ☐ 5-MATTHEWS
☐ 2-DAVIDSON ☐ 6-HUNTERSVILLE
☐ 3-CORNELIUS ☐ 7-MINT HILL

1965

BUILDING INFORMATION:

TYPE OF BUILDING:

☐ SINGLE MOBILE HOME (S) ☐ MODULAR HOME (M)
☐ DOUBLE WIDE (D) ☐ MULTIPLE FAMILY (U)
☑ HOUSE (H) ☐ OTHER

HEATED SQUARE FOOTAGE: 1200SF
NUMBER OF BEDROOMS: 3
NUMBER OF OCCUPANTS: 2

FOUNDATION FOR RESIDENCE:

☑ CONCRETE SLAB ☐ BASEMENT WITH PLUMBING
☐ CRAWLSPACE ☐ BASEMENT WITH NO PLUMBING

IF PLANNING TO EXPAND/ALTER THE EXISTING SYSTEM INDICATE THE FOLLOWING CHANGES:

NUMBER OF BEDROOMS TO BE ADDED: NUMBER OF ADDITIONAL OCCUPANTS IN THE RESIDENCE:
WILL THERE BE A HOME BUSINESS IN THE RESIDENCE? ☐ YES ☑ NO TYPE:

WATER SUPPLY:

☑ MUNICIPAL (M) ☐ PUBLIC (C) ☐ PRIVATE WELL (P) ☐ SHARED WELL (S) ☐ OTHER 'SPRINGS' (O)

PROPOSED USE OF WELL: ☐ N/A ☐ IRRIGATION ☐ POTABLE ☐ GEOTHERMAL ☐ OTHER

ARE ANY OF THE FOLLOWING LOCATED ON THE PROPERTY? IF SO, PLEASE SHOW LOCATION ON SITE PLAN/PLAT.

BURIED CABLES, LANDFILLS, STUMPHOLES	☐ YES ☑ NO	WELLS, SPRINGS, OR WATER LINES	☐ YES ☑ NO
EXISTING WASTEWATER SYSTEMS	☑ YES ☐ NO	DESIGNATED WETLANDS	☐ YES ☑ NO
EASEMENTS OR RIGHT-OF-WAYS	☐ YES ☑ NO	GRADING/SOIL REMOVAL PERFORMED	☐ YES ☑ NO

PROPERTY OWNER:

NAME: CHARLES HELTON
ADDRESS: 8611 VIOLA DR
CITY: CHARLOTTE
STATE: NC ZIP: 28212
HOME PHONE: WORK PHONE:
MOBILE PHONE: FAX:

LEGAL AGENT FOR PROPERTY OWNER, IF APPLICABLE:

NAME:
ADDRESS:
CITY:
STATE: ZIP:
HOME PHONE: WORK PHONE:
MOBILE PHONE: FAX:

WHAT DATE WAS THE PROPERTY ORIGINALLY DEEDED AND RECORDED?
WHAT IS THE ANTICIPATED CLOSING DATE FOR THIS PROPERTY?

*An Improvement Permit is subject to suspension or revocation if site plans or the intended use change or if information submitted in this application is falsified or changed. The undersigned, owner, or legal agent for the owner, of the property described above as the "Job Location" has read the foregoing application, acknowledges that the contents of same are true, and authorizes the Mecklenburg County Health Department to enter onto the property for the purpose of processing this request.

Charles Helton 4/19/06
Owner's/Agent's Signature Date

NORTH CAROLINA DEPARTMENT OF
ENVIRONMENT & NATURAL RESOURCES DIVISION
OF ENVIRONMENTAL HEALTH ON-SITE
WASTEWATER SECTION

*A Well Permit is subject to suspension or revocation if site plans or the intended use change or if information submitted in this application is falsified or changed. The undersigned, owner, or legal agent for the owner, of the property described above as the "Job Location" has read the foregoing application, acknowledges that the contents of same are true, and authorizes the Mecklenburg County Health Department to enter onto the property for the purpose of processing this request.

Owner's/Agent's Signature Date

MECKLENBURG COUNTY HEALTH DEPARTMENT
GROUNDWATER & WASTEWATER SERVICES
700 N. TRYON ST., SUITE 211
CHARLOTTE, NC 28202 704-336-5103 / FAX: 704-336-6894