

9120 CROSSTIMBERS DR

10526205

4/30/08

marliwr

Groundwater and Wastewater Services File Imaging Project
May 2007
Barcode Font = IDAutomationHC39M

CERTIFICATE OF COMPLETION/OPERATION PERMIT

HEALTH DEPARTMENT
ENVIRONMENTAL HEALTH DIVISION
700 NORTH TRYON ST., SUITE 211
CHARLOTTE, NC 28202
PHONE (704) 336-5102

FILE: 2208A DATE: 7-14-00

TC: 105-262-05 ☒ L ☐ CRT

SERIAL Nº 18381

Name of Owner SANDRA MORRISON Juris.: _____

Address of Property 9120 CROSS TIMBERS DRIVE

Inspection Data:

Tank Material PCC1500

Total Length of Drainfield 400

Number of Lines 4 @ 100

Cover Depth 12"

Water Supply Source MUNICIPAL

Distance to Water Source >10'

Excavation Inspected 7-12-00

Tank(s) Inspected 7-14-00

Wash Line Inspected —

High Water Alarm Inspected _____

SEE INSTALLATION

PLOT

Design 1500 ST 1200 SFT CONV 12C CTR# RCS

The undersigned has inspected the Septic Tank System described above, and certifies it has been

☐ installed or constructed ☐ altered or repaired

☑ in accordance with the permit issued ☐ as detailed in the plot above

and meets the provisions of I5A NCAC 18A. 1900, "Laws And Rules For Sewage Treatment and Disposal Systems" in effect on the date of issuance of the permit. This issuance of this

☐ Certificate of Completion ☑ Operation Permit

does not in any way guarantee that the system will operate properly or relieve any person now or hereafter owning, controlling, or using such system from any liability resulting from the failure of the system to operate properly. This document is issued subject to those restrictions and conditions shown on the permit(s) and the provisions of I5A NCAC 18A. 1990 in addition to those listed below under "COMMENTS." This document shall be null and void if any information contained in the application is untrue or if any additions are made to the property which would increase the requirements for said system.

Notice: Disturbance of the designated repair area may result in the suspension/revocation of this permit.

COMMENTS: TYPE II-C

Environmental Health Specialist

Mecklenburg County services are available without regard to ethnic origin, sex, or disability.

INSTALLATION, CONSTRUCTION, ALTERATION, AND/OR REPAIR APPROVAL


HEALTH DEPARTMENT
ENVIRONMENTAL HEALTH DIVISION
700 NORTH TRYON ST., SUITE 211
CHARLOTTE, NC 28202
PHONE (704) 336-5102

FILE: 2208A DATE: 6-22-00

TC: 105-262-05 ☐ L

SERIAL Nº 18462

Permission is hereby given to _____ Install or Construct, _____ Alter or Repair the individual septic tank wastewater treatment system with subsurface, soil absorption, effluent discharge as specified herein at the described location. This permit is granted based upon the information supplied in the application dated 5-18-99. All work shall be completed on or before 6-22-00, after which date this permit shall be null and void. The system shall meet all of the construction requirements of I5A NCAC 18A. 1900 which are in effect on the date of the granting of this permit. A Certificate of Completion or an Operation Permit must be obtained from the Mecklenburg County Health Department before any system can be covered up or placed into service. The issuance of this permit does not in any way guarantee that the system anticipated to be constructed will operate properly, or relieve any person now or hereafter owning, controlling or using such system from any liability resulting from the failure of the system to operate properly.

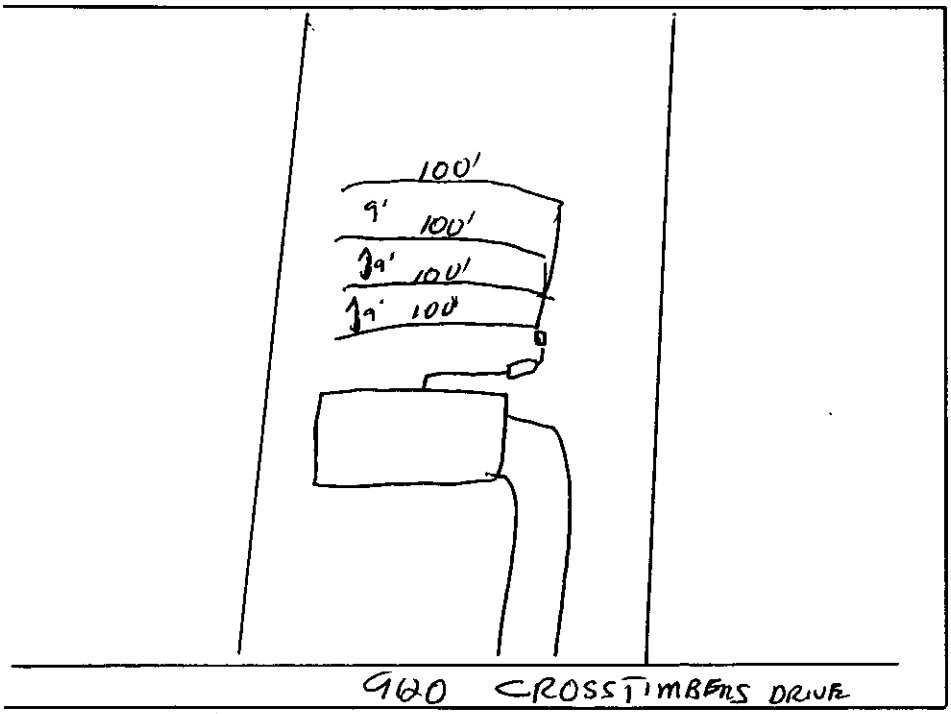

PLOT OF SYSTEM

Liquid Capacity of Septic Tank 1500 gallons

Liquid Capacity of Dosing Tank _____ gallons

Tank Construction PCC

Trench Depth 30"

Absorption and/or Nitrification Lines:

Trench Width 3 feet

Trench Walls Scored and Porous YES

Total Line Length 400 feet

Number of Lines 4

Depth of Stone 12" inches

Distance from House >5 feet

Distance from Property Line 10' feet

Distance from Well >100' feet

NOTICE: This system shall not be installed while soils are in a wet condition.

NAME OF OWNER SANDRA MORRISON

LOCATION OF PROPERTY 9120 CROSSTIMBERS DRIVE

Comments: _____

Environmental Health Specialist

WHITE - HEALTH DEPARTMENT's COPY • CANARY - E.H.S. COPY • PINK - OWNER OR AGENT's COPY

PROPOSED PLOT PLAN

HEALTH DEPARTMENT
ENVIRONMENTAL HEALTH DIVISION
700 NORTH TRYON STREET
CHARLOTTE, NC 28202
PHONE (704) 336-5102

FILE: 2208A ~~2953B~~

TC: 105-262-05


Draw in and name all roads adjoining the property. Draw in and accurately dimension the lot concerned. Accurately indicate property boundaries proposed and/or existing structures and driveways, underground utilities, and wells and springs within 100 feet of the proposed building or drainfield.

PERMIT FOR
FARMWOOD NORTH
LOT #25

SCALE 1" = 40'

(1) INSTALL DRAIN LINES SHALLOW 24" AND ON CONTOUR.

(2) LOCATE ALL PARTS OF SEPTIC TANK SYSTEM 15' FROM ANY POOL AND 5' FROM DECK OR BUILDING FOUNDATION.

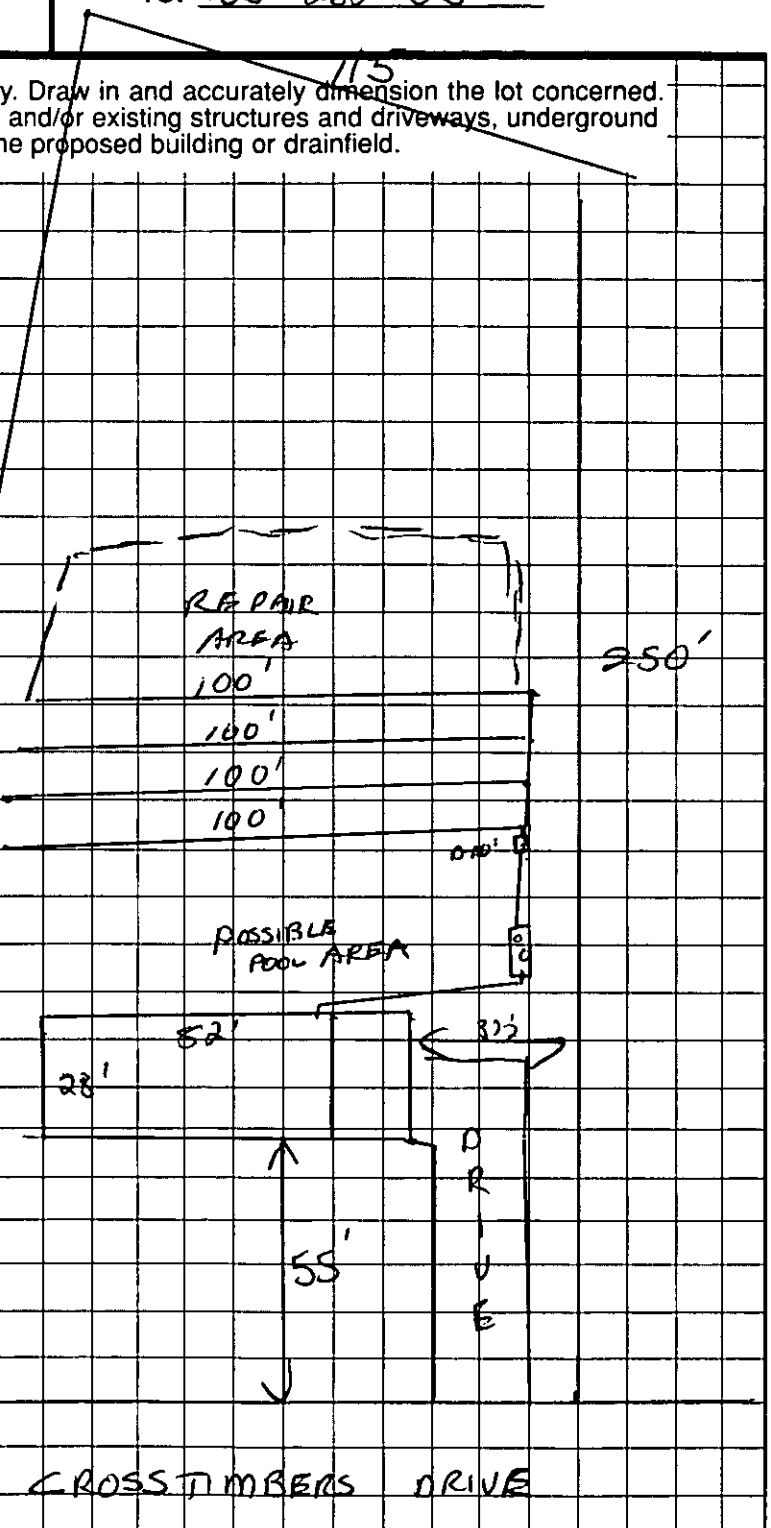

9120 CROSSTIMBERS DRIVE

X _____
OWNER/AGENT SIGNATURE

DATE

APPROVAL DATE _____

White - Health Department's Copy Canary - E.H.S. Copy Pink - Owner's Copy

cLtH 1681

FEE: 300 / AUTHORIZATION FOR WASTEWATER SYSTEM CONSTRUCTION
DATE: 3/28/02 VOID SIXTY (60) MONTHS FROM DATE OF ISSUANCE

DATE: _____ PERMIT NO: 2208A
PARCEL NO: 105-262-05

JOB LOCATION ADDRESS: 9120 CROSS TIMBERS DRIVE
PROPERTY OWNER: CRAIG GERGEN
BUILDING CONTRACTOR: CRAIG GERGEN
SUBDIVISION NAME: FARMWOOD NORTH LOT 25
AUTHORIZATION ISSUED BY: _____ DATE: 6-11-99
DEHNR AUTHORIZED AGENT

AUTHORIZATION CONDITIONS

1. WASTEWATER SYSTEM CONSTRUCTION AND INSTALLATION MUST MEET ALL CONDITIONS AND SPECIFICATIONS AS SET FORTH IN IMPROVEMENT PERMIT NO. _____, AND THE ATTACHED SITE PLAN WITH SYSTEM DETAILS. CONSTRUCTION AND INSTALLATION MUST ALSO MEET ALL REQUIREMENTS SET FORTH IN THE RULES GOVERNING SANITARY SEWAGE COLLECTION, TREATMENT, AND DISPOSAL AND ANY OTHER APPLICABLE RULES AND LAWS.

2. AN INSTALLATION, CONSTRUCTION, ALTERATION AND/OR REPAIR APPROVAL MUST BE SECURED PRIOR TO INSTALLATION OF THE SEPTIC TANK SYSTEM. THE INSTALLER OF THE SYSTEM SHALL BE A REGISTERED SEPTIC TANK CONTRACTOR WITH MECKLENBURG COUNTY HEALTH DEPARTMENT.

3. ANY ALTERATION IN SITE OR SOIL CONDITIONS (INCLUDING LOCATION OF STRUCTURES AND APPURTENANCES) OR MODIFICATION IN USE, DESIGN WASTEWATER FLOW, OR WASTEWATER CHARACTERISTICS AS SPECIFIED IN THE ASSOCIATED IMPROVEMENT PERMIT AND APPLICATION, MAY SUBJECT THIS AUTHORIZATION AND ASSOCIATED PERMIT(S) TO REVOCATION.

4. OTHER CONDITIONS: _____

OWNER CERTIFICATION

I CERTIFY THAT THERE HAVE BEEN NO ALTERATIONS IN SITE OR SOIL CONDITIONS OR MODIFICATIONS TO FACILITY, WASTEWATER FLOW, OR WASTEWATER CHARACTERISTICS FROM THOSE SPECIFIED IN THE ORIGINAL APPLICATION OR ASSOCIATED IMPROVEMENT PERMIT UNLESS AUTHORIZED IN WRITING BY THE MECKLENBURG COUNTY HEALTH DEPARTMENT. I ALSO UNDERSTAND THAT ANY SUCH ALTERATIONS, MODIFICATIONS, OR FALSE INFORMATION ARE GROUNDS FOR REVOCATION OF PERMITS AND AUTHORIZATION TO CONSTRUCT.

X _____ 3/28/02
SIGNATURE OF OWNER/OWNER'S REPRESENTATIVE DATE

CONDITIONS OF IMPROVEMENT PERMIT

Permit Number: 2208A

Tax Number: 105-262-05

- The IMPROVEMENT PERMIT is subject to revocation if site plans or the intended use change. There is to be NO grading, filling or disturbance of the soil in the area of the septic tank system or repair area.
- CONSTRUCTION AUTHORIZATION must be obtained prior to receiving a Building Permit. The Construction Authorization is NOT transferable. Do not clear, grade, fill or disturb soil prior to obtaining a Construction Authorization.
- Domestic-type wastewater only. No industrial process wastewater may be discharged into the system.

Basement	___ Yes	X No	___ Partial Basement
Type Primary Wastewater System Type (circle one): I (II) III IV V VI	X Conventional ___ Prefabricated, permeable block panel system ___ Shallow Placed Conventional	___ Low Pressure Pipe ___ Large Diameter Pipe ___ Fill ___ Other	___ Innovative or Experimental: ___ IWWS-93-1 ___ IWWS-93-2 ___ IWWS-94-1

3 Long-term acceptance rate	360 Max gallons/day wastewater flow	1200 Absorption Area (sq ft)	9' Trench spacing (min. on centers)
NO Serviced by private well	1500 Gallon septic tank	400 Total trench length (ft)	30" Maximum trench depth (At least 12" of provisionally suitable soil must remain between trench bottom and unsuitable soil conditions)
3 Bedrooms in residence	___ Gallon pump tank	12" Depth of stone	

Any surface waters present: Type: Minimum separation distance:

Site modifications required:

Additional Conditions: SEE PLOT PLAN

Repair Area System Type Type (circle one): I (II) III IV V VI	X Conventional ___ Prefabricated, permeable block panel system ___ Shallow Placed Conventional	___ Low Pressure Pipe ___ Large Diameter Pipe ___ Fill ___ Other	___ Innovative or Experimental: ___ IWWS-93-1 ___ IWWS-93-2 ___ IWWS-94-1

1200 Absorption Area (Sq ft) 400 Total Trench Length (Ft)	12" Depth of Stone Trench	9' Trench spacing (min. on centers)	30" Maximum Trench Depth

For existing system, enter the year originally installed:

The undersigned, an authorized agent of the MECKLENBURG COUNTY HEALTH DEPARTMENT, certifies that the Department has approved the Request for the Job Location contained in this document. This approval is granted in accordance with the provisions of Laws and Rules For Sewage, Treatment and Disposal in effect at the time of issuance of the permit and is subject to the following provisions:

- No work shall be conducted on the septic tank system until an Installation, Construction, Alteration and/or Repair Approval is granted by this Department.
- This Improvement permit is transferable.

DEHNR Authorized Agent — Date 6-11-99

X Owner/Agent Signature — Date 3/28/07

MECKLENBURG COUNTY
HEALTH DEPARTMENT
ENVIRONMENTAL HEALTH DIVISION
c/o HAL MARSHALL CTR.
SUITE 211
700 N. TRYON ST.
CHARLOTTE, N.C. 28202.
(704) 336-5102

NORTH CAROLINA DEPARTMENT OF
ENVIRONMENTAL, HEALTH,
AND NATURAL RESOURCES
DIVISION OF ENVIRONMENTAL HEALTH
ON-SITE WASTEWATER SECTION

FEE: 100.00 CK # 2725
DATE: 5/18/99 GC

APPLICATION FOR IMPROVEMENT PERMIT FOR RESIDENTIAL SITE INDIVIDUAL WATER AND WASTEWATER SYSTEMS PROGRAM

[ ] CRT

TYPE APPLICATION: [✓] NEW SYSTEM [ ] EXPANSION/ ALTERATION OF EXISTING SYSTEM [ ] REPAIR OF EXISTING SYSTEM

NORTH CAROLINA
DEPARTMENT OF ENVIRONMENT,
HEALTH, AND NATURAL RESOURCES
DIVISION OF ENVIRONMENTAL HEALTH
ON-SITE WASTEWATER SECTION

FILE #: ~~27838~~ 2208A

PROPERTY INFORMATION (FROM ENGINEERING FORM) FOR JOB LOCATION:

TAX/PARCEL NUMBER: 105262 05

STREET ADDRESS: 9120 CROSS TIMBERS

SUBDIVISION OR MOBILE HOME PARK NAME: FARMWOOD NORTH

LOT NUMBER: LOT 25 (on TAX MAP) BLK 3

TYPE OF BUILDING (CHECK ONE):

[ ] SINGLE MOBILE HOME(S)
[ ] DOUBLE WIDE (D)
[ ] HOUSE (H)
[✓] MODULAR HOME (M)
[ ] MULTIPLE FAMILY (U)
[ ] OTHER (O)

TOWNSHIP (CHECK ONE):

[✓] 0 MECKLENBURG
[ ] 1 CHARLOTTE
[ ] 2 DAVIDSON
[ ] 3 CORNELIUS
[ ] 4 PINEVILLE
[ ] 5 MATTHEWS
[ ] 6 HUNTERSVILLE
[ ] 7 MINT HILL

HEATED SQUARE FOOTAGE: 2270

NUMBER OF BEDROOMS: 3 NUMBER OF OCCUPANTS: 2

CLOSING DATE _____

FOUNDATION FOR RESIDENCE:

[ ] WITHOUT BASEMENT ON SLAB
[✓] CRAWL SPACE
[ ] WITH BASEMENT /PLUMBING
[ ] WITH BASEMENT /NO PLUMBING

IF EXPANSION/ALTERATION OF EXISTING SYSTEM, DESCRIBE THE PROPOSED BUILDING ADDITION:

WILL THERE BE A HOME BUSINESS IN THE RESIDENCE: [ ] YES [✓] NO TYPE: _____

WATER SUPPLY (CHECK ONE):

[✓] COMMUNITY (C)
[ ] MUNICIPAL (M)
[ ] PRIVATE WELL (P)
[ ] SHARED WELL (S)
[ ] OTHER 'SPRINGS' (O)

IF ANY OF THE FOLLOWING ARE LOCATED ON THE PROPERTY, PLEASE SHOW LOCATION ON PLAT:

BURIED CABLES, LANDFILLS, STUMPHOLES	[ ] YES [✓] NO	WELL, SPRINGS OR WATERLINES	[ ] YES [✓] NO
EXISTING WASTEWATER SYSTEMS	[ ] YES [✓] NO	DESIGNATED WETLANDS	[ ] YES [✓] NO
EASTMENTS OR RIGHT-OF-WAYS	[ ] YES [✓] NO		

PROPERTY OWNER:

NAME: HOME FEDERAL BANK (LAST) (FIRST) (MI)

ADDRESS: 139 South Tryon ST

CITY: Charlotte STATE: NC ZIP: 28202

DAYTIME PHONE: ( ) –

LEGAL AGENT FOR PROPERTY OWNER, IF APPLICABLE:

NAME: HOME FEDERAL Robin Choate (LAST) (FIRST) (MI)

DAYTIME PHONE: 704/534 – 6300

WHAT DATE WAS THE PROPERTY ORIGINALLY DEEDED AND RECORDED? _____

An Improvement Permit is subject to suspension or revocation if site plans or the intended use change or if information submitted in this application is falsified or changed. The undersigned, owner, or legal agent for the owner, of the property described above as the "Job Location" has read the foregoing application, acknowledges that the contents of same are true, and authorizes agents of the Mecklenburg County Health Department to enter onto the property for the purpose of processing this request.

SIGNED: [signature] DATE: 5/18/99

MECKLENBURG COUNTY HEALTH DEPARTMENT
ENVIRONMENTAL HEALTH DIVISION
c/o HAL MARSHALL CTR., SUITE 211, 700 N. TRYON ST., CHARLOTTE, N.C. 28202., (704) 336-5102


PROPOSED PLOT PLAN

HEALTH DEPARTMENT
ENVIRONMENTAL HEALTH DIVISION
700 NORTH TRYON STREET
CHARLOTTE, NC 28202
PHONE (704) 336-5102

FILE: 2208A ~~2983B~~

TC: 105-262-05

Draw in and name all roads adjoining the property. Draw in and accurately dimension the lot concerned. Accurately indicate property boundaries proposed and/or existing structures and driveways, underground utilities, and wells and springs within 100 feet of the proposed building or drainfield.

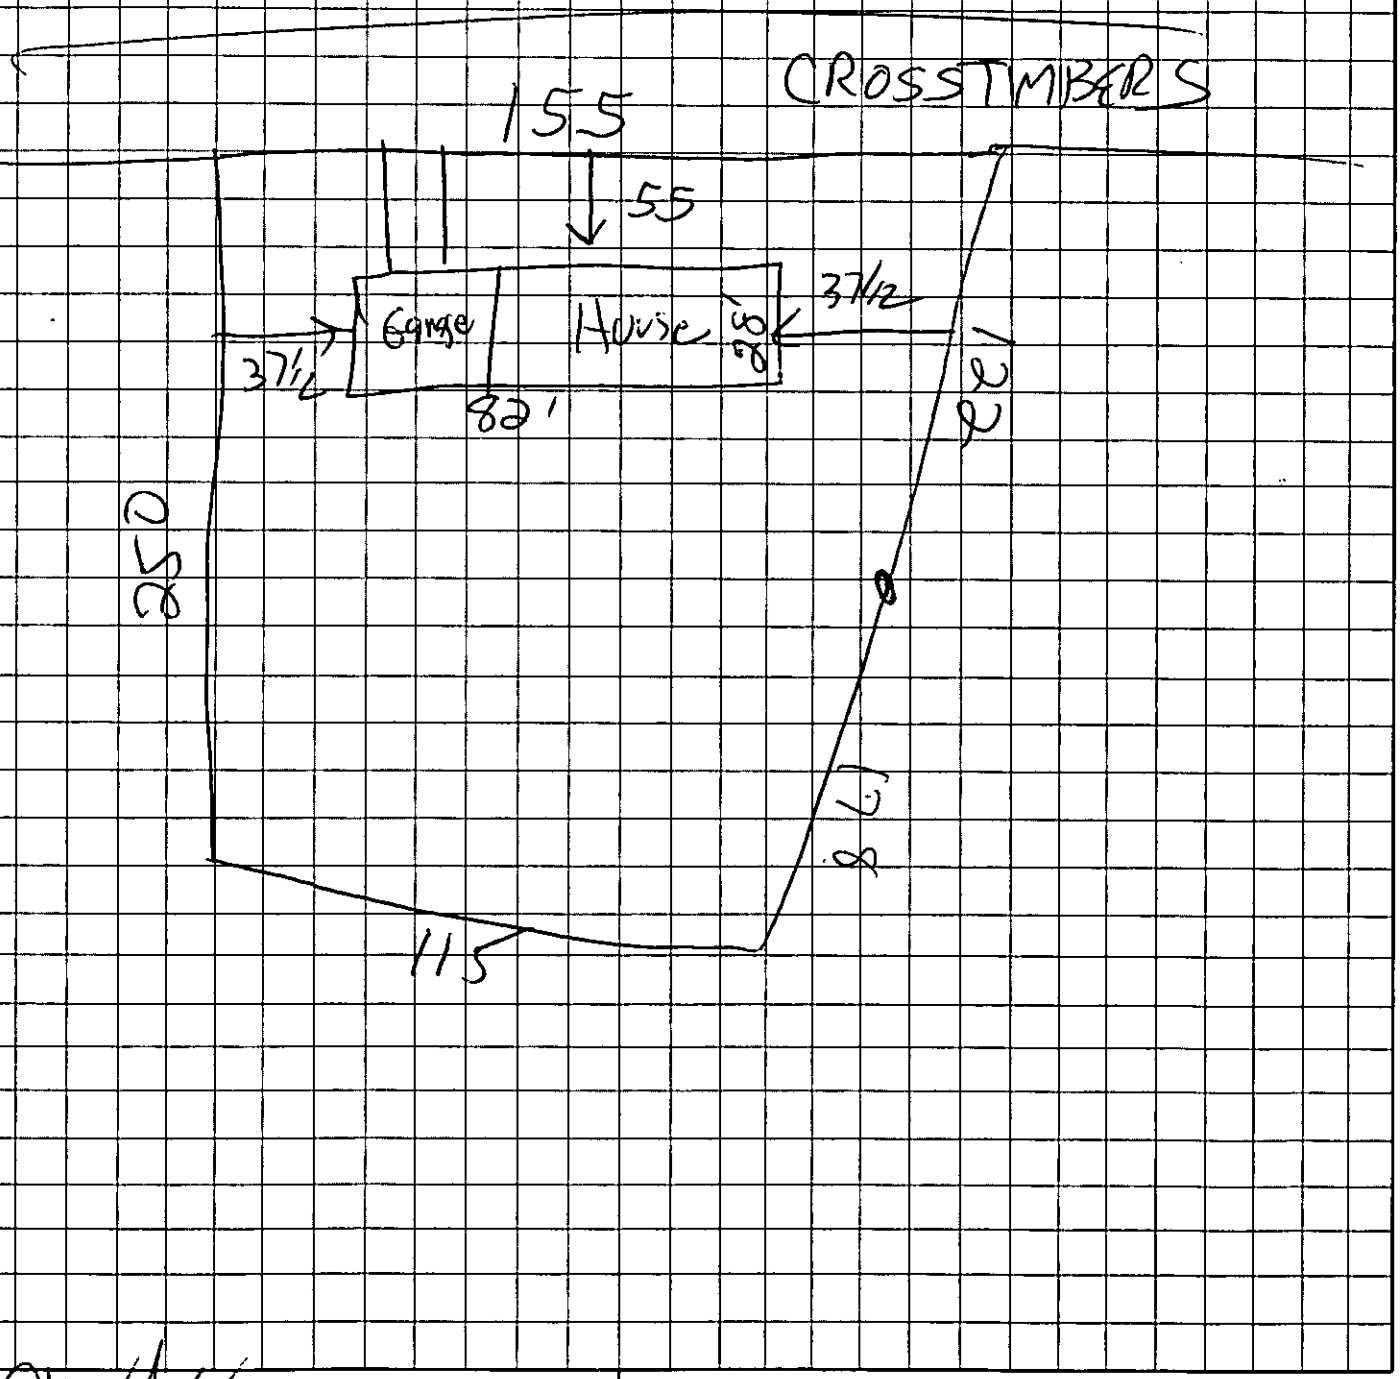

OWNER/AGENT SIGNATURE C W Hw

DATE 5/18/99

APPROVAL DATE _____

White - Health Department's Copy Canary - E.H.S. Copy Pink - Owner's Copy


PROPOSED PLOT PLAN

HEALTH DEPARTMENT
ENVIRONMENTAL HEALTH DIVISION
700 NORTH TRYON STREET
CHARLOTTE, NC 28202
PHONE (704) 336-5102

FILE: 2208A ~~29837~~

TC: 105-262-05

Draw in and name all roads adjoining the property. Draw in and accurately dimension the lot concerned. Accurately indicate property boundaries proposed and/or existing structures and driveways, underground utilities, and wells and springs within 100 feet of the proposed building or drainfield.

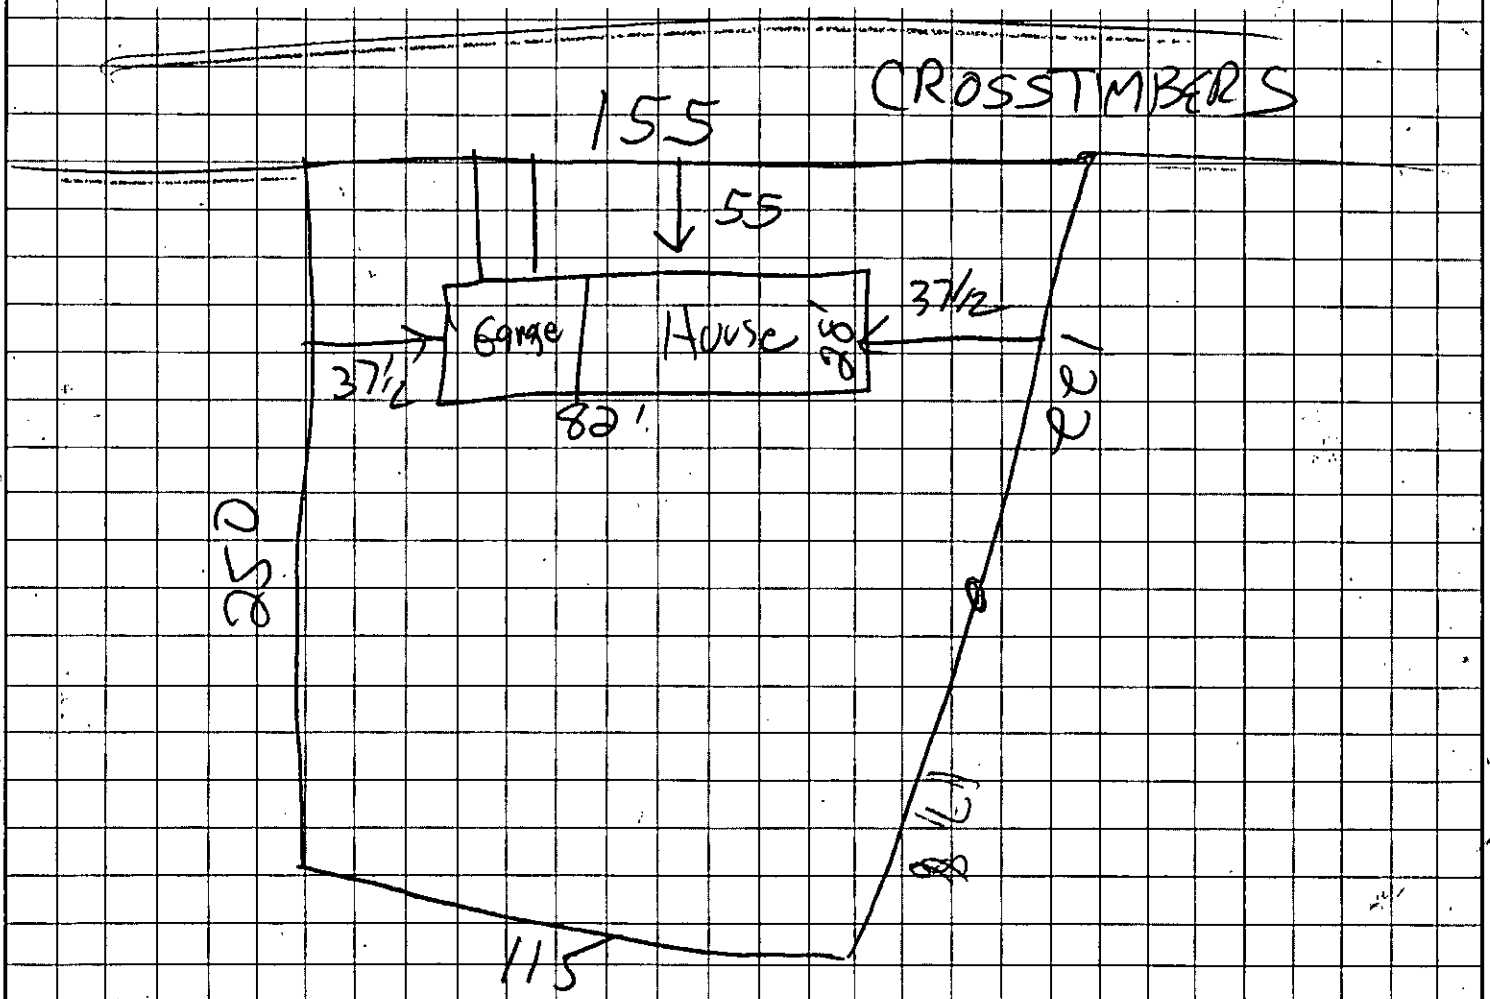

OWNER/AGENT SIGNATURE CWM

DATE 5/18/99

APPROVAL DATE _____

White - Health Department's Copy Canary - E.H.S. Copy Pink - Owner's Copy


PROPOSED PLOT PLAN

HEALTH DEPARTMENT
ENVIRONMENTAL HEALTH DIVISION
700 NORTH TRYON STREET
CHARLOTTE, NC 28202
PHONE (704) 336-5102

FILE: 2208A ~~2183B~~

TC: 105-262-05

Draw in and name all roads adjoining the property. Draw in and accurately dimension the lot concerned. Accurately indicate property boundaries proposed and/or existing structures and driveways, underground utilities, and wells and springs within 100 feet of the proposed building or drainfield.

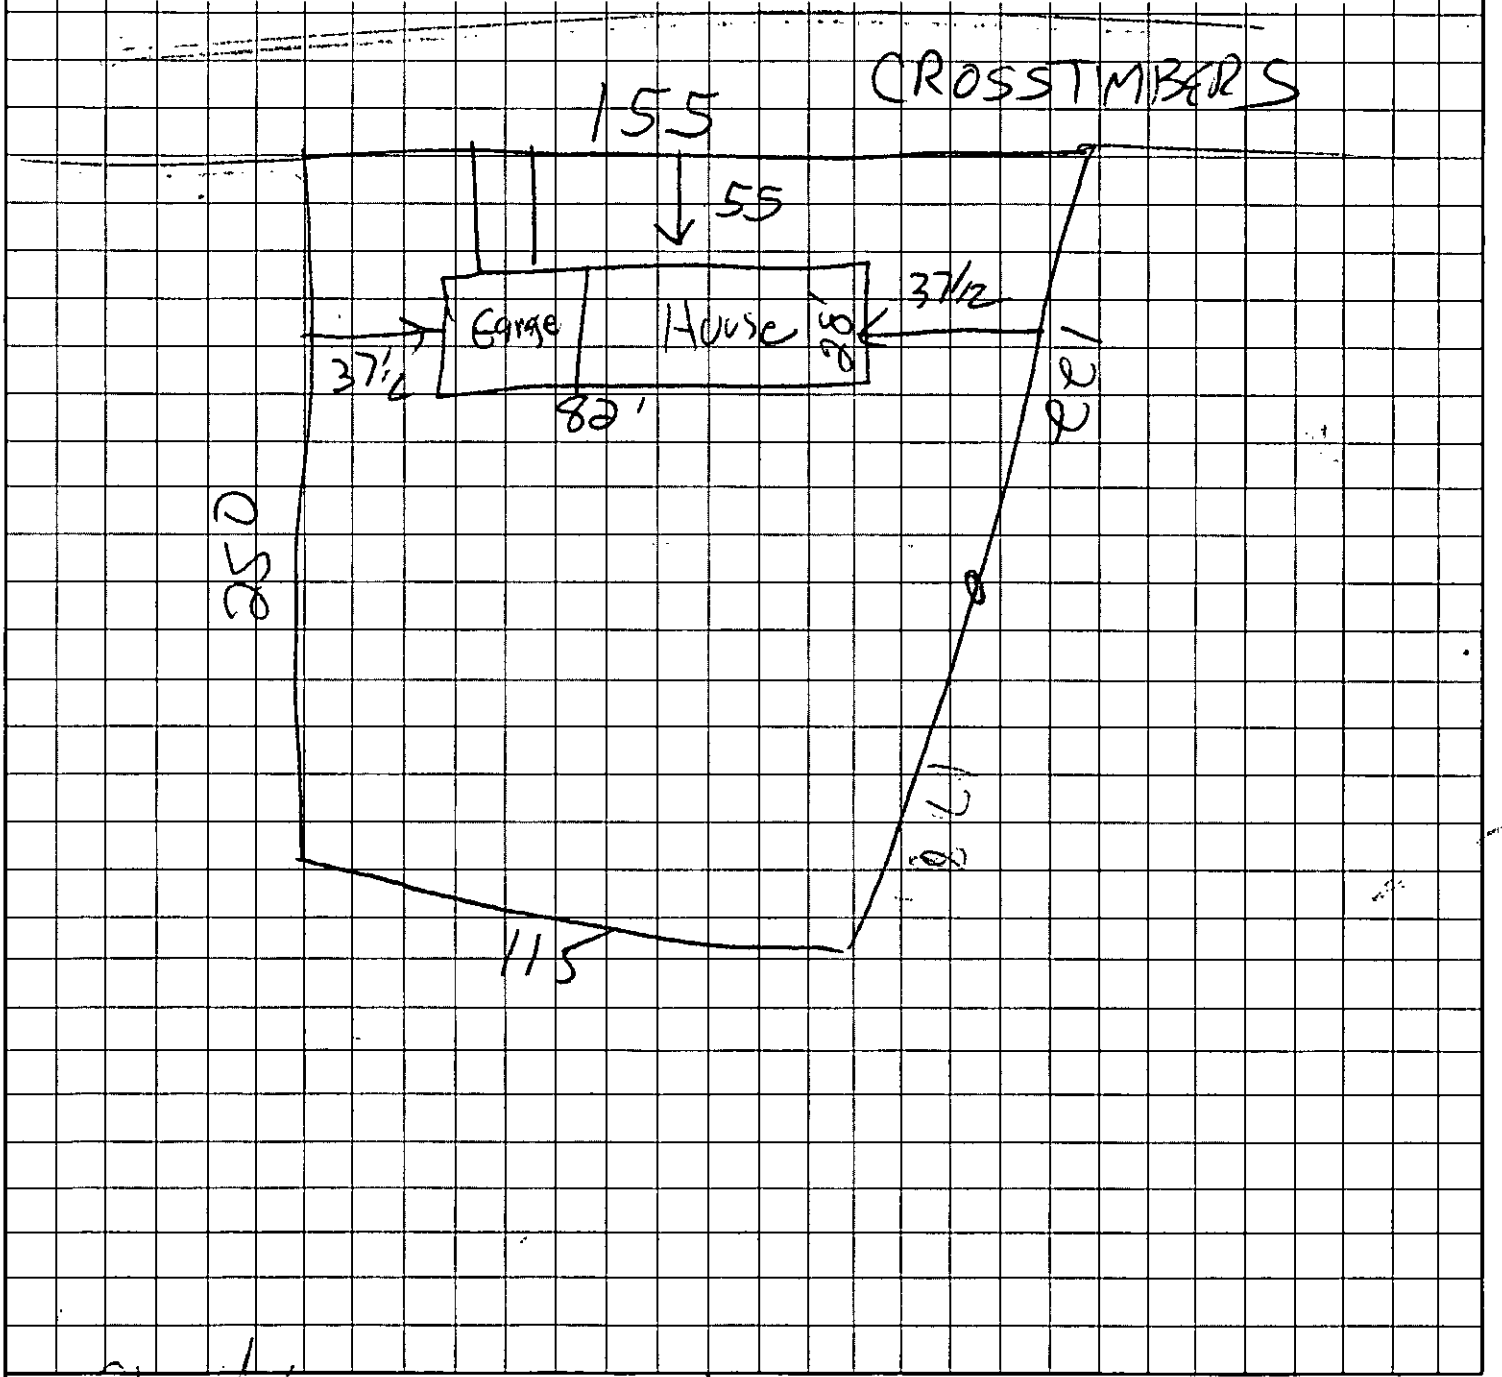

OWNER/AGENT SIGNATURE C W Hill

DATE 5/18/99

APPROVAL DATE _____

White - Health Department's Copy Canary - E.H.S. Copy Pink - Owner's Copy

FEE: [illegible] 275

DATE: 5/18/99 gc

APPLICATION FOR IMPROVEMENT PERMIT FOR RESIDENTIAL SITE INDIVIDUAL WATER AND WASTEWATER SYSTEMS PROGRAM

4W

#1 2208A 1 J.CRT

TYPE APPLICATION: ✓ NEW SYSTEM __ EXPANSION/ ALTERATION OF EXISTING SYSTEM __ REPAIR OF EXISTING SYSTEM

NORTH CAROLINA
DEPARTMENT OF ENVIRONMENT,
HEALTH, AND NATURAL RESOURCES
DIVISION OF ENVIRONMENTAL HEALTH
ON-SITE WASTEWATER SECTION

COPY

FILE #: ~~27850~~

PROPERTY INFORMATION (FROM ENGINEERING FORM) FOR JOB LOCATION:

TAX/PARCEL NUMBER: 105262 05

STREET ADDRESS: 9120 CROSS TIMBERS

SUBDIVISION OR MOBILE HOME PARK NAME: FARMWOOD NORTH

LOT NUMBER: LOT 25 (on TAX MAP) BLK 3

TYPE OF BUILDING (CHECK ONE):

__ SINGLE MOBILE HOME(S)
__ DOUBLE WIDE (D)
__ HOUSE (H)
✓ MODULAR HOME (M)
__ MULTIPLE FAMILY (U)
__ OTHER (O)

TOWNSHIP (CHECK ONE):

✓ 0 MECKLENBURG
__ 1 CHARLOTTE
__ 2 DAVIDSON
__ 3 CORNELIUS
__ 4 PINEVILLE
__ 5 MATTHEWS
__ 6 HUNTERSVILLE
__ 7 MINT HILL

HEATED SQUARE FOOTAGE: 2270

NUMBER OF BEDROOMS: 3 NUMBER OF OCCUPANTS: 2

FOUNDATION FOR RESIDENCE:

__ WITHOUT BASEMENT ON SLAB
✓ CRAWL SPACE
__ WITH BASEMENT /PLUMBING
__ WITH BASEMENT /NO PLUMBING

CLOSING DATE _____

for checker 5-27-99
use initial upon
WAM - 5-28-99

IF EXPANSION/ALTERATION OF EXISTING SYSTEM, DESCRIBE THE PROPOSED BUILDING ADDITION:

WILL THERE BE A HOME BUSINESS IN THE RESIDENCE: __ YES ✓ NO TYPE: _____

WATER SUPPLY (CHECK ONE):

✓ COMMUNITY (C)
__ MUNICIPAL (M)
__ PRIVATE WELL (P)
__ SHARED WELL (S)
__ OTHER 'SPRINGS' (O)

IF ANY OF THE FOLLOWING ARE LOCATED ON THE PROPERTY, PLEASE SHOW LOCATION ON PLAT:

BURIED CABLES, LANDFILLS, STUMPHOLES	__ YES ✓ NO	WELL, SPRINGS OR WATERLINES	__ YES ✓ NO
EXISTING WASTEWATER SYSTEMS	__ YES ✓ NO	DESIGNATED WETLANDS	__ YES ✓ NO
EASTMENTS OR RIGHT-OF-WAYS	__ YES ✓ NO		

PROPERTY OWNER:	LEGAL AGENT FOR PROPERTY OWNER, IF APPLICABLE:
NAME: (LAST) HOME (FIRST) FEDERAL (MI) BANK	NAME: (LAST) HOME (FIRST) FEDERAL (MI) Robin Choate
ADDRESS: 139 South Tryon ST	DAYTIME PHONE: 704 534 - 6300
CITY: Charlotte STATE: NC ZIP: 28202	
DAYTIME PHONE: ( ) -	

WHAT DATE WAS THE PROPERTY ORIGINALLY DEEDED AND RECORDED? _____

An Improvement Permit is subject to suspension or revocation if site plans or the intended use change or if information submitted in this application is falsified or changed. The undersigned, owner, or legal agent for the owner, of the property described above as the "Job Location" has read the foregoing application, acknowledges that the contents of same are true, and authorizes agents of the Mecklenburg County Health Department to enter onto the property for the purpose of processing this request.

SIGNED: [signature] DATE: 5/18/99

MECKLENBURG COUNTY HEALTH DEPARTMENT
ENVIRONMENTAL HEALTH DIVISION
c/o HAL MARSHALL CTR., SUITE 211, 700 N. TRYON ST., CHARLOTTE, N.C. 28202., (704) 336-5102

...ATION REPORT
...MBER 11236

Parcel: 10515201,03 PO

...: 9120 Crosstimbers Drive

...ivision:


...ot: L25 Block: Acres: .85

Owner: Bob McLemore Company, Inc.
Address: PO Box 25746
Charlotte, NC 28212

Comments: _____

Described by: William B. Marlin

Date: 11-19-87

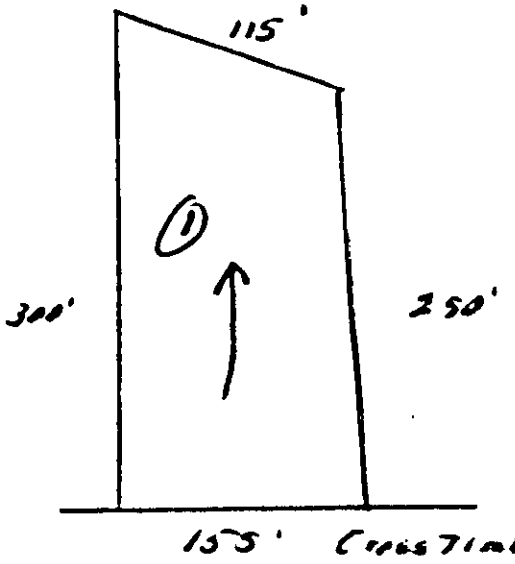

*** EVALUATION KEY ***

S = Suitable U = Unsuitable
PS = Provisionally Suitable

The "Area Classification" below indicates the suitability of areas in the diagram.

FACTORS	AREA 1	AREA 2	AREA 3	AREA 4	AREA 5	AREA 6
Topography	(S) PS U 8-15%	S PS U	S PS U	S PS U	S PS U	S PS U
Texture	S (PS) U Clay	S PS U	S PS U	S PS U	S PS U	S PS U
Structure	S (PS) U Blocky	S PS U	S PS U	S PS U	S PS U	S PS U
Drainage	S (PS) U 736" To water	S PS U	S PS U	S PS U	S PS U	S PS U
Depth	S (PS) U >36"	S PS U	S PS U	S PS U	S PS U	S PS U
Restrictive Horizons	S (PS) U >36"	S PS U	S PS U	S PS U	S PS U	S PS U
Available Space	S (PS) U	S PS U	S PS U	S PS U	S PS U	S PS U
Other (specify)	S PS U	S PS U	S PS U	S PS U	S PS U	S PS U
Soil Group/Series	IVA Enon-Iredell					
Area Classification	S (PS) U	S PS U	S PS U	S PS U	S PS U	S PS U