SEE INSTRUCTIONS ON BACK

Date Received 4-14-83

ICAR(S) Application No. 19561

T. C. No. 031-022-04


Map Date _____

MECKLENBURG COUNTY
DEPARTMENT OF ENVIRONMENTAL HEALTH

Application for an
Installation, Construction, Alteration, and/or Repair Permit
(Individual Septic Tank System with Subsurface, Soil Absorption, Effluent Discharge)

The owner of that property described hereinafter hereby applies to the Mecklenburg County Department of Environmental Health for a permit to:

1) ____ Install or Construct 2) ✓ Alter or Repair an individual septic tank wastewater treatment system with a subsurface, soil absorption, effluent discharge.

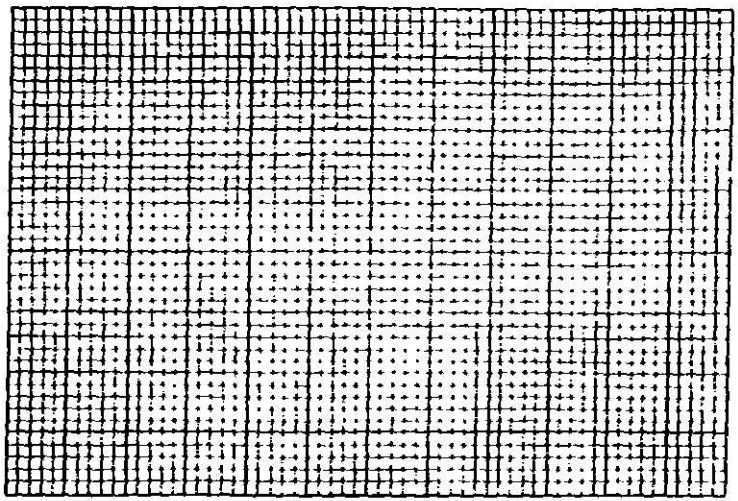

3) PLOT PLAN (ACCURATELY DIMENSIONED)

Mobile Home ____Yes ✓No
Residence ____Yes ____No

4) No of Bedrooms _____

5) Business Use — Max No Employees 2

6) Washing Machine ____Yes ____No

7) Garbage Disposal ____Yes ____No

8) Dishwasher ____Yes ____No

9) Water Supply
- A) Individual Well ✓
- B) Governmental System _____
- C) Community System
  - 1 Well source _____
  - 2 Governmental source _____

10) Sewage System
House located within 200 feet of public sewer ____Yes ✓No
House located within 200 feet of community sewer ____Yes ✓No

11) FHA Case No _____

12) VA Case No _____

13) NAME OF OWNER City Ices Service Company
LAST FIRST MIDDLE

14) ADDRESS OF OWNER 7600 Mt. Holly Rd

15) PHONE NO. Home _____ Office _____

16) LOCATION OF SYSTEM Same
STREET OR COUNTY ROAD

17) SUBDIVISION _____ Lot No. _____ Block No. _____

Map Book No. _____ Page No. _____

18) DEED REFERENCE — DEED BOOK _____ AT PAGE _____

19) HAS A SOIL INVESTIGATION BEEN RUN? _____ YES _____ NO DATE RUN _____

20) PTR NUMBER (See Instructions) _____

The undersigned person hereby agrees that he has read the foregoing application and that the contents of same are true. It is understood that any permit applied for herein shall be void and of no effect if any of the above facts are not true.

4-14-83
DATE OF APPLICATION

OWNER

EHD-5-76

ENVIRONMENTAL HEALTH DEPARTMENT'S COPY


Date Issued 4-14-83

C of A (s) No. 19561

T. C. No. 031-022-04

MECKLENBURG COUNTY
DEPARTMENT OF ENVIRONMENTAL HEALTH

PLOT PLAN SHEET

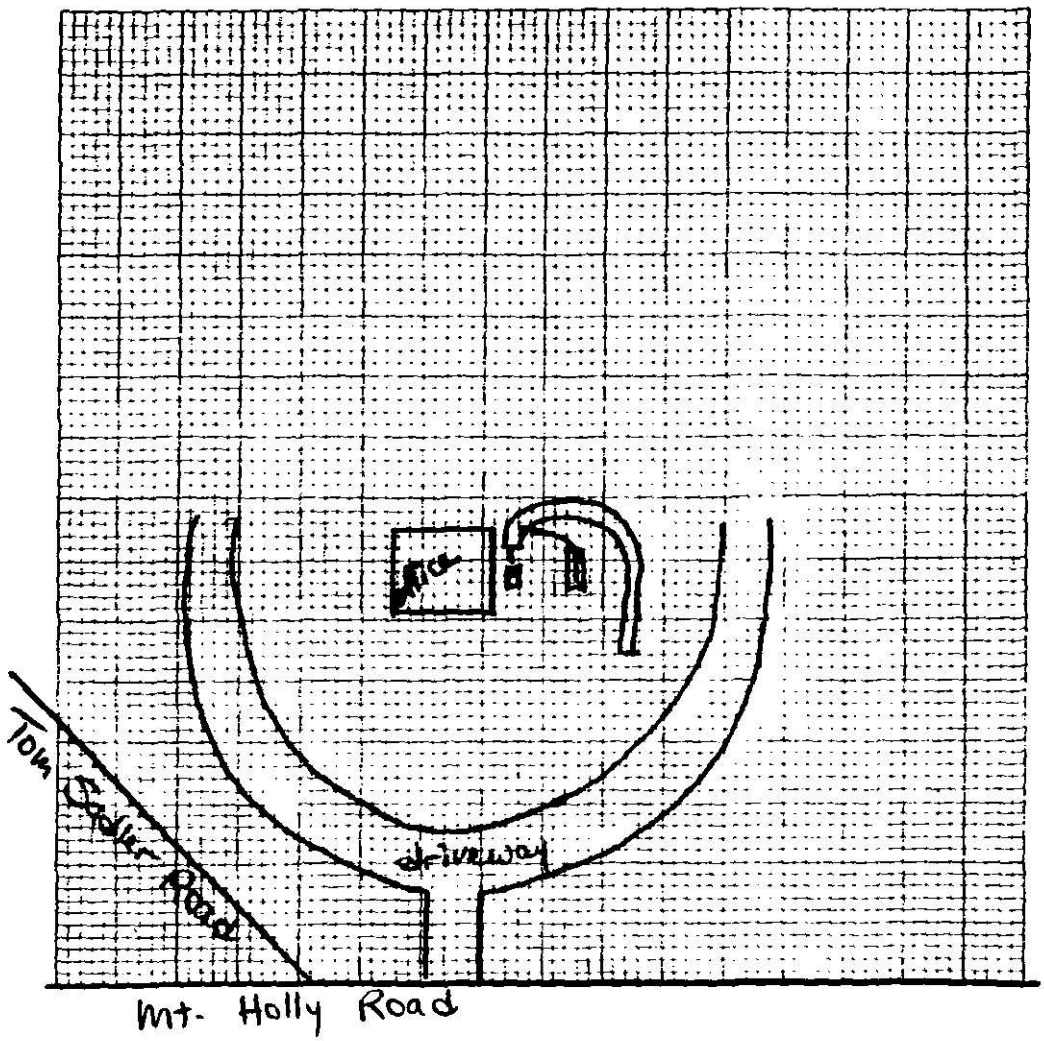

PLOT PLAN

ACCURATE DIAGRAM OF SYSTEM AS INSTALLED

Mike Sexton

Environmentalist

EHD-5-76

Environmental Health Department's Copy

C of A (s) No. 19561 ✓

Date Issued 4-14-83 Serial 5727 T C. No. 031-022-04

MECKLENBURG COUNTY
DEPARTMENT OF ENVIRONMENTAL HEALTH

CERTIFICATE OF APPROVAL

(Individual Septic Tank System with Subsurface, Soil Absorption, Effluent Discharge)

Name of Owner Cities Service Oil Company
(LAST FIRST MIDDLE)

Location of Property 7600 Mt. Holly Road

Application Number 19561 Permit Number ____

Inspection Data:

Liquid Capacity of Tank — Tank Material —

Total Length of Drain Tile 100' Number of Lines one

Depth of Filter Material 53" Cover Depth 3'

Water Supply Source city Distance from Water Source —

Excavation Inspected — (DATE) Tank Inspected — (DATE)

Nitrification Field Inspected 4-14-83 (DATE)

Washing Machine Line Inspected, If Applicable — (DATE)

The undersigned has inspected the Individual Septic Tank System with subsurface, soil absorption, effluent discharge as described above and it has been ✓ installed or constructed, ____ altered or repaired in accordance with the permit issued and the regulations of the Mecklenburg County Health Commission in effect on the date of issuance of the permit. The issuance of this Certificate of Approval does not in any way guarantee that the system will operate properly or relieve any person now or hereafter owning, controlling, or using such system from any liability resulting from the failure of the system to operate properly. This Certificate of Approval is issued subject to those restrictions and conditions shown on the permit(s) in addition to those listed below under comments. This Certificate of Approval shall be null and void if any information contained in the application is untrue or if any additions are made to the property which would increase the requirements for said system.

Comments Be careful of water + power lines on future repairs.

Mike Sexton
Environmentalist

EHD-5-76

ENVIRONMENTAL HEALTH DEPARTMENT'S COPY