SUPERVISOR/ADMINISTRATIVE PROFESSIONAL CHECKLIST

☐ NEW SEPTIC ☑ REPAIR ☐ USE EXISTING ☐ MODIFIED PLOT PLAN ☐ ALTERATION

File Number: 6400A

Assigned Inspector: Troy

☐ IP $250.00: _____ Initial/Date

☐ IP Commercial $450.00: _____ Initial/Date

☐ CA & OP $400.00: _____ Initial/Date

☐ Alteration Fees $300: _____ Initial/Date

☐ Modified Plot Plan Fees $100.00: _____ Initial/Date

☐ Use Existing Fees $100.00: _____ Initial/Date

☐ Use Existing Approved ☐ Use Existing Denied

☐ Send IP permit for signature: _____ ☐ Signature received: _____

☐ Floor plans reviewed

☐ Generate CA ☐ Approve as Noted in Winchester

☐ This site is served by septic and well. Verify each is complete before final hold is released

☐ This septic system requires a certified operation contract before final hold is released

☐ Certified operator contract is on file: _____

☒ Septic file complete: 2/5/25

☐ Release final hold in Winchester: _____

Comments:

Tank Replacement Only

6400A

MECKLENBURG COUNTY
HEALTH DEPARTMENT

#15187

APPLICATION FOR A RESIDENTIAL SITE IMPROVEMENT PERMIT/ CONSTRUCTION AUTHORIZATION FOR AN ON-SITE WASTEWATER SYSTEM, NEW WELL INSTALLATION, OR REPAIR OF EXISTING WELL

1. SEPTIC / TYPE APPLICATION: ☐ N/A ☐ NEW SYSTEM ☐ ALTERATION ☑ REPAIR ☐ MODIFIED PLOT PLAN

2. WELL / TYPE APPLICATION: ☑ N/A ☐ NEW WELL ☐ MAJOR REPAIR ☐ ABANDONMENT

3. JOB LOCATION INFORMATION:

TAX PARCEL NUMBER: 137-092-05
STREET ADDRESS: 11203 Pine Grove Ave
CITY: Mint Hill
STATE: NC **ZIP:** 28227
SUBDIVISION NAME: None
LOT #: 24 **LOT SIZE (acres):** t Sq Ft27,4

TOWNSHIP:

☐ MECKLENBURG ☐ CORNELIUS ☐ HUNTERSVILLE
☐ DAVIDSON ☐ CHARLOTTE ☐ PINEVILLE
☐ MATTHEWS ☑ MINT HILL

4. BUILDING INFORMATION:

BUILDING TYPE:

☐ SINGLE MOBILE HOME ☐ MODULAR HOME
☐ DOUBLE WIDE ☐ MULTIPLE FAMILY
☑ HOUSE ☐ OTHER _____

HEATED SQUARE FOOTAGE: 1,053
NUMBER OF BEDROOMS: 3
NUMBER OF OCCUPANTS: 7

FOUNDATION TYPE:

☐ CONCRETE SLAB ☐ BASEMENT WITH PLUMBING
☑ CRAWL SPACE ☐ BASEMENT WITH NO PLUMBING

5. IF PLANNING TO EXPAND OR ALTER THE EXISTING SEPTIC SYSTEM PLEASE COMPLETE THE FOLLOWING SECTION: ☑ N/A

NUMBER OF BEDROOMS TO BE ADDED: _____ NUMBER OF ADDITIONAL OCCUPANTS IN THE RESIDENCE: _____

6. WATER SUPPLY: ☑ MUNICIPAL ☐ PRIVATE WELL ☐ PUBLIC WELL ☐ SHARED WELL ☐ OTHER _____

7. PROPOSED USE OF WELL: ☑ N/A ☐ IRRIGATION ☐ POTABLE (DRINKING WATER) ☐ OTHER _____

8. PLEASE INDICATE AND RANK DESIRED SEPTIC SYSTEM TYPE(S) IN ORDER OF PREFERENCE *(1-MOST DESIRED 5-LEAST DESIRED):*

☐ N/A ☐ ANY TYPE ☑ CONVENTIONAL ☐ ACCEPTED ☐ INNOVATIVE ☐ ALTERNATIVE ☐ OTHER _____

8A. RANK: ____ ____ ____ ____ ____

9. DO ANY OF THE FOLLOWING APPLY TO THE PROPERTY IN QUESTION? IF "YES" PLEASE ATTACH SUPPORTING DOCUMENTATION.

BURIED CABLES, LANDFILLS, STUMPHOLES	☐ YES ☑ NO	GRADING/SOIL REMOVAL PERFORMED	☐ YES ☑ NO
EXISTING WASTEWATER (SEPTIC) SYSTEMS	☐ YES ☑ NO	JURISDICTIONAL WETLANDS	☐ YES ☑ NO
WELLS, SPRINGS, OR WATER LINES	☐ YES ☑ NO	APPROVAL REQUIRED BY ANY OTHER PUBLIC AGENCY	☐ YES ☑ NO
EASEMENTS OR RIGHT-OF-WAYS	☐ YES ☑ NO	WASTEWATER OTHER THAN DOMESTIC SEWAGE	☐ YES ☑ NO
CHEMICAL/PETROLEUM STORAGE TANKS	☐ YES ☐ NO	KNOWN UNDERGROUND CONTAMINATION	☐ YES ☑ NO
WASTE STORAGE	☐ YES ☑ NO	GROUNDWATER USE RESTRICTIONS/VARIANCES	☐ YES ☑ NO

10. WHAT DATE WAS THE PROPERTY ORIGINALLY DEEDED AND RECORDED? 04/17/2020 ☐ UNKNOWN

11. WHAT IS THE ANTICIPATED CLOSING DATE FOR THIS PROPERTY? 01/27/2025 ☐ N/A

12. PROPERTY OWNER:

NAME: Joseph Thawn Khai
ADDRESS: 11203 Pine Grove Ave
CITY: Mint Hill
STATE: NC ZIP: 28227
WORK PHONE: 9803462881
MOBILE PHONE: 9803462881
FAX: _____
E-MAIL: jkhai0649@gmail.com

13. OWNER'S LEGAL REPRESENTATIVE, IF APPLICABLE:

NAME: _____
ADDRESS: _____
CITY: _____
STATE: _____ ZIP: _____
WORK PHONE: _____
MOBILE PHONE: _____
FAX: _____
E-MAIL: _____

MECKLENBURG COUNTY – GROUNDWATER & WASTEWATER SERVICES
700 N. TRYON ST. SUITE 211 CHARLOTTE, NC 28202, OFFICE: 980-314-1680, FAX: 704-336-6894
Email: Wellreg@MecklenburgCountyNC.gov

Revised on: 4/20/17

14. SEPTIC SYSTEM PERMIT APPLICATION:

If the information in this application is falsified, changed, or the site is altered, then the Improvement Permit and Authorization to Construct shall become invalid. I have read this application and certify that the information provided herein is true, complete and correct. Authorized county and state officials are granted right of entry to conduct necessary inspections to determine compliance with applicable laws and rules. I understand that I am solely responsible for the proper identification and labeling of all property lines and corners and making the site accessible so that a complete site evaluation can be performed. The permit is valid for either sixty (60) months or is non-expiring depending upon the documentation submitted: complete site plan = 60 months, complete plat = non-expiring.

JK (Initial here for septic system applications)

15. WELL PERMIT APPLICATION:

If the information in this application is falsified, changed, or the site is altered, then the Well Permit shall become invalid. I have read this application and certify that the information provided herein is true, complete and correct. Authorized county and state officials are granted right of entry to conduct necessary inspections to determine compliance with applicable laws and rules. I understand that I am solely responsible for the proper identification and labeling of all property lines and corners and making the site accessible so that a complete site evaluation can be performed. The permit is valid for a period of twelve (12) months from the date of issuance.

_____ (Initial here for well applications)

16. APPLICATION SIGNATURE SECTION:

ONLY COMPLETE APPLICATIONS WILL BE PROCESSED. A proper signature is required in order to process your application. Please review the application carefully and sign in the space provided below. A PROPOSED PLOT PLAN is required to be submitted with each application.

Joseph Thawn Khai
Property Owner's or Owner's Legal Representative Signature

01/06/2025
Date

OFFICE USE ONLY

☐ SURVEY PLAT TO SCALE SUBMITTED ☐ SCALED SITE PLAN SUBMITTED ☐ UN-SCALED SITE PLAN SUBMITTED

SEPTIC APPLICATION FEE RECEIVED: $ _____ DATE FEE RECEIVED: _____

WELL APPLICATION FEE RECEIVED: $ _____ DATE FEE RECEIVED: _____

APPLICATION PROCESSED BY: _____

GWS FILE NUMBER ASSIGNED: _____

APPLICATION ID NUMBER ASSIGNED: _____

COMMENTS:

MECKLENBURG COUNTY – GROUNDWATER & WASTEWATER SERVICES
700 N. TRYON ST. SUITE 211 CHARLOTTE, NC 28202, OFFICE: 980-314-1680, FAX: 704-336-6894
Email: Wellreg@MecklenburgCountyNC.gov

Revised on: 4/20/17

File #: _____

PROPOSED PLOT PLAN


A drawing showing the locations of the following items is required: existing and proposed property lines with dimensions, easements or right-of-ways, proposed building pad(s) or existing building footprint(s), all appurtenances (garage, driveway, deck, pool, etc.), location of existing or proposed well(s), location of existing or proposed sewer lines and sewage disposal systems, surface water bodies, and any aboveground or underground storage tanks. Provide names for all roads that adjoin the property.

Street Address: 11203 Pine Grove Ave, Mint Hill NC 28227

Tax Parcel #: 137-092-05

Subdivision Name: None

Lot #: 24

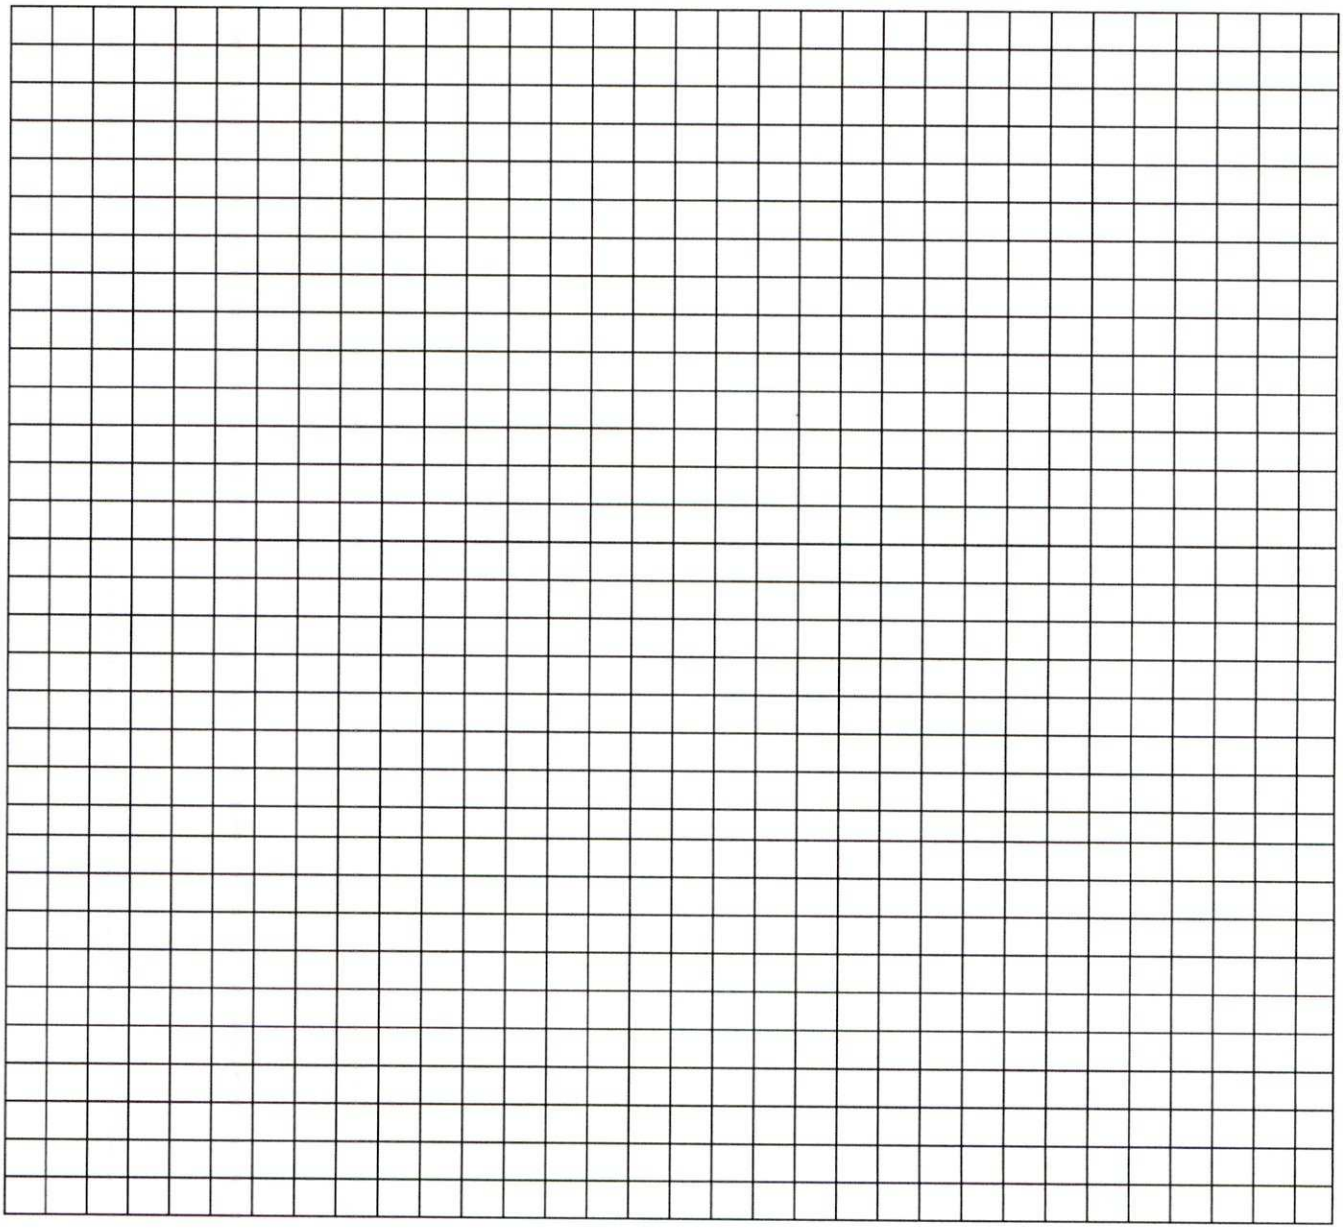

Joseph Thawn Khai

Property Owner's or Owner's Legal Representative Signature

01/06/2025

Date

MECKLENBURG COUNTY – GROUNDWATER & WASTEWATER SERVICES
700 N. TRYON ST. SUITE 211 CHARLOTTE, NC 28202, OFFICE: 980-314-1680, FAX: 704-336-6894
Email: Wellreg@MecklenburgCountyNC.gov

Revised on: 4/20/17

INSTALLATION, CONSTRUCTION, ALTERATION, AND/OR REPAIR PERMIT


HEALTH DEPARTMENT
ENVIRONMENTAL HEALTH DIVISION
1200 BLYTHE BOULEVARD
CHARLOTTE, NC 28203
PHONE (704) 376-4603

FILE: 6400-A DATE: 3-22-90

TC: 137-092-05 ☐ L

SERIAL Nº 14634

Permission is hereby given to _____ Install or Construct, ✓ Alter or Repair the individual septic tank wastewater treatment system with subsurface, soil absorption, effluent discharge as specified herein at the described location. This permit is granted based upon the information supplied in the application dated 3-16-90. All work shall be completed on or before 4-22-90, after which date this permit shall be null and void. The system shall meet all of the construction requirements of 10 NCAC 10A .1900 which are in effect on the date of the granting of this permit. A Certificate of Completion or an Operation Permit must be obtained from the Mecklenburg County Health Department before any system can be covered up or placed into service. The issuance of this permit does not in any way guarantee that the system anticipated to be constructed will operate properly, or relieve any person now or hereafter owning, controlling or using such system from any liability resulting from the failure of the system to operate properly.

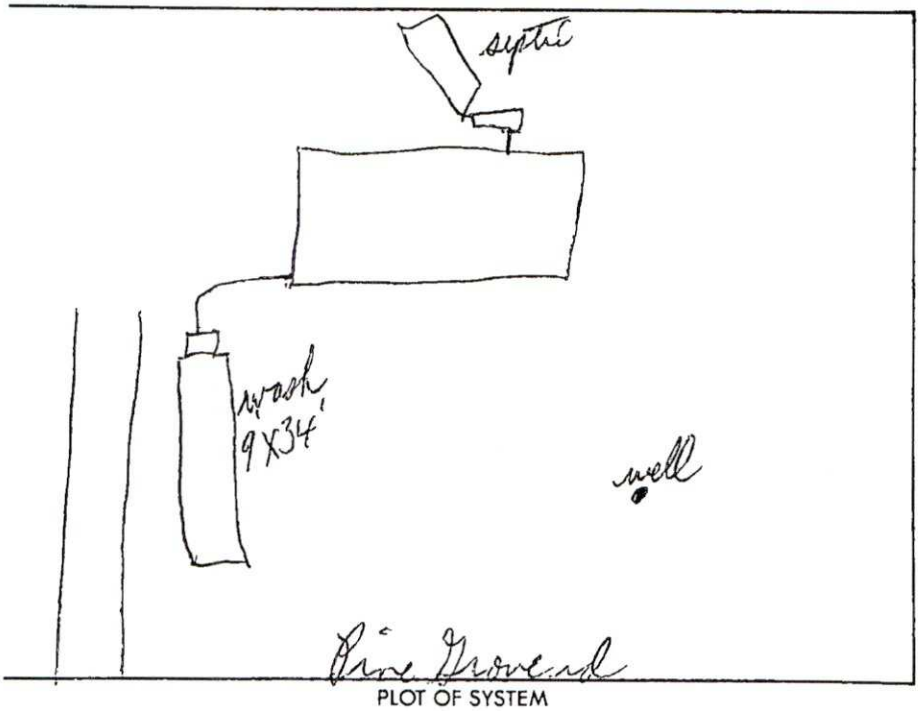

PLOT OF SYSTEM

Liquid Capacity of Septic Tank repair gallons

Liquid Capacity of Dosing Tank _____ gallons

Tank Construction _____

Absorption and/or Nitrification Lines:

Trench Width 9 feet

Total Line Length 100 feet

Number of Lines 3

Depth of Stone 18 inches

Distance from House 5 feet

Distance from Property Line 10 feet

Distance from Well >50 feet

NAME OF OWNER Mrs. Henry McCall

LOCATION OF PROPERTY 11201 Pine Grove Rd

Comments: 1 bed 9'X34'X18" stone - wash repair

Division or Section Head

B. R. Ferguson
Environmentalist

* If this permit is for the installation or construction of a new system, it must be signed by the division or a section head of the Mecklenburg County Health Department in order to be valid. Only the signature of the Environmentalist is required where an existing system is being altered or repaired.

WHITE - HEALTH DEPARTMENT'S COPY • CANARY - ENVIRONMENTALIST'S COPY • PINK - OWNER OR AGENT'S COPY

Mecklenburg County Groundwater & Wastewater Services
3205 Freedom Dr. Suite 8000 Charlotte, NC 28208
Phone: (980) 314-1680 Fax: (704) 336-6894

NC DHHS
Division of Environmental Health
On-Site Wastewater Section

IMPROVEMENT PERMIT/CONSTRUCTION AUTHORIZATION for REPAIRING an ON-SITE WASTEWATER TREATMENT & DISPOSAL SYSTEM

File #: 6400A Permit #: 15187 Tax Parcel #: 137-092-05

Property Owner: Joseph Thawn Khai

Job Location Address: 11203 Pine Grove Ave

City: Mint Hill State: NC Zip Code: 28227

Improvement Permit Issuance Date: NA **Construction Authorization Issuance Date:** 1/9/2025

Permission is hereby given to **repair** an on-site wastewater treatment & and disposal system, with subsurface soil absorption and effluent discharge, as specified herein at the described location. This approval is granted based upon the application information submitted to our office. All work shall be completed on or before 1/9/2026. The system shall meet all of the construction requirements of 15A NCAC 18A. 1900 which are in effect on the date of granting this approval. An **Operation Permit** must be obtained from the Mecklenburg County Health Department before any system can be covered up or placed into service. The issuance of this permit does not in any way guarantee that the system anticipated to be constructed will operate properly, or relieve any person now of hereafter owning, controlling or using such system from any liability resulting from the failure of the system to operate properly.

Permitted Design Flow: 360 GPD Site LTAR: NA GPD/ft²

Liquid Capacity of Septic Tank: 1000 gallons Liquid Capacity of Dosing Tank: NA gallons

Drainfield Design ☑ N/A

Trench Depth: _____ inches

Trench Width: _____ feet

Line Spacing: _____ feet (O.C.)

Total line length: _____ feet

# of Lines: _____ @ _____ feet

Depth of Media: _____ inches (Type) _____

Distribution Device: _____

Bed Design *(For Repair Installations ONLY.)* ☑ N/A

Bed Depth: _____ inches

Bed Width: _____ feet

Total line length: _____ feet

# of Lines: _____ @ _____ feet

Depth of Media: _____ inches (Type) _____

Distribution Device: _____

Water Supply Source

☑ Municipal ☐ Private Well ☐ Community Well

☐ Other _____

Minimum System Setbacks

Distance from Building Foundation: 5 feet

Distance from Property Line: 10 feet

Distance from Water Supply Source: 10 feet

SKETCH OF SYSTEM LAYOUT
(Proposed Layout)

*See attached drawing.


- Septic Tank replacement only.
- Pump, crush, fill exst. ST.
- Uncover and check condition of D-box.
- Reconnect ST to exst. system.
- Call for pre-construction meeting prior to installation.

Comments: System Classification & Type: Septic Tank replacement only

Authorized Agent: Troy Kling Signature: Ty

Owner Signature: _____ Date: _____

On-site Wastewater Improvement Permit Diagram

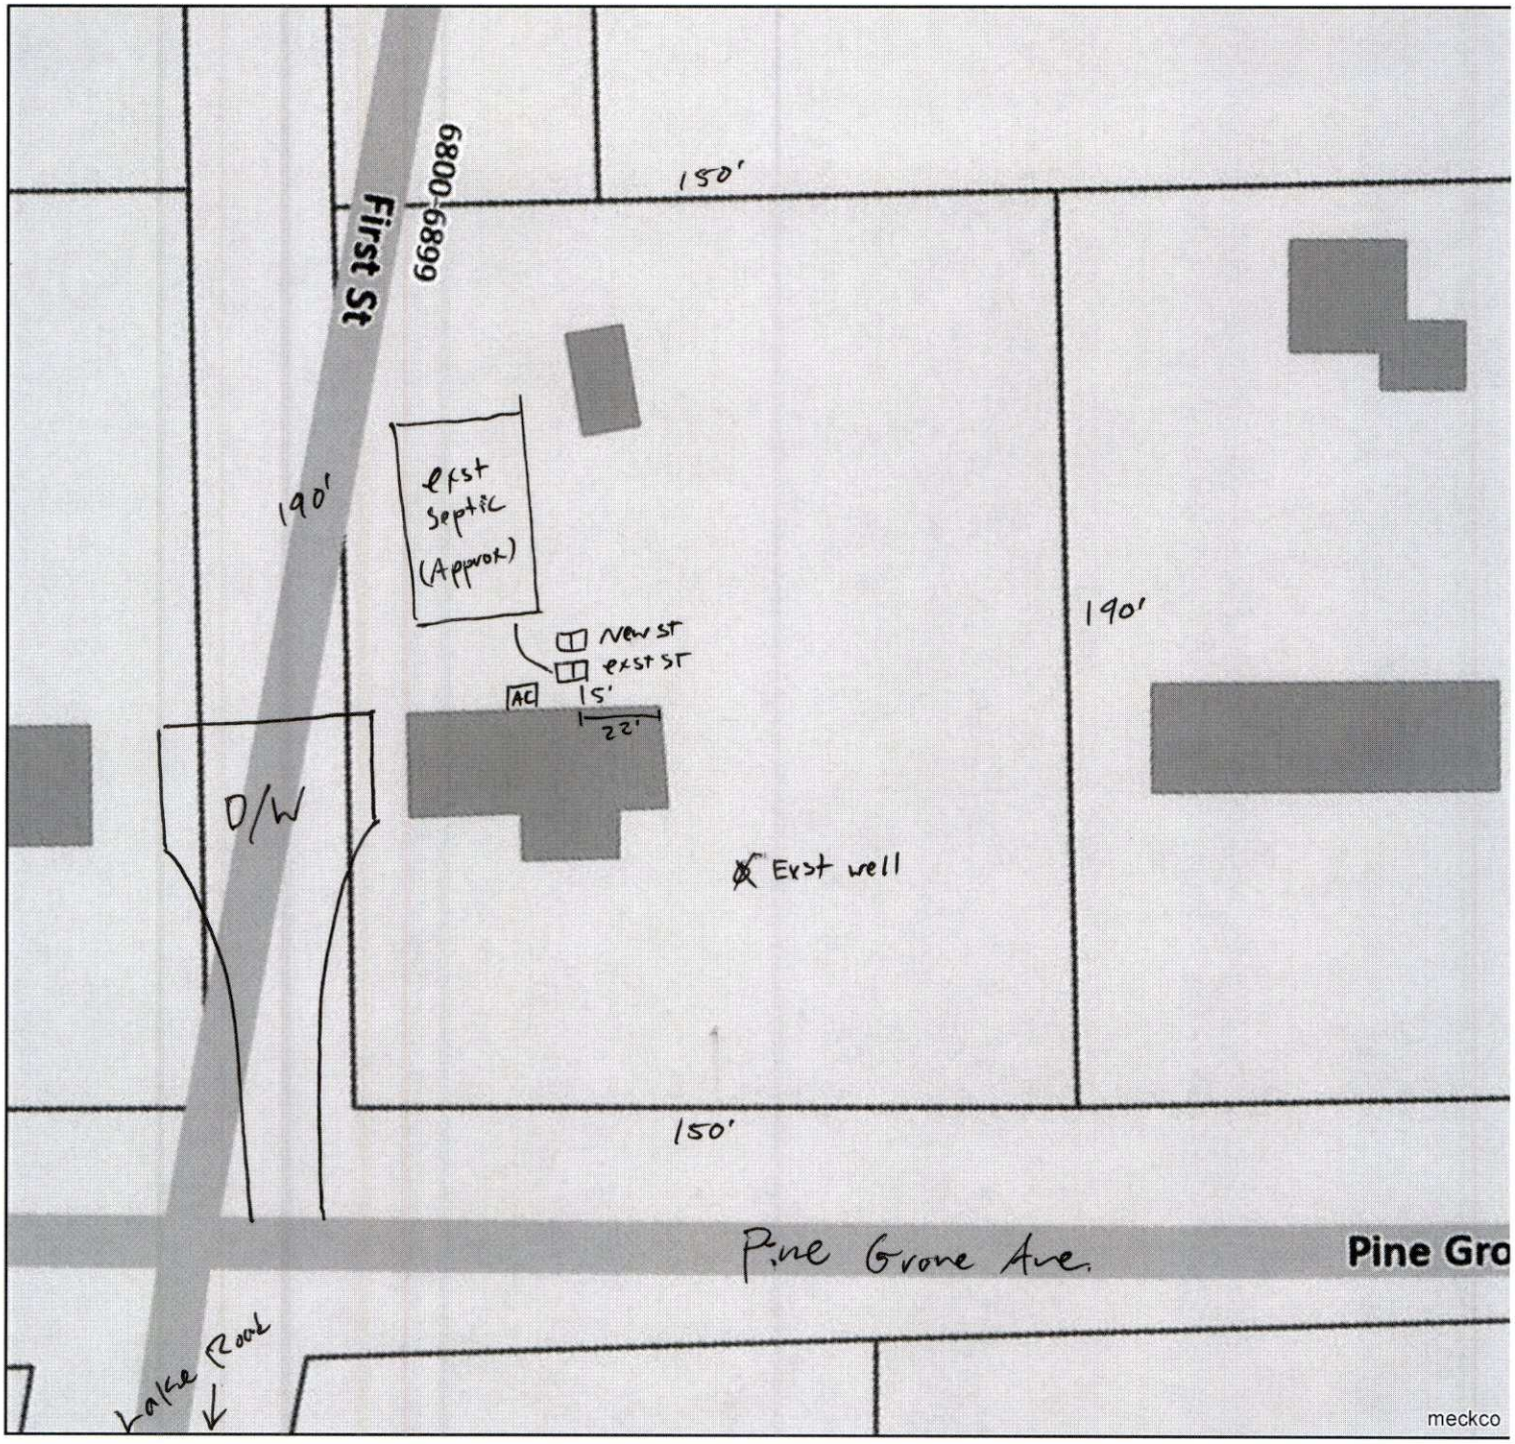

Mecklenburg County Health Department
Environmental Health - Groundwater and Wastewater Services

Permit #: 15187
PID #: 137-092-05
File #: 6400A

Authorized Agent: Troy Kling Date: 1/9/2025

Owner/ Legal Agent: _____ Date: _____

1 inch = 40 fee

Mecklenburg County Groundwater & Wastewater Services
3205 Freedom Dr. Suite 8000, Charlotte, NC 28208
Phone: (980) 314-1680 Fax: (704) 336-6894

NC DHHS
Division of Environmental Health
On-Site Wastewater Section

OPERATION PERMIT for an ON-SITE WASTEWATER TREATMENT & DISPOSAL SYSTEM

File #: 6400A Permit #: 15187 Tax Parcel #: 137-092-05

Property Owner: Joseph Thavn Khai

Job Location Address: 11203 Pine Grove Ave

City: Mint Hill State: NC Zip Code: 28227

Operation Permit Issuance Date: 2/5/25 Contractor Name: Stevens Septic

Permitted Design Flow: 360 GPD Liquid Capacity of Dosing Tank: / gallons

Liquid Capacity of Septic Tank: 1000 gallons Tank Manufacture Xtraf STB-760 Effluent Pump Model: /

Drainfield Installation ☑ N/A

Trench Depth: _____ inches

Trench Width: _____ feet

Line Spacing: _____ feet (O.C.)

Total line length: _____ feet

# of Lines: _____ @ _____ feet

Depth of Media: _____ inches (Type) _____

Depth of Cover: _____ inches

Distribution Device: _____

Bed Installation *(For Repair Installations ONLY.)* ☑ N/A

Bed Depth: _____ inches

Bed Width: _____ feet

Total line length: _____ feet

# of Lines: _____ @ _____ feet

Depth of Media: _____ inches (Type) _____

Depth of Cover: _____ inches

Distribution Device: _____

Water Supply Source

☑ Municipal ☐ Private Well ☐ Community Well

☐ Other _____

System Installation Setbacks

Distance from Building Foundation: 75 feet

Distance from Property Line: >10 feet

Distance from Water Supply Source: >10 feet


Inspection Dates

Tank(s) Inspected: 2/4/25

Excavation Inspected: /

Pump & Controls Inspected: /

SKETCH OF SYSTEM INSTALLATION
(As-Built Drawing)

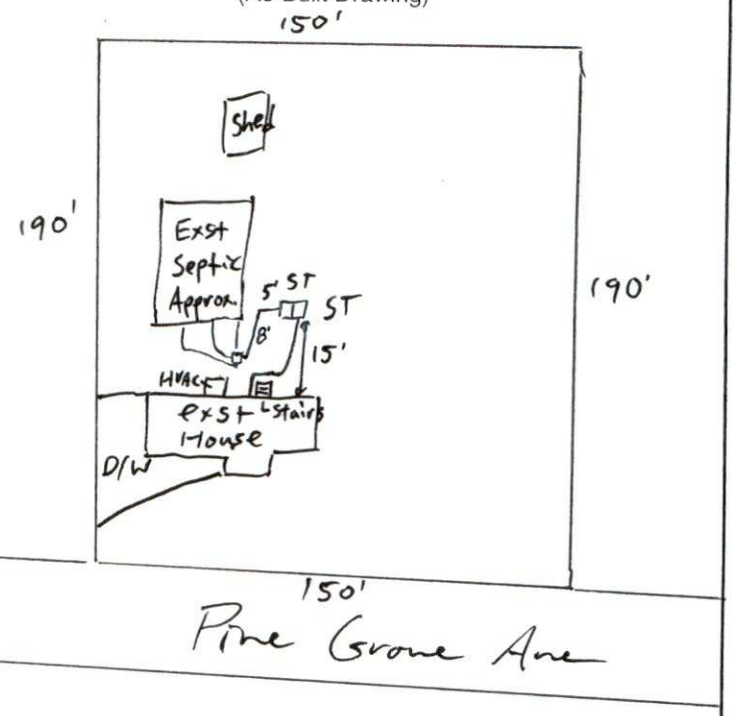

The undersigned has inspected the Septic Tank System described above, and certifies it has been ☑ installed ☐ altered ☑ repaired ☑ as detailed in the plot above ☑ in accordance with the permit issued and meets the provisions of 15A NCAC 18A. 1900, "Laws and Rules for Sewage Treatment and Disposal Systems" in effect on the date of issuance of the permit. The issuance of this Operation Permit does not in any way guarantee that the system will operate properly or relieve any person now or hereafter owning, controlling, or using such system from any liability resulting from the failure of the system to operate properly. This document is issued subject to those restrictions and conditions shown on the permit(s) and the provisions of 15A NCAC 18A. 1900 in addition to those listed below under "Comments." This document shall be null and void if any information contained in the application is untrue or if any additions are made to the property which would increase the requirements for said system.

Notice: Disturbance of the designated repair area may result in the Suspension or Revocation of this permit.

Comments: System Classification & Type: ST only

DENR Authorized Agent: Troy Kling Signature: T