P# 285837

11272

MECKLENBURG COUNTY
GROUNDWATER & WASTEWATER SERVICES

3766

APPLICATION FOR A RESIDENTIAL SITE IMPROVEMENT PERMIT/ CONSTRUCTION AUTHORIZATION FOR AN ON-SITE WASTEWATER SYSTEM, NEW WELL INSTALLATION, OR REPAIR OF EXISTING WELL

1. **SEPTIC / TYPE APPLICATION:** ☐ N/A ☑ NEW SYSTEM ☐ ALTERATION ☐ REPAIR ☐ MODIFIED PLOT PLAN

2. **WELL / TYPE APPLICATION:** ☑ N/A ☐ NEW WELL ☐ MAJOR REPAIR ☐ ABANDONMENT

3. **JOB LOCATION INFORMATION:**

TAX PARCEL NUMBER: 13930229
STREET ADDRESS: 8326 Arlington Church Rd
CITY: Charlotte
STATE: NC ZIP: 28227
SUBDIVISION NAME:
LOT #: LOT SIZE (acres): 9 1976
TOWNSHIP:
☐ 0-MECKLENBURG ☐ 3-CORNELIUS ☐ 6-HUNTERSVILLE
☐ 1-CHARLOTTE ☐ 4-PINEVILLE ☑ 7-MINT HILL
☐ 2-DAVIDSON ☐ 5-MATTHEWS

4. **BUILDING INFORMATION:**

BUILDING TYPE:
☐ SINGLE MOBILE HOME ☐ MODULAR HOME
☐ DOUBLE WIDE ☐ MULTIPLE FAMILY
☐ HOUSE ☑ OTHER Pool house
HEATED SQUARE FOOTAGE: 800
NUMBER OF BEDROOMS: 1
NUMBER OF OCCUPANTS:
FOUNDATION TYPE:
☐ CONCRETE SLAB ☐ BASEMENT WITH PLUMBING
☑ CRAWL SPACE ☐ BASMENT WITH NO PLUMBING

5. **IF PLANNING TO EXPAND OR ALTER THE EXISTING SEPTIC SYSTEM PLEASE COMPLETE THE FOLLOWING SECTION:** ☐ N/A

NUMBER OF BEDROOMS TO BE ADDED: _____ NUMBER OF ADDITIONAL OCCUPANTS IN THE RESIDENCE: _____

6. **WATER SUPPLY:** ☐ MUNICIPAL ☑ PRIVATE WELL ☐ PUBLIC WELL ☐ SHARED WELL ☐ OTHER _____

7. **PROPOSED USE OF WELL:** ☐ N/A ☐ IRRIGATION ☑ POTABLE (DRINKING WATER) ☐ OTHER _____

8. **PLEASE INDICATE AND RANK DESIRED SEPTIC SYSTEM TYPE(S) IN ORDER OF PREFERENCE** *(1-MOST DESIRED 5-LEAST DESIRED):*

☐ N/A ☒ ANY TYPE ☑ CONVENTIONAL ☐ ACCEPTED ☐ INNOVATIVE ☐ ALTERNATIVE ☐ OTHER _____

8A. **RANK:** ____ ____ ____ ____ ____

9. **DO ANY OF THE FOLLOWING APPLY TO THE PROPERTY IN QUESTION? IF "YES" PLEASE ATTACH SUPPORTING DOCUMENTATION.**

BURIED CABLES, LANDFILLS, STUMPHOLES	☐ YES	☑ NO	GRADING/SOIL REMOVAL PERFORMED	☐ YES	☑ NO
EXISTING WASTEWATER (SEPTIC) SYSTEMS	☑ YES	☐ NO	JURISDICTIONAL WETLANDS	☐ YES	☑ NO
WELLS, SPRINGS, OR WATER LINES	☑ YES	☐ NO	APPROVAL REQUIRED BY ANY OTHER PUBLIC AGENCY	☐ YES	☑ NO
EASEMENTS OR RIGHT-OF-WAYS	☐ YES	☑ NO	WASTEWATER OTHER THAN DOMESTIC SEWAGE	☐ YES	☑ NO
CHEMICAL/PETROLEUM STORAGE TANKS	☐ YES	☑ NO	KNOWN UNDERGROUND CONTAMINATION	☐ YES	☑ NO
WASTE STORAGE	☐ YES	☑ NO	GROUNDWATER USE RESTRICTIONS/VARIANCES	☐ YES	☑ NO

10. **WHAT DATE WAS THE PROPERTY ORIGINALLY DEEDED AND RECORDED?** _____ ☑ UNKNOWN

11. **WHAT IS THE ANTICIPATED CLOSING DATE FOR THIS PROPERTY?** _____ ☐ N/A

12. **PROPERTY OWNER:**

NAME: Sharon Browne
ADDRESS: 8326 Arlington Church Rd
CITY: Chlt
STATE: NC ZIP: 28227
HOME PHONE: 704 545.9107
WORK PHONE: 704 545.9107
MOBILE PHONE: 704.634.1637
FAX: 704.573.4597

13. **OWNER'S LEGAL REPRESENTATIVE, IF APPLICABLE:**


NAME: Rick Duncan Construction
ADDRESS: 215 East CJ Thomas Rd
CITY: Monroe
STATE: NC ZIP: 28110
HOME PHONE:
WORK PHONE: 289-2429
MOBILE PHONE: 309-2945
FAX: 289-2429

MECKLENBURG COUNTY – GROUNDWATER & WASTEWATER SERVICES
700 N. TRYON ST. SUITE 211 CHARLOTTE, NC 28202, OFFICE: 704-336-5103, FAX: 704-336-6984

Revised on: 7/1/08

PRELIMINARY BUILDING FLOOR 1

THE ANNEX COMMERCIAL UNITS 101, 102, 103

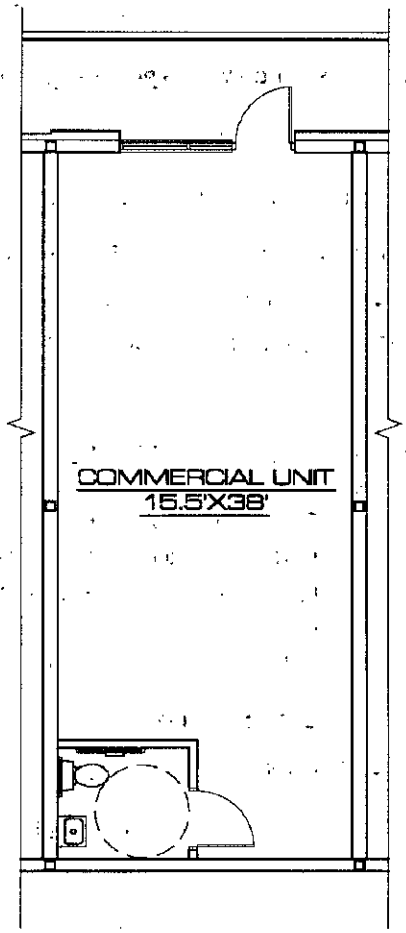

Floor plan may be inverted depending on location in building.

14. SEPTIC SYSTEM PERMIT APPLICATION:

If the information in this application is falsified, changed, or the site is altered, then the Improvement Permit and Authorization to Construct shall become invalid. I have read this application and certify that the information provided herein is true, complete and correct. Authorized county and state officials are granted right of entry to conduct necessary inspections to determine compliance with applicable laws and rules. I understand that I am solely responsible for the proper identification and labeling of all property lines and corners and making the site accessible so that a complete site evaluation can be performed. The permit is valid for either sixty (60) months or is non-expiring depending upon the documentation submitted: complete site plan = 60 months, complete plat = non-expiring.

SKB (Initial here for septic system applications)

15. WELL PERMIT APPLICATION:

If the information in this application is falsified, changed, or the site is altered, then the Well Permit shall become invalid. I have read this application and certify that the information provided herein is true, complete and correct. Authorized county and state officials are granted right of entry to conduct necessary inspections to determine compliance with applicable laws and rules. I understand that I am solely responsible for the proper identification and labeling of all property lines and corners and making the site accessible so that a complete site evaluation can be performed. The permit is valid for a period of twelve (12) months from the date of issuance.

_____ (Initial here for well applications)

16. APPLICATION SIGNATURE SECTION:

ONLY COMPLETE APPLICATIONS WILL BE PROCESSED. A proper signature is required in order to process your application. Please review the application carefully and sign in the space provided below.

Sharon Brown — Property Owner's or Owner's Legal Representative Signature

07.02.08 — Date

OFFICE USE ONLY

☐ SURVEY PLAT TO SCALE SUBMITTED ☐ SCALED SITE PLAN SUBMITTED ☑ UN-SCALED SITE PLAN SUBMITTED

SEPTIC APPLICATION FEES RECEIVED: $ 250.00 DATE FEE RECEIVED: 8/4/08

WELL APPLICATION FEES RECEIVED: $ _____ DATE FEE RECEIVED: _____

APPLICATION PROCESSED BY: JC

GWS FILE NUMBER ASSIGNED: 10272

APPLICATION ID NUMBER ASSIGNED: 3766


COMMENTS:

MECKLENBURG COUNTY – GROUNDWATER & WASTEWATER SERVICES
700 N. TRYON ST. SUITE 211 CHARLOTTE, NC 28202, OFFICE: 704-336-5103, FAX: 704-336-6984

Revised on: 7/1/08

PRELIMINARY UNIT PLAN

SKYBOX COMMERCIAL UNIT 104

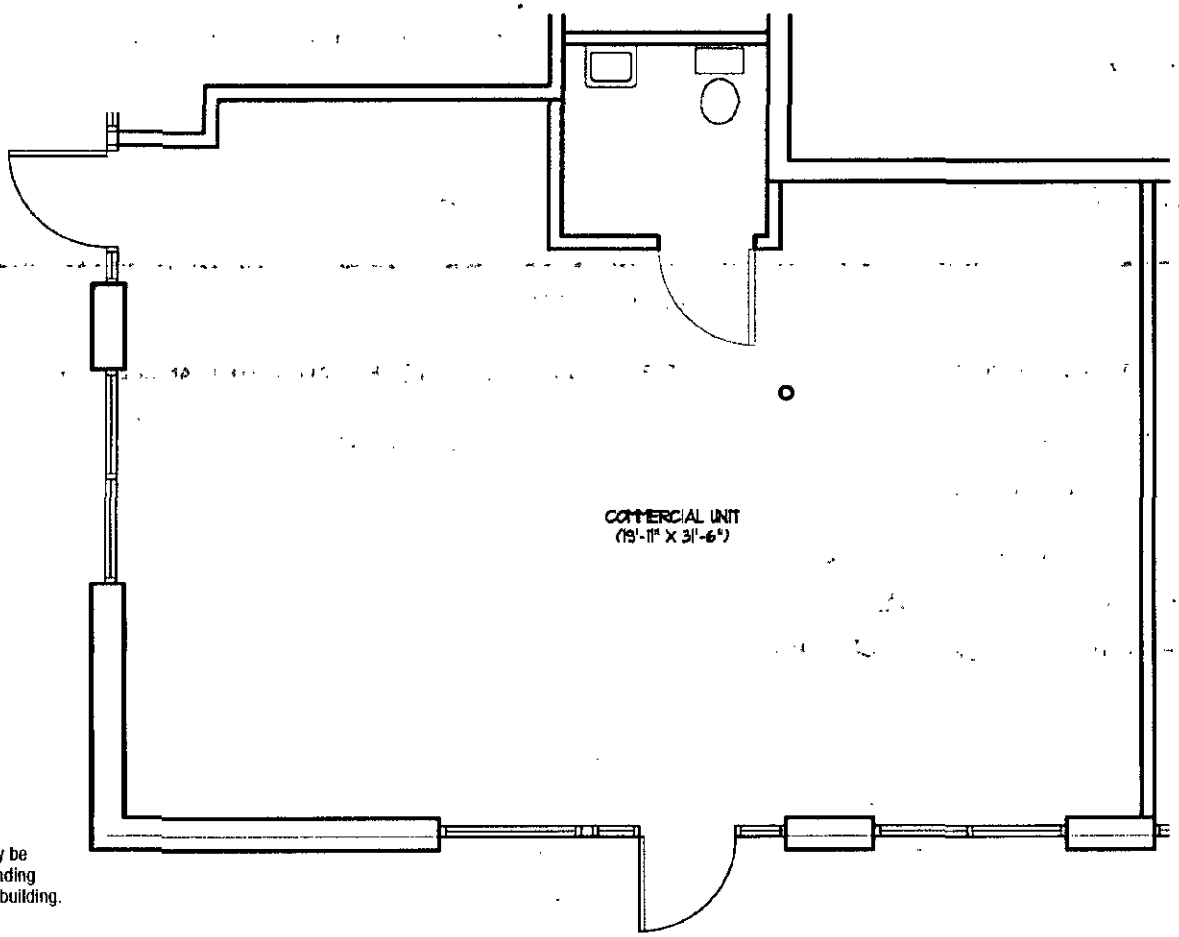

Floor plan may be inverted depending on location in building.


Mecklenburg County, North Carolina

POLARIS

Property Ownership Land Records Information System

Date Printed: Thu Jul 17 18:58:57 EDT 2008

8326 Arlington Church Road

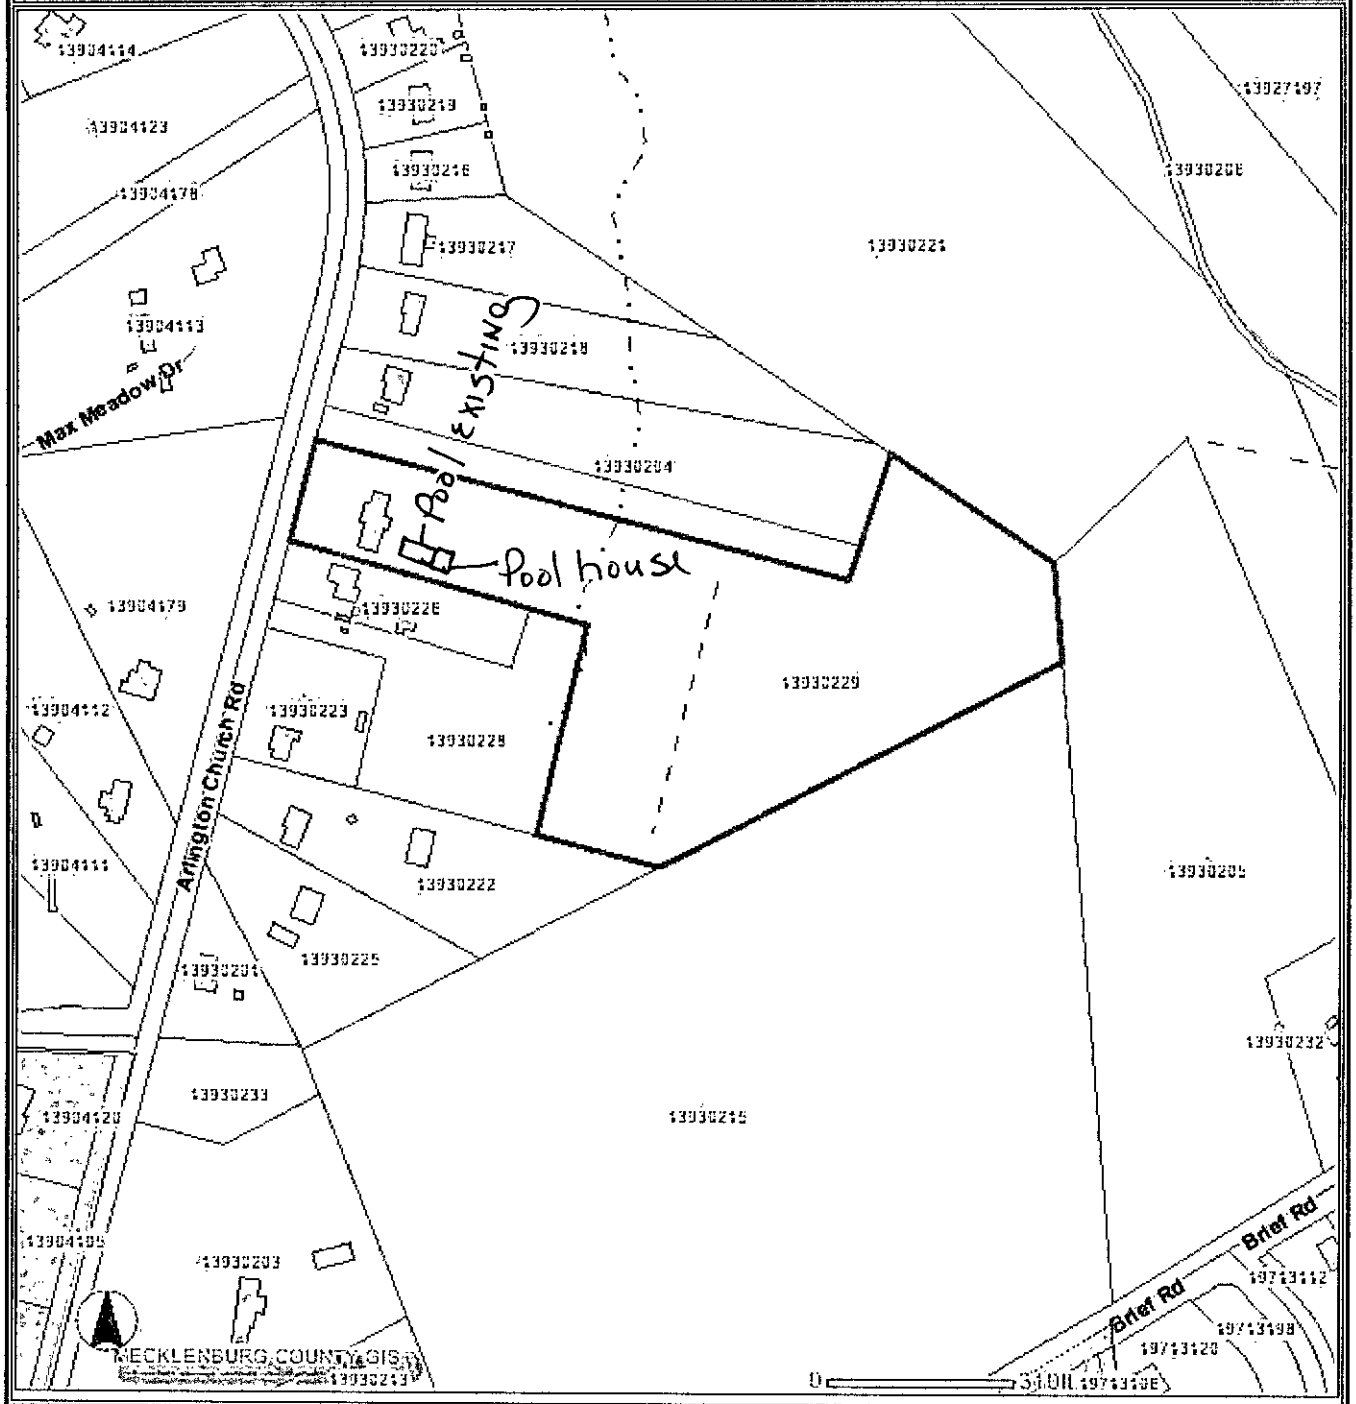

This map is prepared for the inventory of real property within Mecklenburg County and is compiled from recorded deeds, plats, tax maps, surveys, planimetric maps, and other public records and data. Users of this map are hereby notified that the aforementioned public primary information sources should be consulted for verification. Mecklenburg County and its mapping contractors assume no legal responsibility for the information contained herein.

Department of Environment, Health, and Natural Resources
Division of Environmental Health
On-site Wastewater Section

Sheet: 1 of 2
Property ID: 139-30-229
Lot #:
File #: 11272
AppID: 3766

SOIL/SITE EVALUATION for ON-SITE WASTEWATER SYSTEM

Owner: Sharon Browne
Applicant: Sharon Browne
Address: 8326 Arlington church road Charllotte, NC 28227
Date Evaluated: 08/07/2008
Proposed Facility: Pool House
Design Flow (.1949): 240gpd
Property Size: 9 acres
Location of Site: 8326 Arlington church road Charllotte, NC 28227
Property Recorded: 1976
Water Supply: [ ] Public [ ] Individual [X] Well [ ] Spring [ ] Other
Evaluation Method: [X] Auger Boring [ ] Pit [ ] Cut
Type of Wastewater: [X] Sewage [ ] Industrial Process [ ] Mixed

PROFILE #	.1940 Landscape Position/ Slope%	Horizon Depth (IN.)	SOIL MORPHOLOGY .1941 .1941 Structure/ Texture	.1941 Consistence Mineralogy	b PROFILE FACTORS .1942 Soil Wetness/ Color	.1943 Soil Depth (IN.)	.1956 Sapro Class	.1944 Restr Horiz	Profile Class & LTAR
1	LS	0-4	GR/SL	FR,SS,SP,SXP	>40" TO SOIL WETNESS	40	None	N/A	P.S IV
	9	4-11	GR-SBK/SCL	FR,S,SP,SXP					.3GPD/FT^2
		11-40	SBK/C	FI,S,SP,SXP					
2	LS	0-7	GR/SCL	FR,SS,SP,SXP	>48" TO SOIL WETNESS	48	"	"	"
	11	7-48	SBK/C	FI,S,SP,SXP					
3	LS	0-8	GR/SCL	FR,SS,SP,SXP	>48" TO SOIL WETNESS	48	"	"	"
	6	8-48	SBK/C	FI,S,SP,SXP					
4	LS	0-7	GR/SCL	FR,SS,SP,SXP	>48" TO SOIL WETNESS	45	"	"	"
	8	7-45	SBK/C	FI,S,SP,SXP					
5	LS	0-8	GR-SBK/SCL	FR-FI,SS,SP,SXP	>48" TO SOIL WETNESS	48	"	"	.275GPD/FT^2
	3	8-48	SBK/C	FI,S,SP,SXP					P.S IV
6	LS	0-9	GR/SL	FR,SS,SP,SXP	>48" TO SOIL WETNESS	48	"	"	.3GPD/FT^2
	3	9-13	GR-SBK/SCL	FR-FI,SS,SP,SXP					P.S IV
		13-48	SBK/C	FI,S,P,SXP					
				Site LTAR .275gpd/ft^2					

Description	Initial System	Repair System
Available Space (.1945)	P.S	P.S
System Type(s)	IIIg	IIIg
Site LTAR	.275GPD/FT^2	.275GPD/FT^2

Other Factors (.1946):
Soil Evaluation By: Jason Jackson
Others Present:
Site Classification (.1948): Provisionally Suitable
Site Evaluation By: Jason Jackson
Others Present: David Cornelius

Sheet: 2of2


COMMENTS: FILE #: 11272

100% repair area not required

Landscape Position	Group	Texture	.1955 LTAR	Structure
R-Ridge	I	S-Sand	1.2 - 0.8	SG-Single Grain
SS-Shoulder Slope		LS-Loamy Sand		M-Massive
LS-Linear Slope				CR-Crumb
FS-Foot Slope	II	SL-Sandy Loam	0.8 - 0.6	GR-Granular
NS-Nose Slope		L-Loam		SBK-Subangular Blocky
HS-Head Slope				ABK-Angular Blocky
CC-Concave Slope	III	SI-Silt	0.6 - 0.3	PL-Platy
CV-Convex Slope		SICL-Silty Clay Loam		PR-Prismatic
T-Terrace				
FP-Flood Plain		CL-Clay Loam		
		SCL-Sandy Clay Loam		
	IV	SC-Sandy Clay	0.4 - 0.1	
		SIC-Silty Clay		
		C-Clay		

Consistence Moist	Consistence Wet	Mineralogy
VFR-Very Friable	NS-Non-Sticky	SEXP-Slightly Expansive
FR-Friable	SS-Slightly Sticky	EXP-Expansive
FI-Firm	S-Sticky	
VFI-Very Firm	VS-Very Sticky	
EFI-Extremely Firm	NP-Non-Plastic	
	SP-Slightly Plastic	
	P-Plastic	
	VP-Very Plastic	

Sketch of Soil Evaluation Locations

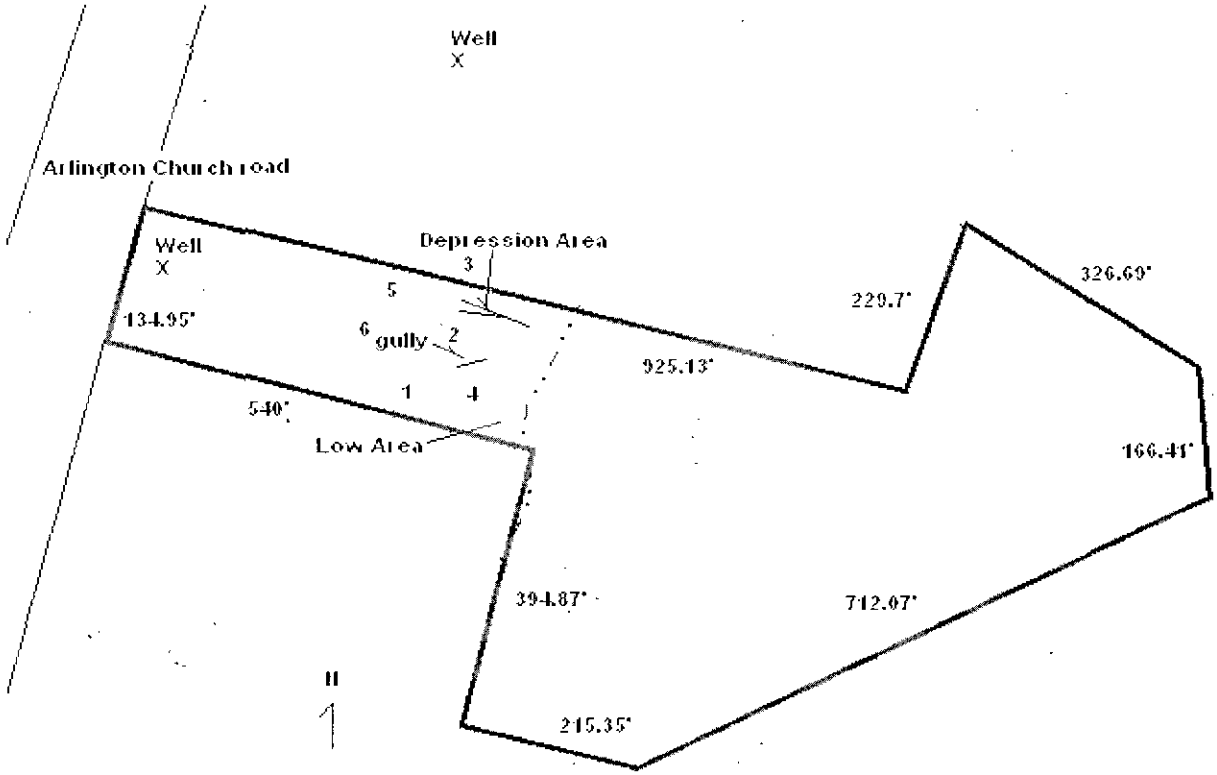


PROPOSED PLOT PLAN

HEALTH DEPARTMENT
ENVIRONMENTAL HEALTH DIVISION
700 NORTH TRYON ST., SUITE 211
CHARLOTTE, NC 28202
PHONE (704) 336-5103

FILE: 11272

TC: 13930229

Draw in and name all roads adjoining the property. Draw in and accurately dimension the lot concerned. Accurately indicate property boundaries proposed and/or existing structures and driveways, underground utilities and wells and springs within 100 feet of the proposed building or drainfield.

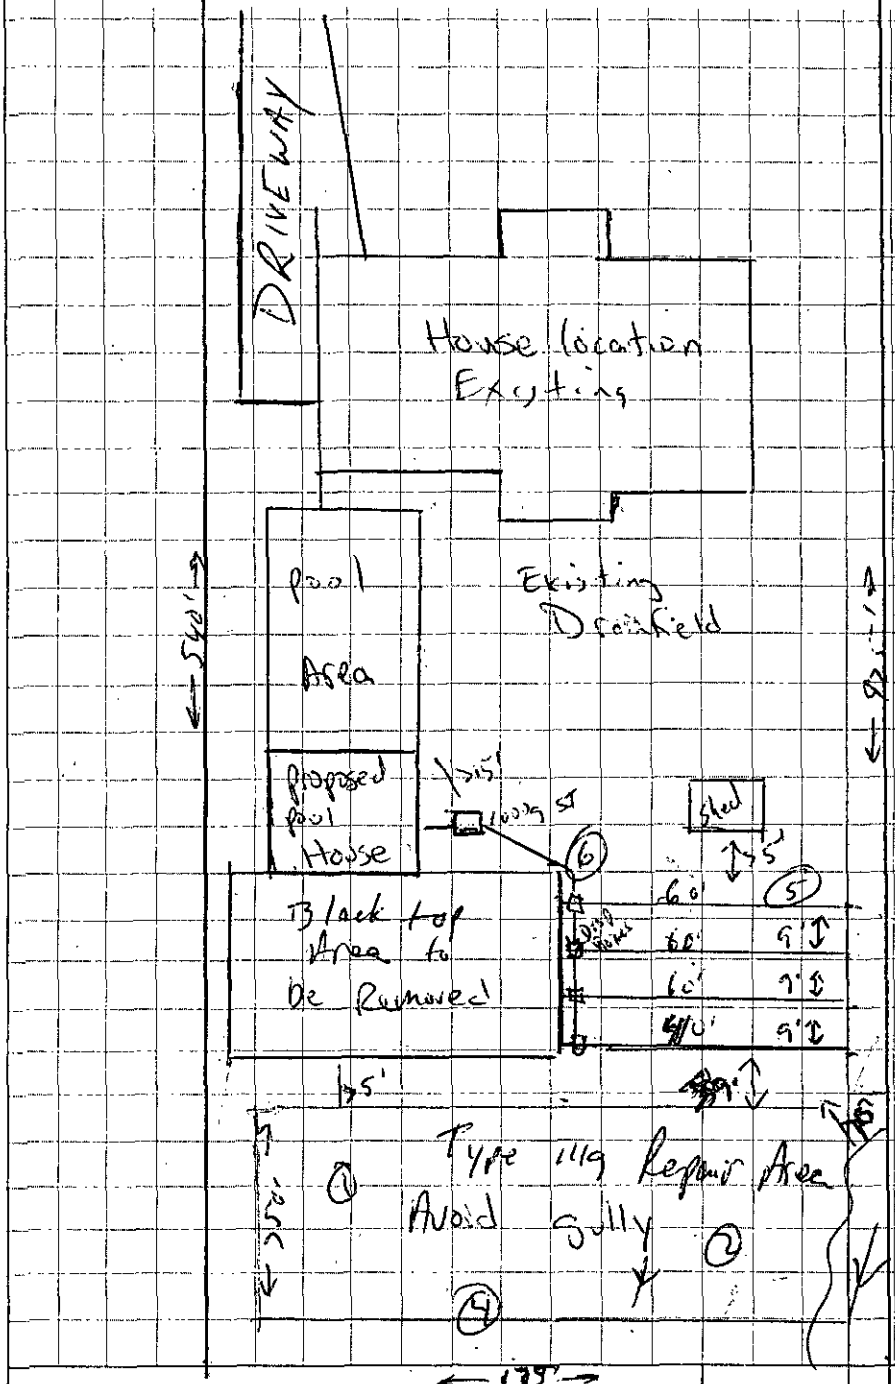

lot size > 9 acres

Comments

Pool House
240 gpd at .275 LTAR
873' drainfield area
at 25% reduction 1119
219 linear ft
have 3 lines at 60'
in length and 1 at
40' in length, or
2 lines at 60' and
2 lines at 50'
1000 gal septic tank
to drop boxes
Have Type IIIg
Repair Area
* avoid gullies near
repair Area

* Keep system > 5' from pool Area

APPROVAL DATE _____ 1"=40' JJ 8-18-08

OWNER/AGENT SIGNATURE

DATE

White - Health Department's Copy Canary - E.H.S. Copy Pink - Owner's Copy

Mecklenburg County Groundwater & Wastewater Services
700 N. Tryon St, Suite 211 Charlotte, NC 28202
Phone: (704) 336-5103 Fax: (704) 336-6894

NC DENR
Division of Environmental Health
On-Site Wastewater Section

IMPROVEMENT PERMIT for a RESIDENTIAL ON-SITE WASTEWATER TREATMENT & DISPOSAL SYSTEM

Permit #: 30003766 GWS File #: 11272 Tax Parcel #: 139-302-29

- This IMPROVEMENT PERMIT is subject to revocation if site plans or the intended use change. There is to be NO grading, filling, or disturbance of the soil in the area of the septic tank system or repair area.
- CONSTRUCTION AUTHORIZATION must be obtained prior to receiving a Building Permit. The Construction Authorization is NOT transferable Do not clear, grade, fill or disturb soil prior to obtaining a Construction Authorization.
- Domestic-type wastewater only. No industrial process wastewater may be discharged into the system.

I. This Improvement Permit Shall: Expire in Five (5) Years **Expiration Date (If Applicable):** 8/18/2013

Type of Installation: Residential - New System Lot Number: 0

Structure Type: OTHER Size (ft^2): 800 # Bedrooms: 1 # Occupants: 1

Building Foundation: Crawl Space Water Supply: Community

II. Initial System Type: Approved **System Classification:** IIIg

Initial System Specifications:

Design Flow (gpd):	240	LTAR (gpd/ft^2):	.275	Septic Tank Size (gal):	1000	Pump Tank Size (gal):	N/A
Trench Width (ft):	3	Trench Spacing (ft):	9	Absorption Area (ft^2):	655	Total Trench Length (ft):	218
Maximum Trench Depth (in):	30	Depth of Media (in):	12	Distribution Device:	Drop Boxes		

III. Repair System Type: Approved **System Classification:** IIIg

Repair System Specifications:

Design Flow (gpd):	240	LTAR (gpd/ft^2):	.275	Septic Tank Size (gal):	1000	Pump Tank Size (gal):	N/A
Trench Width (ft):	3	Trench Spacing (ft):	9	Absorption Area (ft^2):	655	Total Trench Length (ft):	218
Maximum Trench Depth (in):	30	Depth of Media (in):	12	Distribution Device:	Drop Boxes		

IV. Permit Conditions/Comments:

(Please See the Following Page for Permit Conditions.)

The undersigned, an authorized agent of the MECKLENBURG COUNTY HEALTH DEPARTMENT, certifies that the Department is issuing an IMPROVEMENT PERMIT for the above referenced property. This permit is being issued in accordance with the *Laws and Rules For Sewage Treatment, and Disposal Systems* and is subject to the following provisions:

- No work shall be conducted on the septic system until an INSTALLATION APPROVAL is granted by the Department.
- The septic system installer shall be a registered septic contractor with Mecklenburg County Health Department.
- The permitted system shall be installed in accordance with the included PLOT PLAN.
- This IMPROVEMENT PERMIT is transferable.

DENR Authorized Agent: Jason Jackson Owner/Legal Agent: _____
Print Name

Signature: Jason Jackson Signature: _____

Date Issued: 8/18/2008

Mecklenburg County Groundwater & Wastewater Services
700 N. Tryon St, Suite 211 Charlotte, NC 28202
Phone: (704) 336-5103 Fax: (704) 336-6894

NC DENR
Division of Environmental Health
On-Site Wastewater Section

IMPROVEMENT PERMIT for a RESIDENTIAL ON-SITE WASTEWATER TREATMENT & DISPOSAL SYSTEM

Permit #: **30003766** GWS File #: **11272**

IV. Permit Conditions/Comments:

- This Improvement Permit is being issued based on a supplemental soil investigation performed by staff from our office.
- All components of the septic system must be installed in accordance with the required setbacks listed on the corresponding plot plan.
- All components of the septic system must be located at least 100 ft. (50 ft. minimum) from all private wells.

The undersigned, an authorized agent of the MECKLENBURG COUNTY HEALTH DEPARTMENT, certifies that the Department is issuing an IMPROVEMENT PERMIT for the above referenced property. This permit is being issued in accordance with the *Laws and Rules For Sewage Treatment and Disposal Systems* and is subject to the following provisions:

- No work shall be conducted on the septic system until an INSTALLATION APPROVAL is granted by the Department.
- The septic system installer shall be a registered septic contractor with Mecklenburg County Health Department.
- The permitted system shall be installed in accordance with the included PLOT PLAN.
- This IMPROVEMENT PERMIT is transferable.

DENR Authorized Agent: Jason Jackson

Signature: Jason Jackson

Date Issued: 8/18/2008

Owner/Legal Agent: _____
Print Name

Signature: _____

Mecklenburg County Groundwater & Wastewater Services
700 N. Tryon St. Suite 211 Charlotte, NC 28202
Phone: (704) 336-5103 Fax: (704) 336-6894

NC DENR
Division of Environmental Health
On-Site Wastewater Section

IMPROVEMENT PERMIT for a RESIDENTIAL ON-SITE WASTEWATER TREATMENT & DISPOSAL SYSTEM

Permit #: 30003766 GWS File #: 11272 Tax Parcel #: 139-302-29

- This IMPROVEMENT PERMIT is subject to revocation if site plans or the intended use change. There is to be NO grading, filling, or disturbance of the soil in the area of the septic tank system or repair area.
- CONSTRUCTION AUTHORIZATION must be obtained prior to receiving a Building Permit. The Construction Authorization is NOT transferable. Do not clear, grade, fill or disturb soil prior to obtaining a Construction Authorization.
- Domestic-type wastewater only. No industrial process wastewater may be discharged into the system.

I. This Improvement Permit Shall: Expire in Five (5) Years **Expiration Date (If Applicable):** 8/18/2013

Type of Installation: Residential - New System Lot Number: 9

Structure Type: OTHER Size (ft^2): 800 # Bedrooms: 1 # Occupants: 1

Building Foundation: Crawl Space Water Supply: Community

II. Initial System Type: Approved **System Classification:** IIIc

Initial System Specifications:

Design Flow (gpd): 240 LTAR (gpd/ft^2): .275 Septic Tank Size (gal): 1000 Pump Tank Size (gal): N/A

Trench Width (ft): 3 Trench Spacing (ft): 6 Absorption Area (ft^2): 655 Total Trench Length (ft): 218

Maximum Trench Depth (in): 30 Depth of Media (in): 12 Distribution Device: Drop Boxes

III. Repair System Type: Approved **System Classification:** IIIg

Repair System Specifications:

Design Flow (gpd): 240 LTAR (gpd/ft^2): .275 Septic Tank Size (gal): 1000 Pump Tank Size (gal): N/A

Trench Width (ft): 3 Trench Spacing (ft): 6 Absorption Area (ft^2): 655 Total Trench Length (ft): 218

Maximum Trench Depth (in): 30 Depth of Media (in): 12 Distribution Device: Drop Boxes

IV. Permit Conditions/Comments:

(Please See the Following Page for Permit Conditions.)

The undersigned, an authorized agent of the MECKLENBURG COUNTY HEALTH DEPARTMENT, certifies that the Department is issuing an IMPROVEMENT PERMIT for the above referenced property. This permit is being issued in accordance with the *Laws and Rules For Sewage Treatment and Disposal Systems* and is subject to the following provisions:

- No work shall be conducted on the septic system until an INSTALLATION APPROVAL is granted by the Department.
- The septic system installer shall be a registered septic contractor with Mecklenburg County Health Department.
- The permitted system shall be installed in accordance with the included PLOT PLAN.
- This IMPROVEMENT PERMIT is transferable.

DENR Authorized Agent: Jason Jackson Owner/Legal Agent: Sharon Browne
Print Name

Signature: Jason Jackson Signature: Sharon Browne

Date Issued: 8/18/2008

Mecklenburg County Groundwater & Wastewater Services
700 N. Tryon St, Suite 211 Charlotte, NC 28202
Phone: (704) 336-5103 Fax: (704) 336-6894

NC DENR
Division of Environmental Health
On-Site Wastewater Section

IMPROVEMENT PERMIT for a RESIDENTIAL ON-SITE WASTEWATER TREATMENT & DISPOSAL SYSTEM

Permit #: 30003766 GWS File #: 11272

IV. Permit Conditions/Comments:

- This Improvement Permit is being issued based on a supplemental soil investigation performed by staff from our office.
- All components of the septic system must be installed in accordance with the required setbacks listed on the corresponding plot plan.
- All components of the septic system must be located at least 100 ft. (50 ft. minimum) from all private wells.

The undersigned, an authorized agent of the MECKLENBURG COUNTY HEALTH DEPARTMENT, certifies that the Department is issuing an IMPROVEMENT PERMIT for the above referenced property. This permit is being issued in accordance with the *Laws and Rules For Sewage Treatment and Disposal Systems* and is subject to the following provisions:

- No work shall be conducted on the septic system until an INSTALLATION APPROVAL is granted by the Department.
- The septic system installer shall be a registered septic contractor with Mecklenburg County Health Department.
- The permitted system shall be installed in accordance with the included PLOT PLAN.
- This IMPROVEMENT PERMIT is transferable.

DENR Authorized Agent: Jason Jackson

Signature: Jason Jackson

Date Issued: 8/15/2008

Owner/Legal Agent: Sharon Browne
Print Name

Signature: Sharon Browne

PROPOSED PLOT PLAN


HEALTH DEPARTMENT
ENVIRONMENTAL HEALTH DIVISION
700 NORTH TRYON ST., SUITE 211
CHARLOTTE, NC 28202
PHONE (704) 336-5103

704-336-
6894

FILE: 11272

TC: 135 30 229

Draw in and name all roads adjoining the property. Draw in and accurately dimension the lot concerned. Accurately indicate property boundaries proposed and/or existing structures and driveways, underground utilities and wells and springs within 100 feet of the proposed building or drainfield.

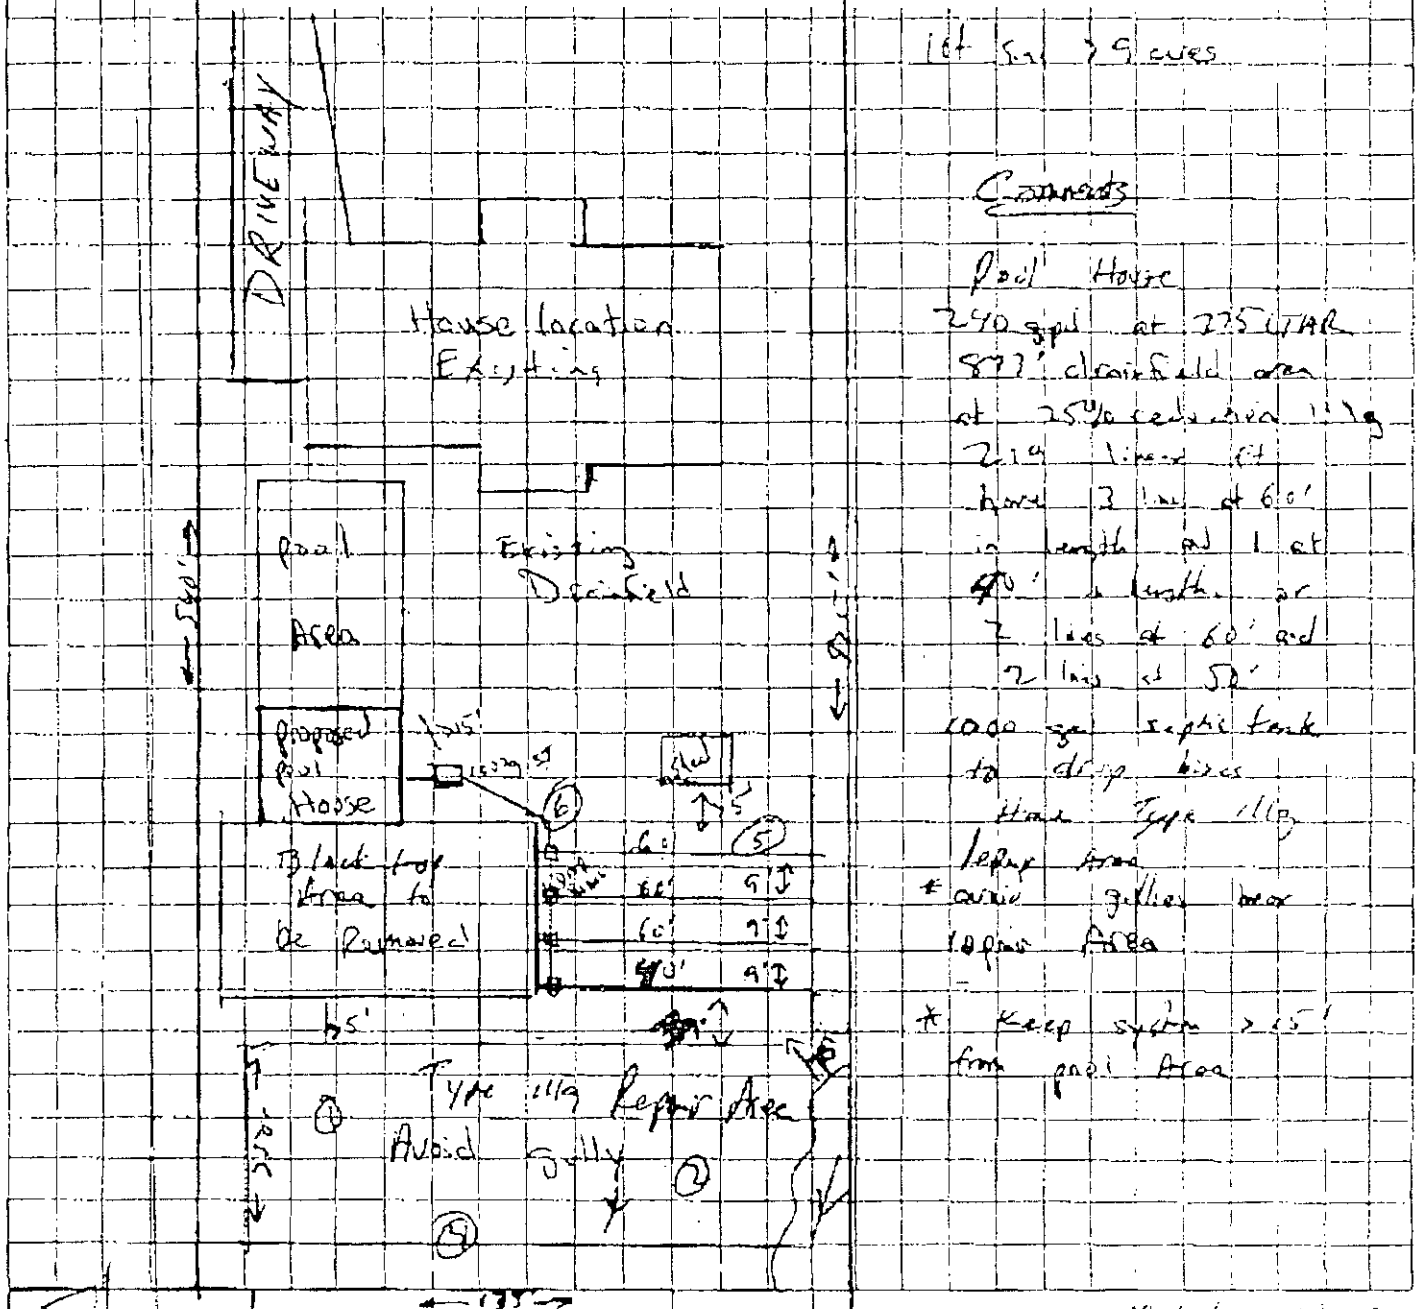

Sharon Browne
OWNER/AGENT SIGNATURE

DATE 10.20.08

APPROVAL DATE JJ 8-18-08

White - Health Department's Copy Canary - E.H.S. Copy Pink - Owner's Copy

Mecklenburg County Groundwater & Wastewater Services
700 N. Tryon St., Suite 211 Charlotte, NC 28202
Phone: (704) 336-5103 Fax: (704) 336-6894

NC DENR
Division of Environmental Health
On-Site Wastewater Section

INSTALLATION APPROVAL for an ON-SITE WASTEWATER TREATMENT & DISPOSAL SYSTEM

File #: 11272 Permit #: _____ Tax Parcel #: 139-30-229

Property Owner: SHARON K BROWNE

Job Location Address: 8326 ARLINGTON CH RD.

City: CHARLOTTE State: NC Zip Code: 28227

Installation Approval Issuance Date: 6/22/09

Permission is hereby given to ☑ install ☐ alter ☐ repair an on-site wastewater treatment & and disposal system, with subsurface soil absorption and effluent discharge, as specified herein at the described location. This approval is granted based upon the application information submitted to our office. All work shall be completed on or before 7/22/09, after which date this approval shall be null and void. The system shall meet all of the construction requirements of 15A NCAC 18A. 1900 which are in effect on the date of granting this approval. An **Operation Permit** must be obtained from the Mecklenburg County Health Department before any system can be covered up or placed into service. The issuance of this permit does not in any way guarantee that the system anticipated to be constructed will operate properly, or relieve any person now of hereafter owning, controlling or using such system from any liability resulting from the failure of the system to operate properly.

***NOTICE: This system shall not be installed while soils are in a wet condition.**

Permitted Design Flow: 240 GPD

Site LTAR: 0.275 GPD/ft² (For new installations only.)

Liquid Capacity of Septic Tank: 1500 gallons

Liquid Capacity of Dosing Tank: N/A gallons

Drainfield Design ☐ N/A

Trench Depth: 30 inches

Trench Width: 3 feet

Line Spacing: 9 feet (O.C.)

Total line length: 218 feet

# of Lines: 2 @ 110 feet

Depth of Media: 12 inches (Type) 111g

Distribution Device: D-Box

Bed Design *(For Repair Installations ONLY.)* ☐ N/A

Bed Depth: _____ inches

Bed Width: _____ feet

Total line length: _____ feet

# of Lines: _____ @ _____ feet

Depth of Media: _____ inches (Type) _____

Distribution Device: _____

Water Supply Source

☐ Municipal ☑ Private Well ☐ Community Well

☐ Other _____


Minimum System Setbacks

Distance from Building Foundation: 10 feet

Distance from Property Line: 10 feet

Distance from Water Supply Source: >50 feet

SKETCH OF SYSTEM LAYOUT
(Proposed Layout)

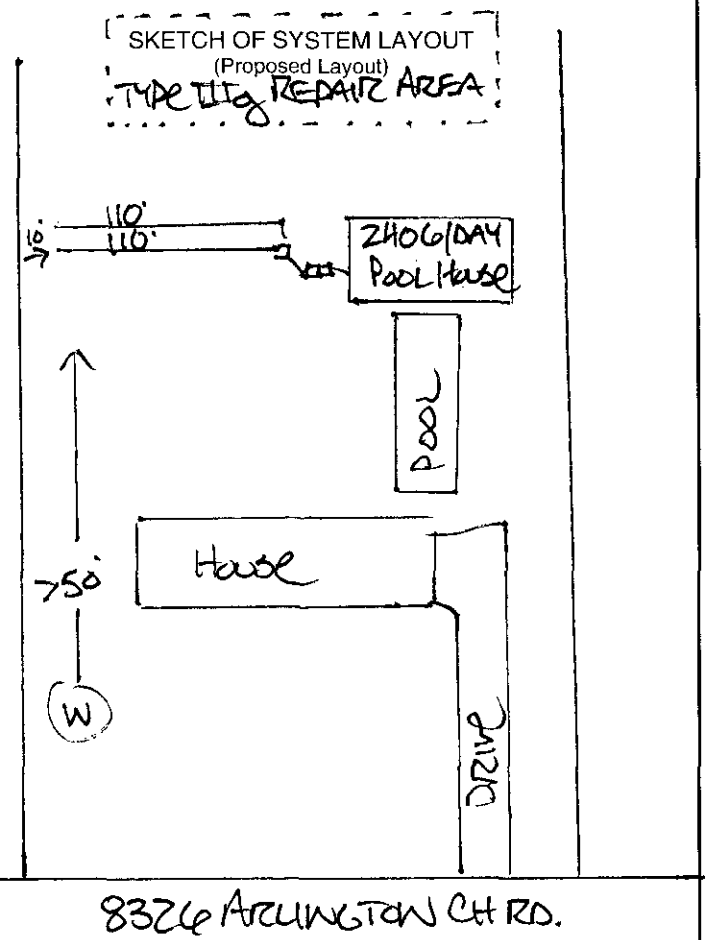

Comments: System Classification & Type: 111g, 25% REDUCTION. INSTALL 2 LINES @ 110' ea.
STAY >50' FROM WELL.

DENR Authorized Agent: DAVID CORNELIUS Signature: _____

Mecklenburg County Groundwater & Wastewater Services
700 N. Tryon St., Suite 211 Charlotte, NC 28202
Phone: (704) 336-5103 Fax: (704) 336-6894

NC DENR
Division of Environmental Health
On-Site Wastewater Section

OPERATION PERMIT for an ON-SITE WASTEWATER TREATMENT & DISPOSAL SYSTEM

File #: 11272 Permit #: _____ Tax Parcel #: 139-30-229

Property Owner: SHARON K. BROWNE

Job Location Address: 8326 ARLINGTON CH RD.

City: CHARLOTTE State: NC Zip Code: 28227

Operation Permit Issuance Date: 6/24/09 Contractor Name: NORWOOD

Permitted Design Flow: 240 GPD

Liquid Capacity of Septic Tank: 1500 gallons

Liquid Capacity of Dosing Tank: N/A gallons

Effluent Pump Model: N/A

Drainfield Installation ☐ N/A E-Z-FLOW

Trench Depth: 30 inches

Trench Width: 3 feet

Line Spacing: 9 feet (O.C.)

Total line length: 220 feet

# of Lines: 2 @ 110 feet

Depth of Media: 12 inches (Type) 111g

Depth of Cover: 12 inches

Distribution Device: D-Box

Bed Installation *(For Repair Installations ONLY.)* ☐ N/A

Bed Depth: _____ inches

Bed Width: _____ feet

Total line length: _____ feet

# of Lines: _____ @ _____ feet

Depth of Media: _____ inches (Type) _____

Depth of Cover: _____ inches

Distribution Device: _____

Water Supply Source

☐ Municipal ☑ Private Well ☐ Community Well

☐ Other _____

System Installation Setbacks

Distance from Building Foundation: 10 feet

Distance from Property Line: 10 feet

Distance from Water Supply Source: 75 feet

Inspection Dates

Tank(s) Inspected: 6/24/09

Excavation Inspected: 6/24/09

Pump & Controls Inspected: N/A

SKETCH OF SYSTEM INSTALLATION
(As-Built Drawing)

INSTALLED AS SHOWN ON INSTALLATION PERMIT. DC 6/24/09

The undersigned has inspected the Septic Tank System described above, and certifies it has been ☑ installed ☐ altered ☐ repaired ☐ as detailed in the plot above ☑ in accordance with the permit issued and meets the provisions of 15A NCAC 18A. 1900, "Laws and Rules for Sewage Treatment and Disposal Systems" in effect on the date of issuance of the permit. The issuance of this Operation Permit does not in any way guarantee that the system will operate properly or relieve any person now or hereafter owning, controlling, or using such system from any liability resulting from the failure of the system to operate properly. This document is issued subject to those restrictions and conditions shown on the permit(s) and the provisions of 15A NCAC 18A. 1900 in addition to those listed below under "Comments." This document shall be null and void if any information contained in the application is untrue or if any additions are made to the property which would increase the requirements for said system.

Notice: Disturbance of the designated repair area may result in the Suspension or Revocation of this permit.

Comments: System Classification & Type: 111g, 25% REDUCTION, E-Z-FLOW. 2 LINES INSTALLED @ 110' ea. (EZFlow 120SH, G, N/A, N/A)

DENR Authorized Agent: DAVID CORNELIUS Signature: _____

Mecklenburg County Groundwater & Wastewater Services
700 N. Tryon St., Suite 211 Charlotte, NC 28202
Phone: (704) 336-5103 Fax: (704) 336-6894

NC DENR
Division of Environmental Health
On-Site Wastewater Section

OPERATION PERMIT for an
ON-SITE WASTEWATER TREATMENT & DISPOSAL SYSTEM

File #: 11272 Permit #: _____ Tax Parcel #: 139-30-229

Property Owner: SHARON K BROWNE

Job Location Address: 8326 ARLINGTON CH RD.

City: CHARLOTTE State: NC Zip Code: 28227

OPERATION PERMIT CONDITIONS:

I. Performance: System shall perform in accordance with 15A NCAC 18A .1961.

II. Monitoring: System shall be monitored as required by 15A NCAC 18A .1961.

III. Maintenance: Ground absorption sewage treatment and disposal systems shall be checked, and the contents of the septic tank removed, periodically from all compartments, to ensure proper operation of the system. The contents shall be pumped whenever the solids level is found to be more than 1/3 of the liquid depth in any compartment.

IV. Operation: System shall be operated in accordance with 15A NCAC 18A .1961.

System Classification: I II a

*Operation Permits for Type V and VI systems expire five (5) years from the date of issuance (in accordance with Table V(a)). The system owner must contact GWS six (6) months prior to expiration for permit renewal.

Subsurface system operator required: Yes ☐ No ☒

☐ This type of system requires the system owner to maintain a contract with a certified operator to perform system inspection, maintenance, and reporting as required in 15A NCAC 18A .1961. and Table V(a). The system owner is responsible for all fees associated with these services.

☒ System does not require inspection by GWS on a routine frequency.

☐ System requires inspection by GWS once every five (5) years. The system owner is responsible for all fees associated with the inspection.

☐ System requires inspection by GWS once every three (3) years. The system owner is responsible for all fees associated with the inspection.

☐ System requires inspection by GWS once every twelve (12) months. The system owner is responsible for all fees associated with the inspection.

☐ System requires inspection by GWS once every six (6) months. The system owner is responsible for all fees associated with the inspection.

V. Other:

_____

_____

_____

_____

DENR Authorized Agent: DAVID CORNELIUS Date: 6/25/09

Signature: _____