Mecklenburg County Groundwater & Wastewater Services
700 N. Tryon St., Suite 211 Charlotte, NC 28202
Phone: (704) 336-5103 Fax: (704) 336-6894

NC DENR
Division of Environmental Health
On-Site Wastewater Section

OPERATION PERMIT for an ON-SITE WASTEWATER TREATMENT & DISPOSAL SYSTEM

File #: 8423B Permit #: ~~8423B~~ 5410 Tax Parcel #: 139276 07

Property Owner: True Homes

Job Location Address: 7205 Friar Tuck Ln, Lot 7

City: Mint Hill State: NC Zip Code: 28227

Operation Permit Issuance Date: 10/31/12 Contractor Name: Chris Stevens

Permitted Design Flow: 480 GPD

Liquid Capacity of Septic Tank: 1500 gallons

Liquid Capacity of Dosing Tank: 1000 gallons

Effluent Pump Model: Liberty 253

Drainfield Installation ☐ N/A

Trench Depth: 24 inches

Trench Width: 3 feet

Line Spacing: 9 feet (O.C.)

Total line length: 440 feet

# of Lines: 4 @ 110 feet

Depth of Media: 12 inches (Type) chambers

Depth of Cover: 12 inches

Distribution Device: Washer box, chamber fed

Bed Installation *(For Repair Installations ONLY.)* ☒ N/A

Bed Depth: _____ inches

Bed Width: _____ feet

Total line length: _____ feet

# of Lines: _____ @ _____ feet

Depth of Media: _____ inches (Type) _____

Depth of Cover: _____ inches

Distribution Device: _____

Water Supply Source

☐ Municipal ☒ Private Well ☐ Community Well

☐ Other _____

System Installation Setbacks

Distance from Building Foundation: 10 feet

Distance from Property Line: 10 feet

Distance from Water Supply Source: >50' feet


Inspection Dates

Tank(s) Inspected: 10/31/12

Excavation Inspected: 10/31/12

Pump & Controls Inspected: 10/31/12

SKETCH OF SYSTEM INSTALLATION
(As-Built Drawing)

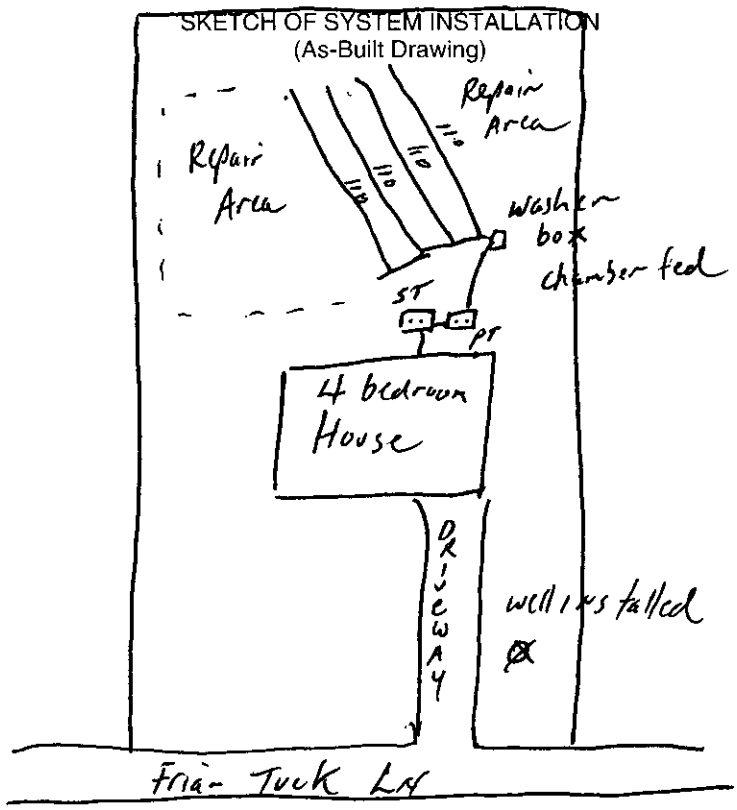

The undersigned has inspected the Septic Tank System described above, and certifies it has been ☒ installed ☐ altered ☐ repaired ☒ as detailed in the plot above ☐ in accordance with the permit issued and meets the provisions of 15A NCAC 18A. 1900, "Laws and Rules for Sewage Treatment and Disposal Systems" in effect on the date of issuance of the permit. The issuance of this Operation Permit does not in any way guarantee that the system will operate properly or relieve any person now or hereafter owning, controlling, or using such system from any liability resulting from the failure of the system to operate properly. This document is issued subject to those restrictions and conditions shown on the permit(s) and the provisions of 15A NCAC 18A. 1900 in addition to those listed below under "Comments." This document shall be null and void if any information contained in the application is untrue or if any additions are made to the property which would increase the requirements for said system.

Notice: Disturbance of the designated repair area may result in the Suspension or Revocation of this permit.

Comments: System Classification & Type: Type IIIb Pump to Chambers BIOA 36HC, P, NA, NA
Change to Pump System due to elevation change

DENR Authorized Agent: Phil Walker Signature: Phil Walker REHS

Mecklenburg County Groundwater & Wastewater Services
700 N. Tryon St., Suite 211 Charlotte, NC 28202
Phone: (704) 336-5103 Fax: (704) 336-6894

NC DENR
Division of Environmental Health
On-Site Wastewater Section

OPERATION PERMIT for an
ON-SITE WASTEWATER TREATMENT & DISPOSAL SYSTEM

File #: 8423B Permit #: 5410 Tax Parcel #: 139 27607

Property Owner: True Homes

Job Location Address: 9205 Friar Tuck Ln, Lot 7

City: Mint Hill State: NC Zip Code: 28227

OPERATION PERMIT CONDITIONS:

I. Performance: System shall perform in accordance with 15A NCAC 18A .1961.

II. Monitoring: System shall be monitored as required by 15A NCAC 18A .1961.

III. Maintenance: Ground absorption sewage treatment and disposal systems shall be checked, and the contents of the septic tank removed, periodically from all compartments, to ensure proper operation of the system. The contents shall be pumped whenever the solids level is found to be more than 1/3 of the liquid depth in any compartment.

IV. Operation: System shall be operated in accordance with 15A NCAC 18A .1961.

System Classification: IIIb

*Operation Permits for Type V and VI systems expire five (5) years from the date of issuance (in accordance with Table V(a)). The system owner must contact GWS six (6) months prior to expiration for permit renewal.

Subsurface system operator required: Yes ☐ No ☒

☐ This type of system requires the system owner to maintain a contract with a certified operator to perform system inspection, maintenance, and reporting as required in 15A NCAC 18A .1961. and Table V(a). The system owner is responsible for all fees associated with these services.

☐ System does not require inspection by GWS on a routine frequency.

☒ System requires inspection by GWS once every five (5) years. The system owner is responsible for all fees associated with the inspection.

☐ System requires inspection by GWS once every three (3) years. The system owner is responsible for all fees associated with the inspection.

☐ System requires inspection by GWS once every twelve (12) months. The system owner is responsible for all fees associated with the inspection.

☐ System requires inspection by GWS once every six (6) months. The system owner is responsible for all fees associated with the inspection.

V. Other: Pump to chambers

DENR Authorized Agent: Philo Walker Date: 10/31/12

Signature: Philo Walker REHS

Mecklenburg County Groundwater & Wastewater Services
700 N. Tryon St., Suite 211 Charlotte, NC 28202
Phone: (704) 336-5103 Fax: (704) 336-6894

NC DENR
Division of Environmental Health
On-Site Wastewater Section

INSTALLATION APPROVAL for an ON-SITE WASTEWATER TREATMENT & DISPOSAL SYSTEM

File #: 8423B Permit #: 5410 Tax Parcel #: 139 276 07

Property Owner: True Homes

Job Location Address: 7205 Friar Tuck Ln, lot 7

City: Mint Hill State: NC Zip Code: 28227

Installation Approval Issuance Date: 10/29/12

Permission is hereby given to ☒ *install* ☐ *alter* ☐ *repair an on-site wastewater treatment & and disposal system, with subsurface soil* absorption and effluent discharge, as specified herein at the described location. This approval is granted based upon the application information submitted to our office. All work shall be completed on or before 11/29/12, after which date this approval shall be null and void. The system shall meet all of the construction requirements of 15A NCAC 18A. 1900 which are in effect on the date of granting this approval. An **Operation Permit** must be obtained from the Mecklenburg County Health Department before any system can be covered up or placed into service. The issuance of this permit does not in any way guarantee that the system anticipated to be constructed will operate properly, or relieve any person now of hereafter owning, controlling or using such system from any liability resulting from the failure of the system to operate properly.

***NOTICE: This system shall not be installed while soils are in a wet condition.**

Permitted Design Flow: 480 GPD

Site LTAR: 0.275 GPD/ft² (For new installations only.)

Liquid Capacity of Septic Tank: 1500 gallons

Liquid Capacity of Dosing Tank: 1000 gallons

Drainfield Design ☐ N/A

Trench Depth: 24 inches

Trench Width: 3 feet

Line Spacing: 9 feet (O.C.)

Total line length: 440 feet

# of Lines: 4 @ 110 feet

Depth of Media: 12 inches (Type) 2570 Reduction

Distribution Device: Washer box, chamber fed

Bed Design *(For Repair Installations ONLY.)* ☒ N/A

Bed Depth: _____ inches

Bed Width: _____ feet

Total line length: _____ feet

# of Lines: _____ @ _____ feet

Depth of Media: _____ inches (Type) _____

Distribution Device: _____

Water Supply Source

☐ Municipal ☒ Private Well ☐ Community Well

☐ Other _____


Minimum System Setbacks

Distance from Building Foundation: 10 feet

Distance from Property Line: 10 feet

Distance from Water Supply Source: 50' feet

SKETCH OF SYSTEM LAYOUT
(Proposed Layout)

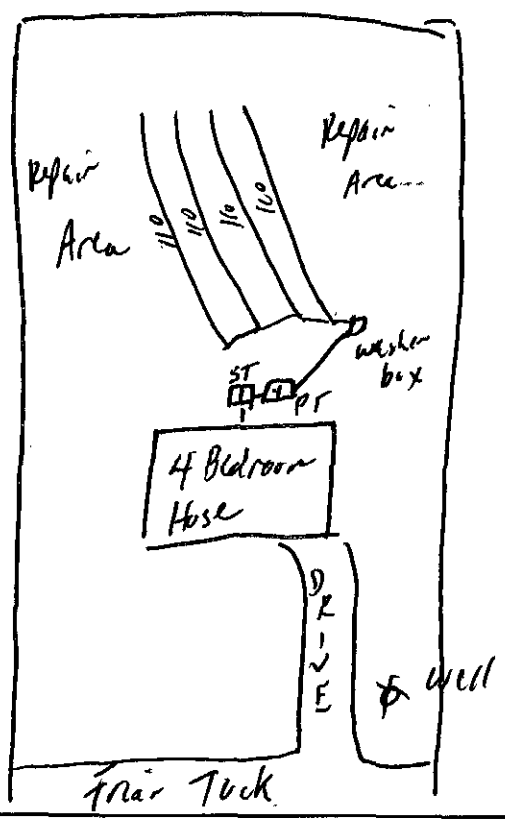

Comments: System Classification & Type: Type IIIb Pump system to be installed due to elevation changes from grading. Septic drainfield to be installed at 24" max trench depth.

DENR Authorized Agent: Philo Walker Signature: Philo Walker REHS

Mecklenburg County Groundwater & Wastewater Services
700 N. Tryon St, Suite 211 Charlotte, NC 28202
Phone: (704) 336-5103 Fax: (704) 336-6894

NC DENR
Division of Environmental Health
On-Site Wastewater Section

IMPROVEMENT PERMIT for a RESIDENTIAL ON-SITE WASTEWATER TREATMENT & DISPOSAL SYSTEM

Permit #: **30005410** GWS File #: **8423B** Tax Parcel #: **139-276-07**

- This IMPROVEMENT PERMIT is subject to revocation if site plans or the intended use change. There is to be **NO** grading, filling, or disturbance of the soil in the area of the septic tank system or repair area.
- CONSTRUCTION AUTHORIZATION must be obtained prior to receiving a Building Permit. The Construction Authorization is **NOT** transferable. *Do not clear, grade, fill or disturb soil prior to obtaining a Construction Authorization.*
- Domestic-type wastewater only. No industrial process wastewater may be discharged into the system.

I. This Improvement Permit Shall: Expire in Five (5) Years **Expiration Date (If Applicable):** 4/3/2017

Type of Installation: Residential - New System Lot Number: 7

Structure Type: HOUSE Size (ft^2): 3200 # Bedrooms: 4 # Occupants: 5

Building Foundation: Concrete Slab Water Supply: Private Well

II. Initial System Type: Pump to Approved **System Classification:** IIIg

Initial System Specifications:

Design Flow (gpd):	480	LTAR (gpd/ft^2):	0.275	Septic Tank Size (gal):	1500	Pump Tank Size (gal):	N/A
Trench Width (ft):	3	Trench Spacing (ft):	9	Absorption Area (ft^2):	1309	Total Trench Length (ft):	436
Maximum Trench Depth (in):	24	Depth of Media (in):	12	Distribution Device:	Distribution Box		

III. Repair System Type: Pump to Approved **System Classification:** IIIb

Repair System Specifications:

Design Flow (gpd):	480	LTAR (gpd/ft^2):	0.275	Septic Tank Size (gal):	1500	Pump Tank Size (gal):	1000
Trench Width (ft):	3	Trench Spacing (ft):	9	Absorption Area (ft^2):	1309	Total Trench Length (ft):	436
Maximum Trench Depth (in):	24	Depth of Media (in):	12	Distribution Device:	Pressure Manifold		

IV. Permit Conditions/Comments:

(Please See the Following Page for Permit Conditions.)

The undersigned, an authorized agent of the MECKLENBURG COUNTY HEALTH DEPARTMENT, certifies that the Department is issuing an IMPROVEMENT PERMIT for the above referenced property. This permit is being issued in accordance with the *Laws and Rules For Sewage Treatment, and Disposal Systems* and is subject to the following provisions:

- No work shall be conducted on the septic system until an INSTALLATION APPROVAL is granted by the Department.
- The septic system installer shall be a registered septic contractor with Mecklenburg County Health Department.
- The permitted system shall be installed in accordance with the included PLOT PLAN.
- This IMPROVEMENT PERMIT is transferable.

Philo Walker

DENR Authorized Agent: ~~Jeremy Michael~~ Owner/Legal Agent: _____
Print Name

Signature: Philo Walker REHS Signature: _____

Date Issued: ~~4/3/2012~~ 10/31/12

Mecklenburg County Groundwater & Wastewater Services
700 N. Tryon St, Suite 211 Charlotte, NC 28202
Phone: (704) 336-5103 Fax: (704) 336-6894

NC DENR
Division of Environmental Health
On-Site Wastewater Section

IMPROVEMENT PERMIT for a RESIDENTIAL ON-SITE WASTEWATER TREATMENT & DISPOSAL SYSTEM

Permit #: **30005410** GWS File #: **8423B**

IV. Permit Conditions/Comments:

- This type of septic system requires an inspection once every 5 years by our office. The system owner is responsible for any fees, as determined by the Mecklenburg County Board of Commissioners, associated with this inspection.
- This type of repair system requires the installation of a pump tank and all associated components. This type of system will require routine inspections by our office. The system owner is responsible for all fees associated with these inspections.
- All components of the septic system must be installed in accordance with the required setbacks listed on the corresponding plot plan.
- All components of the septic system must be located at least 100 ft. (50 ft. minimum) from all private wells.
- The invert of the sewer pipe exiting the structrue should be kept as high as possible in order to achieve gravity flow to the drain field. A dosing tank will be required if gravity flow to the drain field can not be achieved.
- Flow from all gutters and downspouts shall be directed not to discharge water onto or across any part of the septic system.
- Foundation drains shall be constructed not to discharge water onto or across any part of the septic system.
- 10/29/12 SEPTIC SYSTEM CHANGED TO PUMP SYSTEM DUE TO GRADING ELEVATION CHANGES.

The undersigned, an authorized agent of the MECKLENBURG COUNTY HEALTH DEPARTMENT, certifies that the Department is issuing an IMPROVEMENT PERMIT for the above referenced property. This permit is being issued in accordance with the *Laws and Rules For Sewage Treatment and Disposal Systems* and is subject to the following provisions:


- No work shall be conducted on the septic system until an INSTALLATION APPROVAL is granted by the Department.
- The septic system installer shall be a registered septic contractor with Mecklenburg County Health Department.
- The permitted system shall be installed in accordance with the included PLOT PLAN.
- This IMPROVEMENT PERMIT is transferable.

Phil Walker

DENR Authorized Agent: ~~Jeremy Michael~~ Owner/Legal Agent:_____
Print Name

Signature: Phil Walker REHS Signature:_____

Date Issued: ~~4/3/2012~~ 10/31/12

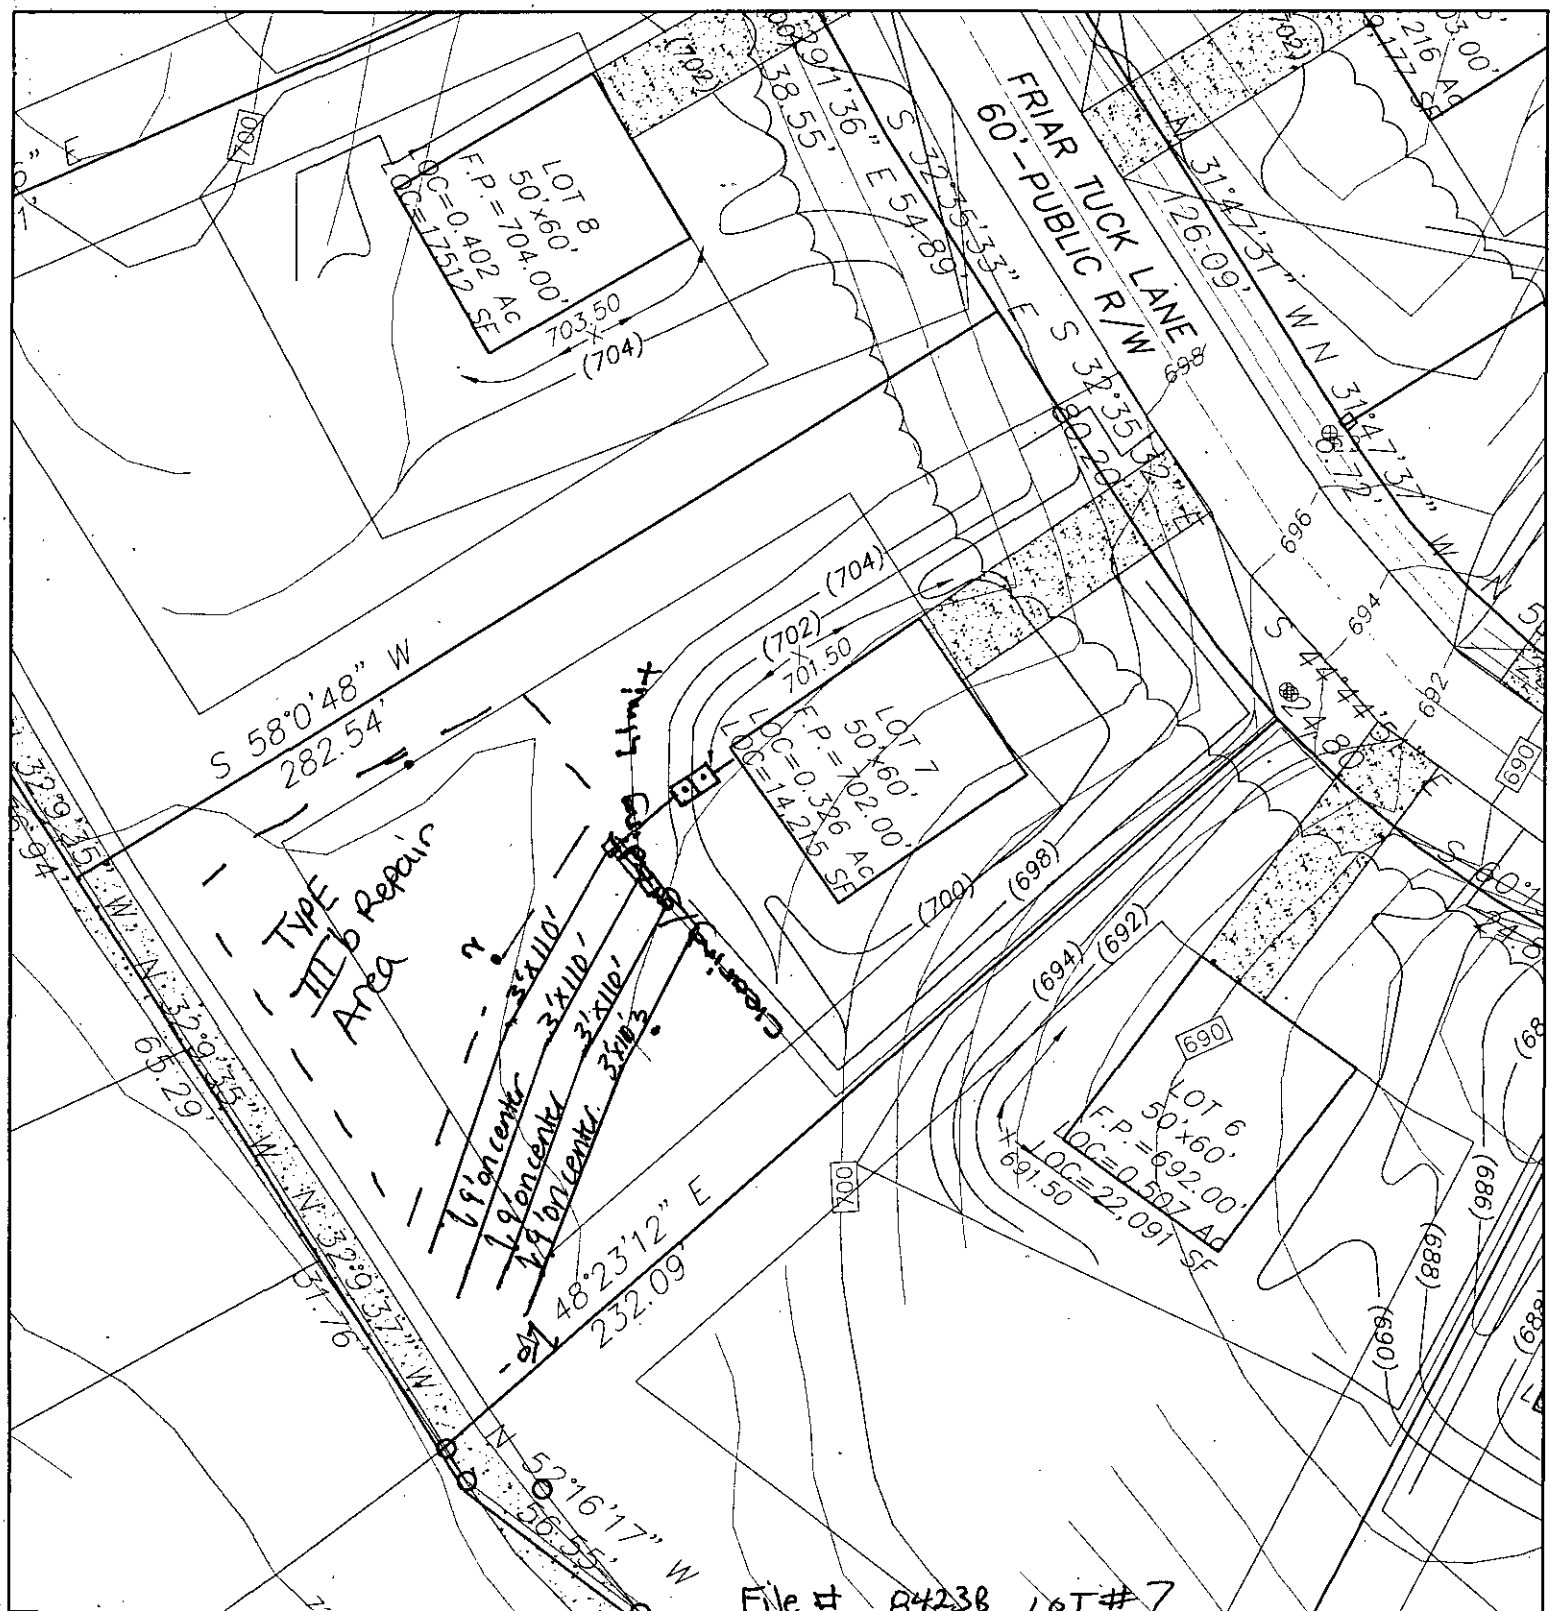

File # 84238 LOT # 7

LOT GRADING PLAN
LOT 7
SHERWOOD FOREST SUBDIVISION
MINT HILL, NORTH CAROLINA
CAROLINA DEVELOPMENT SOLUTIONS, LLC
1932 CLARK ELLIOT STREET
FORT MILL, SOUTH CAROLINA 29708
SCALE 1"=50'

4 BR Residence 480 GPD
0.275 LTAR
Install 440 L.F. of TYPE IIIg 25% Reduction
1500 GAL SEPTIC TANK
D-Box / Feed Lines eaual'ton contour of land level
* 24" Max Trech Depth
Maintain 50 ft min off well.

GRAPHIC SCALE
50 25 0 50

summit landservices
P.O. BOX 7442
CHARLOTTE, NC 28241
OFFICE: 704.506.0554
FAX: 704.504.1125
WWW.SUMMIT-COMPANIES.COM

Jeremy Michael REHS 03/06/2012

8423B

MECKLENBURG COUNTY HEALTH DEPARTMENT 5410

APPLICATION FOR A RESIDENTIAL SITE IMPROVEMENT PERMIT/ CONSTRUCTION AUTHORIZATION FOR AN ON-SITE WASTEWATER SYSTEM, NEW WELL INSTALLATION, OR REPAIR OF EXISTING WELL

1. **SEPTIC / TYPE APPLICATION:** ○ N/A ● NEW SYSTEM ○ ALTERATION ○ REPAIR ○ MODIFIED PLOT PLAN

2. **WELL / TYPE APPLICATION:** ○ N/A ● NEW WELL ○ MAJOR REPAIR ○ ABANDONMENT

3. **JOB LOCATION INFORMATION:**

TAX PARCEL NUMBER: 13927607
STREET ADDRESS: 7205 Friar Tuck LN
CITY: Mint Hill
STATE: NC ZIP: 28227
SUBDIVISION NAME: Sherwood Forest
LOT #: 7 LOT SIZE (acres): 1.009
TOWNSHIP:
○ MECKLENBURG ○ CORNELIUS ○ HUNTERSVILLE
○ DAVIDSON ○ CHARLOTTE ○ PINEVILLE
○ MATTHEWS ● MINT HILL

4. **BUILDING INFORMATION:**

BUILDING TYPE:
○ SINGLE MOBILE HOME ○ MODULAR HOME
○ DOUBLE WIDE ○ MULTIPLE FAMILY
● HOUSE ○ OTHER _____
HEATED SQUARE FOOTAGE: 3200
NUMBER OF BEDROOMS: 4
NUMBER OF OCCUPANTS: 5
FOUNDATION TYPE:
● CONCRETE SLAB ○ BASEMENT WITH PLUMBING
○ CRAWL SPACE ○ BASEMENT WITH NO PLUMBING

5. **IF PLANNING TO EXPAND OR ALTER THE EXISTING SEPTIC SYSTEM PLEASE COMPLETE THE FOLLOWING SECTION:** ☒ N/A

NUMBER OF BEDROOMS TO BE ADDED: _____ NUMBER OF ADDITIONAL OCCUPANTS IN THE RESIDENCE: _____

6. **WATER SUPPLY:** ○ MUNICIPAL ● PRIVATE WELL ○ PUBLIC WELL ○ SHARED WELL ○ OTHER _____

7. **PROPOSED USE OF WELL:** ○ N/A ○ IRRIGATION ● POTABLE (DRINKING WATER) ○ OTHER _____

8. **PLEASE INDICATE AND RANK DESIRED SEPTIC SYSTEM TYPE(S) IN ORDER OF PREFERENCE** *(1-MOST DESIRED 5-LEAST DESIRED):*

☐ N/A ☒ ANY TYPE ☐ CONVENTIONAL ☐ ACCEPTED ☐ INNOVATIVE ☐ ALTERNATIVE ☐ OTHER _____

8A. **RANK:** ____ ____ ____ ____ ____

9. **DO ANY OF THE FOLLOWING APPLY TO THE PROPERTY IN QUESTION? IF "YES" PLEASE ATTACH SUPPORTING DOCUMENTATION.**

BURIED CABLES, LANDFILLS, STUMPHOLES	○ YES ● NO	GRADING/SOIL REMOVAL PERFORMED	○ YES ● NO
EXISTING WASTEWATER (SEPTIC) SYSTEMS	○ YES ● NO	JURISDICTIONAL WETLANDS	○ YES ● NO
WELLS, SPRINGS, OR WATER LINES	○ YES ● NO	APPROVAL REQUIRED BY ANY OTHER PUBLIC AGENCY	○ YES ● NO
EASEMENTS OR RIGHT-OF-WAYS	● YES ○ NO	WASTEWATER OTHER THAN DOMESTIC SEWAGE	○ YES ● NO
CHEMICAL/PETROLEUM STORAGE TANKS	○ YES ● NO	KNOWN UNDERGROUND CONTAMINATION	○ YES ● NO
WASTE STORAGE	○ YES ● NO	GROUNDWATER USE RESTRICTIONS/VARIANCES	○ YES ● NO

10. **WHAT DATE WAS THE PROPERTY ORIGINALLY DEEDED AND RECORDED?** _____ ☒ UNKNOWN

11. **WHAT IS THE ANTICIPATED CLOSING DATE FOR THIS PROPERTY?** 5/1/2012 ☐ N/A

12. **PROPERTY OWNER:**

NAME: B&C Land Holdings
ADDRESS: 2649 Brekonridge Center Dr
CITY: Monroe
STATE: NC ZIP: 28110
WORK PHONE: _____
MOBILE PHONE: 803-389-3387
FAX: 800-980-4077
E-MAIL: Stwiddy.cds@gmail.com

13. **OWNER'S LEGAL REPRESENTATIVE, IF APPLICABLE:**

NAME: Scott Twiddy
ADDRESS: 1932 Clark Elliott St
CITY: Fort Mill
STATE: SC ZIP: 29708
WORK PHONE: _____
MOBILE PHONE: 803-389-3387
FAX: 800-980-4077
E-MAIL: Stwiddy.cds@gmail.com

MECKLENBURG COUNTY – GROUNDWATER & WASTEWATER SERVICES
700 N. TRYON ST. SUITE 211 CHARLOTTE, NC 28202, OFFICE: 704-336-5103, FAX: 704-336-6894

Revised on: 12/15/10

14. SEPTIC SYSTEM PERMIT APPLICATION:

If the information in this application is falsified, changed, or the site is altered, then the Improvement Permit and Authorization to Construct shall become invalid. I have read this application and certify that the information provided herein is true, complete and correct. Authorized county and state officials are granted right of entry to conduct necessary inspections to determine compliance with applicable laws and rules. I understand that I am solely responsible for the proper identification and labeling of all property lines and corners and making the site accessible so that a complete site evaluation can be performed. The permit is valid for either sixty (60) months or is non-expiring depending upon the documentation submitted: complete site plan = 60 months, complete plat = non-expiring.

SS (Initial here for septic system applications)

15. WELL PERMIT APPLICATION:

If the information in this application is falsified, changed, or the site is altered, then the Well Permit shall become invalid. I have read this application and certify that the information provided herein is true, complete and correct. Authorized county and state officials are granted right of entry to conduct necessary inspections to determine compliance with applicable laws and rules. I understand that I am solely responsible for the proper identification and labeling of all property lines and corners and making the site accessible so that a complete site evaluation can be performed. The permit is valid for a period of twelve (12) months from the date of issuance.

_____ (Initial here for well applications)

16. APPLICATION SIGNATURE SECTION:

ONLY COMPLETE APPLICATIONS WILL BE PROCESSED. A proper signature is required in order to process your application. Please review the application carefully and sign in the space provided below. A PROPOSED PLOT PLAN is required to be submitted with each application.

Scott Priddy
Property Owner's or Owner's Legal Representative Signature

1/30/2012
Date

OFFICE USE ONLY

O SURVEY PLAT TO SCALE SUBMITTED O SCALED SITE PLAN SUBMITTED O UN-SCALED SITE PLAN SUBMITTED

SEPTIC APPLICATION FEE RECEIVED: $ 250.00 DATE FEE RECEIVED: 1/30/12

WELL APPLICATION FEE RECEIVED: $ _____ DATE FEE RECEIVED: _____


APPLICATION PROCESSED BY: lws

GWS FILE NUMBER ASSIGNED: 8423B

APPLICATION ID NUMBER ASSIGNED: 5410

COMMENTS:

MECKLENBURG COUNTY – GROUNDWATER & WASTEWATER SERVICES
700 N. TRYON ST. SUITE 211 CHARLOTTE, NC 28202, OFFICE: 704-336-5103, FAX: 704-336-6894

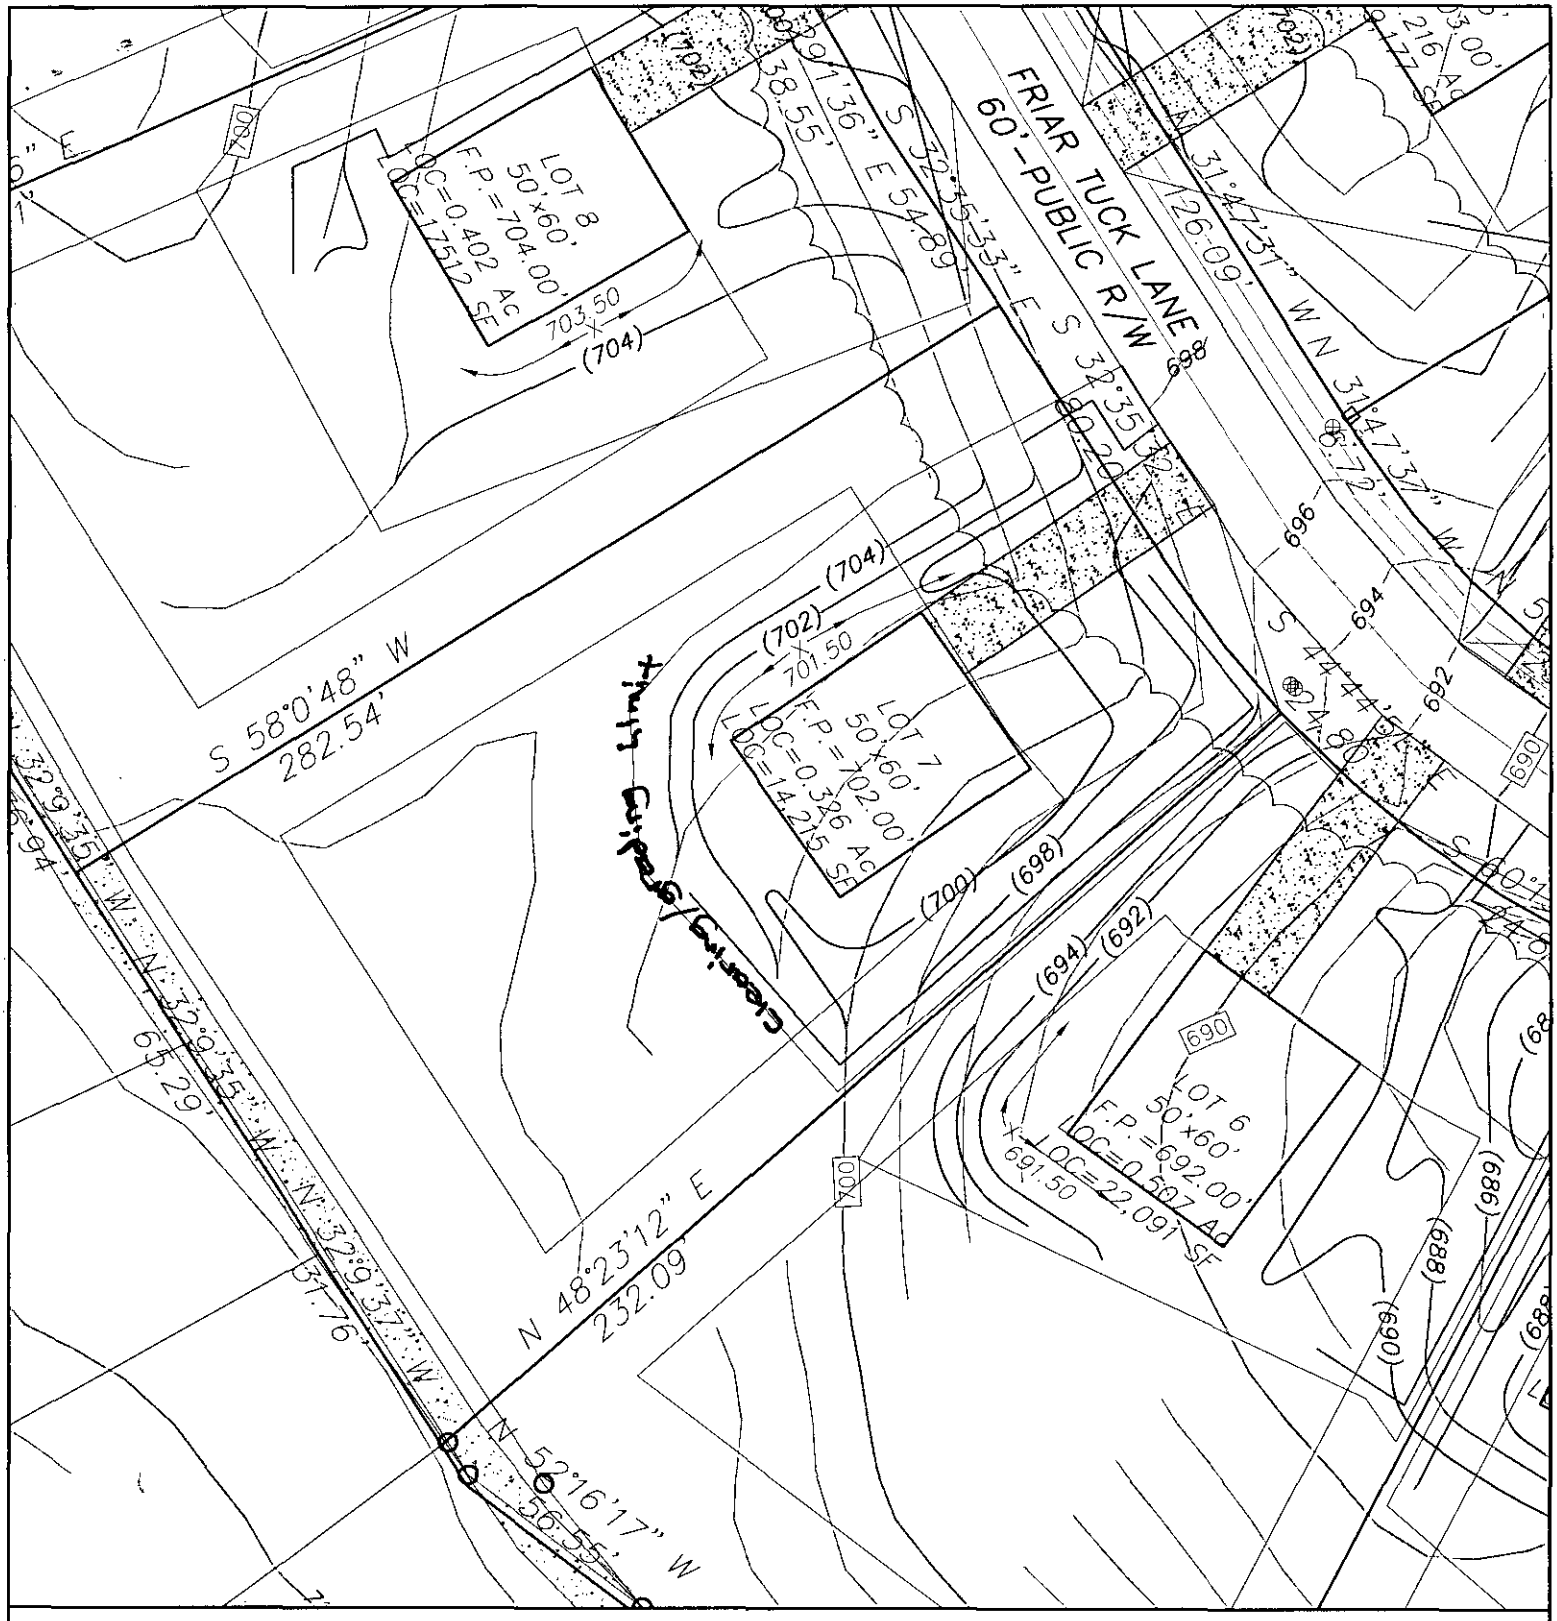

LOT GRADING PLAN
LOT 7
SHERWOOD FOREST SUBDIVISION
MINT HILL, NORTH CAROLINA
CAROLINA DEVELOPMENT SOLUTIONS, LLC
1932 CLARK ELLIOT STREET
FORT MILL, SOUTH CAROLINA 29708
SCALE 1"=50'

GRAPHIC SCALE

50 25 0 50

summit
londservices
P.O. BOX 7442
CHARLOTTE, NC 28241
OFFICE: 704.506.0554
FAX: 704.504.1125
WWW.SUMMIT-COMPANIES.COM

Department of Environment, Health, and Natural Resources
Division of Environmental Health
On-site Wastewater Section

Sheet: 1 of 2
Property ID: 139-276-07
Lot #: 7
File #: 8423B
AppID: 5410

SOIL/SITE EVALUATION
for ON-SITE WASTEWATER SYSTEM

Owner: B&C Land Holdings
Applicant: Scott Twiddy
Address: 2649 Brekonridge Centre Dr. Monroe, NC 28110
Date Evaluated: 5/3/2012
Proposed Facility: Residence
Design Flow (.1949): 480 GPD
Property Size: 1.009 a.c.
Location of Site: 7205 Friar Tuck Ln. Mint Hill, NC 28227
Property Recorded: N/A
Water Supply: [ ] Public [X] Individual [X] Well [ ] Spring [ ] Other
Evaluation Method: [X] Auger Boring [X] Pit [ ] Cut
Type of Wastewater: [X] Sewage [ ] Industrial Process [ ] Mixed

PROFILE #	1940 Landscape Position/ Slope%	Horizon Depth (IN.)	SOIL MORPHOLOGY 1941 Structure/ Texture	SOIL MORPHOLOGY 1941 Consistence Mineralogy	b PROFILE FACTORS 1942 Soil Wetness/ Color	1943 Soil Depth (IN.)	1956 Sapro Class	1944 Restr Horiz	Profile Class & LTAR
Pit 1	LS 2%	0-8	SBK/SCL	SS/SP/FRI/SEXP		54"			PS, IV 0.3 GPD/FT^2
		8-54	SBK-ABK/C	S/P/FI/SEXP					
Pit 2	LS 2%	0-8	SBK/SCL	SS/SP/FRI/SEXP	Chroma 2 @ 36"	36"			PS, IV 0.275 GPD/FT^2
		8-36	ABK/C	S/P/FI/SEXP					
AB 3	LS 2%	0-8	SBK/SCL	SS/SP/FRI/SEXP		48"			PS, IV 0.275 GPD/FT^2
		8-48	SBK/C	S/P/FI/SEXP					

Description	Initial System	Repair System
Available Space (.1945)	PS	PS
System Type(s)	IIIg	IIIg
Site LTAR	0.275	0.275

Other Factors (.1946):
Soil Evaluation By: Jeremy Michael
Others Present: Jeremy Michael REHS.
Site Classification (.1948): PS
Site Evaluation By: Jeremy Michael
Others Present:

COMMENTS:

Landscape Position	Group	Texture	.1955 LTAR	Structure
R-Ridge	I	S-Sand	1.2 - 0.8	SG-Single Grain
SS-Shoulder Slope		LS-Loamy Sand		M-Massive
LS-Linear Slope				CR-Crumb
FS-Foot Slope	II	SL-Sandy Loam	0.8 - 0.6	GR-Granular
NS-Nose Slope		L-Loam		SBK-Subangular Blocky
HS-Head Slope				ABK-Angular Blocky
CC-Concave Slope	III	SI-Silt	0.6 - 0.3	PL-Platy
CV-Convex Slope		SICL-Silty Clay Loam		PR-Prismatic
T-Terrace				
FP-Flood Plain		CL-Clay Loam		
		SCL-Sandy Clay Loam		
	IV	SC-Sandy Clay	0.4 - 0.1	
		SIC-Silty Clay		
		C-Clay		

Consistence Moist	Consistence Wet	Mineralogy
VFR-Very Friable	NS-Non-Sticky	SEXP-Slightly Expansive
FR-Friable	SS-Slightly Sticky	EXP-Expansive
FI-Firm	S-Sticky	
VFI-Very Firm	VS-Very Sticky	
EFI-Extremely Firm	NP-Non-Plastic	
	SP-Slightly Plastic	
	P-Plastic	
	VP-Very Plastic	

Sketch of Soil Evaluation Locations

