SUPERVISOR/ADMINISTRATIVE PROFESSIONAL CHECKLIST

NEW SEPTIC ☐ NEW WELL ☐ USE EXISTING ☐ MODIFIED PLOT PLAN ☐

New Septic Fees Paid

IP ($250.00) _____ Initial/Date

CA ($200.00) _____Initial/Date

OP ($200.00) _____Initial/Date

(CA and OP fees need to be paid before a building permit can be issued)

New Well Fees Paid: $550.00 _____ Initial/Date

Use Existing Fees Paid: $100.00 _____Initial/Date

Alteration Fees Paid: $300 Total $200 3/15/22 LE Initial/Date (If use existing was part of payment)

Modified Plot Plan Fees Paid: $100.00 _____Initial/Date

Floor plans need to be submitted and reviewed before CA can be issued ☐ Review ☐

This site is served by septic and well. Verify each is complete before final hold is released ☐

Septic file complete ☒ 3/6/23 Well complete ☐ _____

Send permit for signature ☐ Signature received ☐ _____

This septic system requires a certified operation contract before final hold is released ☐

Certified operator contract is on file ☐ _____

MECKLENBURG COUNTY
HEALTH DEPARTMENT

1855A #12954

APPLICATION FOR A RESIDENTIAL SITE IMPROVEMENT PERMIT/ CONSTRUCTION AUTHORIZATION FOR AN ON-SITE WASTEWATER SYSTEM, NEW WELL INSTALLATION, OR REPAIR OF EXISTING WELL

1. SEPTIC / TYPE APPLICATION: ○ N/A ○ NEW SYSTEM ◉ ALTERATION ○ REPAIR ○ MODIFIED PLOT PLAN

2. WELL / TYPE APPLICATION: ◉ N/A ○ NEW WELL ○ MAJOR REPAIR ○ ABANDONMENT

3. JOB LOCATION INFORMATION:

TAX PARCEL NUMBER: 19714124
STREET ADDRESS: 10941 Tara Oaks Dr.
CITY: Charlotte
STATE: NC ZIP: 28227
SUBDIVISION NAME:
LOT #: 11 LOT SIZE (acres): 5.49
TOWNSHIP:
○ MECKLENBURG ○ CORNELIUS ○ HUNTERSVILLE
○ DAVIDSON ○ CHARLOTTE ○ PINEVILLE
○ MATTHEWS ◉ MINT HILL

4. BUILDING INFORMATION:

BUILDING TYPE:
○ SINGLE MOBILE HOME ○ MODULAR HOME
○ DOUBLE WIDE ○ MULTIPLE FAMILY
◉ HOUSE ○ OTHER
HEATED SQUARE FOOTAGE: 4,990
NUMBER OF BEDROOMS: 4
NUMBER OF OCCUPANTS: 2
FOUNDATION TYPE:
○ CONCRETE SLAB ○ BASEMENT WITH PLUMBING
◉ CRAWL SPACE ○ BASEMENT WITH NO PLUMBING

5. IF PLANNING TO EXPAND OR ALTER THE EXISTING SEPTIC SYSTEM PLEASE COMPLETE THE FOLLOWING SECTION: ☐ N/A

NUMBER OF BEDROOMS TO BE ADDED: 0 NUMBER OF ADDITIONAL OCCUPANTS IN THE RESIDENCE: 0

6. WATER SUPPLY: ○ MUNICIPAL ◉ PRIVATE WELL ○ PUBLIC WELL ○ SHARED WELL ○ OTHER

7. PROPOSED USE OF WELL: ◉ N/A ○ IRRIGATION ○ POTABLE (DRINKING WATER) ○ OTHER

8. PLEASE INDICATE AND RANK DESIRED SEPTIC SYSTEM TYPE(S) IN ORDER OF PREFERENCE *(1-MOST DESIRED 5-LEAST DESIRED)*:

☐ N/A ☐ ANY TYPE ☑ CONVENTIONAL ☐ ACCEPTED ☐ INNOVATIVE ☐ ALTERNATIVE ☑ OTHER Pump Required

8A. RANK: ____ ____ ____ ____ ____

9. DO ANY OF THE FOLLOWING APPLY TO THE PROPERTY IN QUESTION? IF "YES" PLEASE ATTACH SUPPORTING DOCUMENTATION.

BURIED CABLES, LANDFILLS, STUMPHOLES	○ YES ◉ NO	GRADING/SOIL REMOVAL PERFORMED	○ YES ◉ NO
EXISTING WASTEWATER (SEPTIC) SYSTEMS	◉ YES ○ NO	JURISDICTIONAL WETLANDS	○ YES ◉ NO
WELLS, SPRINGS, OR WATER LINES	○ YES ◉ NO	APPROVAL REQUIRED BY ANY OTHER PUBLIC AGENCY	○ YES ◉ NO
EASEMENTS OR RIGHT-OF-WAYS	◉ YES ○ NO	WASTEWATER OTHER THAN DOMESTIC SEWAGE	○ YES ◉ NO
CHEMICAL/PETROLEUM STORAGE TANKS	○ YES ○ NO	KNOWN UNDERGROUND CONTAMINATION	○ YES ◉ NO
WASTE STORAGE	○ YES ◉ NO	GROUNDWATER USE RESTRICTIONS/VARIANCES	○ YES ◉ NO

10. WHAT DATE WAS THE PROPERTY ORIGINALLY DEEDED AND RECORDED? _____ ☑ UNKNOWN

11. WHAT IS THE ANTICIPATED CLOSING DATE FOR THIS PROPERTY? _____ ☑ N/A

12. PROPERTY OWNER:

NAME: Daniela R. Hawkins & Christopher A. Hawkins
ADDRESS: 10941 Tara Oaks Dr
CITY: Charlotte
STATE: NC ZIP: 28227
WORK PHONE: (703) 402-9870
MOBILE PHONE: (703) 402-9870
FAX:
E-MAIL: daniela.r.hawkins@gmail.com

13. OWNER'S LEGAL REPRESENTATIVE, IF APPLICABLE:

**Owner's Authorization form is required if legal representative is submitting application*

NAME:
ADDRESS:
CITY:
STATE: ZIP:
WORK PHONE:
MOBILE PHONE:
FAX:
E-MAIL:

MECKLENBURG COUNTY – GROUNDWATER & WASTEWATER SERVICES
3205 Freedom Dr. Suite 8000, Charlotte, NC 28208 OFFICE: (980) 314-1680, FAX: 704-336-6894

Revised on: 03/27/19

14. SEPTIC SYSTEM PERMIT APPLICATION:

If the information in this application is falsified, changed, or the site is altered, then the Improvement Permit and Authorization to Construct shall become invalid. I have read this application and certify that the information provided herein is true, complete and correct. Authorized county and state officials are granted right of entry to conduct necessary inspections to determine compliance with applicable laws and rules. I understand that I am solely responsible for the proper identification and labeling of all property lines and corners and making the site accessible so that a complete site evaluation can be performed. The permit is valid for either sixty (60) months or is non-expiring depending upon the documentation submitted: complete site plan = 60 months, complete plat = non-expiring.

_____ (Initial here for septic system applications)

15. WELL PERMIT APPLICATION:

If the information in this application is falsified, changed, or the site is altered, then the Well Permit shall become invalid. I have read this application and certify that the information provided herein is true, complete and correct. Authorized county and state officials are granted right of entry to conduct necessary inspections to determine compliance with applicable laws and rules. I understand that I am solely responsible for the proper identification and labeling of all property lines and corners and making the site accessible so that a complete site evaluation can be performed. The permit is valid for a period of twelve (12) months from the date of issuance.

_____ (Initial here for well applications)

16. APPLICATION SIGNATURE SECTION:

ONLY COMPLETE APPLICATIONS WILL BE PROCESSED. A proper signature is required in order to process your application. Please review the application carefully and sign in the space provided below. A PROPOSED PLOT PLAN is required to be submitted with each application.

_____ 3/15/2022

Property Owner's or Owner's Legal Representative Signature — Date

---

OFFICE USE ONLY

○ SURVEY PLAT TO SCALE SUBMITTED ○ SCALED SITE PLAN SUBMITTED ○ UN-SCALED SITE PLAN SUBMITTED

SEPTIC APPLICATION FEE RECEIVED: $ _____ DATE FEE RECEIVED: _____

WELL APPLICATION FEE RECEIVED: $ _____ DATE FEE RECEIVED: _____

APPLICATION PROCESSED BY: _____

GWS FILE NUMBER ASSIGNED: _____

APPLICATION ID NUMBER ASSIGNED: _____

COMMENTS:

_____

_____

_____

_____

_____

_____

_____

_____

_____

_____

File #: _____

PROPOSED PLOT PLAN


A drawing showing the locations of the following items is required: existing and proposed property lines with dimensions, easements or right-of-ways, proposed building pad(s) or existing building footprint(s), all appurtenances (garage, driveway, deck, pool, etc.), location of existing or proposed well(s), location of existing or proposed sewer lines and sewage disposal systems, surface water bodies, and any aboveground or underground storage tanks. Provide names for all roads that adjoin the property.

Street Address: 10941 Tara Oaks Dr., Charlotte, NC 28227

Tax Parcel #: 19714124

Subdivision Name: _____

Lot #: 11

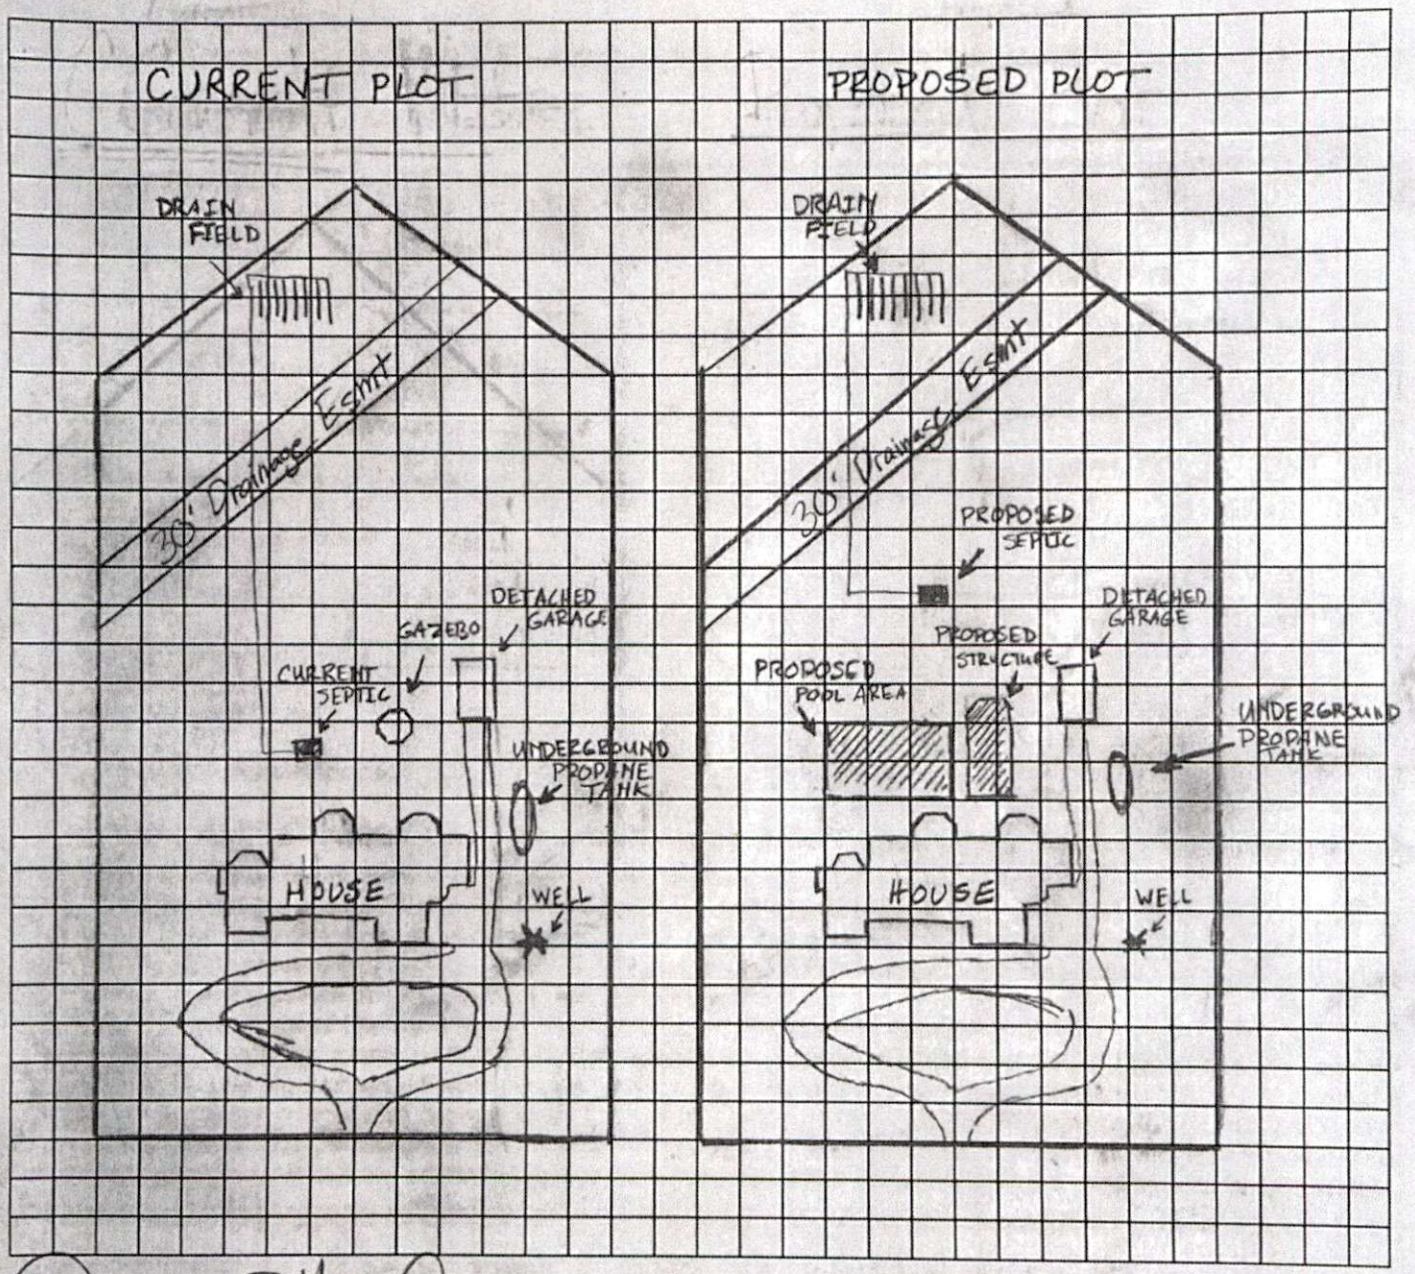

Property Owner's or Owner's Legal Representative Signature

3/15/2022
Date

CERTIFICATE OF COMPLETION/OPERATION PERMIT

HEALTH DEPARTMENT
ENVIRONMENTAL HEALTH DIVISION
700 NORTH TRYON ST., SUITE 211
CHARLOTTE, NC 28202
PHONE (704) 336-5102

FILE: 1855 A DATE: 7-24-98

TC: 192-141- 24 L CRT

SERIAL Nº 17677

Name of Owner ROGER ELLISON JR. Juris.:

Address of Property 10941 TARA OAKS DRIVE

Inspection Data:

Tank Material PCC 1500 GAL

Total Length of Drainfield 400

Number of Lines 4 @ 100

Cover Depth 12"

Water Supply Source WELL


Distance to Water Source 150'

Excavation Inspected 7-24-98

Tank(s) Inspected 7-24-98

Wash Line Inspected NA

High Water Alarm Inspected 7-24-98

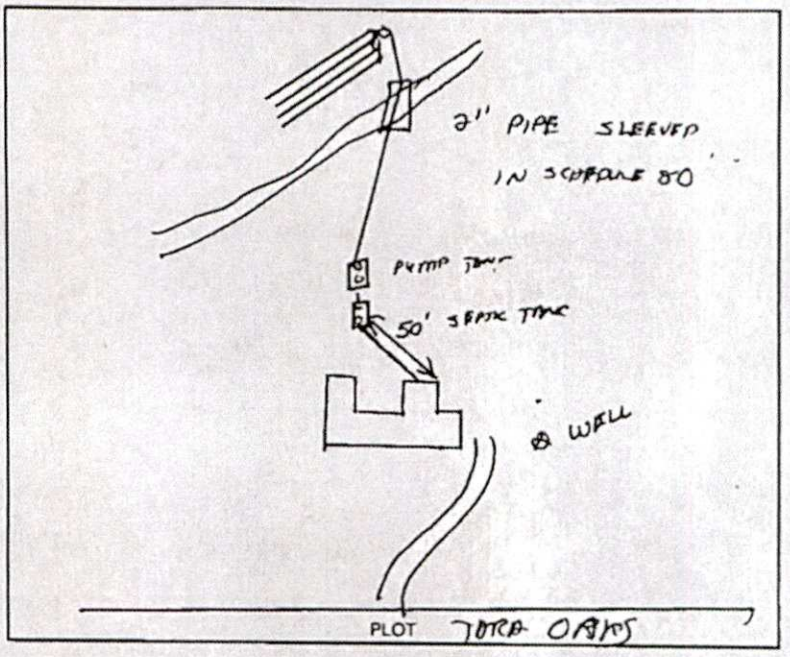

Design 1500ST 1000 DT P1 M00 1200 SFT 12G CRL CTR# W.T. NORWOOD

The undersigned has inspected the Septic Tank System described above, and certifies it has been

☐ installed or constructed ☐ altered or repaired

☐ in accordance with the permit issued ☐ as detailed in the plot above

and meets the provisions of 15A NCAC 18A. 1900, "Laws And Rules For Sewage Treatment and Disposal Systems" in effect on the date of issuance of the permit. This issuance of this

☐ Certificate of Completion ☑ Operation Permit


does not in any way guarantee that the system will operate properly or relieve any person now or hereafter owning, controlling, or using such system from any liability resulting from the failure of the system to operate properly. This document is issued subject to those restrictions and conditions shown on the permit(s) and the provisions of 15A NCAC 18A. 1990 in addition to those listed below under "COMMENTS." This document shall be null and void if any information contained in the application is untrue or if any additions are made to the property which would increase the requirements for said system.

Notice: Disturbance of the designated repair area may result in the suspension/revocation of this permit.

COMMENTS: (1) TANKS WERE PLACED 50' FROM HOUSE DUE TO MASSIVE ROCK FORMATION ADJACENT TO HOUSE. (2) SYSTEM IS TYPE III B W/ TYPE III REPAIR

J Andrew Walker RS
Environmental Health Specialist

Mecklenburg County services are available without regard to ethnic origin, sex, or disability.

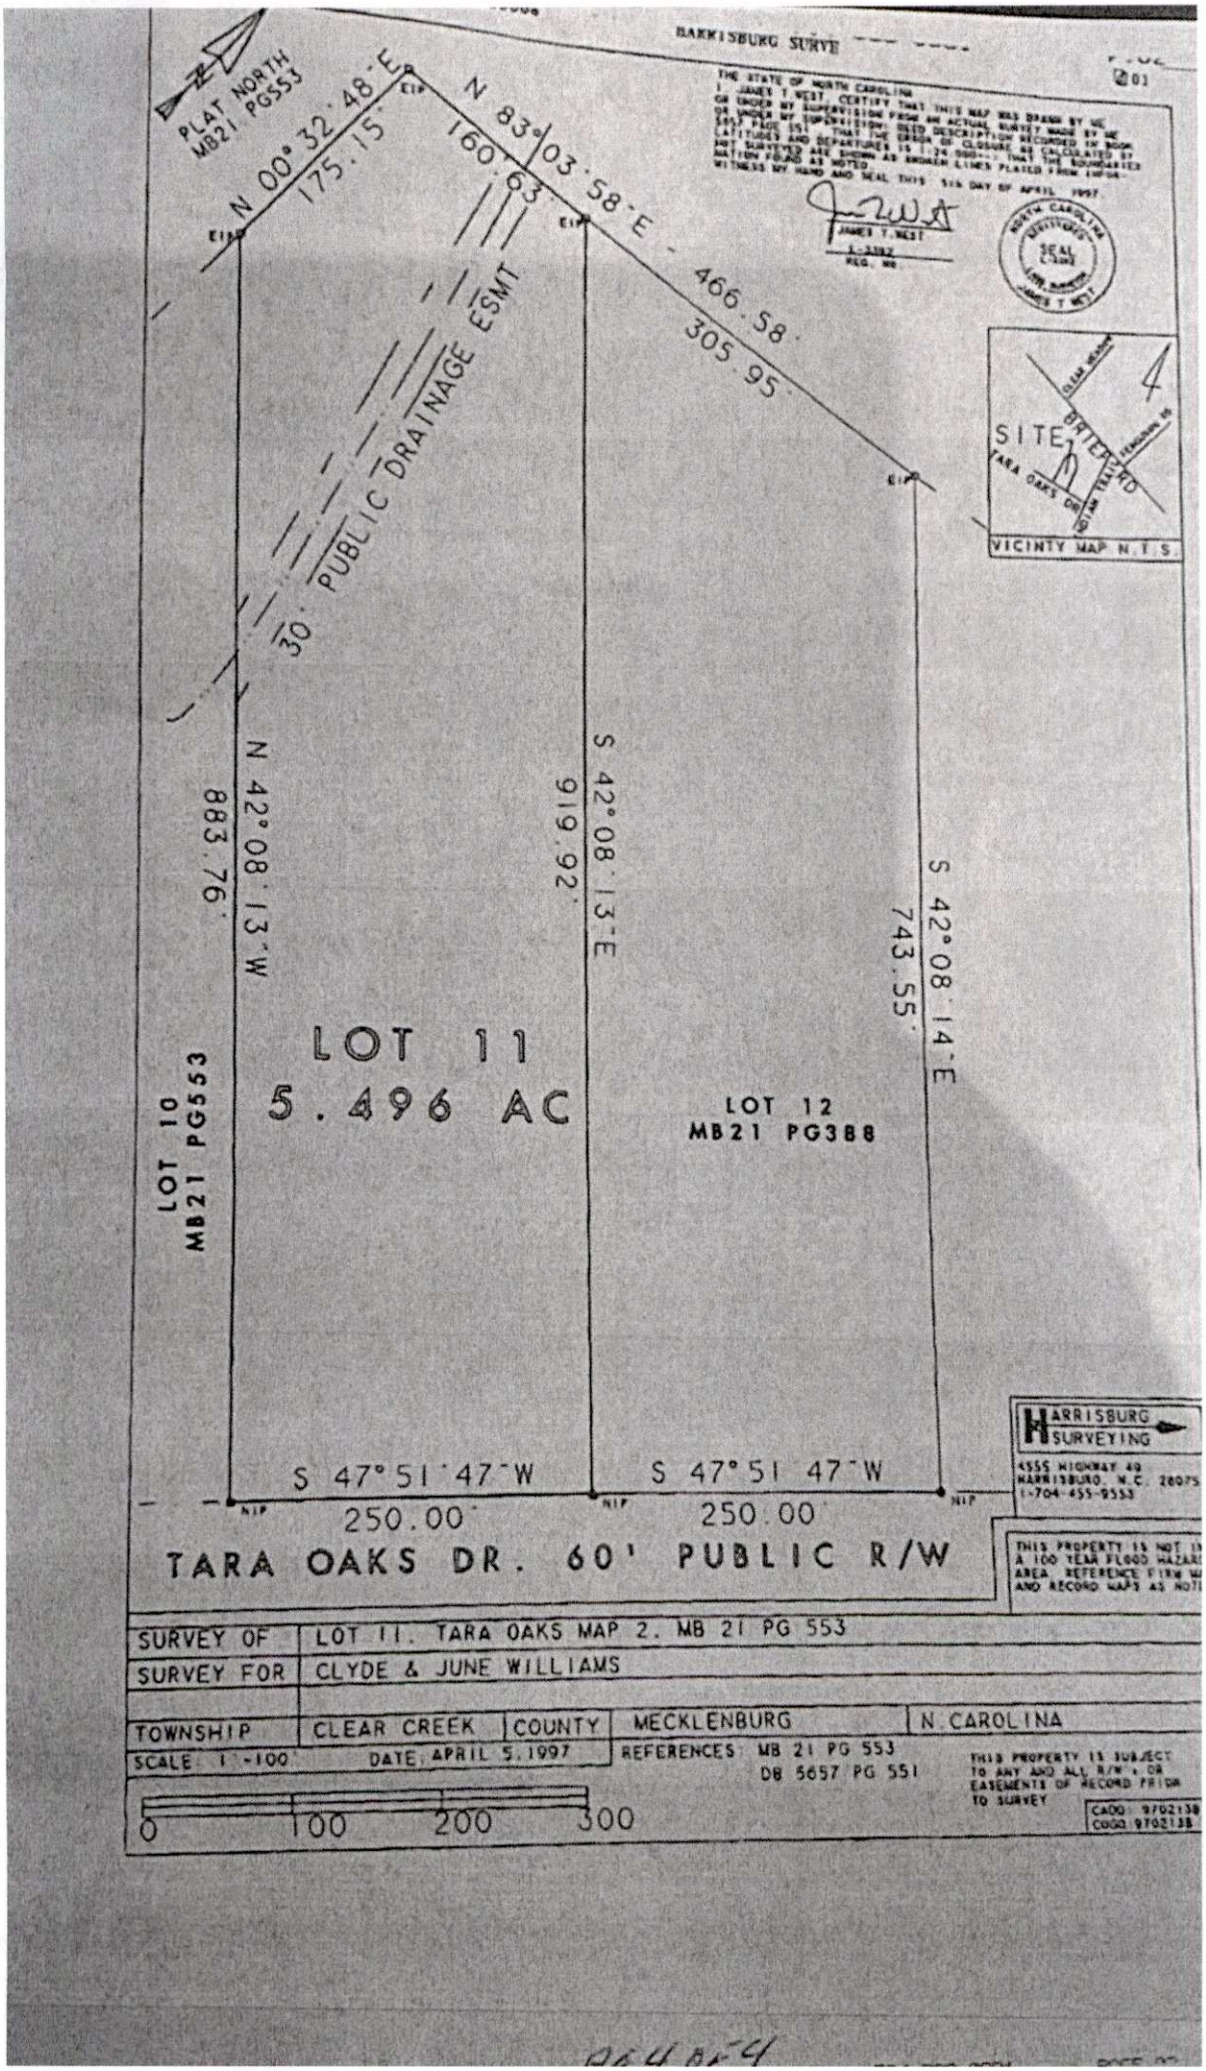

SURVEY OF	LOT 11. TARA OAKS MAP 2. MB 21 PG 553				
SURVEY FOR	CLYDE & JUNE WILLIAMS				
TOWNSHIP	CLEAR CREEK	COUNTY	MECKLENBURG		N. CAROLINA
SCALE 1"=100'	DATE APRIL 5, 1997	REFERENCES	MB 21 PG 553 DB 5657 PG 551	THIS PROPERTY IS SUBJECT TO ANY AND ALL R/W + OR EASEMENTS OF RECORD PRIOR TO SURVEY	

0 100 200 300

CADD: 9702138
COGO: 9702138

THIS PROPERTY IS NOT IN A 100 YEAR FLOOD HAZARD AREA. REFERENCE FIRM MAP AND RECORD MAPS AS NOTED

R6481-4

MECKLENBURG COUNTY
LAND USE AND ENVIRONMENTAL SERVICES
Payment Receipt

Receipt Information

Date: 03/15/22
Receipt #: 134720
Check / Auth #: VISA 00549D
Received By: ELLISLW

Amount: 300.00
Tendered: 300.00
Returned: 0.00

Account Information

Account #: 200000
Contractor: HAWKINS, DANIELA
Attn:
Address:
Address:
City/State/Zip: ,

Item	Description	Permit#	Quantity	Unit Price	Total Price
0706	Septic Alteration Permit 10941 TARA OAKS DR		1	300.00	300.00

----------Outstanding Balances----------

Month-To-Date	Prior Month	30 Days	60 Days	90 Days	Balance

Mecklenburg County Groundwater & Wastewater Services
3205 Freedom Dr., Suite 8000 Charlotte, NC 28208
Phone: (980) 314-1680 Fax: (704) 336-6894

NC DHHS
Division of Environmental Health
On-Site Wastewater Section

IMPROVEMENT PERMIT for a RESIDENTIAL
ON-SITE WASTEWATER TREATMENT & DISPOSAL SYSTEM

Permit #: **30012954** GWS File #: **1855A** Tax Parcel #: **197-141-24**

- This IMPROVEMENT PERMIT is subject to revocation if site plans or the intended use change. There is to be **NO** grading, filling, or disturbance of the soil in the area of the septic tank system or repair area.
- CONSTRUCTION AUTHORIZATION must be obtained prior to receiving a Building Permit. Do not clear, grade, fill or disturb soil prior to obtaining a Construction Authorization.
- Domestic-type wastewater only. No industrial process wastewater may be discharged into the system.

I. This Improvement Permit Shall: Expire in Five (5) Years **Expiration Date (If Applicable):** 7/28/2027

Type of Installation: Residential - Alteration Lot Number: 11

Structure Type: HOUSE Size (ft^2): 4990 # Bedrooms: 4 Max. Occup.: 8

Building Foundation: Crawl Space Water Supply: Private Well

II. Initial System Type: Accepted **System Classification:** IIIb

Initial System Specifications:

Design Flow (gpd): 480 LTAR (gpd/ft^2): .3 Septic Tank Size (gal): 1000 Pump Tank Size (gal): 1000

Trench Width (ft): ~~3~~ Trench Spacing (ft): ~~9~~ Absorption Area (ft^2): ~~1600~~ Total Trench Length (ft): ~~533~~

Maximum Trench Depth (in): 30 Depth of Media (in): 12 Distribution Device: N/A

III. Repair System Type: Accepted **System Classification:** IIIb

Repair System Specifications:

Design Flow (gpd): 480 LTAR (gpd/ft^2): .3 Septic Tank Size (gal): 1000 Pump Tank Size (gal): 1000

Trench Width (ft): ~~3~~ Trench Spacing (ft): ~~9~~ Absorption Area (ft^2): ~~1600~~ Total Trench Length (ft): ~~533~~

Maximum Trench Depth (in): 30 Depth of Media (in): 12 Distribution Device: N/A

IV. Permit Conditions/Comments:

(Please See the Following Page for Permit Conditions.)

The undersigned, an authorized agent of the STATE OF NORTH CAROLINA, certifies that the Department is issuing an IMPROVEMENT PERMIT for the above referenced property. This permit is being issued in accordance with the *Laws and Rules For Sewage Treatment, and Disposal Systems* and is subject to the following provisions:

- No work shall be conducted on the septic system until a Pre-Construction meeting has been completed by the Department.
- The septic system installer shall be a licensed septic contractor with the North Carolina Wastewater Contractor Inspector Certification Board.
- The permitted system shall be installed in accordance with the included PLOT PLAN.
- This IMPROVEMENT PERMIT is transferable.
- only new septic tank and pump tank 1000gal PT / 1000gal ST

Authorized Agent: Bryan Davenport Owner/Legal Agent: DANIELA R HAWKINS
Print Name

Signature: Bryan Davenport Signature: Daniela R Hawkins

Date Issued: 7/28/2022

Mecklenburg County Groundwater & Wastewater Services
3205 Freedom Dr. Suite 8000 Charlotte, NC 28208
Phone: (980) 314-1680 Fax: (704) 336-6894

NC DHHS
Division of Environmental Health
On-Site Wastewater Section

IMPROVEMENT PERMIT/CONSTRUCTION AUTHORIZATION for REPAIRING an ON-SITE WASTEWATER TREATMENT & DISPOSAL SYSTEM

File #: 1855A Permit #: 12954 Tax Parcel #: 197-141-24

Property Owner: Daniela / Christopher Hawkins

Job Location Address: 10941 Tara Oaks Dr

City: Charlotte State: NC Zip Code: 28227

Improvement Permit Issuance Date: 7/29/22 **Construction Authorization Issuance Date:** _____

Permission is hereby given to **repair** an on-site wastewater treatment & and disposal system, with subsurface soil absorption and effluent discharge, as specified herein at the described location. This approval is granted based upon the application information submitted to our office. All work shall be completed on or before _____. The system shall meet all of the construction requirements of 15A NCAC 18A. 1900 which are in effect on the date of granting this approval. An **Operation Permit** must be obtained from the Mecklenburg County Health Department before any system can be covered up or placed into service. The issuance of this permit does not in any way guarantee that the system anticipated to be constructed will operate properly, or relieve any person now of hereafter owning, controlling or using such system from any liability resulting from the failure of the system to operate properly.

Permitted Design Flow: existing GPD

Site LTAR: existing GPD/ft²

Liquid Capacity of Septic Tank: 1000 gallons

Liquid Capacity of Dosing Tank: 1000 gallons

Drainfield Design ☑ N/A

Trench Depth: _____ inches

Trench Width: _____ feet

Line Spacing: _____ feet (O.C.)

Total line length: _____ feet

# of Lines: _____ @ _____ feet

Depth of Media: _____ inches (Type) _____

Distribution Device: _____

Bed Design *(For Repair Installations ONLY.)* ☑ N/A

Bed Depth: _____ inches

Bed Width: _____ feet

Total line length: _____ feet

# of Lines: _____ @ _____ feet

Depth of Media: _____ inches (Type) _____

Distribution Device: _____

Water Supply Source

☐ Municipal ☑ Private Well ☐ Community Well


☐ Other _____

Minimum System Setbacks

Distance from Building Foundation: 60 feet

Distance from Property Line: 121 feet

Distance from Water Supply Source: 10 feet

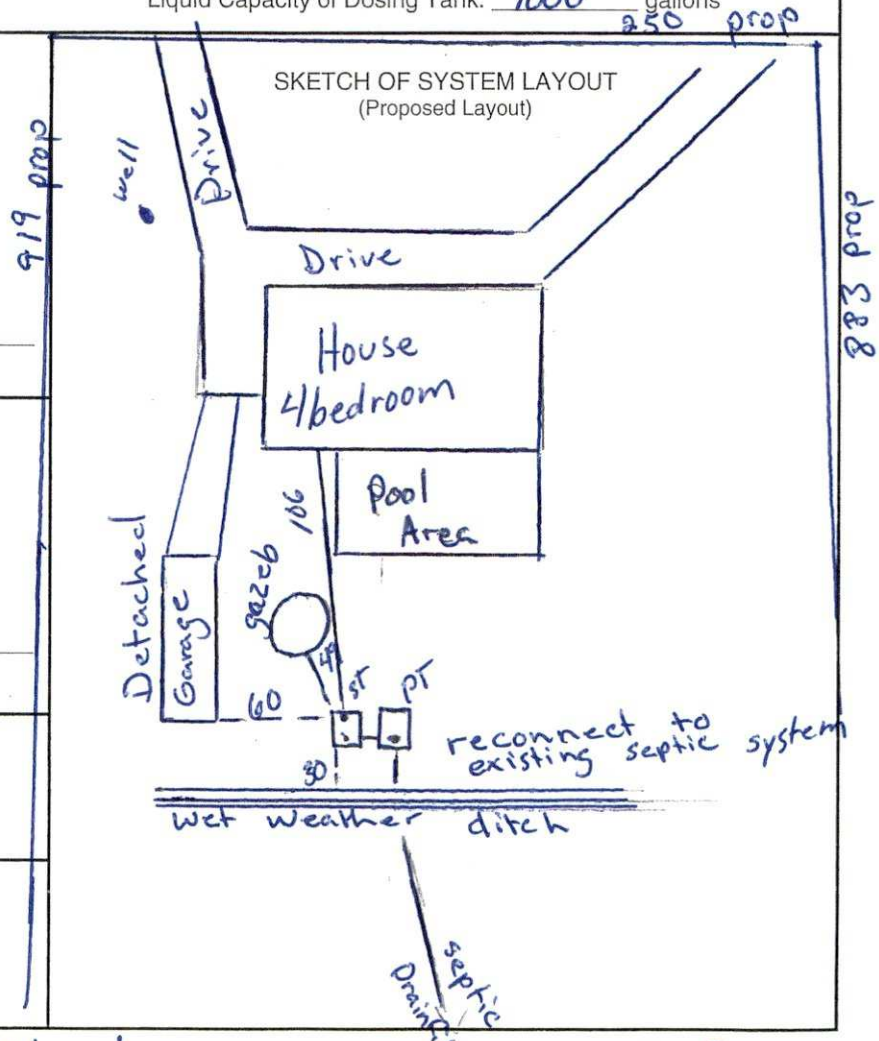

Comments: System Classification & Type: IIIb / B / NA / NA permit for 1000 gal tank and Pumptank "pressure head will have to be adjusted for 2ft of pressure"

Authorized Agent: Bryan Davenport Signature: Bryan Davenport

Owner Signature: Daniela R Hawkins Date: 7/29/2022

Mecklenburg County Groundwater & Wastewater Services
3205 Freedom Dr. Suite 8000 Charlotte, NC 28208
Phone: (980) 314-1680 Fax: (704) 336-6894

Septic System Pre-Construction Meeting Checklist

File # 1855A App# 12954 Tax Parcel# 197-141-24

Property Owner: _____

Job Location Address: 10941 Tara Oaks Dr

City: Charlotte State: NC Zip Code: 28227

1. Does System design match facility, flow & wastewater characteristics?

   ☑ YES ☐ NO

   Comments: _____

2. Is there sufficient available space for the septic systems initial and repair areas?

   ☑ YES ☐ NO

   Comments: _____

   _____

3. Can the septic system be installed per the permit conditions and drawing on file?

   ☑ YES ☐ NO

   Comments: _____

   _____

*If "NO" is checked for any of the above the existing permit may need to be revoked.

Permission is hereby given to ☑ install ☐ alter ☐ repair an on-site wastewater treatment & and disposal system, with subsurface soil absorption and effluent discharge meeting all of the construction requirements of 15A NCAC 18A .1900 which are in effect on the date of granting this approval. **System shall not be installed while soils are in wet condition.**

Bryan Davenport
Authorized Agent

8/12/22
Date

Robert Lany
Others Present

Mecklenburg County Groundwater & Wastewater Services
3205 Freedom Dr. Suite 8000, Charlotte, NC 28208
Phone: (980) 314-1680 Fax: (704) 336-6894

NC DHHS
Division of Environmental Health
On-Site Wastewater Section

OPERATION PERMIT for an ON-SITE WASTEWATER TREATMENT & DISPOSAL SYSTEM

File #: 1855A Permit #: 12954 Tax Parcel #: 197-141-24

Property Owner: _____

Job Location Address: 10941 Tara Oaks Dr

City: Charlotte State: NC Zip Code: 28227

Operation Permit Issuance Date: 8/16/22 Contractor Name: Robert Lang

Permitted Design Flow: existing GPD Liquid Capacity of Dosing Tank: 1000 gallons

Liquid Capacity of Septic Tank: ~~ex~~ 1000 gallons Tank Manufacture D/S Effluent Pump Model: _____

ST-STB 97 NC 6-1-22 PT-71-NC 7-5-22

Drainfield Installation ☑ N/A

Trench Depth: _____ inches

Trench Width: _____ feet

Line Spacing: _____ feet (O.C.)

Total line length: _____ feet

# of Lines: _____ @ _____ feet

Depth of Media: _____ inches (Type) _____

Depth of Cover: _____ inches

Distribution Device: _____

Bed Installation *(For Repair Installations ONLY.)* ☑ N/A

Bed Depth: _____ inches

Bed Width: _____ feet

Total line length: _____ feet

# of Lines: _____ @ _____ feet

Depth of Media: _____ inches (Type) _____

Depth of Cover: _____ inches

Distribution Device: _____

Water Supply Source

☐ Municipal ☑ Private Well ☐ Community Well

☐ Other _____

System Installation Setbacks

Distance from Building Foundation: 116 feet

Distance from Property Line: 10 feet

Distance from Water Supply Source: 100 feet


Inspection Dates

Tank(s) Inspected: 8/12/22

Excavation Inspected: 8/12/22

Pump & Controls Inspected: _____

SKETCH OF SYSTEM INSTALLATION
(As-Built Drawing)

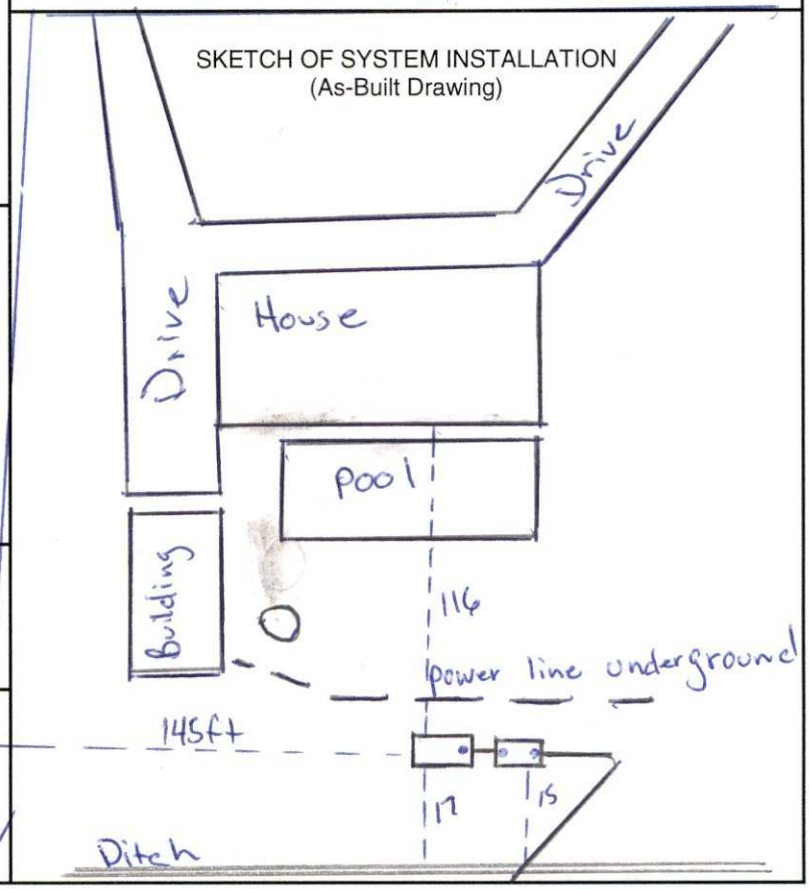

The undersigned has inspected the Septic Tank System described above, and certifies it has been ☑ installed ☐ altered ☐ repaired ☐ as detailed in the plot above ☑ in accordance with the permit issued and meets the provisions of 15A NCAC 18A. 1900, "Laws and Rules for Sewage Treatment and Disposal Systems" in effect on the date of issuance of the permit. The issuance of this Operation Permit does not in any way guarantee that the system will operate properly or relieve any person now or hereafter owning, controlling, or using such system from any liability resulting from the failure of the system to operate properly. This document is issued subject to those restrictions and conditions shown on the permit(s) and the provisions of 15A NCAC 18A. 1900 in addition to those listed below under "Comments." This document shall be null and void if any information contained in the application is untrue or if any additions are made to the property which would increase the requirements for said system.

Notice: Disturbance of the designated repair area may result in the Suspension or Revocation of this permit.

Comments: System Classification & Type: Tank and PT tank

DENR Authorized Agent: Bryan Davenport Signature: Bryan Davenport

Mecklenburg County Groundwater & Wastewater Services
3205 Freedom Dr. Suite 8000, Charlotte, NC 28208
Phone: (980) 314-1680 Fax: (704) 336-6894

NC DHHS
Division of Environmental Health
On-Site Wastewater Section

OPERATION PERMIT for an
ON-SITE WASTEWATER TREATMENT & DISPOSAL SYSTEM

File #: 1855A Permit #: 12954 Tax Parcel #: 197-141-24

Property Owner: _____

Job Location Address: 10941 Tara Oaks Dr

City: Charlotte State: NC Zip Code: 28227

OPERATION PERMIT CONDITIONS:

I. Performance: System shall perform in accordance with 15A NCAC 18A .1961.

II. Monitoring: System shall be monitored as required by 15A NCAC 18A .1961.

III. Maintenance: Ground absorption sewage treatment and disposal systems shall be checked, and the contents of the septic tank removed, periodically from all compartments, to ensure proper operation of the system. The contents shall be pumped whenever the solids level is found to be more than 1/3 of the liquid depth in any compartment.

IV. Operation: System shall be operated in accordance with 15A NCAC 18A .1961.

System Classification: Tank

*Operation Permits for Type V and VI systems expire five (5) years from the date of issuance (in accordance with Table V(a)). The system owner must contact GWS six (6) months prior to expiration for permit renewal.

Subsurface system operator required: Yes ☐ No ☑

☐ This type of system requires the system owner to maintain a contract with a certified operator to perform system inspection, maintenance, and reporting as required in 15A NCAC 18A .1961. and Table V(a). The system owner is responsible for all fees associated with these services.

☑ System does not require inspection by GWS on a routine frequency.

☐ System requires inspection by GWS once every five (5) years. The system owner is responsible for all fees associated with the inspection.

☐ System requires inspection by GWS once every three (3) years. The system owner is responsible for all fees associated with the inspection.

☐ System requires inspection by GWS once every twelve (12) months. The system owner is responsible for all fees associated with the inspection.

☐ System requires inspection by GWS once every six (6) months. The system owner is responsible for all fees associated with the inspection.

V. Other: moved tanks to make room for pool

DENR Authorized Agent: Bryan Davenport Date: 8/16/22

Signature: B Davenport