

13734 GIRL SCOUT RD

19936121

1/9/2008

duponbj

Groundwater and Wastewater Services File Imaging Project
May 2007
Barcode Font = IDAutomationHC39M

CONDITIONS OF IMPROVEMENT PERMIT

Permit Number: **5874B**

Tax Number: **19935032**

- The IMPROVEMNET PERMIT is subject to revocation if site plans or the intended use change. There is to be **NO** grading, filling, or disturbance of the soil in the area of the septic tank system or repair area.
- CONSTRUCTION AUTHORIZATION must be obtained prior to receiving a Building Permit. The Construction Authorization is **NOT** transferable. Do not clear, grade, fill or disturb soil prior to obtaining a Construction Authorization.
- Domestic-type wastewater only. No industrial process wastewater may be discharged into the system.

Basement: ☐ Yes ☐ No ☐ Partial Basement

Primary Wastewater System

Type: ☐ I ☐ II ☒ III ☐ IV ☐ V ☐ VI

☐ Conventional
☐ Prefabricated, permeable block panel system
☐ Shallow Placed Conventional
☐ Low Pressure Pipe
☐ Large Diameter Pipe
☐ Fill
☐ Other
☒ Innovative or Experimental:

0.3 Long-term acceptance rate (GPD/ft^2)	600 Max gallons/day wastewater flow	1500 Absorption Area (ft^2)	9 Trench spacing (min. on centers) (ft)
Serviced by private well: ☐ Yes ☒ No	1500 Gallon septic tank	500 Total trench length (ft)	24 Maximum trench depth (in) (At least 12" of provisionally suitable soil must remain between trench bottom and unsuitable soil conditions.)
5 Bedrooms in residence	1500 Gallon pump tank	na Depth of stone (in)	

Any surface water present: **Yes** Type: **Lake** Minimum separation distance (ft): **100**

Additional conditions: **Install according to plans on file submitted by S&ME, 7/18/05. Lot #164**

Repair Area System

Type: ☐ I ☐ II ☐ III ☒ IV ☐ V ☐ VI

☐ Conventional
☒ Prefabricated, permeable block panel system
☐ Shallow Placed Conventional
☒ Low Pressure Pipe
☐ Large Diameter Pipe
☐ Fill
☐ Other
☐ Innovative or Experimental:

1000 Absorption Area (ft^2) 333 Total trench length (ft)	na Depth of stone (in)	8 Trench spacing (min. on centers) (ft)	24 Maximum trench depth (in)

The undersigned, an authorized agent of the MECKLENBURG COUNTY HELTH DEPARTMENT, certifies that the Department has approved the Request for the Job Location contained in this document. The approval is granted in accordance with the provisions of Laws and Rules For Sewage, Treatment and Disposal in effect at the time of issuance of the permit and is subject to the following provisions:

*** No work shall be conducted on the septic tank system until an Installation, Construction, Alteration and/or Repair Approval is granted by this Department.

*** This Improvement permit is transferable.

8/8/05

DENR Authorized Agent Date

8-8-05

Owner/Agent Signature Date

MECKLENBURG COUNTY
HEALTH DEPARTMENT
ENVIRONMENTAL HEALTH DIVISION
c/o HAL MARSHALL CTR.
SUITE 211
700 N. TRYON ST.
CHARLOTTE, NC 28202
(704) 336-5103

NORTH CAROLINA DEPARTMENT OF
ENVIRONMENTAL, HEALTH, AND
NATURAL RESOURCES
DIVISION OF ENVIRONMENTAL HEALTH
ON-SITE WASTEWATER SECTION

S&ME

Date: July 18, 2005

To: Mr. David Cornelius, R.S.
Mecklenburg County Env. Health Dept.

From: Paul G. Penninger, LSS
Toney C. Jacobs, LSS

RE: Request for an Improvement Permit for Lot 164 at The Sanctuary:
MCHD File #5874B

The Sanctuary at Lake Wylie is requesting an Improvement Permit for the above referenced lot. **This lot will utilize an off-site septic area for the septic system drainfield.** Mr. Bill Marlin has evaluated the soils (see attached MCHD soil sheets) and S&ME, Inc. has flagged the system and repair on the septic area. The septic lines have been located by the surveyor and are shown on the attached maps. The attached sketch and specifications are not an Improvement Permit and are intended only to assist the MCHD in permitting the referenced lot at The Sanctuary.

We understand that a building permit cannot be issued until your office issues an Authorization to Construct (ATC). The buyer will apply for the ATC. If the buyer's house pad does not fit in the "building envelope" shown on the Improvement Permit, we understand that the proposed system may have to be modified prior to your office issuing the ATC. **No grading shall take place on the lot prior to obtaining the ATC from the MCHD.**

Tri-County Wastewater (TCWW) is under contract to supply maintenance services for each septic system installed at The Sanctuary. TCWW will have a list of preferred septic contractors for the subdivision and will also have requirements for septic system installation that are greater than the MCHD and State requirements. It will be the responsibility of TCWW to enforce any requirements above State requirements or the MCHD conditions on the Improvement Permit.

Please review the attached system sketch and design specifications for the Improvement Permit. Any additions or revisions you feel are necessary can be made on the Improvement Permit. Please call in you have and questions or comments.

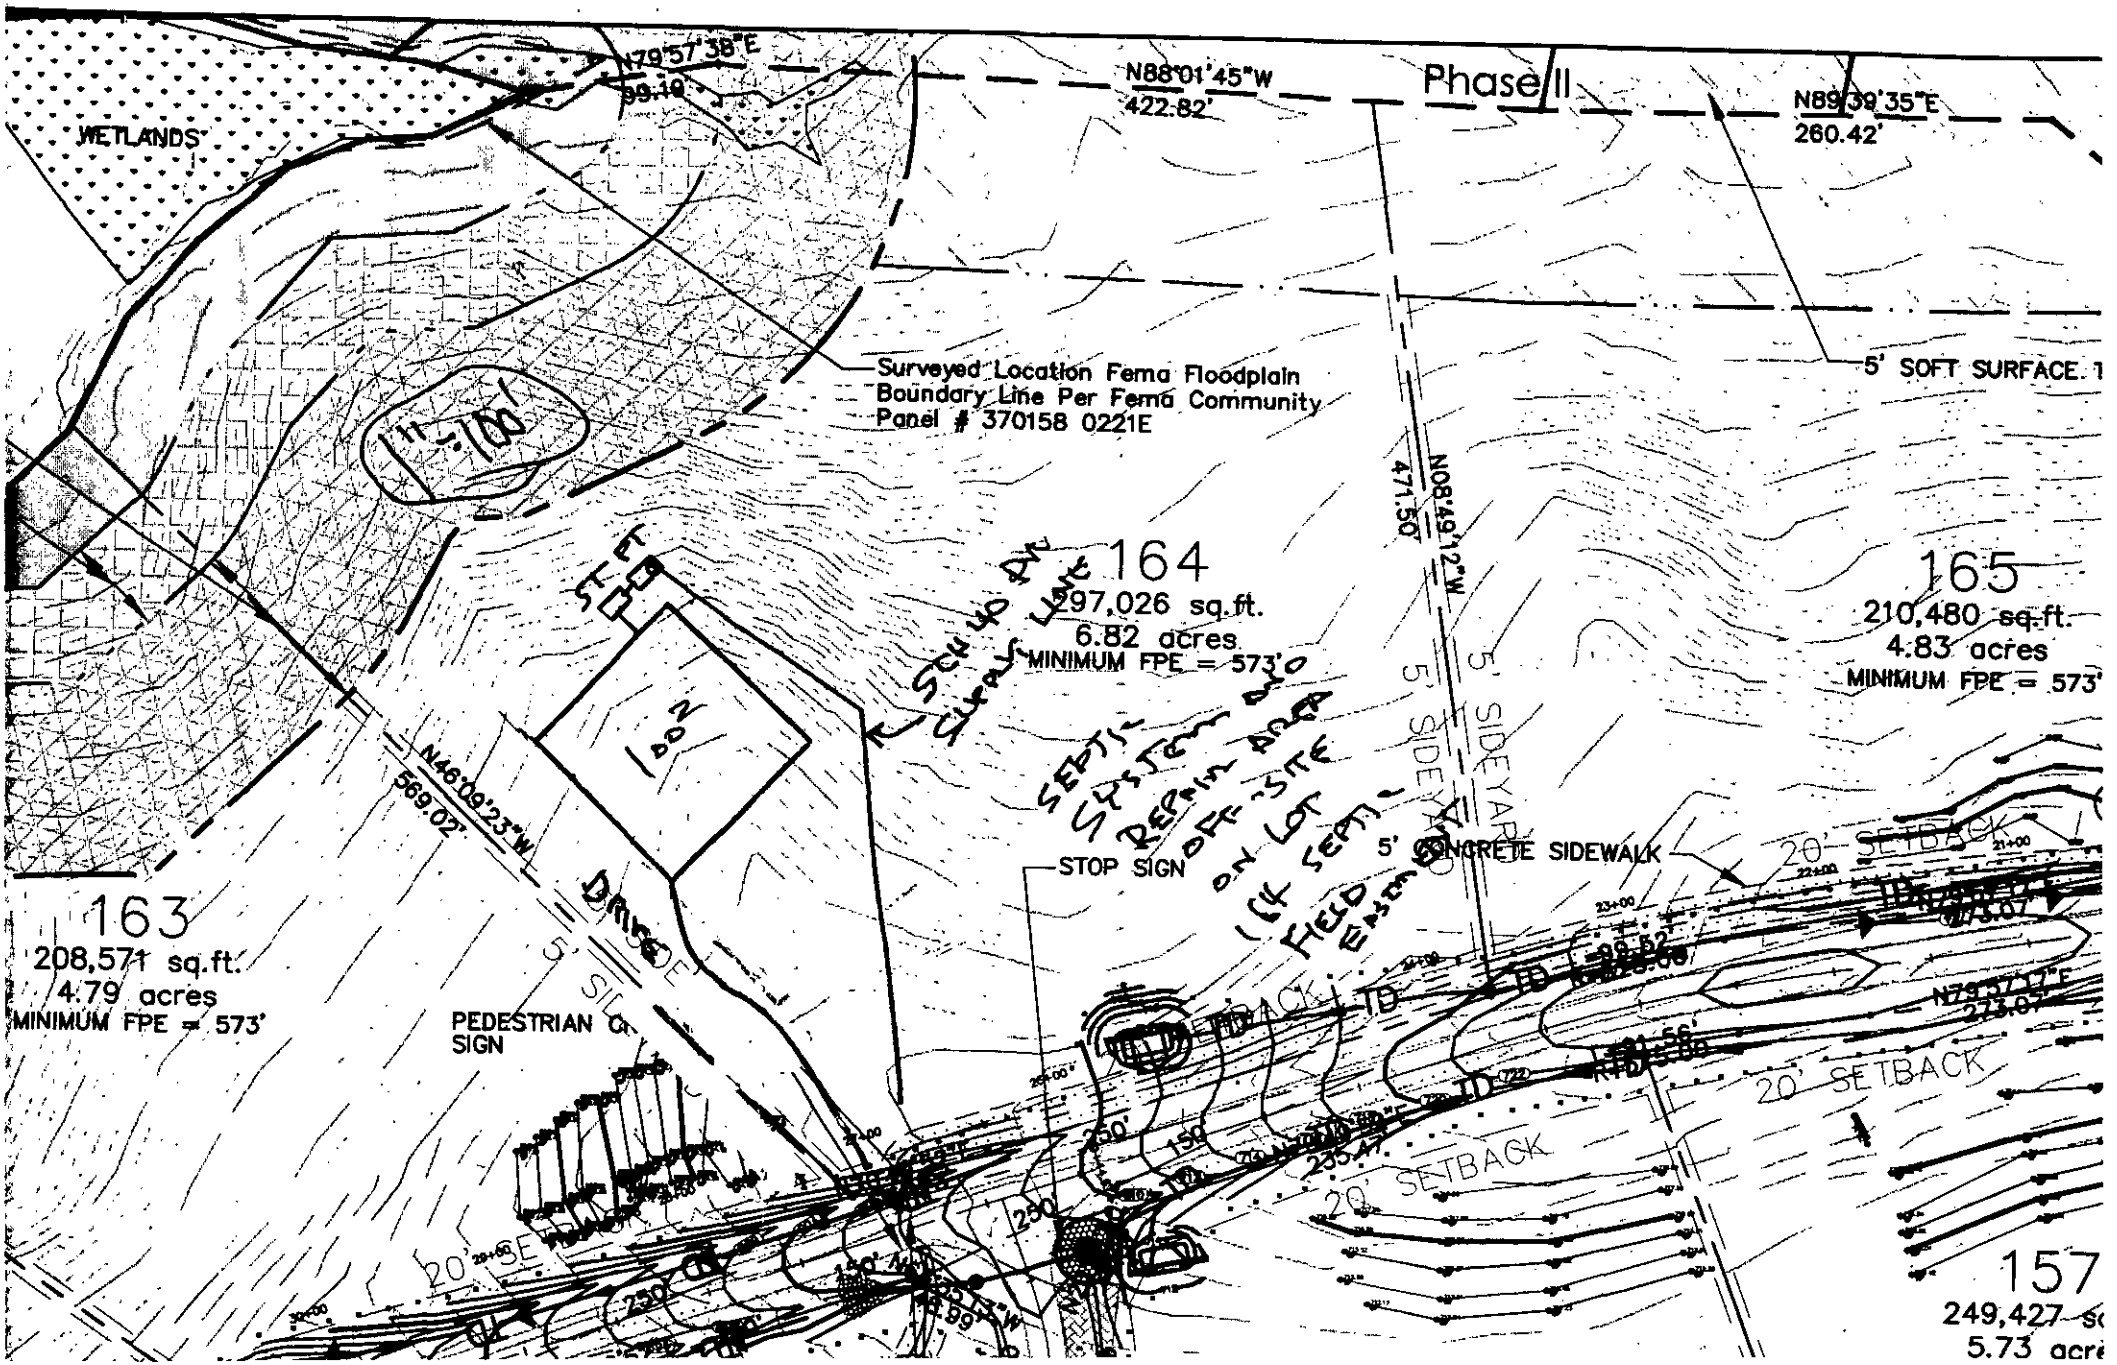
S&ME, Inc.
105-D Denver Business Park Dr.
Mooresville, North Carolina 28115-7926

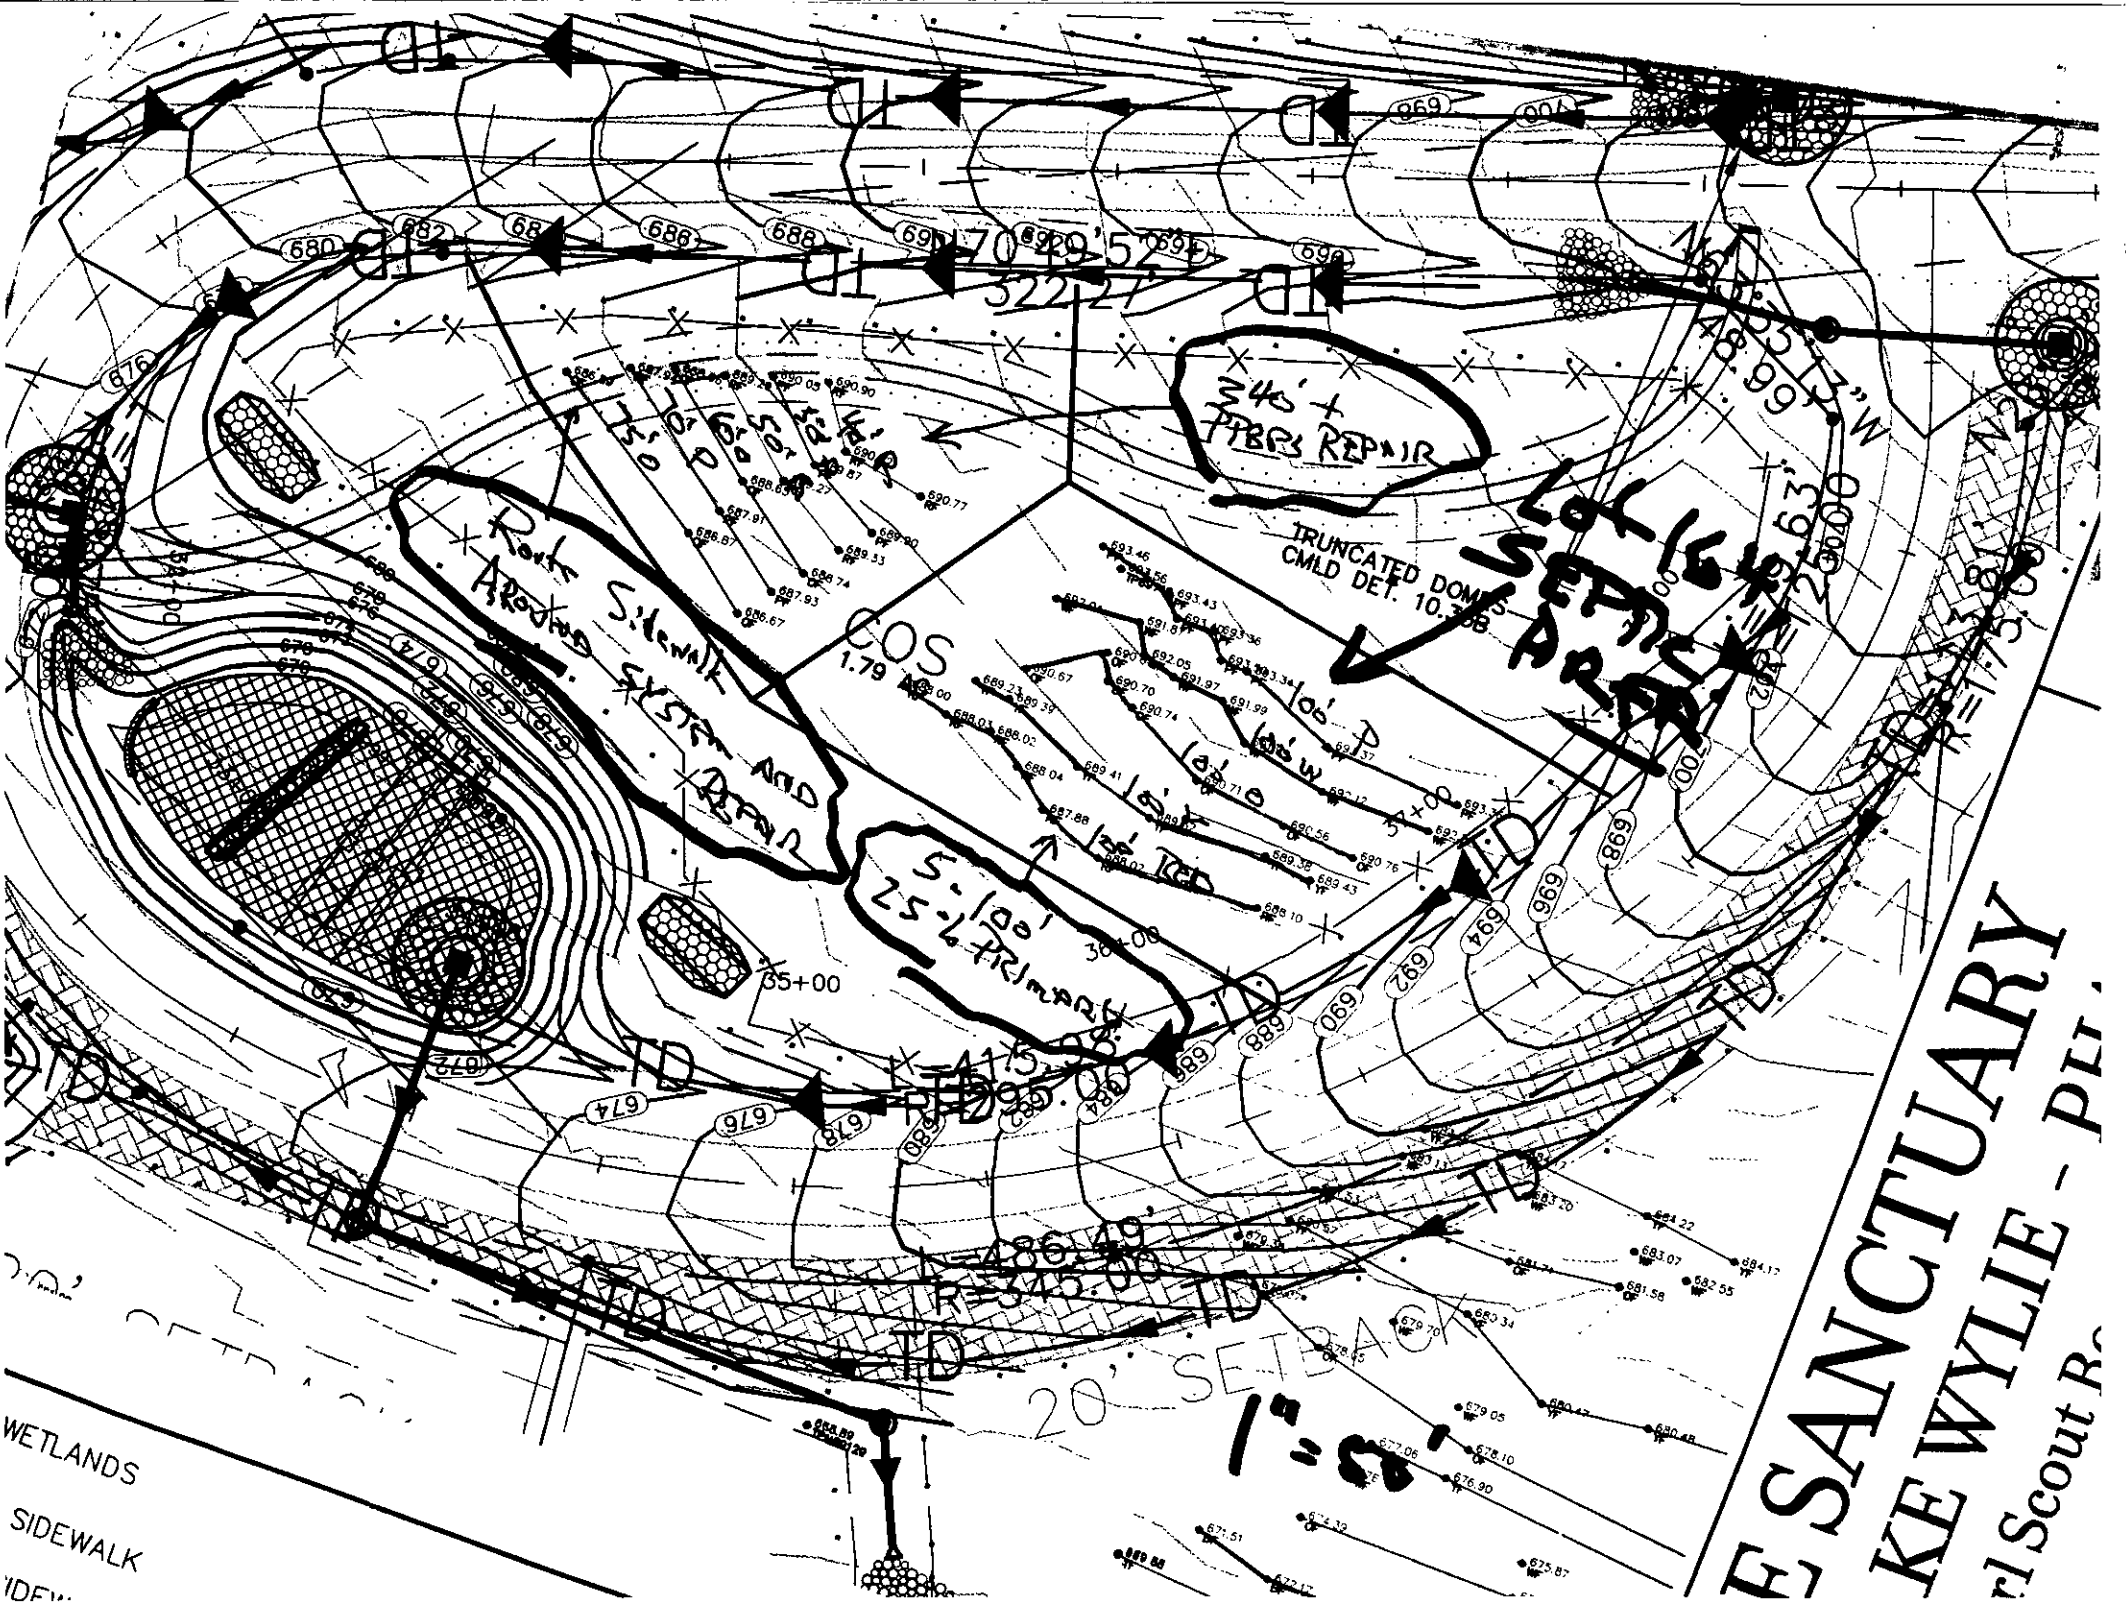
(704) 662-8625
(704) 662-8735 fax
www.smeinc.com

Design Specifications for Lot 164 at The Sanctuary
MCHD File # 5874B

Daily Design Flow:	600 gpd
Number Bedrooms:	5 bedroom
Basement or Crawl Space:	Basement
Septic Tank Size:	1500 gal
Pump Tank Size:	1500 gal
Primary System Loading Rate:	**0.3 gpd/ft^2**
Primary System:	**25% reduction**
Number and length of laterals:	5 @ 100 ft.
Total ft. of primary system:	500 ft.
Flow Rate through system:	27.5 gpm – use ½ in. SCH 80 taps with 2 ft. head pressure on pressure manifold (5.5 gpm per tap)
Pump Requirements:	to be calculated by installer when specific house and pump tank locations are available
Dosing Volume:	approx. 270 gal. – 2.2 doses/day at design flow
Depth of effluent pumped per dose:	calculated to specific tank by measure or dealer engineering specifications (1 cubic ft. of water equals 7.48 gal.)
Check Valve:	yes
Siphon break hole:	no
Repair System Loading Rate:	**0.3 gpd/ft^2**
Repair System:	***LP PPBPS***
Total ft. of repair	340 ft.

Notes: This lot utilizes an off-site septic area for the drainfield.


WETLANDS
N79°57'38"E
99.19'
N88°01'45"W
422.82'
Phase II
N89°39'35"E
260.42'
5' SOFT SURFACE T
Surveyed Location Fema Floodplain
Boundary Line Per Fema Community
Panel # 370158 0221E
N08°49'12"W
471.50'
164
297,026 sq.ft.
6.82 acres
MINIMUM FPE = 573'
165
210,480 sq.ft.
4.83 acres
MINIMUM FPE = 573'
163
208,571 sq.ft.
4.79 acres
MINIMUM FPE = 573'
N46°09'23"W
569.02'
DRIVE
5' SIDEWALK
PEDESTRIAN
SIGN
STOP SIGN
5' CONCRETE SIDEWALK
20' SETBACK
157
249,427 sq
5.73 acre


TRUNCATED DOMES
CMLD DET. 10.
COS
1.79
Septic
Repair
322.27
N 48°05'13" W
48.99
N 22°53'00" E
63.00
N 67°07'00" W
115.00
R=415.08
R=486.49
R=345.00
20' SETBACK
1"=20'
WETLANDS
SIDEWALK
E SANCTUARY
KE WYLIE - PH

GWS – RES. APP 12/04

200.00 check 1891

SEPTIC FEE
DATE
CRT. [illegible]

PERMIT APPLICATION FOR A RESIDENTIAL SITE IMPROVEMENT PERMIT / CONSTRUCTION AUTHORIZATION FOR ON-SITE WASTEWATER SYSTEM NEW WELL INSTALLATION OR REPAIR OF EXISTING WELL MECKLENBURG COUNTY GROUNDWATER & WASTEWATER SERVICES

WELL FEE
DATE
CRT. [illegible]

JBA 2/21/05

FILE # 58748

SEPTIC / TYPE APPLICATION: ☐ NONE ☒ NEW SYSTEM EXISTING SYSTEM: ☐ EXPANSION/ALTERATION ☐ REPAIR

WELL / TYPE APPLICATION: ☐ NONE ☐ NEW WELL ☐ MAJOR REPAIR ☐ ABANDONMENT

JOB LOCATION INFORMATION:

TAX/PARCEL #: 19935032
STREET ADDRESS: Girl Scout
CITY: Charlotte
STATE: NC ZIP: 28278
SUBDIVISION OR MOBILE HOME PARK NAME: SANCTUARY
LOT #: GIRL SCOUT
TOWNSHIP: 164

☒ 0-MECKLENBURG ☐ 4-PINEVILLE
☐ 1-CHARLOTTE ☐ 5-MATTHEWS
☐ 2-DAVIDSON ☐ 6-HUNTERSVILLE
☐ 3-CORNELIUS ☐ 7-MINT HILL

BUILDING INFORMATION:

TYPE OF BUILDING:
☐ SINGLE MOBILE HOME (S) ☐ MODULAR HOME (M)
☐ DOUBLE WIDE (D) ☐ MULTIPLE FAMILY (U)
☒ HOUSE (H) ☐ OTHER
HEATED SQUARE FOOTAGE:
NUMBER OF BEDROOMS: 5
NUMBER OF OCCUPANTS:

FOUNDATION FOR RESIDENCE:
☐ CONCRETE SLAB ☒ BASEMENT WITH PLUMBING
☐ CRAWLSPACE ☐ BASEMENT WITH NO PLUMBING

IF PLANNING TO EXPAND/ALTER THE EXISTING SYSTEM INDICATE THE FOLLOWING CHANGES:
NUMBER OF BEDROOMS TO BE ADDED: NUMBER OF ADDITIONAL OCCUPANTS IN THE RESIDENCE:
WILL THERE BE A HOME BUSINESS IN THE RESIDENCE? ☐ YES ☐ NO TYPE:

WATER SUPPLY:
☒ MUNICIPAL (M) ☐ PUBLIC (C) ☐ PRIVATE WELL (P) ☐ SHARED WELL (S) ☐ OTHER 'SPRINGS' (O)

PROPOSED USE OF WELL: ☐ N/A ☐ IRRIGATION ☐ POTABLE ☐ GEOTHERMAL ☐ OTHER

ARE ANY OF THE FOLLOWING LOCATED ON THE PROPERTY? IF SO, PLEASE SHOW LOCATION ON SITE PLAN/PLAT.

BURIED CABLES, LANDFILLS, STUMPHOLES	☐ YES	☒ NO	WELLS, SPRINGS, OR WATER LINES	☐ YES	☐ NO
EXISTING WASTEWATER SYSTEMS	☐ YES	☒ NO	DESIGNATED WETLANDS	☐ YES	☐ NO
EASEMENTS OR RIGHT-OF-WAYS	☐ YES	☒ NO	GRADING/SOIL REMOVAL PERFORMED	☐ YES	☒ NO

PROPERTY OWNER:

NAME: SANCTUARY AT LAKE WYLIE, LLC
ADDRESS: P.O. Box 1003
CITY: CHARLOTTE, NC
STATE: NC ZIP: 28201
HOME PHONE: WORK PHONE: 295-0950
MOBILE PHONE: FAX:

LEGAL AGENT FOR PROPERTY OWNER, IF APPLICABLE:

NAME: Tony Jacobs, Jr. & Assoc. Inc
ADDRESS: 169 Pembrook Dr.
CITY: Mooresville
STATE: NC ZIP: 28117
HOME PHONE: — WORK PHONE: 663-6905
MOBILE PHONE: — FAX: 662-9845

WHAT DATE WAS THE PROPERTY ORIGINALLY DEEDED AND RECORDED? Lots Not Recorded
WHAT IS THE ANTICIPATED CLOSING DATE FOR THIS PROPERTY?

*An Improvement Permit is subject to suspension or revocation if site plans or the intended use change or if information submitted in this application is falsified or changed. The undersigned, owner, or legal agent for the owner, of the property described above as the "Job Location" has read the foregoing application, acknowledges that the contents of same are true, and authorizes the Mecklenburg County Health Department to enter onto the property for the purpose of processing this request.

2-21-05
Owner's/Agent's Signature Date

NORTH CAROLINA DEPARTMENT OF
ENVIRONMENT & NATURAL RESOURCES DIVISION
OF ENVIRONMENTAL HEALTH ON-SITE
WASTEWATER SECTION

*A Well Permit is subject to suspension or revocation if site plans or the intended use change or if information submitted in this application is falsified or changed. The undersigned, owner, or legal agent for the owner, of the property described above as the "Job Location" has read the foregoing application, acknowledges that the contents of same are true, and authorizes the Mecklenburg County Health Department to enter onto the property for the purpose of processing this request.

*Owner's/Agent's Signature Date

MECKLENBURG COUNTY HEALTH DEPARTMENT
GROUNDWATER & WASTEWATER SERVICES
700 N. TRYON ST., SUITE 211
CHARLOTTE, NC 28202
704-336-5103 / FAX: 704-336-6894