MECKLENBURG COUNTY
HEALTH DEPARTMENT

97028 #8856

5 APR '17 PM 4:04

APPLICATION FOR A RESIDENTIAL SITE IMPROVEMENT PERMIT/ CONSTRUCTION AUTHORIZATION FOR AN ON-SITE WASTEWATER SYSTEM, NEW WELL INSTALLATION, OR REPAIR OF EXISTING WELL

1. SEPTIC / TYPE APPLICATION: ○ N/A ○ NEW SYSTEM ○ ALTERATION ☒ REPAIR ○ MODIFIED PLOT PLAN

2. WELL / TYPE APPLICATION: ☒ N/A ○ NEW WELL ○ MAJOR REPAIR ○ ABANDONMENT

3. JOB LOCATION INFORMATION:
TAX PARCEL NUMBER: 11316326
STREET ADDRESS: 9507 BRENDA ANN RD
CITY: CHARLOTTE
STATE: NC ZIP: 28214
SUBDIVISION NAME: _____
LOT #: _____ LOT SIZE (acres): .9
TOWNSHIP:
☒ MECKLENBURG ○ CORNELIUS ○ HUNTERSVILLE
○ DAVIDSON ○ CHARLOTTE ○ PINEVILLE
○ MATTHEWS ○ MINT HILL

4. BUILDING INFORMATION:
BUILDING TYPE:
○ SINGLE MOBILE HOME ○ MODULAR HOME
○ DOUBLE WIDE ○ MULTIPLE FAMILY
☒ HOUSE ○ OTHER _____
HEATED SQUARE FOOTAGE: _____
NUMBER OF BEDROOMS: 3
NUMBER OF OCCUPANTS: 3
FOUNDATION TYPE:
○ CONCRETE SLAB ○ BASEMENT WITH PLUMBING
☒ CRAWL SPACE ○ BASEMENT WITH NO PLUMBING

5. IF PLANNING TO EXPAND OR ALTER THE EXISTING SEPTIC SYSTEM PLEASE COMPLETE THE FOLLOWING SECTION: ☐ N/A

NUMBER OF BEDROOMS TO BE ADDED: _____ NUMBER OF ADDITIONAL OCCUPANTS IN THE RESIDENCE: _____

6. WATER SUPPLY: ○ MUNICIPAL ☒ PRIVATE WELL ○ PUBLIC WELL ○ SHARED WELL ○ OTHER _____

7. PROPOSED USE OF WELL: ☒ N/A ○ IRRIGATION ○ POTABLE (DRINKING WATER) ○ OTHER _____

8. PLEASE INDICATE AND RANK DESIRED SEPTIC SYSTEM TYPE(S) IN ORDER OF PREFERENCE *(1-MOST DESIRED 5-LEAST DESIRED)*:

☐ N/A ☐ ANY TYPE ☐ CONVENTIONAL ☐ ACCEPTED ☐ INNOVATIVE ☐ ALTERNATIVE ☐ OTHER _____

8A. RANK: ____ ____ ____ ____ ____

9. DO ANY OF THE FOLLOWING APPLY TO THE PROPERTY IN QUESTION? IF "YES" PLEASE ATTACH SUPPORTING DOCUMENTATION.

BURIED CABLES, LANDFILLS, STUMPHOLES	○ YES ☒ NO	GRADING/SOIL REMOVAL PERFORMED	○ YES ☒ NO
EXISTING WASTEWATER (SEPTIC) SYSTEMS	☒ YES ○ NO	JURISDICTIONAL WETLANDS	○ YES ☒ NO
WELLS, SPRINGS, OR WATER LINES	☒ YES ○ NO	APPROVAL REQUIRED BY ANY OTHER PUBLIC AGENCY	○ YES ☒ NO
EASEMENTS OR RIGHT-OF-WAYS	○ YES ☒ NO	WASTEWATER OTHER THAN DOMESTIC SEWAGE	○ YES ☒ NO
CHEMICAL/PETROLEUM STORAGE TANKS	○ YES ☒ NO	KNOWN UNDERGROUND CONTAMINATION	○ YES ☒ NO
WASTE STORAGE	○ YES ☒ NO	GROUNDWATER USE RESTRICTIONS/VARIANCES	○ YES ☒ NO

10. WHAT DATE WAS THE PROPERTY ORIGINALLY DEEDED AND RECORDED? _____ ☒ UNKNOWN

11. WHAT IS THE ANTICIPATED CLOSING DATE FOR THIS PROPERTY? _____ ☒ N/A

12. PROPERTY OWNER:
NAME: JEFF TODD
ADDRESS: 9507 BRENDA ANN RD
CITY: CHARLOTTE
STATE: NC ZIP: 28214
WORK PHONE: _____
MOBILE PHONE: 704 4307654
FAX: _____
E-MAIL: NWFAN1@YAHOO.COM

13. OWNER'S LEGAL REPRESENTATIVE, IF APPLICABLE:
NAME: _____
ADDRESS: _____
CITY: _____
STATE: _____ ZIP: _____
WORK PHONE: _____
MOBILE PHONE: _____
FAX: _____
E-MAIL: _____

14. SEPTIC SYSTEM PERMIT APPLICATION:

If the information in this application is falsified, changed, or the site is altered, then the Improvement Permit and Authorization to Construct shall become invalid. I have read this application and certify that the information provided herein is true, complete and correct. Authorized county and state officials are granted right of entry to conduct necessary inspections to determine compliance with applicable laws and rules. I understand that I am solely responsible for the proper identification and labeling of all property lines and corners and making the site accessible so that a complete site evaluation can be performed. The permit is valid for either sixty (60) months or is non-expiring depending upon the documentation submitted: complete site plan = 60 months, complete plat = non-expiring.

JPN (Initial here for septic system applications)

15. WELL PERMIT APPLICATION:

If the information in this application is falsified, changed, or the site is altered, then the Well Permit shall become invalid. I have read this application and certify that the information provided herein is true, complete and correct. Authorized county and state officials are granted right of entry to conduct necessary inspections to determine compliance with applicable laws and rules. I understand that I am solely responsible for the proper identification and labeling of all property lines and corners and making the site accessible so that a complete site evaluation can be performed. The permit is valid for a period of twelve (12) months from the date of issuance.

_____ (Initial here for well applications)

16. APPLICATION SIGNATURE SECTION:

ONLY COMPLETE APPLICATIONS WILL BE PROCESSED. A proper signature is required in order to process your application. Please review the application carefully and sign in the space provided below. A PROPOSED PLOT PLAN is required to be submitted with each application.

_____ 4/5/17
Property Owner's or Owner's Legal Representative Signature — Date

---

OFFICE USE ONLY

○ SURVEY PLAT TO SCALE SUBMITTED ○ SCALED SITE PLAN SUBMITTED ○ UN-SCALED SITE PLAN SUBMITTED

SEPTIC APPLICATION FEE RECEIVED: $ _____ DATE FEE RECEIVED: _____

WELL APPLICATION FEE RECEIVED: $ _____ DATE FEE RECEIVED: _____

APPLICATION PROCESSED BY: _____

GWS FILE NUMBER ASSIGNED: _____

APPLICATION ID NUMBER ASSIGNED: _____

COMMENTS:

MECKLENBURG COUNTY – GROUNDWATER & WASTEWATER SERVICES
700 N. TRYON ST. SUITE 211 CHARLOTTE, NC 28202, OFFICE: 704-336-5103, FAX: 704-336-6894

Revised on: 12/15/10


File #: _____

PROPOSED PLOT PLAN

A drawing showing the locations of the following items is required: existing and proposed property lines with dimensions, easements or right-of-ways, proposed building pad(s) or existing building footprint(s), all appurtenances (garage, driveway, deck, pool, etc.), location of existing or proposed well(s), location of existing or proposed sewer lines and sewage disposal systems, surface water bodies, and any aboveground or underground storage tanks. Provide names for all roads that adjoin the property.

Street Address: _____ Tax Parcel #: _____

Subdivision Name: _____ Lot #: _____

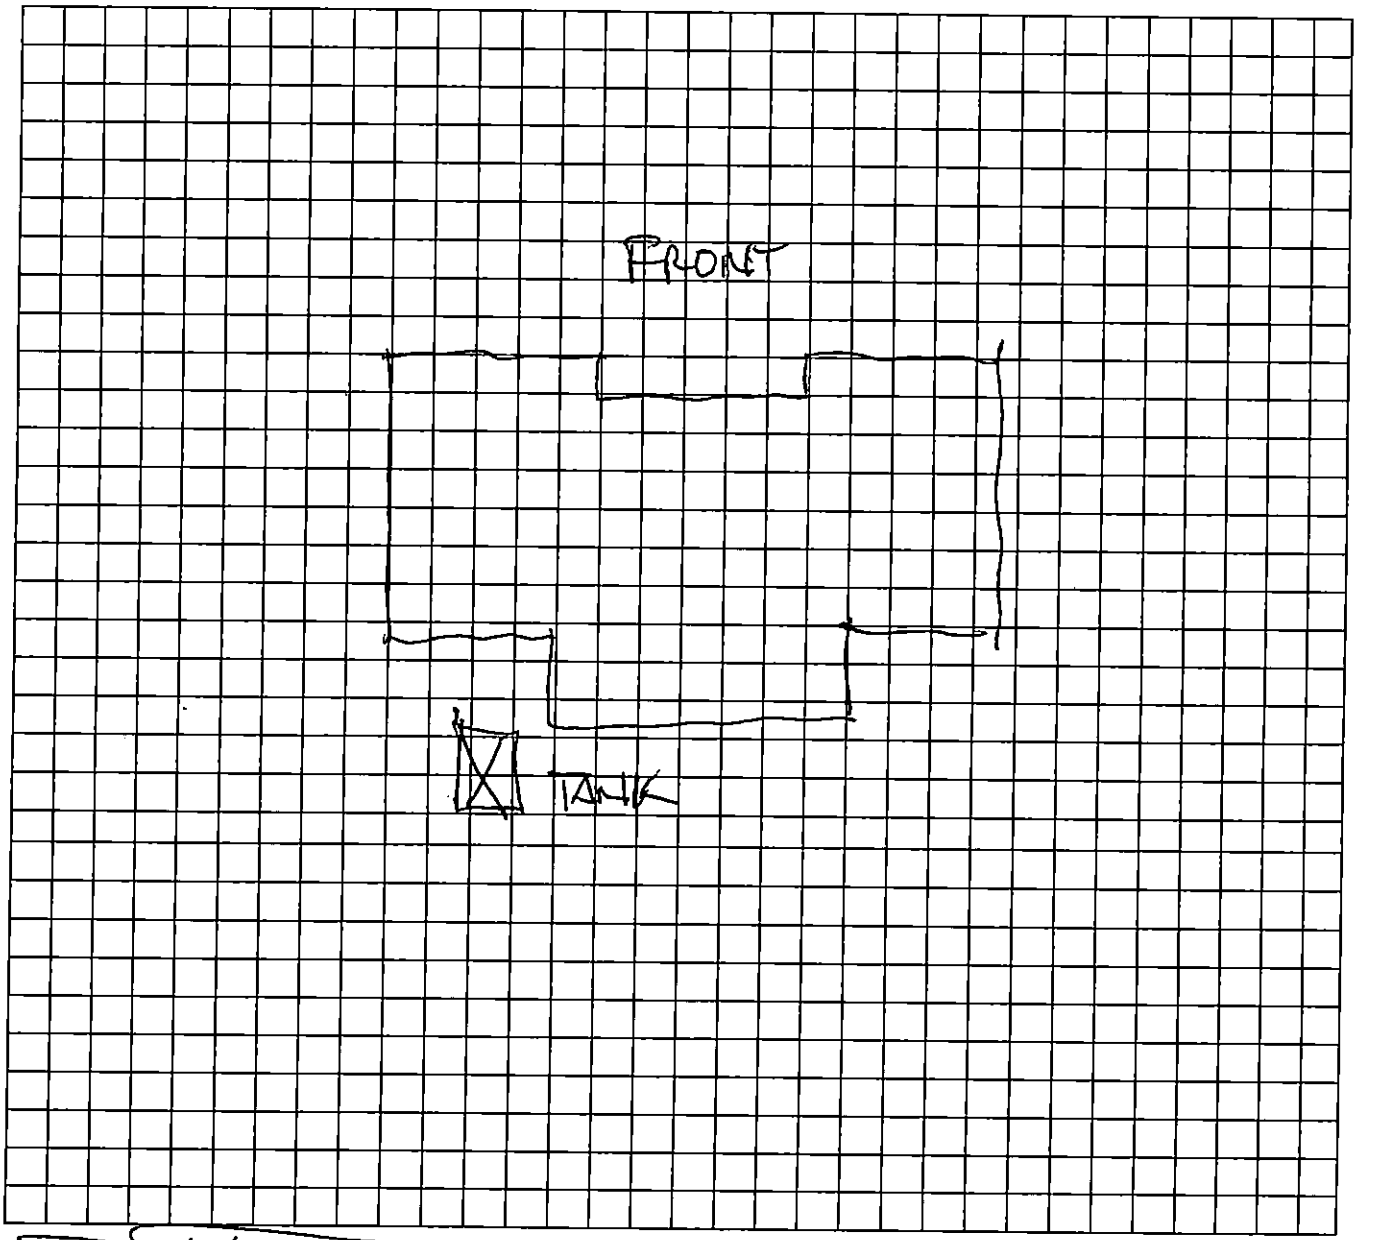

Property Owner's or Owner's Legal Representative Signature

4/5/17
Date

MECKLENBURG COUNTY – GROUNDWATER & WASTEWATER SERVICES
700 N. TRYON ST. SUITE 211 CHARLOTTE, NC 28202, OFFICE: 704-336-5103, FAX: 704-336-6894

Revised on: 12/15/10

DENR/DEH

ON-SITE WASTEWATER SECTION

Sheet ___ of ___
PROPERTY ID #: ___
COUNTY: ___

SOIL/SITE EVALUATION
for ON-SITE WASTEWATER SYSTEM

OWNER: Jeff Todd
ADDRESS: 9507 Brenda Ann Rd
APPLICATION DATE: ___
DATE EVALUATED: 6-2-17
PROPOSED FACILITY: ___ PROPOSED DESIGN FLOW (.1949): ___
PROPERTY SIZE: ___
LOCATION OF SITE: ___
PROPERTY RECORDED: ___
WATER SUPPLY: ▫ Private ▫ Public ☒ Well ▫ Spring ▫ Other ___
EVALUATION METHOD: ▫ Auger Boring ☒ Pit ▫ Cut TYPE OF WASTEWATER: ☒ Sewage ▫ Industrial Process ▫ Mix

PROFILE	1940 LANDSCAPE POSITION/ SLOPE %	HORIZON DEPTH (IN)	SOIL MORPHOLOGY (.1941) 1941 STRUCTURE/ TEXTURE	1941 CONSISTENCE/ MINERALOGY	OTHER PROFILE FACTORS 1942 SOIL WETNESS/ COLOR	1949 SOIL DEPTH	1950 PAPRO CLASS	1944 RESTR HORIZ	PROFILE CLASS & LTAR
1	L 3	0-14"	SCl V FR	WSB SS SE XP					
		14-36"	C Fi	SBK SS SE XP					
		36-50"	Cl Fr	SBK SS SE XP	NA	50	N/A	N/A	PS 3
2									
3									
4									

DESCRIPTION	INITIAL SYSTEM	REPAIR SYSTEM
Available Space (.1945)		PS
System Type(s)		IIa
Site LTAR		.3

OTHER FACTORS (.1946): ___
SITE CLASSIFICATION (.1948): ___
EVALUATED BY: April Bumgarner
OTHER(S) PRESENT: ___

LEGEND

use the following standard abbreviations

LANDSCAPE POSITION	GROUP	SOIL TEXTURE	CONVENTIONAL .1955 LTAR*	LPP .1957 LTAR*	MINERALOGY/ CONSISTENCE	STRUCTURE
CC (Concave Slope)	I	S (Sand)	1.2 - 0.8	0.6 - 0.4	NEXP (Non-expansive)	G (Single Grain)
CV (Convex Slope)		LS (Loamy Sand)			SEXP (Slightly Expansive)	M (Massive)
D (Drainage Way)					EXP (Expansive)	CR (Crumb)
DS (Debris Slump)	II	SL (Sandy Loam)	0.8 - 0.6	0.4 - 0.3		GR (Granular)
FP (Flood Plain)		L (Loam)				SBK (Subangular Blocky)
FS (Foot Slope)						ABK (Angular Blocky)
H (Head Slope)	III	Si (Silt)	0.6 - 0.3	0.3 - 0.15		PL (Platy)
L (Linear Slope)		SiCL (Silty Clay Loam)				PR (Prismatic)
N (Nose Slope)		CL (Clay Loam)				
R (Ridge)		SCL (Sandy Clay Loam)			MOIST	WET
S (Shoulder Slope)		SiL (Silt Loam)				
T (Terrace)					VFR (Very Friable)	NS (Non-sticky)
	IV	SC (Sandy Clay)	0.4 - 0.1	0.2 - 0.05	FR (Friable)	SS (Slightly Sticky)
		SiC (Silty Clay)			FI (Firm)	S (Sticky)
		C (Clay)			VFI (Very Firm v. Very Sticky)	VS (Very Sticky)
		O (Organic)	None	None	EFI (Extremely Firm)	NP (Non-plastic)
						SP (Slightly Plastic)
						P (Plastic)
						VP (Very Plastic)

*Adjust LTAR due to depth, consistence, structure, soil wetness, landscape, position, wastewater flow and quality.


NOTES

HORIZON DEPTH	In inches below natural soil surface
DEPTH OF FILL	In inches from land surface
RESTRICTIVE HORIZON	Thickness and depth from land surface
SAPROLITE	S(suitable) or U(unsuitable)
SOIL WETNESS	Inches from land surface to free water or inches from land surface to soil colors with chroma 2 or less - record Munsell color chip designation
CLASSIFICATION	S (Suitable), PS (Provisionally Suitable), or U (Unsuitable)

Evaluation of saprolite shall be by pits.

Long-term Acceptance Rate (LTAR): gal/day/ft^2

Show profile locations and other site features (dimensions, reference or benchmark, and North).

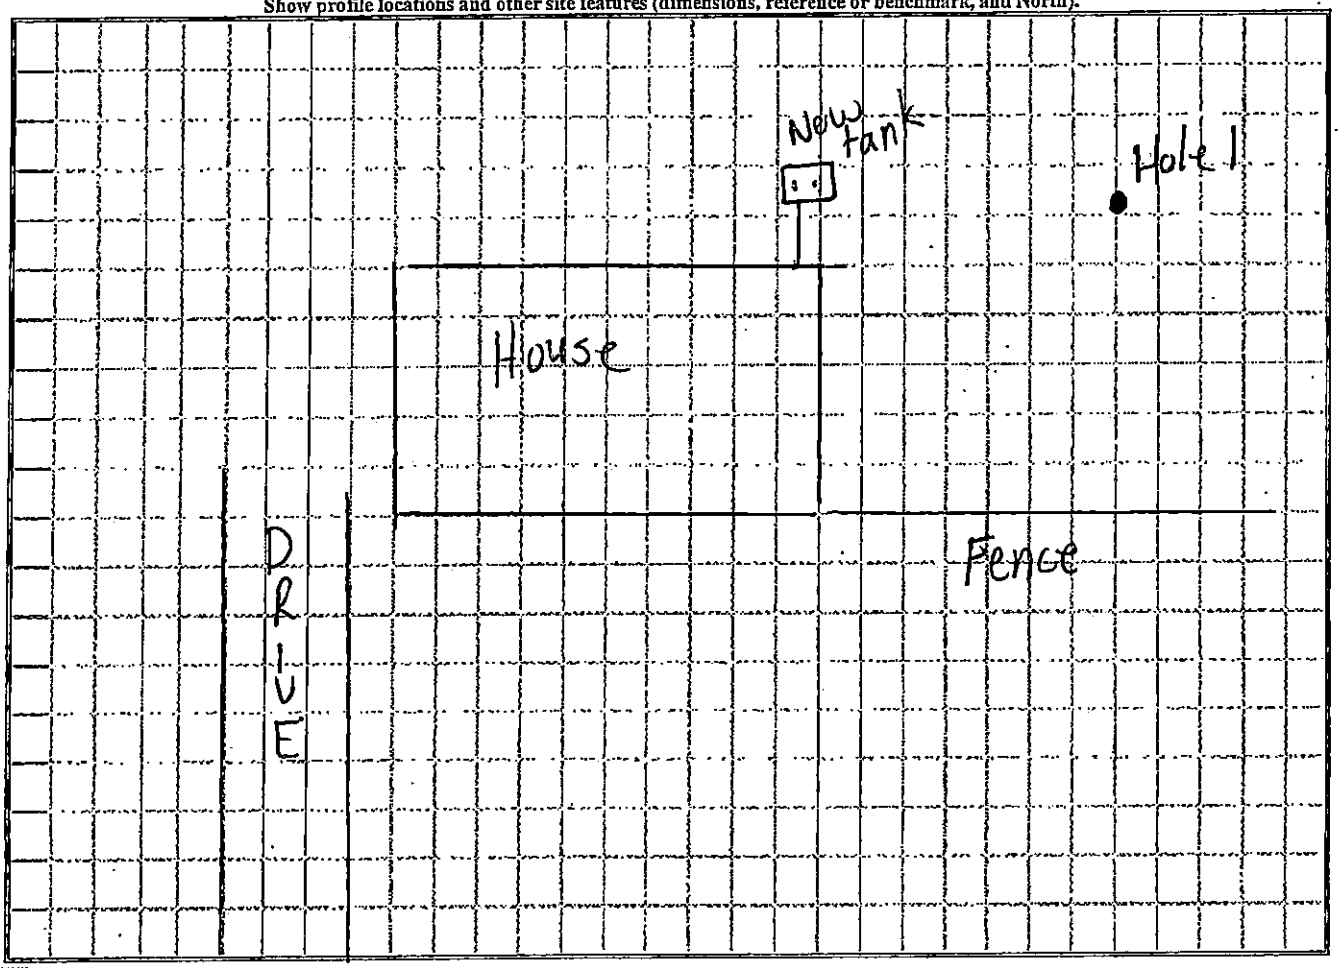

DENR (######)
Review (#####)

Mecklenburg County Groundwater & Wastewater Services
700 N. Tryon St., Suite 211 Charlotte, NC 28202
Phone: (980) 314-1680 Fax: (704) 336-6894

NC DHHS
Division of Environmental Health
On-Site Wastewater Section

IMPROVEMENT PERMIT/CONSTRUCTION AUTHORIZATION
for an ON-SITE WASTEWATER TREATMENT & DISPOSAL SYSTEM

File #: 9702B Permit #: 8856 Tax Parcel #: 113-163-26

Property Owner: Jeff Todd

Job Location Address: 9507 Brenda Ann

City: Charlotte State: NC Zip Code: 28214

Improvement Permit Issuance Date: 6/6/17 **Construction Authorization Issuance Date** 6/6/17

Permission is hereby given to ☒ install ☐ alter ☒ repair an on-site wastewater treatment & and disposal system, with subsurface soil absorption and effluent discharge, as specified herein at the described location. This permit is granted based upon the application information submitted to our office. This permit expires 5 years from the date it was issued. The system shall meet all of the construction requirements of 15A NCAC 18A .1900 which are in effect on the date of granting this approval. An **Operation Permit** must be obtained from the Mecklenburg County Health Department before any system can be covered up or placed into service. The issuance of this permit does not in any way guarantee that the system anticipated to be constructed will operate properly, or relieve any person now of hereafter owning, controlling or using such system from any liability resulting from the failure of the system to operate properly.

***NOTICE: This system shall not be installed while soils are in a wet condition.**

Permitted Design Flow: 360 GPD Site LTAR: .3 GPD/ft² (For new installations only.)

Liquid Capacity of Septic Tank: 1000 gallons Liquid Capacity of Dosing Tank: NA gallons

Drainfield Design ☒ N/A

Trench Depth: ~~36"~~ inches

Trench Width: _____ feet

Line Spacing: _____ feet (O.C.)

Total line length: _____ feet

# of Lines: _____ @ _____ feet

Depth of Media: _____ inches (Type) _____

Distribution Device: _____

Bed Design *(For Repair Installations ONLY.)* ☐ N/A

Bed Depth: 36" inches

Bed Width: 10' feet

Total line length: 57' feet

# of Lines: 3 @ 57 feet

Depth of Media: 24" inches (Type) IIa Tire Chip or Stone #5

Distribution Device: D-Box

Water Supply Source

☐ Municipal ☒ Private Well ☐ Community Well

☐ Other _____


Minimum System Setbacks

Distance from Building Foundation: 5 feet

Distance from Property Line: 10' feet

Distance from Water Supply Source: 50'min feet

SKETCH OF SYSTEM LAYOUT
(Proposed Layout)

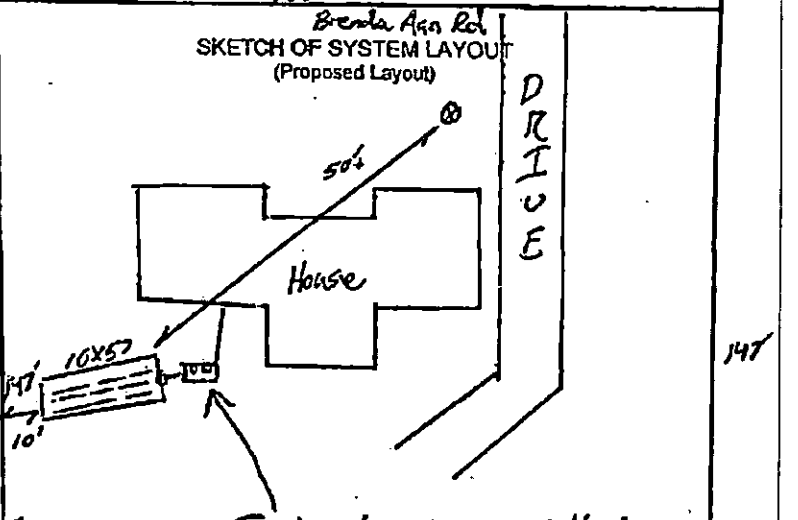

- New Tank already Installed
- Insall Bed 10X57' w/ 24" stone or Tire Chips.

Comments: System Classification & Type: IIa (Tire chip or Stone)

Authorized Agent: Bradley W. Hallman Signature: [signature]

Owner Signature: Jeff Todd Date: 6/19/17

[redacted] Large Tract

Improvement Permit/Construction Authorization: 130A-336(a) - Facility/appurtenance setbacks shown from fixed points?	N/A
Corrections/modifications needed?	Yes
Comments:	
IA issued date:	
OP Issued date:	6-2-17
Review performed by:	Jeremy Michael
Date performed:	6/14/2017

Created at 6/14/2017 9:24 AM by Michael, Jeremy
Last modified at 6/14/2017 9:24 AM by Michael, Jeremy

Close

Owner needs to sign the permit

IP should not be dated JUST CA

Groundwater & Wastewater Services: Septic Project File & D

Edit Response | Delete Response | Manage Permissions | Workflows | Alert Me

GWS File #:	9702B
WASPS App #:	8856
Primary ES assigned to project:	Brad Hallman
Secondary ES assigned to project:	April Bumgarner
Project Type:	Repair
Site Evaluation Information: .1939(a)(1) - Topography and Landscape Position Recorded?	Yes
Site Evaluation Information: .1940(a-g) - Slope % Recorded?	No
Site Evaluation Information: .1939(a)(2) - Texture Class Recorded?	Yes
Site Evaluation Information: .1939(a)(2) - Structure Type Recorded?	Yes
Site Evaluation Information: .1939 (a)(2) - Consistence Recorded?	Yes
Site Evaluation Information: .1939(a)(2) - Mineralogy Recorded?	Yes
Site Evaluation Information: .1939(a)(3) - Soil Wetness Condition Recorded?	N/A
Site Evaluation Information: .1939(a)(4) - Soil Depth to Rock or Parent Material Recorded when Encountered?	Yes
Site Evaluation Information: .1939(a)(5) - Depth to Restrictive Horizons Recorded when Encountered?	N/A
Site Evaluation Information: .1939(a)(6) - Sufficient Available Space Recorded?	Yes
Site Evaluation Information: 1937(m) - Are the Profile Locations Shown?	No
Site Evaluation Information: .1939(a) - Are the S/PS Profiles in system & in repair area?	Yes
Site Evaluation Information: .1939(d), .1955, .1956, .1957 - LTAR	Yes
Improvement Permit/Construction Authorization: .1937(g), 130A-336(a) - Proposed System Type stated - Initial	N/A
Improvement Permit/Construction Authorization: 1945(b) - Proposed System Type stated - Repair	No - on Soil Report
Improvement Permit/Construction Authorization: 130A-336(a)(3) - System location identifiable by setbacks - Initial	N/A
Improvement Permit/Construction Authorization: .1937(g), .1945(b) - System components shown - Initial	No
Information Permit/Construction Authorization: .1945(b) - Repair area shown	Yes
Improvement Permit/Construction Authorization: .1937(f)(g) - Does System design match facility, flow & WW characteristics?	N/A
Improvement Permit/Construction Authorization: .1937(f)(g) - Is System design consistent with soil/site conditions?	Yes
Improvement Permit/Construction Authorization: .1937(f)(g) - Is the System located in the approved area?	Yes
Improvement Permit/Construction Authorization: 130A-336(a) - Number of Bedrooms, employees, seats, etc. indicated?	Yes
Improvement Permit/Construction Authorization: .1937 (g) - Trench depth correct?	Yes
Improvement Permit/Construction Authorization: .1937(g) - Trench width correct?	Yes
Improvement Permit/Construction Authorization: .19379(g) - Trench length correct?	Yes
Improvement Permit/Construction Authorization: 130A-336(a)(1) - Proposed/existing well shown?	Yes

Mecklenburg County Groundwater & Wastewater Services
700 N. Tryon St., Suite 211 Charlotte, NC 28202
Phone: (704) 336-5103 Fax: (704) 336-6894

NC DHHS
Division of Environmental Health
On-Site Wastewater Section

IMPROVEMENT PERMIT/CONSTRUCTION AUTHORIZATION for an ON-SITE WASTEWATER TREATMENT & DISPOSAL SYSTEM

File #: 9702B Permit #: 8856 Tax Parcel #: 113-163-26

Property Owner: Jeff Todd

Job Location Address: 9507 Brenda Ann Rd

City: Charlotte NA State: NC Zip Code: _____

Improvement Permit Issuance Date: ~~4/11/17~~ Construction Authorization Issuance Date 4/11/17

Permission is hereby given to ☒ install ☐ alter ☒ repair an on-site wastewater treatment & and disposal system, with subsurface soil absorption and effluent discharge, as specified herein at the described location. This permit is granted based upon the application information submitted to our office. This permit expires 5 years from the date it was issued. The system shall meet all of the construction requirements of 15A NCAC 18A. 1900 which are in effect on the date of granting this approval. An Operation Permit must be obtained from the Mecklenburg County Health Department before any system can be covered up or placed into service. The issuance of this permit does not in any way guarantee that the system anticipated to be constructed will operate properly, or relieve any person now of hereafter owning, controlling or using such system from any liability resulting from the failure of the system to operate properly.

***NOTICE: This system shall not be installed while soils are in a wet condition.**

Permitted Design Flow: 360 GPD
Liquid Capacity of Septic Tank: ~~1000~~ 1000 gal gallons

Site LTAR: NA GPD/ft² (For new installations only.)
Liquid Capacity of Dosing Tank: NA gallons


Drainfield Design ☒ N/A
Trench Depth: _____ inches
Trench Width: _____ feet
Line Spacing: _____ feet (O.C.)
Total line length: _____ feet
# of Lines: _____ @ _____ feet
Depth of Media: _____ inches (Type) _____
Distribution Device: _____

Bed Design *(For Repair Installations ONLY.)* ☒ N/A
Bed Depth: _____ inches
Bed Width: _____ feet
Total line length: _____ feet
# of Lines: _____ @ _____ feet
Depth of Media: _____ inches (Type) _____
Distribution Device: _____

Water Supply Source
☐ Municipal ☒ Private Well ☐ Community Well
☐ Other _____

Minimum System Setbacks
Distance from Building Foundation: 5' feet
Distance from Property Line: 10' feet
Distance from Water Supply Source: 50' min feet

SKETCH OF SYSTEM LAYOUT
(Proposed Layout)

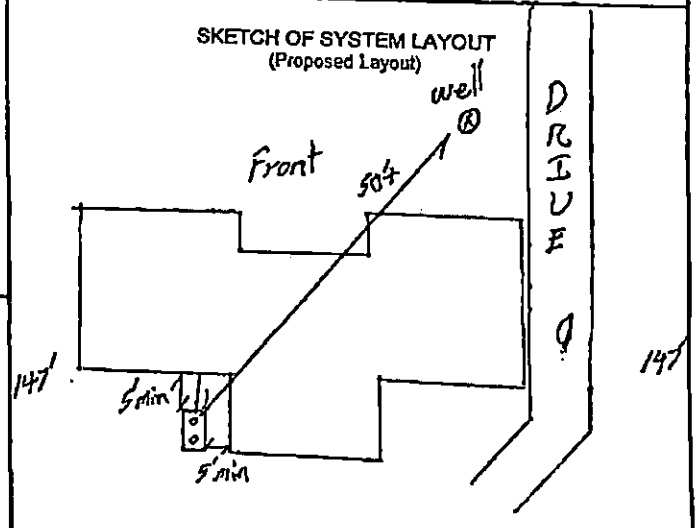

- Ensure tank (new) is 5' min from any foundation to include pilings.
- Pump & crush old tank. Replace w/new 1000 gal tank

Comments: System Classification & Type: Replace existing tank with new 1000 gal tank.

Authorized Agent: Bradley W. Hellman Signature: _____

Owner Signature: _____ Date: 4/19/17

Mecklenburg County Groundwater & Wastewater Services
700 N. Tryon St., Suite 211 Charlotte, NC 28202
Phone: (704) 336-5103 Fax: (704) 336-6894

NC DHHS
Division of Environmental Health
On-Site Wastewater Section

IMPROVEMENT PERMIT/CONSTRUCTION AUTHORIZATION for an ON-SITE WASTEWATER TREATMENT & DISPOSAL SYSTEM

File #: 9702B Permit #: 8856 Tax Parcel #: 113-163-26

Property Owner: Jeff Todd

Job Location Address: 9507 Brenda Ann Rd

City: Charlotte NC State: NC Zip Code: _____

Improvement Permit Issuance Date: ~~4/6/17~~ NA **Construction Authorization Issuance Date** 4/11/17

Permission is hereby given to ☒ install ☐ alter ☒ repair an on-site wastewater treatment & and disposal system, with subsurface soil absorption and effluent discharge, as specified herein at the described location. This permit is granted based upon the application information submitted to our office. This permit expires 5 years from the date it was issued. The system shall meet all of the construction requirements of 15A NCAC 18A. 1900 which are in effect on the date of granting this approval. An **Operation Permit** must be obtained from the Mecklenburg County Health Department before any system can be covered up or placed into service. The issuance of this permit does not in any way guarantee that the system anticipated to be constructed will operate properly, or relieve any person now of hereafter owning, controlling or using such system from any liability resulting from the failure of the system to operate properly.

***NOTICE: This system shall not be installed while soils are in a wet condition.**

Permitted Design Flow: 360 GPD Site LTAR: NA GPD/ft² (For new installations only.)

Liquid Capacity of Septic Tank: ~~Fee E~~ 1000 gal gallons Liquid Capacity of Dosing Tank: NA 200 gallons

Drainfield Design ☒ N/A

Trench Depth: _____ inches

Trench Width: _____ feet

Line Spacing: _____ feet (O.C.)

Total line length: _____ feet

# of Lines: _____ @ _____ feet

Depth of Media: _____ inches (Type) _____

Distribution Device: _____

Bed Design *(For Repair Installations.ONLY.)* ☒ N/A

Bed Depth: _____ inches

Bed Width: _____ feet

Total line length: _____ feet

# of Lines: _____ @ _____ feet

Depth of Media: _____ inches (Type) _____

Distribution Device: _____

Water Supply Source

☐ Municipal ☒ Private Well ☐ Community Well

☐ Other _____


Minimum System Setbacks

Distance from Building Foundation: 5' feet

Distance from Property Line: 10' feet

Distance from Water Supply Source: 50' min feet

SKETCH OF SYSTEM LAYOUT
(Proposed Layout)

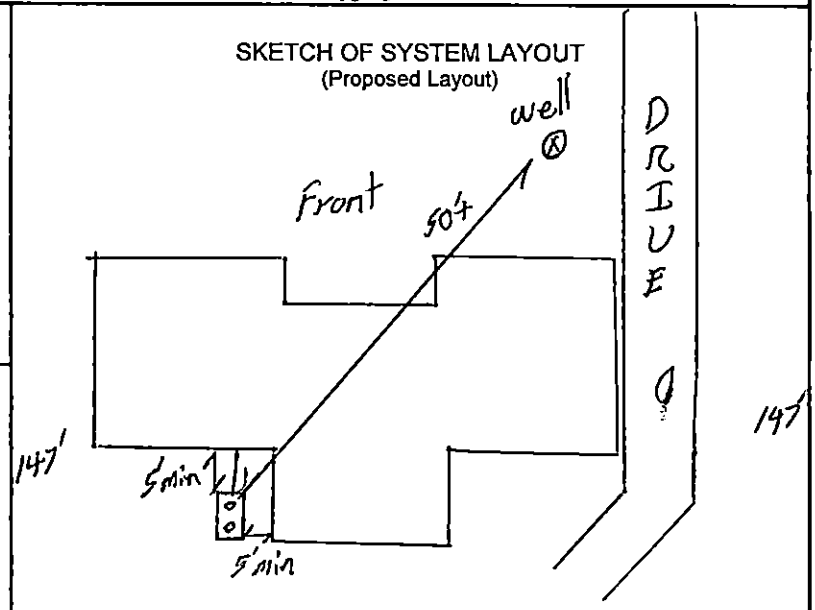

- Enswe tank (new) is 5' min from any foundation to include pilings.

- Pump & crush old tank. Replace w/new 1000 gal tank

Comments: System Classification & Type: Replace existing tank with new 1000 gal tank.

Authorized Agent: Bradley W. Hallman Signature: _____

Owner Signature: _____ Date: _____

Mecklenburg County Groundwater & Wastewater Services
700 N. Tryon St., Suite 211 Charlotte, NC 28202
Phone: (980) 314-1680 Fax: (704) 336-6894

NC DHHS
Division of Environmental Health
On-Site Wastewater Section

IMPROVEMENT PERMIT/CONSTRUCTION AUTHORIZATION for an ON-SITE WASTEWATER TREATMENT & DISPOSAL SYSTEM

File #: 9702B Permit #: 8856 Tax Parcel #: 113-163-26

Property Owner: Jeff Todd

Job Location Address: 9507 Brenda Ann

City: Charlotte State: NC Zip Code: 28214

Improvement Permit Issuance Date: 6/6/17 **Construction Authorization Issuance Date** 6/6/17

Permission is hereby given to ☒ install ☐ alter ☒ repair an on-site wastewater treatment & and disposal system, with subsurface soil absorption and effluent discharge, as specified herein at the described location. This permit is granted based upon the application information submitted to our office. This permit expires 5 years from the date it was issued. The system shall meet all of the construction requirements of 15A NCAC 18A. 1900 which are in effect on the date of granting this approval. An **Operation Permit** must be obtained from the Mecklenburg County Health Department before any system can be covered up or placed into service. The issuance of this permit does not in any way guarantee that the system anticipated to be constructed will operate properly, or relieve any person now of hereafter owning, controlling or using such system from any liability resulting from the failure of the system to operate properly.

***NOTICE: This system shall not be installed while soils are in a wet condition.**

Permitted Design Flow: 360 GPD

Site LTAR: .03 GPD/ft² (For new installations only.)

Liquid Capacity of Septic Tank: 1000 gallons

Liquid Capacity of Dosing Tank: NA gallons

Drainfield Design ☒ N/A

Trench Depth: ~~36"~~ inches

Trench Width: _____ feet

Line Spacing: _____ feet (O.C.)

Total line length: _____ feet

# of Lines: _____ @ _____ feet

Depth of Media: _____ inches (Type) _____

Distribution Device: _____

Bed Design *(For Repair Installations ONLY.)* ☐ N/A

Bed Depth: 36" inches

Bed Width: 10' feet

Total line length: 57' feet

# of Lines: 3 @ 57 feet

Depth of Media: 24" inches (Type) Tire Chip or IIa Stone #5

Distribution Device: D-Box

Water Supply Source

☐ Municipal ☒ Private Well ☐ Community Well


☐ Other _____

Minimum System Setbacks

Distance from Building Foundation: 5 feet

Distance from Property Line: 10' feet

Distance from Water Supply Source: 50' min feet

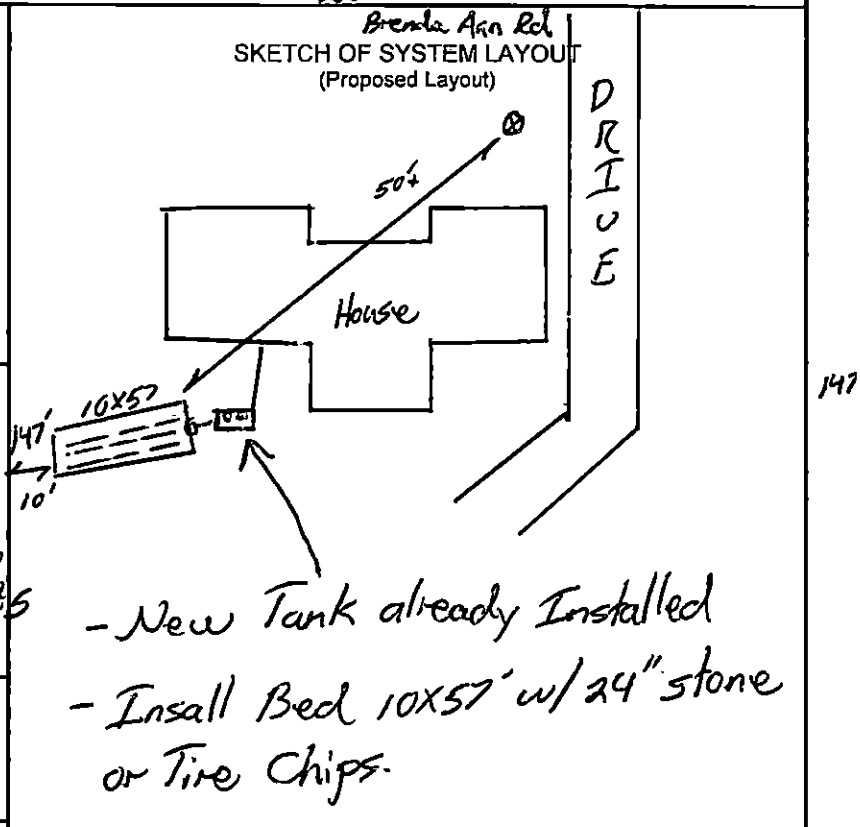

- New Tank already Installed
- Install Bed 10X57' w/ 24" stone or Tire Chips.

Comments: System Classification & Type: IIa (Tire chip or Stone) 190'

Authorized Agent: Bradley W. Hallman Signature: [signature]

Owner Signature: _____ Date: _____

Mecklenburg County Groundwater & Wastewater Services
700 N. Tryon St., Suite 211 Charlotte, NC 28202
Phone: (980) 314-1680 Fax: (704) 336-6894

NC DHHS
Division of Environmental Health
On-Site Wastewater Section

OPERATION PERMIT for an ON-SITE WASTEWATER TREATMENT & DISPOSAL SYSTEM

File #: 9702 B Permit #: 8856 Tax Parcel #: 113-163-26

Property Owner: Jeff Todd

Job Location Address: 9507 Brenda Ann Rd

City: Charlotte State: NC Zip Code: _____

Operation Permit Issuance Date: 6-2-17 Contractor Name: Rays

Permitted Design Flow: 360 GPD Liquid Capacity of Dosing Tank: N/A gallons

Liquid Capacity of Septic Tank: 1000 gallons Manufacture Rays STEP 1-25-17 Effluent Pump Model: N/A

Drainfield Installation ☒ N/A

Trench Depth: _____ inches

Trench Width: _____ feet

Line Spacing: _____ feet (O.C.)

Total line length: _____ feet

# of Lines: _____ @ _____ feet

Depth of Media: _____ inches (Type) _____

Depth of Cover: _____ inches

Distribution Device: _____

Bed Installation *(For Repair Installations ONLY.)* ☒ N/A

Bed Depth: 36" inches

Bed Width: 10' feet

Total line length: 58' feet

# of Lines: 3 @ 58 feet

Depth of Media: 12' inches (Type) Ia TCP

Depth of Cover: 12"+ inches

Distribution Device: D-Box

Water Supply Source

☐ Municipal ☒ Private Well ☐ Community Well

☐ Other _____

System Installation Setbacks

Distance from Building Foundation: 5'+ feet

Distance from Property Line: NA feet

Distance from Water Supply Source: 50'+ feet


Inspection Dates

Tank(s) Inspected: 6/2/17

Excavation Inspected: ~~N/A~~ 6/13/17

Pump & Controls Inspected: ~~N/A~~ _____

SKETCH OF SYSTEM INSTALLATION
(As-Built Drawing)

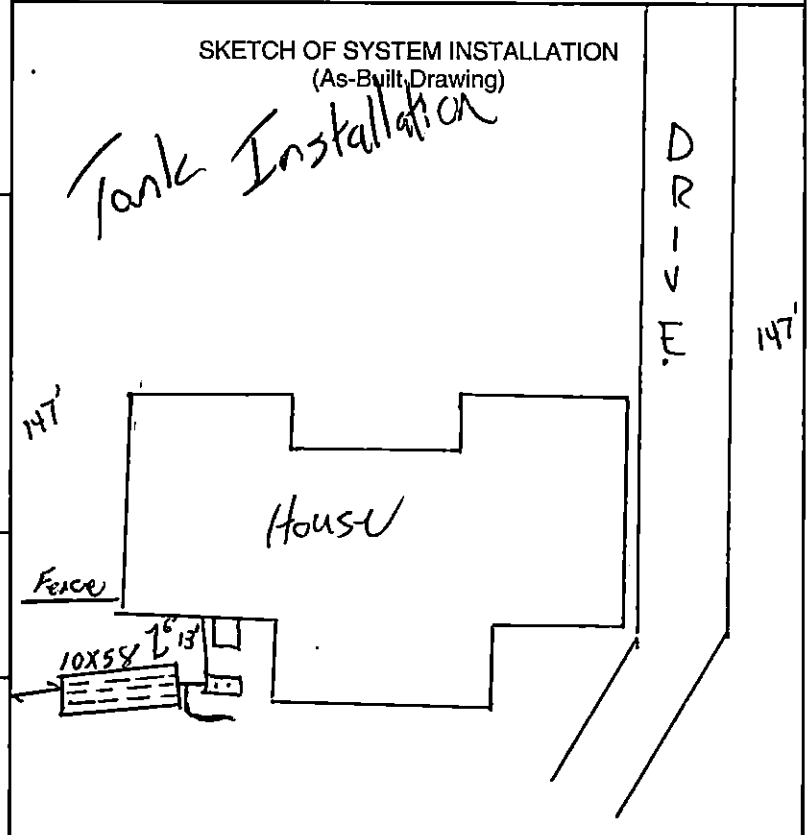

The undersigned has inspected the Septic Tank System described above, and certifies it has been ☐ installed ☐ altered ☐ repaired ☐ as detailed in the plot above ☐ in accordance with the permit issued and meets the provisions of 15A NCAC 18A. 1900, "Laws and Rules for Sewage Treatment and Disposal Systems" in effect on the date of issuance of the permit. The issuance of this Operation Permit does not in any way guarantee that the system will operate properly or relieve any person now or hereafter owning, controlling, or using such system from any liability resulting from the failure of the system to operate properly. This document is issued subject to those restrictions and conditions shown on the permit(s) and the provisions of 15A NCAC 18A. 1900 in addition to those listed below under "Comments." This document shall be null and void if any information contained in the application is untrue or if any additions are made to the property which would increase the requirements for said system.

Notice: Disturbance of the designated repair area may result in the Suspension or Revocation of this permit.

Comments: System Classification & Type: Ia TCP/G/NA/NA

DHHS Authorized Agent: April Bumgarner Signature: April Bumgarner

Bradley W. Hallman

Mecklenburg County Groundwater & Wastewater Services
700 N. Tryon St., Suite 211 Charlotte, NC 28202
Phone: (704) 336-5103 Fax: (704) 336-6894

NC DENR
Division of Environmental Health
On-Site Wastewater Section

OPERATION PERMIT for an
ON-SITE WASTEWATER TREATMENT & DISPOSAL SYSTEM

File #: 9702 B Permit #: 8856 Tax Parcel #: 113-163-26

Property Owner: Jeff Todd

Job Location Address: 9507 Brenda Ann Rd

City: Charlotte State: NC Zip Code: _____

OPERATION PERMIT CONDITIONS:

I. Performance: System shall perform in accordance with 15A NCAC 18A .1961.

II. Monitoring: System shall be monitored as required by 15A NCAC 18A .1961.

III. Maintenance: Ground absorption sewage treatment and disposal systems shall be checked, and the contents of the septic tank removed, periodically from all compartments, to ensure proper operation of the system. The contents shall be pumped whenever the solids level is found to be more than 1/3 of the liquid depth in any compartment.

IV. Operation: System shall be operated in accordance with 15A NCAC 18A .1961.

System Classification: IIa ICP

*Operation Permits for Type V and VI systems expire five (5) years from the date of issuance (in accordance with Table V(a)). The system owner must contact GWS six (6) months prior to expiration for permit renewal.

Subsurface system operator required: Yes ☐ No ☒

☐ This type of system requires the system owner to maintain a contract with a certified operator to perform system inspection, maintenance, and reporting as required in 15A NCAC 18A .1961. and Table V(a). The system owner is responsible for all fees associated with these services.

☒ System does not require inspection by GWS on a routine frequency.

☐ System requires inspection by GWS once every five (5) years. The system owner is responsible for all fees associated with the inspection.

☐ System requires inspection by GWS once every three (3) years. The system owner is responsible for all fees associated with the inspection.

☐ System requires inspection by GWS once every twelve (12) months. The system owner is responsible for all fees associated with the inspection.

☐ System requires inspection by GWS once every six (6) months. The system owner is responsible for all fees associated with the inspection.

V. Other:

_____

_____

_____

_____

DENR Authorized Agent: Bradley W. Hallman Date: 6/13/17

Signature: _____