

5109 LEBANON RD

13531210

1/11/2008

duponbj

Groundwater and Wastewater Services File Imaging Project
May 2007
Barcode Font = IDAutomationHC39M

FILE NUMBER: 7158B

SEPTIC FEE: _____
DATE: _____

Revised On: January 3, 2007

APPLICATION NUMBER: 2353

MECKLENBURG COUNTY GROUNDWATER & WASTEWATER SERVICES
APPLICATION FOR A RESIDENTIAL SITE IMPROVEMENT PERMIT/ CONSTRUCTION AUTHORIZATION FOR AN ON-SITE WASTEWATER SYSTEM, NEW WELL INSTALLATION, OR REPAIR OF EXISTING WELL

WELL FEE: _____
DATE: _____

1. SEPTIC / TYPE APPLICATION: ☐ NONE ☐ NEW SYSTEM ☐ ALTERATION ☒ REPAIR ☐ MODIFIED PLOT PLAN

2. WELL / TYPE APPLICATION: ☐ NONE ☐ NEW WELL ☐ MAJOR REPAIR ☐ ABANDONMENT

3. JOB LOCATION INFORMATION:

TAX PARCEL NUMBER: 135-312-10
STREET ADDRESS: 5169 Leberon Rd.
CITY: Mint Hill
STATE: NC ZIP:
SUBDIVISION NAME:
LOT #: LOT SIZE (acres): 1970
TOWNSHIP:

☐ 0-MECKLENBURG ☐ 3-CORNELIUS ☐ 6-HUNTERSVILLE
☐ 1-CHARLOTTE ☐ 4-PINEVILLE ☒ 7-MINT HILL
☐ 2-DAVIDSON ☐ 5-MATTHEWS

4. BUILDING INFORMATION:

BUILDING TYPE:

☐ SINGLE MOBILE HOME ☐ MODULAR HOME
☐ DOUBLE WIDE ☐ MULTIPLE FAMILY
☐ HOUSE ☐ OTHER _____

HEATED SQUARE FOOTAGE: 4
NUMBER OF BEDROOMS: 3
NUMBER OF OCCUPANTS:

FOUNDATION TYPE:

☐ CONCRETE SLAB ☐ BASEMENT WITH PLUMBING
☒ CRAWL SPACE ☐ BASMENT WITH NO PLUMBING

5. IF PLANNING TO EXPAND OR ALTER THE EXISTING SYSTEM PLEASE COMPLETE THE FOLLOWING SECTION: ☐ N/A

NUMBER OF BEDROOMS TO BE ADDED: _____ NUMBER OF ADDITIONAL OCCUPANTS IN THE RESIDENCE: _____

6. WATER SUPPLY: ☒ MUNICIPAL ☐ PUBLIC WELL ☐ PRIVATE WELL ☐ SHARED WELL ☐ SPRING

7. PROPOSED USE OF WELL: ☐ N/A ☐ IRRIGATION ☐ POTABLE ☐ GEOTHERMAL ☐ OTHER

8. PLEASE INDICATE AND RANK DESIRED SEPTIC SYSTEM TYPE(S) IN ORDER OF PREFERENCE *(1-MOST DESIRED 5-LEAST DESIRED)*:

8A. RANK: ☒ ANY TYPE ☐ CONVENTIONAL ☐ ACCEPTED ☐ INNOVATIVE ☐ ALTERNATIVE ☐ OTHER _____

9. DO ANY OF THE FOLLOWING APPLY TO THE PROPERTY IN QUESTION? IF "YES" PLEASE ATTACH SUPPORTING DOCUMENTATION.

BURIED CABLES, LANDFILLS, STUMPHOLES	☐ YES	☒ NO	GRADING/SOIL REMOVAL PERFORMED	☐ YES	☒ NO
EXISTING WASTEWATER SYSTEMS	☒ YES	☐ NO	JURISDICTIONAL WETLANDS	☐ YES	☒ NO
WELLS, SPRINGS, OR WATER LINES	☐ YES	☒ NO	APPROVAL REQUIRED BY ANY OTHER PUBLIC AGENCY	☐ YES	☒ NO
EASEMENTS OR RIGHT-OF-WAYS	☐ YES	☒ NO	WASTEWATER OTHER THAN DOMESTIC SEWAGE	☐ YES	☒ NO

10. PROPERTY OWNER:

NAME: Larry Klutz
ADDRESS: 5169 Leberon Rd.
CITY: Mint Hill
STATE: ZIP:
HOME PHONE: WORK PHONE:
MOBILE PHONE: FAX:

11. OWNER'S LEGAL REPRESENTATIVE, IF APPLICABLE:

NAME:
ADDRESS:
CITY:
STATE: ZIP:
HOME PHONE: WORK PHONE:
MOBILE PHONE: FAX:

12. WHAT DATE WAS THE PROPERTY ORIGINALLY DEEDED AND RECORDED? _____

13 WHAT IS THE ANTICIPATED CLOSING DATE FOR THIS PROPERTY? _____

14. SEPTIC SYSTEM PERMIT APPLICATION SIGNATURE SECTION:

If the information in this application is falsified, changed, or the site is altered, then the Improvement Permit and Authorization to Construct shall become invalid. I have read this application and certify that the information provided herein is true, complete and correct. Authorized county and state officials are granted right of entry to conduct necessary inspections to determine compliance with applicable laws and rules. I understand that I am solely responsible for the proper identification and labeling of all property lines and corners and making the site accessible so that a complete site evaluation can be performed. The permit is valid for either 60 months or is non-expiring depending upon the documentation submitted: complete site plan = 60 months, complete plat = non-expiring.

[signature] 5.14.07

Property Owner's or Owner's Legal Representative Signature Date

15. WELL PERMIT APPLICATION SIGNATURE SECTION:

If the information in this application is falsified, changed, or the site is altered, then the Well Permit shall become invalid. I have read this application and certify that the information provided herein is true, complete and correct. Authorized county and state officials are granted right of entry to conduct necessary inspections to determine compliance with applicable laws and rules. I understand that I am solely responsible for the proper identification and labeling of all property lines and corners and making the site accessible so that a complete site evaluation can be performed. The permit is valid for a period of 12 months from the date of issuance.

Property Owner's or Owner's Legal Representative Signature Date

☐ SURVEY PLAT TO SCALE SUBMITTED ☐ SCALED SITE PLAN SUBMITTED ☐ UN-SCALED SITE PLAN SUBMITTED

MECKLENBURG COUNTY-GROUNDWATER & WASTEWATER SERVICES
700 N. TRYON ST., SUITE 211, CHARLOTTE, NC 28202 PHONE: (704) 336-5103 FAX: (704) 336-6894

Mecklenburg County Groundwater & Wastewater Services
700 N. Tryon St., Suite 211 Charlotte, NC 28202
Phone: (704) 336-5103 Fax: (704) 336-6894

NC DENR
Division of Environmental Health
On-Site Wastewater Section

INSTALLATION APPROVAL for an ON-SITE WASTEWATER TREATMENT & DISPOSAL SYSTEM

File #: 7158B Permit #: _____ Tax Parcel #: 135-312-10

Property Owner: _____

Job Location Address: 5109 Lebanon Rd.

City: Mt Holly State: NC Zip Code: _____

Installation Approval Issuance Date: 5-15-07

Permission is hereby given to ☐ install ☐ alter ☒ repair an on-site wastewater treatment & and disposal system, with subsurface soil absorption and effluent discharge, as specified herein at the described location. This approval is granted based upon the application information submitted to our office. All work shall be completed on or before 6-15-07, after which date this approval shall be null and void. The system shall meet all of the construction requirements of 15A NCAC 18A. 1900 which are in effect on the date of granting this approval. An **Operation Permit** must be obtained from the Mecklenburg County Health Department before any system can be covered up or placed into service. The issuance of this permit does not in any way guarantee that the system anticipated to be constructed will operate properly, or relieve any person now of hereafter owning, controlling or using such system from any liability resulting from the failure of the system to operate properly.

***NOTICE: This system shall not be installed while soils are in a wet condition.**

Permitted Design Flow: 3 GPD

Site LTAR: N/A GPD/ft² (For new installations only.)

Liquid Capacity of Septic Tank: ~~Existing~~ Wash Box gallons

Liquid Capacity of Dosing Tank: _____ gallons

Drainfield Design ☒ N/A

Trench Depth: _____ inches

Trench Width: _____ feet

Line Spacing: _____ feet (O.C.)

Total line length: _____ feet

# of Lines: _____ @ _____ feet

Depth of Media: _____ inches (Type) _____

Distribution Device: _____

Bed Design *(For Repair Installations ONLY.)* ☐ N/A

Bed Depth: 30 inches

Bed Width: 6 feet

Total line length: 60 feet

# of Lines: 1 @ 60 feet

Depth of Media: 12 inches (Type) E2 Flow or Hardee

Distribution Device: Wash Box

Water Supply Source

☒ Municipal ☐ Private Well ☐ Community Well

☐ Other _____


Minimum System Setbacks

Distance from Building Foundation: 10 feet

Distance from Property Line: 10 feet

Distance from Water Supply Source: 10 feet

SKETCH OF SYSTEM LAYOUT
(Proposed Layout)

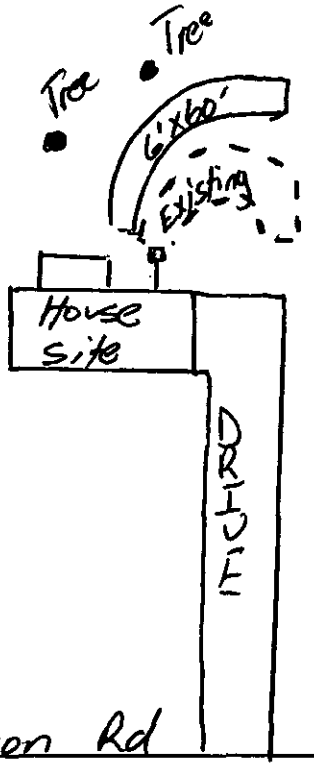

Comments: System Classification & Type: III g Wash Line

DENR Authorized Agent: Jeremy Michael Signature: Jeremy Michael

Mecklenburg County Groundwater & Wastewater Services
700 N. Tryon St., Suite 211 Charlotte, NC 28202
Phone: (704) 336-5103 Fax: (704) 336-6894

NC DENR
Division of Environmental Health
On-Site Wastewater Section

OPERATION PERMIT for an ON-SITE WASTEWATER TREATMENT & DISPOSAL SYSTEM

File #: 7158B Permit #: _____ Tax Parcel #: 135-312-10

Property Owner: _____

Job Location Address: ~~7305 Idlewild Rd~~, 5109 Lebanon Rd.

City: Mint Hill State: _____ Zip Code: _____

Operation Permit Issuance Date: 5-15-07 Contractor Name: Steve Autry

Permitted Design Flow: 360 GPD

Liquid Capacity of Septic Tank: Existing gallons

Liquid Capacity of Dosing Tank: _____ gallons

Effluent Pump Model: _____

Drainfield Installation ☒ N/A

Trench Depth: _____ inches

Trench Width: _____ feet

Line Spacing: _____ feet (O.C.)

Total line length: _____ feet

# of Lines: _____ @ _____ feet

Depth of Media: _____ inches (Type) _____

Depth of Cover: _____ inches

Distribution Device: _____

Inspection Dates

Tank(s) Inspected: N/A

Excavation Inspected: 5-15-07

Pump & Controls Inspected: _____

Bed Installation *(For Repair Installations ONLY.)* ☐ N/A

Bed Depth: 20 inches

Bed Width: 6 feet

Total line length: 60 feet

# of Lines: 1 @ 60 feet

Depth of Media: 12 inches (Type) EZ Flow

Depth of Cover: 18 inches

Distribution Device: D-Box

Water Supply Source

☒ Municipal ☐ Private Well ☐ Community Well

☐ Other _____


System Installation Setbacks

Distance from Building Foundation: 10' feet

Distance from Property Line: 10' feet

Distance from Water Supply Source: 10' feet

SKETCH OF SYSTEM INSTALLATION
(As-Built Drawing)

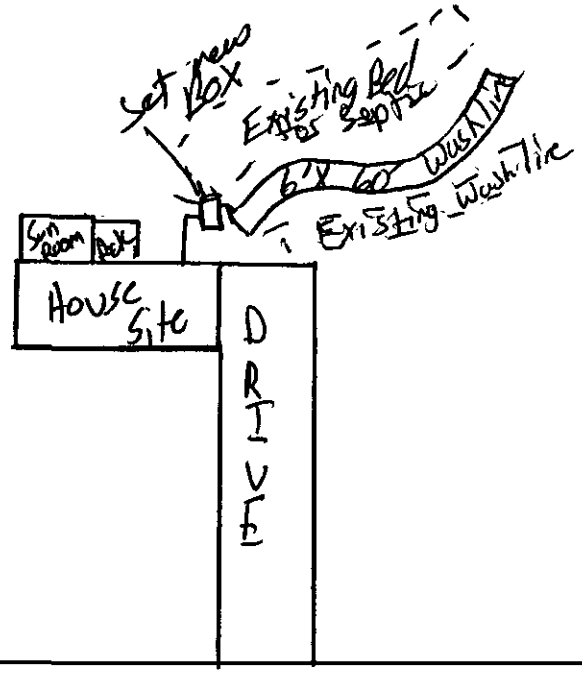

☒ The undersigned has inspected the Septic Tank System described above, and certifies it has been ☐ installed ☐ altered ☒ repaired ☒ as detailed in the plot above ☐ in accordance with the permit issued and meets the provisions of 15A NCAC 18A. 1900, "Laws and Rules for Sewage Treatment and Disposal Systems" in effect on the date of issuance of the permit. The issuance of this Operation Permit does not in any way guarantee that the system will operate properly or relieve any person now or hereafter owning, controlling, or using such system from any liability resulting from the failure of the system to operate properly. This document is issued subject to those restrictions and conditions shown on the permit(s) and the provisions of 15A NCAC 18A. 1900 in addition to those listed below under "Comments." This document shall be null and void if any information contained in the application is untrue or if any additions are made to the property which would increase the requirements for said system.

Notice: Disturbance of the designated repair area may result in the Suspension or Revocation of this permit.

Comments: System Classification & Type: III g Wash line

DENR Authorized Agent: Jeremy Michael Signature: Jeremy Michael