FEE: 100.00 VPW CD # 297273
DATE: 6/19/09
CRT I 1

APPLICATION FOR APPROVAL TO USE AN EXISTING ON-SITE WASTEWATER TREATMENT & DISPOSAL SYSTEM
MECKLENBURG COUNTY - GROUNDWATER & WASTEWATER SERVICES
700 N. Tryon St., Suite 211 Charlotte, NC 28202
Phone: (704) 336-5103 Fax: (704) 336-6894

GWS – UES.APP 09/07

FILE #: 6131B

TYPE APPLICATION: PW 4257

- ☐ ADDITION - INCREASE ROOMS/OCCUPANCY/MOBILE HOME SIZE (A / M)
- ☐ ADDITION - RENOVATION OR GARAGE WITH NO MAJOR CHANGES (X)
- ☐ EXCHANGE MOBILE HOME - SAME # BEDROOMS (Y)
- ☐ COMMERCIAL OR INDUSTRIAL (N)

PERSON FILING APPLICATION:
NAME: JAMES K. ASHFORD JR
ADDRESS: 11410 LAUREN LN.
CITY: DAVIDSON
STATE: NC ZIP: 28036
PHONE: 704-895-0707
ALTERNATE PHONE: 704-650-5000

PROPERTY OWNER:
NAME: (SAME)
ADDRESS:
CITY:
STATE: ZIP:
PHONE:
ALTERNATE PHONE:

JOB LOCATION INFORMATION
TAX/PARCEL #: 00716241
STREET ADDRESS: (SAME)
CITY:
STATE: NC ZIP:
SUBDIVISION OR MOBILE HOME PARK NAME:
LOT #: 3 2006

TOWNSHIP:
- ☐ 0-MECKLENBURG
- ☐ 1-CHARLOTTE
- ☒ 2-DAVIDSON
- ☐ 3-CORNELIUS
- ☐ 4-PINEVILLE
- ☐ 5-MATTHEWS
- ☐ 6-HUNTERSVILLE
- ☐ 7-MINT HILL

WATER SUPPLY:
- ☐ MUNICIPAL (M)
- ☐ COMMUNITY (C)
- ☒ PRIVATE WELL (P)
- ☐ SHARED WELL (S)
- ☐ OTHER 'SPRINGS' (O)

RESIDENTIAL PROPERTY TYPE:
- ☒ HOUSE (H)
- ☐ MODULAR HOME (M)
- ☐ MULTIPLE FAMILY (U)
- ☐ SINGLE MOBILE HOME (S)
- ☐ DOUBLE WIDE (D)
- ☐ OTHER (O)

OCCUPANCY (both fields are required):
NUMBER OF BEDROOMS: 4
NUMBER OF OCCUPANTS: 4

COMMERCIAL / INDUSTRIAL PROPERTY TYPE:
TYPE OF BUSINESS:
EMPLOYEES PER SHIFT:
OF SHIFTS:
INDUSTRIAL WASTES? ☐ YES ☐ NO
UNDERGROUND STORAGE TANKS? ☐ YES ☐ NO

ADDITION TYPE ATTACHED TO EXISTING STRUCTURE:
- ☐ BEDROOM
- ☐ BATHROOM
- ☐ KITCHEN
- ☐ DINING ROOM
- ☐ LIVING ROOM
- ☐ DEN
- ☐ GARAGE
- ☐ SUNROOM
- ☐ PORCH
- ☒ DECK
- ☐ OTHER

ADDITION TYPE DETACHED FROM EXISTING STRUCTURE:
- ☐ DETACHED GARAGE
- ☐ DETACHED GARAGE WITH PLUMBING
- ☐ POOL HOUSE
- ☐ SHOP
- ☐ BARN
- ☐ STORAGE SHED
- ☐ DETACHED PORCH / DECK
- ☐ OTHER

*The undersigned, owner, or legal agent for the owner, of the property described above as the "Job Location" has read the foregoing application, acknowledges that the contents of same are true, and authorizes the Mecklenburg County Health Department to enter onto the property for the purpose of processing this request.

Owner's/Agent's Signature — Date: 6-19-09

*The undersigned, an authorized agent of the Mecklenburg County Health Department, certifies that the Department has approved the Request for the Job Location contained in this document. This approval is granted in accordance with the provisions of Laws and Rules for Sanitary Sewage Collection, Treatment and Disposal in effect at the time of issuance of the permit and is subject to the following provisions:

- No work shall be conducted on the septic tank system until an installation, construction, alteration and/or repair approval is granted y this Department.
- This permit is not transferable.

☐ ADDITION / RENOVATION APPROVAL - VALID 1 YEAR FROM ISSUANCE
☐ MOBILE HOME EXCHANGE APPROVAL - VALID 6 MONTHS FROM ISSUANCE


Approval for deck addition
use existing system
Phil Walker RS 6/26/09
EHS Signature — Date

Mecklenburg County
Land Use & Environmental Service Agency
Groundwater & Wastewater Services
700 N. Tryon St., Suite 211
Charlotte, NC 28202
Phone: (704) 336-5103
Fax: (704) 336-6894

File # 6131B
Date _____

PROPOSED PLOT PLAN

A map showing existing and proposed property lines and easements with dimensions, the location of the single family residence, non-single family residence, or other facility, and appurtenances, the site for the proposed well, and the location of existing or proposed sewer lines and/or sewage disposal systems, surface water bodies, aboveground or underground storage tanks. Name all roads adjoining the property. If this a repair indicate the type of repair.

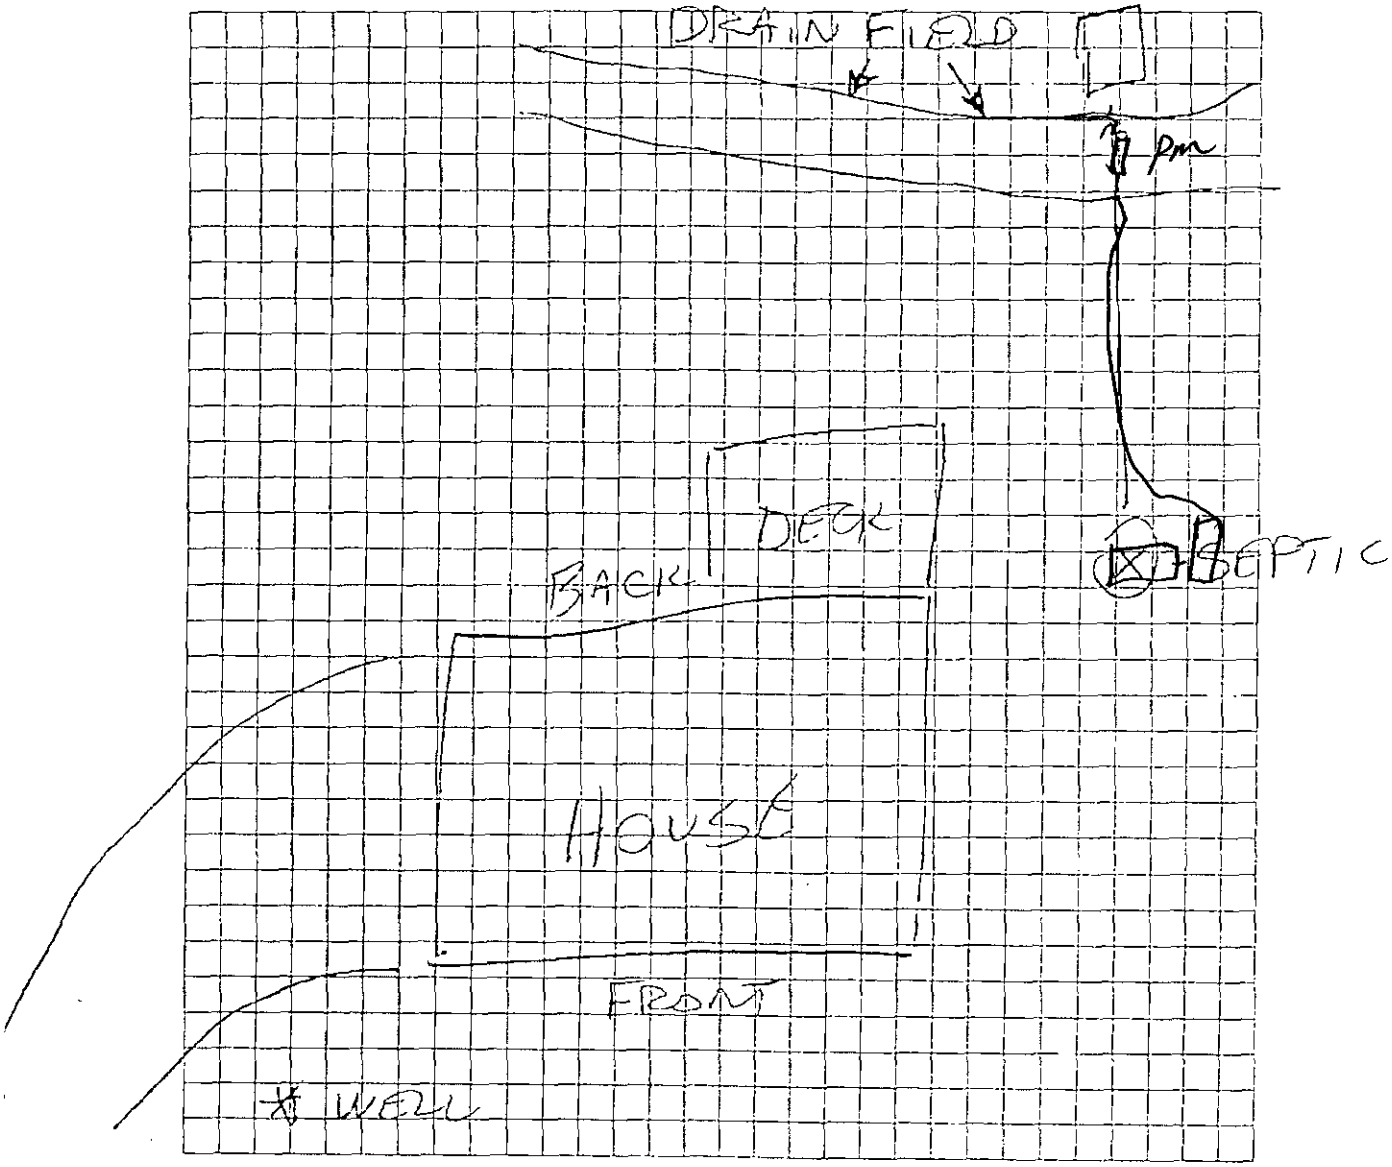

Owner/Agent Signature James K Cox
Date 6-19-09

LBC 12/15/04

Application #354

GWS – RES. APP 07/05

SEPTIC FEE
DATE: 2.16.06
CRT #: 1180

PERMIT APPLICATION FOR A RESIDENTIAL SITE IMPROVEMENT PERMIT / CONSTRUCTION AUTHORIZATION FOR ON-SITE WASTEWATER SYSTEM NEW WELL INSTALLATION OR REPAIR OF EXISTING WELL MECKLENBURG COUNTY GROUNDWATER & WASTEWATER SERVICES

FILE # 61318

WELL FEE
DATE: 2.16.06
CRT #: 1180

SEPTIC / TYPE APPLICATION: ☐ NONE ☒ NEW SYSTEM ☐ ALTERATION ☐ REPAIR ☐ MODIFY PLO™ PLAN

WELL / TYPE APPLICATION: ☐ NONE ☒ NEW WELL ☐ MAJOR REPAIR ☐ ABANDONMENT

JOB LOCATION INFORMATION:

TAX/PARCEL #: 007-162-12
STREET ADDRESS: 11410 Lauren Lane
CITY: Davidson
STATE: NC ZIP: 28036
SUBDIVISION OR MOBILE HOME PARK NAME: Royal Oaks
LOT #: 3
TOWNSHIP:

☒ 0-MECKLENBURG ☐ 4-PINEVILLE
☐ 1-CHARLOTTE ☐ 5-MATTHEWS
☐ 2-DAVIDSON ☐ 6-HUNTERSVILLE
☐ 3-CORNELIUS ☐ 7-MINT HILL

BUILDING INFORMATION:

TYPE OF BUILDING:

☐ SINGLE MOBILE HOME (S) ☐ MODULAR HOME (M)
☐ DOUBLE WIDE (D) ☐ MULTIPLE FAMILY (U)
☒ HOUSE (H) ☐ OTHER

HEATED SQUARE FOOTAGE: 4200
NUMBER OF BEDROOMS: 4
NUMBER OF OCCUPANTS: 4

FOUNDATION FOR RESIDENCE:

☐ CONCRETE SLAB ☐ BASEMENT WITH PLUMBING
☐ CRAWLSPACE ☒ BASEMENT WITH NO PLUMBING

IF PLANNING TO EXPAND/ALTER THE EXISTING SYSTEM INDICATE THE FOLLOWING CHANGES:

NUMBER OF BEDROOMS TO BE ADDED: NUMBER OF ADDITIONAL OCCUPANTS IN THE RESIDENCE:

WILL THERE BE A HOME BUSINESS IN THE RESIDENCE? ☐ YES ☐ NO TYPE:

WATER SUPPLY:

☐ MUNICIPAL (M) ☐ PUBLIC (C) ☒ PRIVATE WELL (P) ☐ SHARED WELL (S) ☐ OTHER 'SPRINGS' (O)

PROPOSED USE OF WELL: ☐ N/A ☐ IRRIGATION ☒ POTABLE ☐ GEOTHERMAL ☐ OTHER

ARE ANY OF THE FOLLOWING LOCATED ON THE PROPERTY? IF SO, PLEASE SHOW LOCATION ON SITE PLAN/PLAT.

BURIED CABLES, LANDFILLS, STUMPHOLES	☐ YES ☒ NO	WELLS, SPRINGS, OR WATER LINES	☐ YES ☒ NO
EXISTING WASTEWATER SYSTEMS	☐ YES ☒ NO	DESIGNATED WETLANDS	☐ YES ☒ NO
EASEMENTS OR RIGHT-OF-WAYS	☒ YES ☐ NO	GRADING/SOIL REMOVAL PERFORMED	☐ YES ☒ NO

PROPERTY OWNER:

NAME: Royal Building Co.
ADDRESS: 19525 Calloway Hills Ln.
CITY: Davidson
STATE: NC ZIP: 28036
HOME PHONE: WORK PHONE: 704-201-5705
MOBILE PHONE: FAX: 704-895-1325

LEGAL AGENT FOR PROPERTY OWNER, IF APPLICABLE:

NAME:
ADDRESS:
CITY:
STATE: ZIP:
HOME PHONE: WORK PHONE:
MOBILE PHONE: FAX:

WHAT DATE WAS THE PROPERTY ORIGINALLY DEEDED AND RECORDED?

WHAT IS THE ANTICIPATED CLOSING DATE FOR THIS PROPERTY?

*An Improvement Permit is subject to suspension or revocation if site plans or the intended use change or if information submitted in this application is falsified or changed. The undersigned, owner, or legal agent for the owner, of the property described above as the "Job Location" has read the foregoing application, acknowledges that the contents of same are true, and authorizes the Mecklenburg County Health Department to enter onto the property for the purpose of processing this request.

2/6/06
Owner's/Agent's Signature Date

NORTH CAROLINA DEPARTMENT OF
ENVIRONMENT & NATURAL RESOURCES DIVISION
OF ENVIRONMENTAL HEALTH ON-SITE
WASTEWATER SECTION

*A Well Permit is subject to suspension or revocation if site plans or the intended use change or if information submitted in this application is falsified or changed. The undersigned, owner, or legal agent for the owner, of the property described above as the "Job Location" has read the foregoing application, acknowledges that the contents of same are true, and authorizes the Mecklenburg County Health Department to enter onto the property for the purpose of processing this request.

Owner's/Agent's Signature Date

MECKLENBURG COUNTY HEALTH DEPARTMENT
GROUNDWATER & WASTEWATER SERVICES
700 N. TRYON ST., SUITE 211
CHARLOTTE, NC 28202 704-336-5103 / FAX: 704-336-6894

Feb 08 2006 1:36PM LUESA NORTH 704 432 2523 p.1

change in plot!


Mecklenburg County
Land Use & Environmental Service Agency
Groundwater & Wastewater Services
700 N. Tryon St., Suite 211
Charlotte, NC 28202
Phone: (704) 336-5103
Fax: (704) 336-8894

File #_____
Date_____

PROPOSED PLOT PLAN

9

A map showing existing and proposed property lines and easements with dimensions, the location of the single family residence, non-single family residence, or other facility, and appurtenances, the site for the proposed well, and the location of existing or proposed sewer lines and/or sewage disposal systems, surface water bodies, aboveground or underground storage tanks. Name all roads adjoining the property. If this a repair indicate the type of repair.

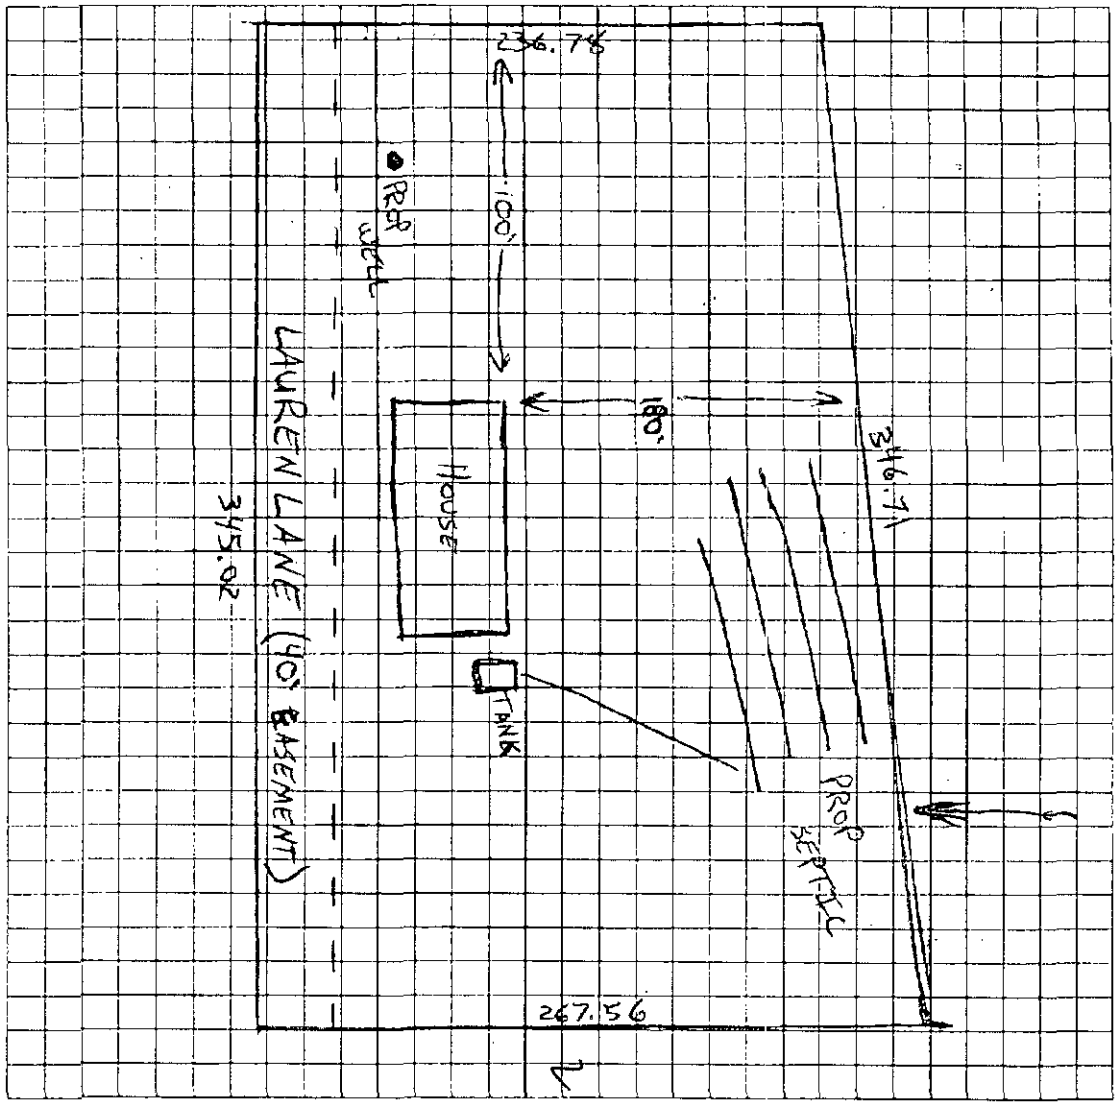

Owner/Agent Signature	
Date	2/6/06

LBC 12/15/04

291/552 4/18

1436 291/727

291 291/582

Department of Environment, Health, and Natural Resources
Division of Environmental Health
On-site Wastewater Section

Sheet: 1 of 2
Property ID: PO 007-162-12
Lot #: 3
File #: 6131B
Code: 1

SOIL/SITE EVALUATION
for ON-SITE WASTEWATER SYSTEM

Owner: Royal Building Co. Applicant:
Address: 19525 Callaway Hills Lane, Davidson, N. C. 28036 Date Evaluated: 9/14/04
Proposed Facility: Residence Design Flow (.1949): 480gpd Property Size: 1.99a
Location of Site: Off Mayes Road Property Recorded:
Water Supply: [ ] Public [x] Individual [x] Well [ ] Spring [ ] Other
Evaluation Method: [x] Auger Boring [ ] Pit [ ] Cut
Type of Wastewater: [x] Sewage [ ] Industrial Process [ ] Mixed

PROFILE #	1940 Landscape Position/ Slope%	Horizon Depth (IN.)	SOIL MORPHOLOGY 1941 Structure/ Texture	SOIL MORPHOLOGY 1941 Consistence Mineralogy	OTHER PROFILE FACTORS 1942 Soil Wetness/ Color	1943 Soil Depth (IN.)	1956 Sapro Class	1944 Restr Horiz	Profile Class & LTAR
1	LS, 10	0-10	GR/SCL	FR/SEXP/SS/SP	>48" TO SOIL WETNESS	48	N/A	NONE	PS, IV
		10-25	SBK/C	FI/SEXP/S/P					.3GPD/FT^2
		25-48	SBK/CL	FR/SEXP/SS/SP					
2	LS, 15	0-9	GR/CL	"	>32" TO SOIL WETNESS	32	"	"	US, IV
		9-32	SBK/C	FI/SEXP/S/P					.25GPD/FT^2
3	LS, 10	0-8	GR/SCL	FR/SEXP/SS/SP	>44" TO SOIL WETNESS	44	"	"	"
		8-26	SBK/C	FI/SEXP/S/P					
		26-44	SBK/CL	FR/SEXP/SS/SP					

Description	Initial System	Repair System
Available Space (.1945)	PS	PS
System Type(s)	T	T
Site LTAR	.275GPD/FT^2	.275GPD/FT^2

Other Factors (.1946):
Site Classification (.1948): PROVISIONALLY SUITABLE
Evaluated By: W. R. Marlin, LSS, 9/15/2005, W. R. Marlin
Others Present: C. Sherrill, K. Stoddard


COMMENTS:
100% repair

Landscape Position	Group	Texture	.1955 LTAR	Structure
R-Ridge	I	S-Sand	1.2 - 0.8	SG-Single Grain
SS-Shoulder Slope		LS-Loamy Sand		M-Massive
LS-Linear Slope				CR-Crumb
FS-Food Slope	II	SL-Sandy Loam	0.8 - 0.6	GR-Granular
NS-Nose Slope		L-Loam		SBK-Subangular Blocky
HS-Head Slope				ABK-Angular Blocky
CC-Concave Slope	III	SI-Silt	0.6 - 0.3	PL-Platy
CV-Convex Slope		SICL-Silty Clay Loam		PR-Prismatic
T-Terrace		CL-Clay Loam		
FP-Flood Plain		SCL-Sandy Clay Loam		
	IV	SC-Sandy Clay	0.4 - 0.1	
		SIC-Silty Clay		
		C-Clay		

436 - INV
291 - PANEL
727

Consistence Moist	Consistence Wet	Mineralogy
VFR-Very Friable	NS-Non-Sticky	SEXP-Slightly Expansive
FR-Friable	SS-Slightly Sticky	EXP-Expansive
FI-Firm	S-Sticky	
VFI-Very Firm	VS-Very Sticky	
EFI-Extremely Firm	NP-Non-Plastic	
	SP-Slightly Plastic	
	P-Plastic	
	VP-Very Plastic	

Sketch of Soil Evaluation Locations

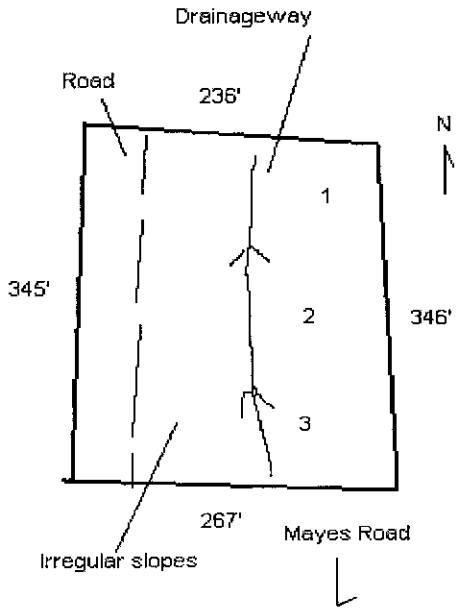

PROPOSED PLOT PLAN

HEALTH DEPARTMENT
ENVIRONMENTAL HEALTH DIVISION
700 NORTH TRYON ST., SUITE 211
CHARLOTTE, NC 28202
PHONE (704) 336-5103

FILE: 6131 B

TC: 00716212

Draw in and name all roads adjoining the property. Draw in and accurately dimension the lot concerned. Accurately indicate property boundaries proposed and/or existing structures and driveways, underground utilities, and wells and springs within 100 feet of the proposed building or drainfield.


1" = 60'

11410 Lauren Lane (Lot 3)

- System design flow = 480 GPD
- Site LTAR .275
- Type III bg innovation system
- 1500 gallon septic tank
- 1000 gallon pump tank
- drop boxes

- 3 lines @ 90', 146', 200'
- lines level and on contour
- Repair will require Type IV a pressurized panel block system

Setbacks
10' from all property lines
15' from basement foundation
100' (150' any) from any private well

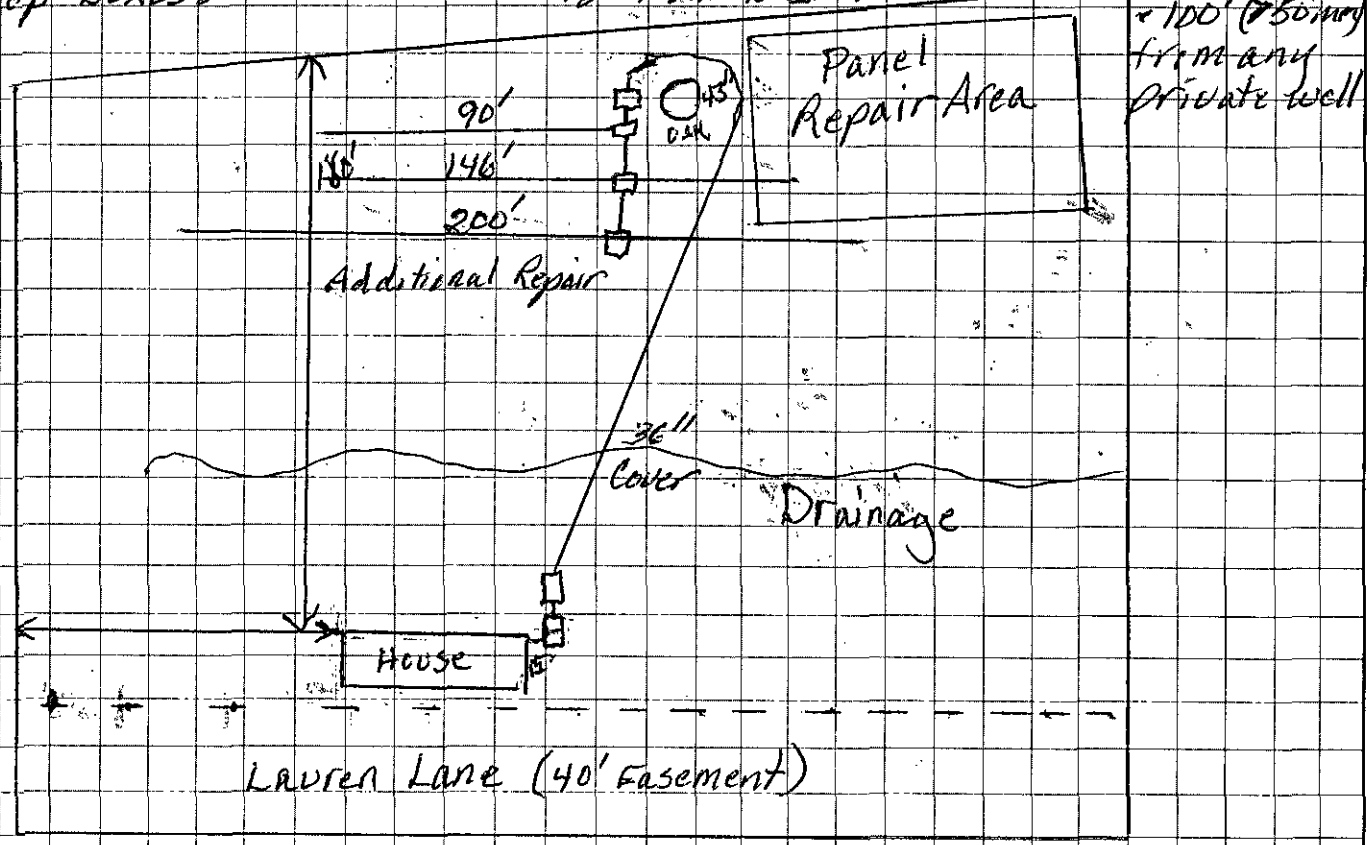

APPLICANT/AGENT SIGNATURE
3-6-06

APPROVAL DATE Cina Buchanan, RS
2/28/06

Health Department's Copy | Canary - E.H.S. Copy | Pink - Owner's Copy

CONDITIONS OF IMPROVEMENT PERMIT / CONSTRUCTION AUTHORIZATON

Permit Number: **6131B** Tax Number: **00716212**

- The IMPROVEMENT PERMIT is subject to revocation if site plans or the intended use change. There is to be **NO** grading, filling, or disturbance of the soil in the area of the septic tank system or repair area.
- CONSTRUCTION AUTHORIZATION must be obtained prior to receiving a Building Permit. The Construction Authorization is **NOT** transferable. Do not clear, grade, fill or disturb soil prior to obtaining a Construction Authorization.
- Domestic-type wastewater only. No industrial process wastewater may be discharged into the system.

Basement: ☒ Yes ☐ No ☐ Partial Basement

Primary Wastewater System

Type: ☐ I ☐ II ☒ III ☐ IV ☐ V ☐ VI

☐ Conventional
☐ Prefabricated, permeable block panel system
☐ Shallow Placed Conventional
☐ Low Pressure Pipe
☐ Large Diameter Pipe
☐ Fill
☐ Other
☒ Innovative or Experimental:

.275 Long-term acceptance rate (GPD/ft^2)	**480** Max gallons/day wastewater flow	**1744** Absorption Area (ft^2)	**9** Trench spacing (min. on centers) (ft)
Serviced by private well: ☒ Yes ☐ No	**1500** Gallon septic tank	**436** Total trench length (ft)	**20** Maximum trench depth (in) (At least 12" of provisionally suitable soil must remain between trench bottom and unsuitable soil conditions.)
4 Bedrooms in residence	**1000** Gallon pump tank	**NA** Depth of stone (in)	

Any surface water present: **NO** Type: Minimum separation distance (ft):

Additional conditions: **Type III bg innovative system with pump and drop boxes.**

Repair Area System

Type: ☐ I ☐ II ☒ III ☐ IV ☐ V ☐ VI

☐ Conventional
☒ Prefabricated, permeable block panel system
☐ Shallow Placed Conventional
☐ Low Pressure Pipe
☐ Large Diameter Pipe
☐ Fill
☐ Other
☐ Innovative or Experimental:

1745 Absorption Area (ft^2) **291** Total trench length (ft)	**NA** Depth of stone (in)	**8** Trench spacing (min. on centers) (ft)	**30** Maximum trench depth (in)

The undersigned, an authorized agent of the MECKLENBURG COUNTY HEALTH DEPARTMENT, certifies that the Department has approved the Request for the Job Location contained in this document. The approval is granted in accordance with the provisions of Laws and Rules For Sewage Treatment, and Disposal Systems in effect at the time of issuance of the permit and is subject to the following provisions:

*** No work shall be conducted on the septic tank system until an Installation, Construction, Alteration and/or Repair Approval is granted by this Department.

*** This Improvement permit is transferable.

Gina Buchanan 2/28/06
DENR Authorized Agent Date

3-6-06
Owner/Agent Signature Date

MECKLENBURG COUNTY HEALTH DEPARTMENT
ENVIRONMENTAL HEALTH DIVISION
700 N. TRYON ST., SUITE 211
CHARLOTTE, NC 28202
PHONE: (704) 336-5103
FAX: (704) 336-6894

NC DENR
DIVISION OF ENVIRONMENTAL HEALTH
ON-SITE WASTEWATER SECTION

FEE: 300.00
DATE: 3/13/2006

CONSTRUCTION AUTHORIZATION FOR AN ON-SITE WASTEWATER TREATMENT & DISPOSAL SYSTEM

MECKLENBURG COUNTY
GROUNDWATER & WASTEWATER SERVICES

FILE NUMBER: 6131B

PERMIT NUMBER: 30000354

PARCEL NUMBER: 00716212

JOB LOCATION INFORMATION

ADDRESS: 11410 LAUREN LN

CITY: DAVIDSON **STATE: NC** **ZIP:** 28036

ISSUED TO: Royal Building Co.

CONSTRUCTION AUTHORIZATION ISSUANCE DATE: 3/6/2006

CONSTRUCTION AUTHORIZATION CONDITIONS

1. WASTEWATER SYSTEM CONSTRUCTION AND INSTALLATION MUST MEET ALL CONDITIONS AND SPECIFICATIONS AS SET FORTH IN IMPROVEMENT PERMIT NUMBER 30000354, AND THE ATTACHED SITE PLAN WITH SYSTEM DETAILS. CONSTRUCTION AND INSTALLATION MUST ALSO MEET ALL REQUIREMENTS SET FORTH IN THE RULES GOVERNING SANITARY SEWAGE COLLECTION, TREATMENT, AND DISPOSAL AND ANY OTHER APPLICABLE RULES AND LAWS.

2. AN INSTALLATION APPROVAL MUST BE SECURED PRIOR TO INSTALLATION OF THE SEPTIC TANK SYSTEM. THE INSTALLER OF THE SYSTEM SHALL BE A REGISTERED SEPTIC TANK CONTRACTOR WITH THE MECKLENBURG COUNTY HEALTH DEPARTMENT.

3. ANY ALTERATION IN SITE OR SOIL CONDITIONS (INCLUDING LOCATION OF STRUCTURES AND APPURTENANCES) OR MODIFICATION IN USE, DESIGN WASTEWATER FLOW, OR WASTEWATER CHARACTERISTICS AS SPECIFIED IN THE ASSOCIATED IMPROVEMENT PERMIT AND APPLICATION, MAY SUBJECT THIS CONSTRUCTION AUTHORIZATION AND ASSOCIATED PERMIT(S) TO REVOCATION.

4. THIS CONSTRUCTION AUTHORIZATION AS PROVIDED IN G.S. 130A-335(f) AND G.S. 130A-336(b) SHALL BE VALID FOR A PERIOD EQUAL TO THE VALIDITY OF THE IMPROVEMENT PERMIT, NOT TO EXCEED 60 MONTHS.
   *CONSTRUCTION AUTHORIZATION EXPIRATION DATE: 2/28/2011

Mecklenburg County Groundwater & Wastewater Services
700 N. Tryon St, Suite 211 Charlotte, NC 28202
Phone: (704) 336-5103 Fax: (704) 336-6894

NC DENR
Division of Environmental Health
On-Site Wastewater Section

IMPROVEMENT PERMIT for a RESIDENTIAL ON-SITE WASTEWATER TREATMENT & DISPOSAL SYSTEM

Permit #: **30000354** GWS File #: **6131B** Tax Parcel #: **007-162-12**

- This IMPROVEMENT PERMIT is subject to revocation if site plans or the intended use change. There is to be **NO** grading, filling, or disturbance of the soil in the area of the septic tank system or repair area.
- CONSTRUCTION AUTHORIZATION must be obtained prior to receiving a Building Permit. The Construction Authorization is **NOT** transferable. Do not clear, grade, fill or disturb soil prior to obtaining a Construction Authorization.
- Domestic-type wastewater only. No industrial process wastewater may be discharged into the system.

I. This Improvement Permit Shall: Expire in Five (5) Years **Expiration Date (If Applicable):** 2/28/2011

Type of Installation: Residential - New System Lot Number: 3

Structure Type: HOUSE Size (ft^2): 4200 # Bedrooms: 4 # Occupants: 4

Building Foundation: Basement Without Plumbing Water Supply: Private Well

II. Initial System Type: Pump to Innovative or Experimental **System Classification:** IIIb

Initial System Specifications:

Design Flow (gpd): 480 LTAR (gpd/ft^2): 0.275 Septic Tank Size (gal): 1500 Pump Tank Size (gal): 1000

Trench Width (ft): 3 Trench Spacing (ft): 9 Absorption Area (ft^2): 1309 Total Trench Length (ft): 436

Maximum Trench Depth (in): 20 Depth of Media (in): 12 Distribution Device: Drop Boxes

III. Repair System Type: PPBPS (pressurized) **System Classification:** IVa

Repair System Specifications:

Design Flow (gpd): 480 LTAR (gpd/ft^2): 0.275 Septic Tank Size (gal): 1500 Pump Tank Size (gal): 1000

Trench Width (ft): 3 Trench Spacing (ft): 9 Absorption Area (ft^2): 873 Total Trench Length (ft): 291

Maximum Trench Depth (in): 30 Depth of Media (in): 16 Distribution Device: N/A

IV. Permit Conditions/Comments:

(Please See the Following Page for Permit Conditions.)

The undersigned, an authorized agent of the MECKLENBURG COUNTY HEALTH DEPARTMENT, certifies that the Department is issuing an IMPROVEMENT PERMIT for the above referenced property. This permit is being issued in accordance with the *Laws and Rules For Sewage Treatment, and Disposal Systems* and is subject to the following provisions:

- No work shall be conducted on the septic system until an INSTALLATION APPROVAL is granted by the Department.
- The septic system installer shall be a registered septic contractor with Mecklenburg County Health Department.
- The permitted system shall be installed in accordance with the included PLOT PLAN.
- This IMPROVEMENT PERMIT is transferable.

DENR Authorized Agent: Cina Buchanan Owner/Legal Agent:_____

Print Name

Signature:_____ Signature:_____

Date Issued: 2/28/2006

Mecklenburg County Groundwater & Wastewater Services
700 N. Tryon St, Suite 211 Charlotte, NC 28202
Phone: (704) 336-5103 Fax: (704) 336-6894

NC DENR
Division of Environmental Health
On-Site Wastewater Section

IMPROVEMENT PERMIT for a RESIDENTIAL ON-SITE WASTEWATER TREATMENT & DISPOSAL SYSTEM

Permit #: **30000354** GWS File #: **6131B**

IV. Permit Conditions/Comments:

- This type of septic system requires an inspection once every 5 years by our office. The system owner is responsible for any fees, as determined by the Mecklenburg County Board of Commissioners, associated with this inspection.
- This type of repair system requires the property owner to obtain a contract with a Certified Operator to perform routine inspections and maintenance on the system.
- This type of repair system requires periodic inspections by our office. The system owner is responsible for any fees, as determined by the Mecklenburg County Board of Commissioners, associated with this inspection.
- All components of the septic system must be installed in accordance with the required setbacks listed on the corresponding plot plan.
- All components of the septic system must be located at least 100 ft. (50 ft. minimum) from all private wells.

The undersigned, an authorized agent of the MECKLENBURG COUNTY HEALTH DEPARTMENT, certifies that the Department is issuing an IMPROVEMENT PERMIT for the above referenced property. This permit is being issued in accordance with the *Laws and Rules For Sewage Treatment and Disposal Systems* and is subject to the following provisions:

- No work shall be conducted on the septic system until an INSTALLATION APPROVAL is granted by the Department.
- The septic system installer shall be a registered septic contractor with Mecklenburg County Health Department.
- The permitted system shall be installed in accordance with the included PLOT PLAN.
- This IMPROVEMENT PERMIT is transferable.

DENR Authorized Agent: Cina Buchanan

Signature:_____

Date Issued: 2/28/2006

Owner/Legal Agent:_____
Print Name

Signature:_____

Mecklenburg County Groundwater & Wastewater Services
700 N. Tryon St., Suite 211 Charlotte, NC 28202
Phone: (704) 336-5103 Fax: (704) 336-6894

NC DENR
Division of Environmental Health
On-Site Wastewater Section

INSTALLATION APPROVAL for an
ON-SITE WASTEWATER TREATMENT & DISPOSAL SYSTEM

File #: 61318 Permit #: 354 Tax Parcel #: 007-162-12

Property Owner: ROYAL BUILDING INC.

Job Location Address: 11410 LAUREN LANE

City: DAVIDSON State: NC Zip Code: 28036

Installation Approval Issuance Date: 5/23/07

Permission is hereby given to ☒ install ☐ alter ☐ repair an on-site wastewater treatment & and disposal system, with subsurface soil absorption and effluent discharge, as specified herein at the described location. This approval is granted based upon the application information submitted to our office. All work shall be completed on or before 6/23/07, after which date this approval shall be null and void. The system shall meet all of the construction requirements of 15A NCAC 18A. 1900 which are in effect on the date of granting this approval. An **Operation Permit** must be obtained from the Mecklenburg County Health Department before any system can be covered up or placed into service. The issuance of this permit does not in any way guarantee that the system anticipated to be constructed will operate properly, or relieve any person now of hereafter owning, controlling or using such system from any liability resulting from the failure of the system to operate properly.

***NOTICE: This system shall not be installed while soils are in a wet condition.**

Permitted Design Flow: 480 GPD

Site LTAR: 0.275 GPD/ft² (For new installations only.)

Liquid Capacity of Septic Tank: 1500 gallons

Liquid Capacity of Dosing Tank: 1000 gallons

Drainfield Design ☐ N/A

Trench Depth: 30 inches

Trench Width: 3 feet

Line Spacing: 9' feet (O.C.)

Total line length: 436 feet

# of Lines: 2 @ 218 feet

Depth of Media: 12 inches (Type) 25% RED.

Distribution Device: PRESSURE MANIFOLD

Bed Design *(For Repair Installations ONLY.)* ☒ N/A

Bed Depth: _____ inches

Bed Width: _____ feet

Total line length: _____ feet

# of Lines: _____ @ _____ feet

Depth of Media: _____ inches (Type) _____

Distribution Device: _____

Water Supply Source

☐ Municipal ☒ Private Well ☐ Community Well

☐ Other _____


Minimum System Setbacks

Distance from Building Foundation: 15' feet

Distance from Property Line: 10' feet

Distance from Water Supply Source: 100' feet

SKETCH OF SYSTEM LAYOUT
(Proposed Layout)

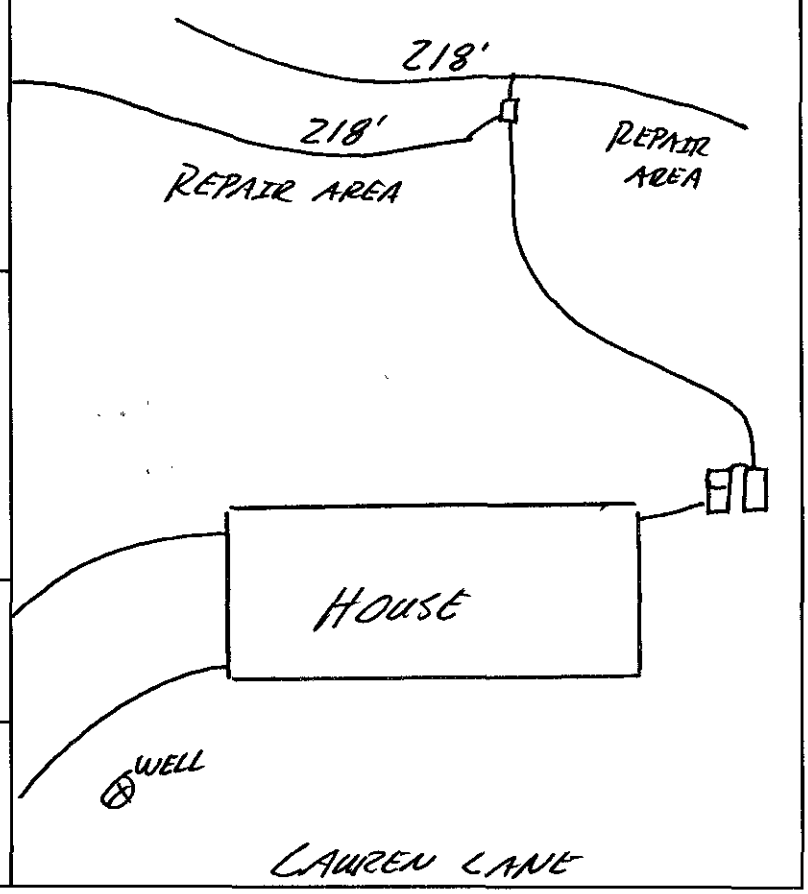

Comments: System Classification & Type: III b Pump To Innovative System

DENR Authorized Agent: Jeremy Michelone, R.S. Signature: Jeremy Michelone, R.S.

Mecklenburg County Groundwater & Wastewater Services
700 N. Tryon St., Suite 211 Charlotte, NC 28202
Phone: (704) 336-5103 Fax: (704) 336-6894

NC DENR
Division of Environmental Health
On-Site Wastewater Section

OPERATION PERMIT for an
ON-SITE WASTEWATER TREATMENT & DISPOSAL SYSTEM

File #: 6/31B Permit #: 354 Tax Parcel #: 007-162-12

Property Owner: ROYAL BUILDING, INC.

Job Location Address: 11410 LAUREL LANE

City: Huntersville State: NC Zip Code: 28078

Operation Permit Issuance Date: 6/21/07 Contractor Name: Wally CHRISTENBURY

Permitted Design Flow: 480 GPD

Liquid Capacity of Septic Tank: 1500 gallons

Liquid Capacity of Dosing Tank: 1000 gallons

Effluent Pump Model: ME 50 S11

Drainfield Installation ☐ N/A

Trench Depth: 30 inches

Trench Width: 3 feet

Line Spacing: 9 feet (O.C.)

Total line length: 440 feet

# of Lines: 2 @ 220 feet

Depth of Media: 12 inches (Type) E-Z FLOW

Depth of Cover: 18 inches

Distribution Device: P. Manifold

Inspection Dates

Tank(s) Inspected: 6/11/07

Excavation Inspected: 6/11/07

Pump & Controls Inspected: 6/11/07

Bed Installation *(For Repair Installations ONLY.)* ☒ N/A

Bed Depth: _____ inches

Bed Width: _____ feet

Total line length: _____ feet


# of Lines: _____ @ _____ feet

Depth of Media: _____ inches (Type) _____

Depth of Cover: _____ inches

Distribution Device: _____

SKETCH OF SYSTEM INSTALLATION
(As-Built Drawing)

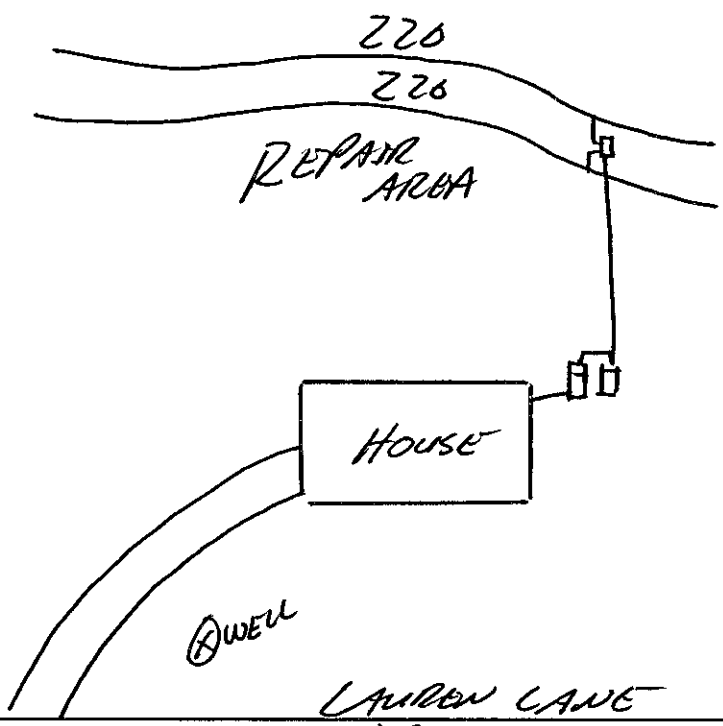

Water Supply Source

☐ Municipal ☒ Private Well ☐ Community Well

☐ Other _____

System Installation Setbacks

Distance from Building Foundation: >15' feet

Distance from Property Line: >10' feet

Distance from Water Supply Source: >100' feet

The undersigned has inspected the Septic Tank System described above, and certifies it has been ☒ installed ☐ altered ☐ repaired ☒ as detailed in the plot above ☐ in accordance with the permit issued and meets the provisions of 15A NCAC 18A. 1900, "Laws and Rules for Sewage Treatment and Disposal Systems" in effect on the date of issuance of the permit. The issuance of this Operation Permit does not in any way guarantee that the system will operate properly or relieve any person now or hereafter owning, controlling, or using such system from any liability resulting from the failure of the system to operate properly. This document is issued subject to those restrictions and conditions shown on the permit(s) and the provisions of 15A NCAC 18A. 1900 in addition to those listed below under "Comments." This document shall be null and void if any information contained in the application is untrue or if any additions are made to the property which would increase the requirements for said system.

Notice: Disturbance of the designated repair area may result in the Suspension or Revocation of this permit.

Comments: System Classification & Type: III-b Pump to 25% Red.


Mecklenburg County Groundwater & Wastewater Services
700 N. Tryon St., Suite 211 Charlotte, NC 28202
Phone: (704) 336-5103 Fax: (704) 336-6894

NC DENR
Division of Environmental Health
On-Site Wastewater Section

OPERATION PERMIT for an ON-SITE WASTEWATER TREATMENT & DISPOSAL SYSTEM

File #: 6131B Permit #: 354 Tax Parcel #: 007-162-12

Property Owner: Royal Building, Inc.

Job Location Address: 11410 Lauren Lane

City: Huntersville State: NC Zip Code: 28078

OPERATION PERMIT CONDITIONS:

I. Performance: System shall perform in accordance with 15A NCAC 18A .1961.

II. Monitoring: System shall be monitored as required by 15A NCAC 18A .1961.

III. Maintenance: Ground absorption sewage treatment and disposal systems shall be checked, and the contents of the septic tank removed, periodically from all compartments, to ensure proper operation of the system. The contents shall be pumped whenever the solids level is found to be more than 1/3 of the liquid depth in any compartment.

IV. Operation: System shall be operated in accordance with 15A NCAC 18A .1961.

System Classification: IIIb

*Operation Permits for Type V and VI systems expire five (5) years from the date of issuance (in accordance with Table V(a)). The system owner must contact GWS six (6) months prior to expiration for permit renewal.

Subsurface system operator required: Yes ☐ No ☒

☐ This type of system requires the system owner to maintain a contract with a certified operator to perform system inspection, maintenance, and reporting as required in 15A NCAC 18A .1961. and Table V(a). The system owner is responsible for all fees associated with these services.

☐ System does not require inspection by GWS on a routine frequency.

☒ System requires inspection by GWS once every five (5) years. The system owner is responsible for all fees associated with the inspection.

☐ System requires inspection by GWS once every three (3) years. The system owner is responsible for all fees associated with the inspection.

☐ System requires inspection by GWS once every twelve (12) months. The system owner is responsible for all fees associated with the inspection.

☐ System requires inspection by GWS once every six (6) months. The system owner is responsible for all fees associated with the inspection.

V. Other:

DENR Authorized Agent: Jeremy Michelson, R.S.

Signature: Jeremy Michelson, R.S.

GWS – RES. APP 12/04

SEPTIC FEE: 200.00 VBQ
DATE: 9-1-05
CRT: [ ]

PERMIT APPLICATION FOR A RESIDENTIAL SITE
IMPROVEMENT PERMIT / CONSTRUCTION AUTHORIZATION
FOR ON-SITE WASTEWATER SYSTEM
NEW WELL INSTALLATION OR REPAIR OF EXISTING WELL
MECKLENBURG COUNTY GROUNDWATER & WASTEWATER SERVICES

FILE # 6131B

WELL FEE:
DATE:
CRT: [ ]

SEPTIC / TYPE APPLICATION: ☐ NONE ☒ NEW SYSTEM EXISTING SYSTEM : ☐ EXPANSION/ALTERATION ☐ REPAIR

WELL / TYPE APPLICATION: ☐ NONE ☒ NEW WELL ☐ MAJOR REPAIR ☐ ABANDONMENT

JOB LOCATION INFORMATION:

TAX/PARCEL #: 00716212PO
STREET ADDRESS: 13615 Mayes Rd
CITY: Huntersville
STATE: NC ZIP: 28078
SUBDIVISION OR MOBILE HOME PARK NAME:
LOT #: 3
TOWNSHIP:

☒ 0-MECKLENBURG ☐ 4-PINEVILLE
☐ 1-CHARLOTTE ☐ 5-MATTHEWS
☐ 2-DAVIDSON ☐ 6-HUNTERSVILLE
☐ 3-CORNELIUS ☐ 7-MINT HILL

BUILDING INFORMATION:

TYPE OF BUILDING:

☐ SINGLE MOBILE HOME (S) ☐ MODULAR HOME (M)
☐ DOUBLE WIDE (D) ☐ MULTIPLE FAMILY (U)
☒ HOUSE (H) ☐ OTHER

HEATED SQUARE FOOTAGE:
NUMBER OF BEDROOMS: 4
NUMBER OF OCCUPANTS:

FOUNDATION FOR RESIDENCE:

☐ CONCRETE SLAB ☒ BASEMENT WITH PLUMBING
☐ CRAWLSPACE ☐ BASEMENT WITH NO PLUMBING

IF PLANNING TO EXPAND/ALTER THE EXISTING SYSTEM INDICATE THE FOLLOWING CHANGES:
NUMBER OF BEDROOMS TO BE ADDED: NUMBER OF ADDITIONAL OCCUPANTS IN THE RESIDENCE:
WILL THERE BE A HOME BUSINESS IN THE RESIDENCE? ☐ YES ☐ NO TYPE:

WATER SUPPLY:

☐ MUNICIPAL (M) ☐ PUBLIC (C) ☒ PRIVATE WELL (P) ☐ SHARED WELL (S) ☐ OTHER 'SPRINGS' (O)

PROPOSED USE OF WELL: ☐ N/A ☐ IRRIGATION ☒ POTABLE ☐ GEOTHERMAL ☐ OTHER

ARE ANY OF THE FOLLOWING LOCATED ON THE PROPERTY? IF SO, PLEASE SHOW LOCATION ON SITE PLAN/PLAT.

BURIED CABLES, LANDFILLS, STUMPHOLES	☐ YES	☒ NO	WELLS, SPRINGS, OR WATER LINES	☐ YES	☒ NO
EXISTING WASTEWATER SYSTEMS	☐ YES	☒ NO	DESIGNATED WETLANDS	☐ YES	☒ NO
EASEMENTS OR RIGHT-OF-WAYS	☐ YES	☒ NO	GRADING/SOIL REMOVAL PERFORMED	☐ YES	☒ NO

PROPERTY OWNER:

NAME: Royal Building Co.
ADDRESS: 19525 Calloway Hills Ln
CITY: Davidson
STATE: NC ZIP: 28036
HOME PHONE: WORK PHONE: 704-201-5705
MOBILE PHONE: FAX: 704-895-1325

LEGAL AGENT FOR PROPERTY OWNER, IF APPLICABLE:

NAME:
ADDRESS:
CITY:
STATE: ZIP:
HOME PHONE: WORK PHONE:
MOBILE PHONE: FAX:

WHAT DATE WAS THE PROPERTY ORIGINALLY DEEDED AND RECORDED?
WHAT IS THE ANTICIPATED CLOSING DATE FOR THIS PROPERTY? 9-1-05

*An Improvement Permit is subject to suspension or revocation if site plans or the intended use change or if information submitted in this application is falsified or changed. The undersigned, owner, or legal agent for the owner, of the property described above as the "Job Location" has read the foregoing application, acknowledges that the contents of same are true, and authorizes the Mecklenburg County Health Department to enter onto the property for the purpose of processing this request.

Owner's/Agent's Signature Date

NORTH CAROLINA DEPARTMENT OF
ENVIRONMENT & NATURAL RESOURCES DIVISION
OF ENVIRONMENTAL HEALTH ON-SITE
WASTEWATER SECTION

*A Well Permit is subject to suspension or revocation if site plans or the intended use change or if information submitted in this application is falsified or changed. The undersigned, owner, or legal agent for the owner, of the property described above as the "Job Location" has read the foregoing application, acknowledges that the contents of same are true, and authorizes the Mecklenburg County Health Department to enter onto the property for the purpose of processing this request.

Owner's/Agent's Signature Date


MECKLENBURG COUNTY HEALTH DEPARTMENT
GROUNDWATER & WASTEWATER SERVICES
700 N. TRYON ST., SUITE 211
CHARLOTTE, NC 28202
704-336-5103 / FAX: 704-336-6894

Mecklenburg County
Land Use & Environmental Service Agency
Groundwater & Wastewater Services
700 N. Tryon St., Suite 211
Charlotte, NC 28202
Phone: (704) 336-5103
Fax: (704) 336-6894

File #_____
Date_____

PROPOSED PLOT PLAN

A map showing existing and proposed property lines and easements with dimensions, the location of the single family residence, non-single family residence, or other facility, and appurtenances, the site for the proposed well, and the location of existing or proposed sewer lines and/or sewage disposal systems, surface water bodies, aboveground or underground storage tanks. Name all roads adjoining the property. If this a repair indicate the type of repair.

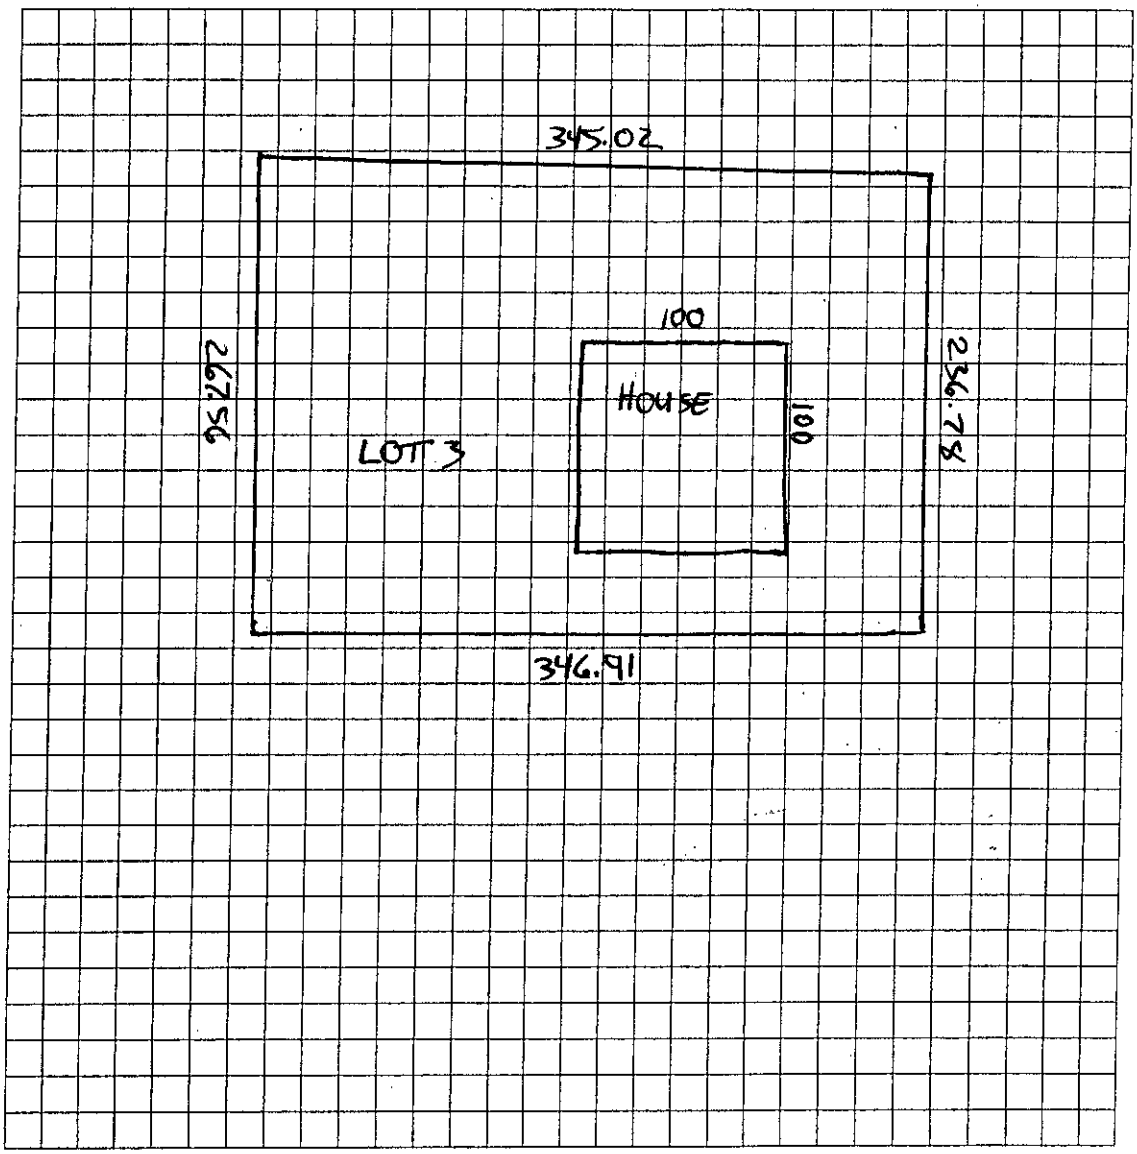

Owner/Agent Signature
Date

LBC 12/15/04

DIVISION OF ENVIRONMENTAL HEALTH
ON-SITE WASTEWATER SECTION

Sheet ___ of ___
PROPERTY ID #: ___
COUNTY: Mecklenburg

SOIL/SITE EVALUATION
for ON-SITE WASTEWATER SYSTEM

OWNER: Kim Studdard Royal Oaks S.D. APPLICANT: Same
ADDRESS: ___ APPLICATION DATE: ___ DATE EVALUATED: 8-20 & 12-k
PROPOSED FACILITY: ___ PROPOSED DESIGN FLOW (.1949): ___ PROPERTY SIZE: ___
LOCATION OF SITE: Lot 3 (off site area for Lot 4 on-site for Lot 3) PROPERTY RECORDED: ___
WATER SUPPLY: ☐ Private ☐ Public ☐ Well ☐ Spring ☐ Other ___
EVALUATION METHOD: ☑ Auger Boring ☑ Pit ☐ Cut
TYPE OF WASTEWATER: ☐ Sewage ☐ Industrial Process ☐ Mixed

PROFILE #	.1940 LANDSCAPE POSITION/ SLOPE %	HORIZON DEPTH (IN.)	SOIL MORPHOLOGY (.1941) .1941 STRUCTURE/ TEXTURE	.1941 CONSISTENCE/ MINERALOGY	OTHER PROFILE FACTORS .1942 SOIL WETNESS/ COLOR	.1943 SOIL DEPTH	.1956 SAPRO CLASS	.1944 RESTR HORIZ	PROFILE CLASS & LTAR
1	S 10-12% A-5 Off site area for Lot 4	0-5	R Bn SCL WSBK	Fri SS/SP (SOAP)	—	48"	—	—	PS .3
		5-24	R Ylw SBK	Fri SS/SP (SOAP)					
		24-32	R Mtld Ylw WSBK	Fri SS/SP (SOAP)					
		32-45	R SCL WSBK	Fri SS/SP (SOAP)					
		45-48	R Mtld Ylw WSBK	Fri SS/SP (SOAP)					
2	S 10% A-6 Off-site area for Lot 4	0-6	R Bn SCL WSBK	Fri SS/SP (SOAP)	—	45"	—	—	PS .3
		6-24	R Ylw SBK	Fri SS/SP (SOAP)					
		24-32	R Mtld Ylw SBK	Fri SS/SP SOAP					
		32-45	R Mtld Ylw WSBK	Fri SS/SP SOAP					
		@ 45	SPR. Mass.						
3	S 8-10% Pit middle of Lot 3 off-site	0-7	R Bn SCL WSBK	Fri SS/SP SOAP	—	53"	—	—	PS .3
		7-27	R Mtld Ylw SBK	Fri SS/SP SOAP					
		27-53	R and Mtld Ylw WSBK	Fri SS/SP SOAP					
4	S 5-10% A-7 On-site Lot 3	0-7	R Bn SCL WSBK	Fri SS/SP SOAP	—	45"	With Saprolite	—	PS .3
		7-45"	R Ylw SBK	Fri SS/SP SOAP					
		@ 45"	R SCL SAP Mass	Fri SS/SP SOAP					
			@ 45" Unsuitable						

DESCRIPTION	INITIAL SYSTEM	REPAIR SYSTEM
Available Space (.1945)	Most likely will need	
System Type(s)	PPBS system for off-site	
Site LTAR	area for Lot 4 on Lot 3	

OTHER FACTORS (.1946): ___
SITE CLASSIFICATION (.1948): ___
EVALUATED BY: M Ash / DH Mecklenburg
OTHER(S) PRESENT: Mecklenburg DH

COMMENTS: _____

LEGEND

use the following standard abbreviations

LANDSCAPE POSITION	GROUP	SOIL TEXTURE	CONVENTIONAL 1955 LTAR	LPP 1957 LTAR	MINERALOGY/ CONSISTENCE	STRUCTURE
CC (Concave Slope)	I	S (Sand)	1.2 - 0.8	0.6 - 0.4	NEXP (Non-expansive)	G (Single Grain)
CV (Convex Slope)		LS (Loamy Sand)			SEXP (Slightly Expansive)	M (Massive)
D (Drainage Way)					EXP (Expansive)	CR (Crumb)
DS (Debris Slump)	II	SL (Sandy Loam)	0.8 - 0.6	0.4 - 0.3		GR (Granular)
FP (Flood Plain)		L (Loam)				SBK (Subangular Blocky
FS (Foot Slope)						ABK (Angular Blocky)
H (Head Slope)	III	SI (Silt)	0.6 - 0.3	0.3 - 0.15		PL (Platy)
L (Linear Slope)		SICL (Silty Clay Loam)				PR (Prismatic)
N (Nose Slope)		CL (Clay Loam)				
R (Ridge)		SCL (Sandy Clay Loam)			**MOIST**	**WET**
S (Shoulder Slope)		SLC (Silt Loam Clay)				
T (Terrace)					VFR (Very Friable)	NS (Non-sticky)
	IV	SC (Sandy Clay)	0.4 - 0.1	0.2 - 0.05	FR (Friable)	SS (Slightly Sticky)
		SIC (Silty Clay)			FI (Firm)	S (Sticky)
					VFI (Very Firm v. Very Sticky)	VS (Very Sticky)
		O (Organic)	None		EFI (Extremely Firm)	NP (Non-plastic)
						SP (Slightly Plastic)
						P (Plastic)
						VP (Very Plastic)


NOTES

HORIZON DEPTH	In inches below natural soil surface
DEPTH OF FILL	In inches from land surface
RESTRICTIVE HORIZON	Thickness and depth from land surface
SAPROLITE	S(suitable) or U(unsuitable)
SOIL WETNESS	Inches from land surface to free water or inches from land surface to soil colors with chroma 2 or less - record Munsell color chip designation
CLASSIFICATION	S (Suitable), PS (Provisionally Suitable), or U (Unsuitable)

Evaluation of saprolite shall be by pits.

Long-term Acceptance Rate (LTAR): gal/day/ft²

Show profile locations and other site features (dimensions, reference or benchmark, and North).

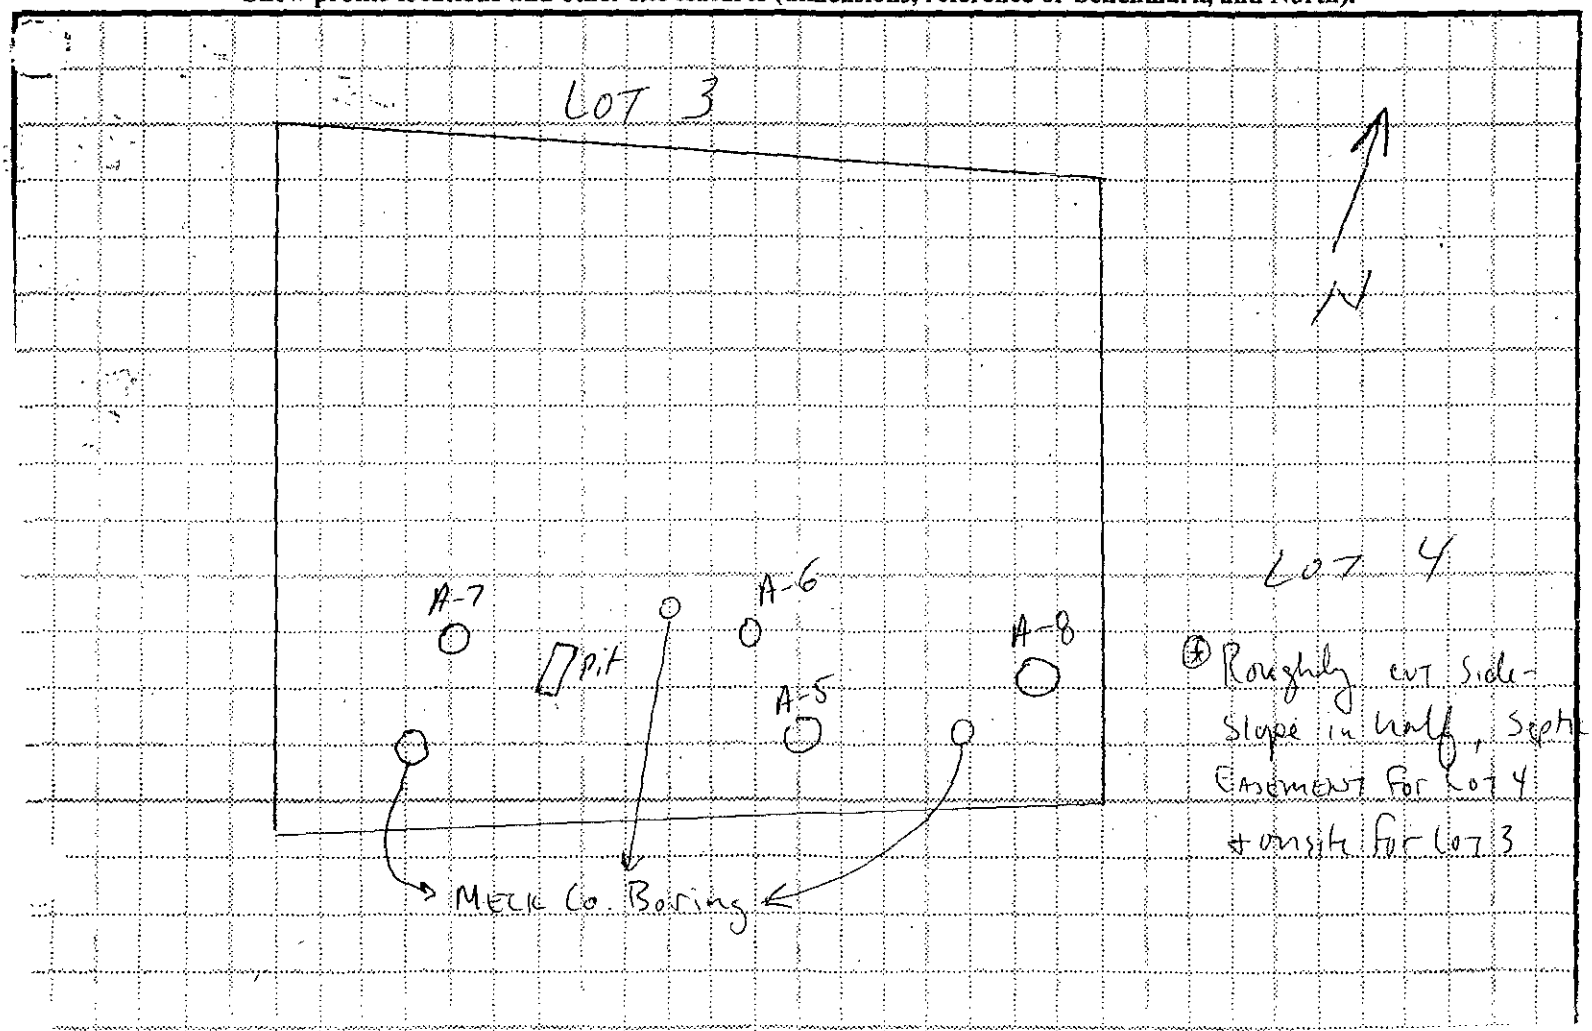

DIVISION OF ENVIRONMENTAL HEALTH
ON-SITE WASTEWATER SECTION

Sheet ___ of ___
PROPERTY ID #: _____
COUNTY: Moore

SOIL/SITE EVALUATION
for ON-SITE WASTEWATER SYSTEM

OWNER: Royal Oaks SD. / Ken Stoddard APPLICANT: _____
ADDRESS: _____ APPLICATION DATE: _____ DATE EVALUATED: _____
PROPOSED FACILITY: _____ PROPOSED DESIGN FLOW (.1949): _____ PROPERTY SIZE: _____
LOCATION OF SITE: Lot 3 off site for Lot 4 PROPERTY RECORDED: _____
WATER SUPPLY: ☐ Private ☐ Public ☐ Well ☑ Spring ☐ Other _____
EVALUATION METHOD: ☑ Auger Boring ☐ Pit ☐ Cut
TYPE OF WASTEWATER: ☐ Sewage ☐ Industrial Process ☐ Mixed

PROFILE #	.1940 LANDSCAPE POSITION/ SLOPE %	HORIZON DEPTH (IN.)	SOIL MORPHOLOGY (.1941) .1941 STRUCTURE/ TEXTURE	SOIL MORPHOLOGY (.1941) .1941 CONSISTENCE/ MINERALOGY	OTHER PROFILE FACTORS .1942 SOIL WETNESS/ COLOR	OTHER PROFILE FACTORS .1943 SOIL DEPTH	OTHER PROFILE FACTORS .1956 SAPRO CLASS	OTHER PROFILE FACTORS .1944 RESTR HORIZ	PROFILE CLASS & LTAR
1	S 10% A-B OFF-SITE FOR LOT 4	0-8	R Bk SCL w/SOK	Fri SL/SP (SCAP)	-	48"	-	-	PS .3
		8-48	R. Ltg SBK	Fri SL/SP (SCAP)	-				
2									
3									
4									

DESCRIPTION	INITIAL SYSTEM	REPAIR SYSTEM
Available Space (.1945)		
System Type(s)		
Site LTAR		

OTHER FACTORS (.1946): _____
SITE CLASSIFICATION (.1948): _____
EVALUATED BY: _____
OTHER(S) PRESENT: _____

COMMENTS: _____

LEGEND

use the following standard abbreviations

LANDSCAPE POSITION	GROUP	SOIL TEXTURE	CONVENTIONAL 1955 LTAR	LPP 1957 LTAR	MINERALOGY/ CONSISTENCE	STRUCTURE
CC (Concave Slope)	I	S (Sand)	1.2 - 0.8	0.6 - 0.4	NEXP (Non-expansive)	G (Single Grain)
CV (Convex Slope)		LS (Loamy Sand)			SEXP (Slightly Expansive)	M (Massive)
D (Drainage Way)					EXP (Expansive)	CR (Crumb)
DS (Debris Slump)	II	SL (Sandy Loam)	0.8 - 0.6	0.4 - 0.3		GR (Granular)
FP (Flood Plain)		L (Loam)				SBK (Subangular Blocky)
FS (Foot Slope)						ABK (Angular Blocky)
H (Head Slope)	III	SI (Silt)	0.6 - 0.3	0.3 - 0.15		PL (Platy)
L (Linear Slope)		SICL (Silty Clay Loam)				PR (Prismatic)
N (Nose Slope)		CL (Clay Loam)				
R (Ridge)		SCL (Sandy Clay Loam)			**MOIST**	**WET**
S (Shoulder Slope)		SLC (Silt Loam Clay)				
T (Terrace)					VFR (Very Friable)	NS (Non-sticky)
	IV	SC (Sandy Clay)	0.4 - 0.1	0.2 - 0.05	FR (Friable)	SS (Slightly Sticky)
		SIC (Silty Clay)			FI (Firm)	S (Sticky)
					VFI (Very Firm v. Very Sticky)	VS (Very Sticky)
		O (Organic)	None		EFI (Extremely Firm)	NP (Non-plastic)
						SP (Slightly Plastic)
						P (Plastic)
						VP (Very Plastic)


NOTES

HORIZON DEPTH	In inches below natural soil surface
DEPTH OF FILL	In inches from land surface
RESTRICTIVE HORIZON	Thickness and depth from land surface
SAPROLITE	S(suitable) or U(unsuitable)
SOIL WETNESS	Inches from land surface to free water or inches from land surface to soil colors with chroma 2 or less - record Munsell color chip designation
CLASSIFICATION	S (Suitable), PS (Provisionally Suitable), or U (Unsuitable)

Evaluation of saprolite shall be by pits.

Long-term Acceptance Rate (LTAR): gal/day/ft²

Show profile locations and other site features (dimensions, reference or benchmark, and North).

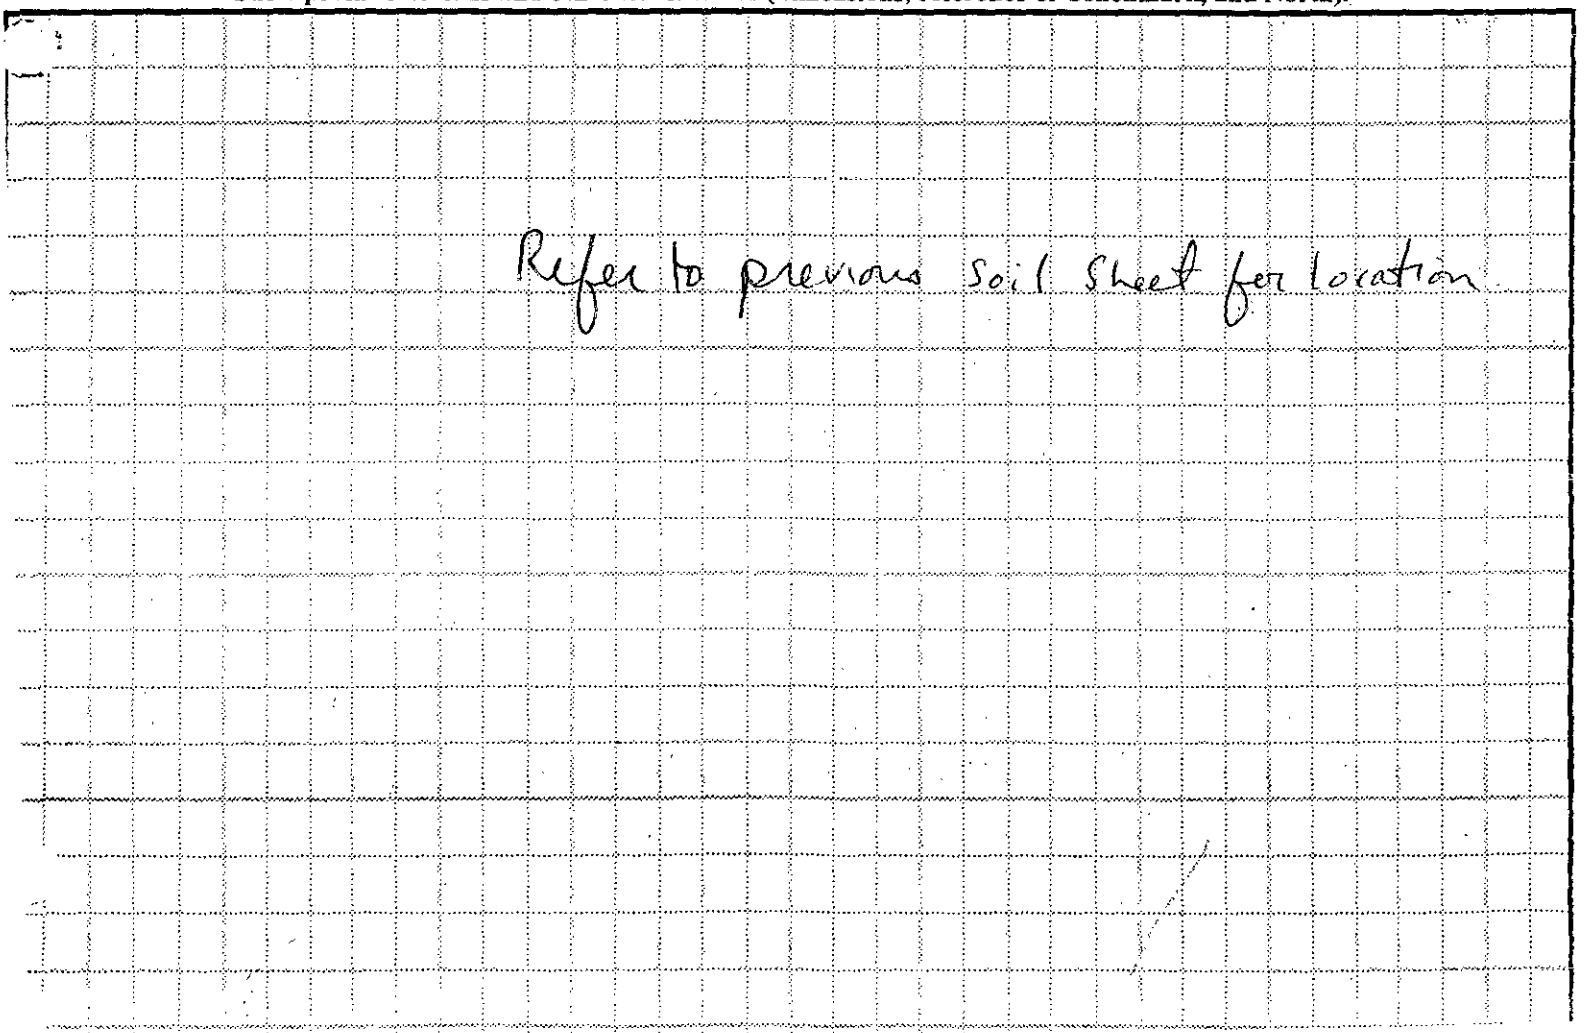



11410 LAUREN LN

00716241

1/9/2008

duponbj

Groundwater and Wastewater Services File Imaging Project
May 2007
Barcode Font = IDAutomationHC39M

2009 UTS on DECK ADDITION

Groundwater & Wastewater Services
Septic Project File & Data Review Worksheet

GWS File #: 6191D WASPS App #: 4257

Primary ES assigned to project: RW

Secondary ES assigned to project:

L D Jacobs 6/26/09

Project Type: New System ☐ Alteration ☐ Repair ☐ Modified Plot Plan ☐ UTS 6

I. File Review:

Rule or Law	Permit Application			
.1937(d)	Is the Application complete	Yes ☑	No ☐	N/A ☐
.1937(d)	Is there a Site plan/Plat with application	Yes ☑	No ☐	N/A ☐
.1937(d)	Is the Facility shown?	Yes ☑	No ☐	N/A ☐
.1937(d)	Are appurtenances shown	Yes ☑	No ☐	N/A ☐
	Site Evaluation Information			
.1939 (a)(1)	Topography and Landscape Position Recorded?	Yes ☐	No ☐	N/A ☐
.1940 (a-g)	Slope % Recorded?	Yes ☐	No ☐	N/A ☐
.1939 (a)(2)	Texture Class Recorded?	Yes ☐	No ☐	N/A ☐
.1939 (a)(2)	Structure type Recorded?	Yes ☐	No ☐	N/A ☐
.1939 (a)(2)	Consistence Recorded?	Yes ☐	No ☐	N/A ☐
.1939 (a)(2)	Mineralogy Recorded?	Yes ☐	No ☐	N/A ☐
.1939 (a)(3)	Soil Wetness Condition Recorded?	Yes ☐	No ☐	N/A ☐
.1939 (a)(4)	Soil Depth to Rock or Parent Material Recorded When Encountered	Yes ☐	No ☐	N/A ☐
.1939 (a)(5)	Depth to Restrictive Horizons Recorded When Encountered?	Yes ☐	No ☐	N/A ☐
.1939 (a)(6)	Sufficient Available Space Recorded?	Yes ☐	No ☐	N/A ☐
.1937(m)	Are the Profile Locations Shown?			
.1939(a)	Are the S/PS Profiles in system & in repair area?	Yes ☐	No ☐	N/A ☐
& .1945(b)	Number of auger borings made: _____ Were sufficient auger borings made?	Yes ☐	No ☐	N/A ☐
.1939(d), .1955, .1956, .1957	LTAR	Yes ☐	No ☐	N/A ☐
	Improvement Permit/Construction Authorization			
.1937(g) 130A-336(a)	Proposed System Type stated-Initial	Yes ☐	No ☐	N/A ☐
.1945(b)	Proposed System Type stated-Repair	Yes ☐	No ☐	N/A ☐
130A-336 (a)(3)	System location identifiable by setbacks - Initial	Yes ☐	No ☐	N/A ☐
.1937(g) .1945(b)	System components shown – Initial	Yes ☐	No ☐	N/A ☐
.1945(b)	Repair area shown	Yes ☐	No ☐	N/A ☐
.1937 (f)(g)	Does System design match facility, flow & WWcharacteristics?	Yes ☐	No ☐	N/A ☐
.1937 (f)(g)	Is System design consistent with soil/site conditions?	Yes ☐	No ☐	N/A ☐
.1937 (f)(g)	Is the System located in the approved area?	Yes ☐	No ☐	N/A ☐
130A-336(a)	Is the Design flow (gpd) indicated?	Yes ☐	No ☐	N/A ☐

130A-336(a)	Number of Bedrooms, employees, seats, etc. indicated?	Yes ☐	No ☐	N/A ☐
.1937(g)	Trench depth indicated?	Yes ☐	No ☐	N/A ☐
.1937(g)	Trench width indicated?	Yes ☐	No ☐	N/A ☐
.1937(g)	Trench length indicated?	Yes ☐	No ☐	N/A ☐
130A-336(a)(1)	Proposed/existing well shown?	Yes ☐	No ☐	N/A ☐
130A-336(a)(1)	Property line lengths shown?	Yes ☐	No ☐	N/A ☐
130A-336(a)	Facility/appurtenance setbacks shown from fixed points?	Yes ☐	No ☐	N/A ☐
	Operation Permit			
.1937(i)	System type as described in table V(a) of rule .1961	Yes ☐	No ☐	N/A ☐
.1937(i)	Conditions for system performance, operation, maintenance, monitoring and reporting.	Yes ☐	No ☐	N/A ☐

II. WASPS Review:

Construction authorization issued	Yes ☐	No ☐	N/A ☐
Installation approval issued	Yes ☐	No ☐	N/A ☐
Operation permit issued	Yes ☐	No ☐	N/A ☐
Other related documentation	Yes ☐	No ☐	N/A ☐

Items requiring correction/modification: _____

Comments:

_____

_____

_____

_____

_____

IA issued date: _____

OP issued date: _____

Review performed by: IR Date performed: 6 26 09

MECKLENBURG COUNTY
LAND USE AND ENVIRONMENTAL SERVICES
Payment Receipt

Receipt Information

Date: 06/19/09
Receipt #: 63299
Check / Auth #: ECHECK 243
Received By: MULLIVR

Amount: 100.00
Tendered: 100.00
Returned: 0.00

Account Information

Account #: 200000
Contractor: ASHFORD JAMES K
Attn:
Address: 11410 LAUREN LN
Address:
City/State/Zip: DAVIDSON, NC 28036

Item	Description	Permit#	Quantity	Unit Price	Total Price
0705	MH Exc/Add/Repl w/o System Mod PN 00716241/11410 LAUREN LN		1	100.00	100.00

James K. Ashford, Jr. NCDL 8825971
Jennifer S. Ashford NCDL 6088955
Wk Ph (704) 947-7724
7605 Garnkirk Drive
Huntersville, NC 28078

2435
6-19 2009
56-21/530

PAY TO THE ORDER OF MECKLENBURG COUNTY $100.00
ONE HUNDRED AND NO/100 DOLLARS

WACHOVIA BANK, N.A.
HUNTERSVILLE, NC 28078

FOR _____ James K Ashford

⑆053000219⑆ 2018657531638⑈ 2435

----------Outstanding Balances----------

Month-To-Date	Prior Month	30 Days	60 Days	90 Days	Balance
275.00	160.00				

Groundwater & Wastewater Services
Septic Project File & Data Review Worksheet

GWS File #: 6131 B WASPS App #: 354

Primary ES assigned to project: OJ

Secondary ES assigned to project: _____

Project Type: New System ☑ Alteration ☐ Repair ☐ Modified Plot Plan ☐

I. File Review:

Rule or Law	Permit Application			
.1937(d)	Is the Application complete	Yes ☑	No ☐	N/A ☐
.1937(d)	Is there a Site plan/Plat with application	Yes ☑	No ☐	N/A ☐
.1937(d)	Is the Facility shown?	Yes ☐	No ☐	N/A ☐
.1937(d)	Are appurtenances shown	Yes ☑	No ☐	N/A ☐
	Site Evaluation Information			
.1939 (a)(1)	Topography and Landscape Position Recorded?	Yes ☑	No ☐	N/A ☐
.1940 (a-g)	Slope % Recorded?	Yes ☑	No ☐	N/A ☐
.1939 (a)(2)	Texture Class Recorded?	Yes ☑	No ☐	N/A ☐
.1939 (a)(2)	Structure type Recorded?	Yes ☑	No ☐	N/A ☐
.1939 (a)(2)	Consistence Recorded?	Yes ☑	No ☐	N/A ☐
.1939 (a)(2)	Mineralogy Recorded?	Yes ☑	No ☐	N/A ☐
.1939 (a)(3)	Soil Wetness Condition Recorded?	Yes ☐	No ☐	N/A ☑
.1939 (a)(4)	Soil Depth to Rock or Parent Material Recorded When Encountered	Yes ☐	No ☐	N/A ☑
.1939 (a)(5)	Depth to Restrictive Horizons Recorded When Encountered?	Yes ☐	No ☐	N/A ☑
.1939 (a)(6)	Sufficient Available Space Recorded?	Yes ☑	No ☐	N/A ☐
.1937(m)	Are the Profile Locations Shown?	✓		
.1939(a)	Are the S/PS Profiles in system & in repair area?	Yes ☑	No ☐	N/A ☐
& .1945(b)	Number of auger borings made: 3 Were sufficient auger borings made?	Yes ☑	No ☐	N/A ☐
.1939(d), .1955, .1956, .1957	LTAR .215	Yes ☑	No ☐	N/A ☐
	Improvement Permit/Construction Authorization			
.1937(g) 130A-336(a)	Proposed System Type stated-Initial	Yes ☑	No ☐	N/A ☐
.1945(b)	Proposed System Type stated-Repair	Yes ☐	No ☐	N/A ☐
130A-336 (a)(3)	System location identifiable by setbacks - Initial	Yes ☐	No ☐	N/A ☐
.1937(g) .1945(b)	System components shown – Initial	Yes ☑	No ☐	N/A ☐
.1945(b)	Repair area shown	Yes ☐	No ☐	N/A ☐
.1937 (f)(g)	Does System design match facility, flow & WWcharacteristics?	Yes ☑	No ☐	N/A ☐
.1937 (f)(g)	Is System design consistent with soil/site conditions?	Yes ☑	No ☐	N/A ☐
.1937 (f)(g)	Is the System located in the approved area?	Yes ☑	No ☐	N/A ☐
130A-336(a)	Is the Design flow (gpd) indicated?	Yes ☑	No ☐	N/A ☐

130A-336(a)	Number of Bedrooms, employees, seats, etc. indicated?	Yes ☑	No ☐	N/A ☐
.1937(g)	Trench depth indicated?	Yes ☑	No ☐	N/A ☐
.1937(g)	Trench width indicated?	Yes ☑	No ☐	N/A ☐
.1937(g)	Trench length indicated?	Yes ☑	No ☐	N/A ☐
130A-336(a)(1)	Proposed/existing well shown?	Yes ☑	No ☐	N/A ☐
130A-336(a)(1)	Property line lengths shown?	Yes ☑	No ☐	N/A ☐
130A-336(a)	Facility/appurtenance setbacks shown from fixed points?	Yes ☑	No ☐	N/A ☐

Operation Permit

.1937(i)	System type as described in table V(a) of rule .1961	Yes ☑	No ☐	N/A ☐
.1937(i)	Conditions for system performance, operation, maintenance, monitoring and reporting.	Yes ☑	No ☐	N/A ☐

II. WASPS Review:

Construction authorization issued	Yes ☐	No ☐	N/A ☐
Installation approval issued	Yes ☐	No ☐	N/A ☐
Operation permit issued	Yes ☐	No ☐	N/A ☐
Other related documentation	Yes ☐	No ☐	N/A ☐

Items requiring correction/modification: _____

Comments:

_____

_____

_____

_____

_____

IA issued date: 5/30/07

OP issued date: _____

Review performed by: VM Date performed: 6/26