SEE INSTRUCTIONS ON BACK

Date Received 8/28/78

ICAR(S) Application No. 14434

T C. No. 077-128-14


Map Date 4-19-77

MECKLENBURG COUNTY
DEPARTMENT OF ENVIRONMENTAL HEALTH

Application for an
Installation, Construction, Alteration, and/or Repair Permit
(Individual Septic Tank System with Subsurface, Soil Absorption, Effluent Discharge)

The owner of that property described hereinafter hereby applies to the Mecklenburg County Department of Environmental Health for a permit to

1) Install or Construct 2) ✓ Alter or Repair on individual septic tank wastewater treatment system with a subsurface soil absorption effluent discharge Bedroom

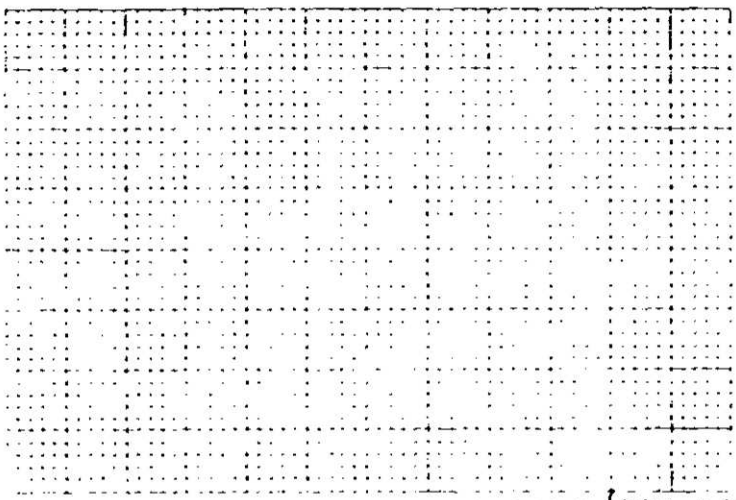

3 PLOT PLAN ACCURATELY DIMENSIONED (John H Sergeas Co, Inc.)

Mobile Home	Yes ✓	No
Residence	Yes	No ✓
4 No. of Bedrooms		
5 Water Use	Mtr. No. 15	
Dishwasher	Yes	No ✓
Washing Machine	Yes ✓	No
Garbage Disposal	Yes	No ✓
Softener	Yes	No ✓
Water Supply		
Individual Well	✓	
Governmental System		
Community System		
Well Source		
Governmental Source		
Sewage System		
Public sewer within 200 feet	Yes ✓	No
Public sewer within 200 feet of	Yes	No ✓

13) NAME OF OWNER Sergeas (LAST) John (FIRST) H (MIDDLE)

14) ADDRESS OF OWNER 4909 The Plaza (28215)

15) PHONE NO Home 537-7613 Office Home 537-8835

16) LOCATION OF SYSTEM 4909 The Plaza (STREET OR COUNTY ROAD)

17 SUBDIVISION Lot No Block No

Map Book No Page No

18) DEED REFERENCE DEED BOOK AT PAGE

19) IS A SOIL EVALUATION NEEDED? YES NO DATE RUN

20) PIN NUMBER (from property tax notice)

The undersigned person hereby agrees that he has read the foregoing application and that the contents of same are true. It is understood that any permit applied for herein shall be void and of no effect if any of the above facts are not true.

8/24/78
DATE OF APPLICATION

OWNER John H Sergeas

EHS 76

Environmental Health Department's Copy


Date Issued August 21 1978 Serial No. 1907 ICAR(S) Permit No. 14434

T C No 097-128-14

Map Date

MECKLENBURG COUNTY
DEPARTMENT OF ENVIRONMENTAL HEALTH
INSTALLATION, CONSTUCTION, ALTERATION, AND/OR REPAIR PERMIT
(Individual Septic Tank System with Subsurface, Soil Absorption, Effluent Discharge)

Permission is hereby given to Install or Construct, ✓ Alter or Repair the individual septic tank wastewater treatment system with subsurface, soil absorption effluent discharge as specified herein at the described location. This permit is granted based upon the information supplied in application 14434, dated and this permit shall be void and of no effect if the information provided in the application is not true or correct as All work shall be completed on or before , after which date this permit shall be null and void

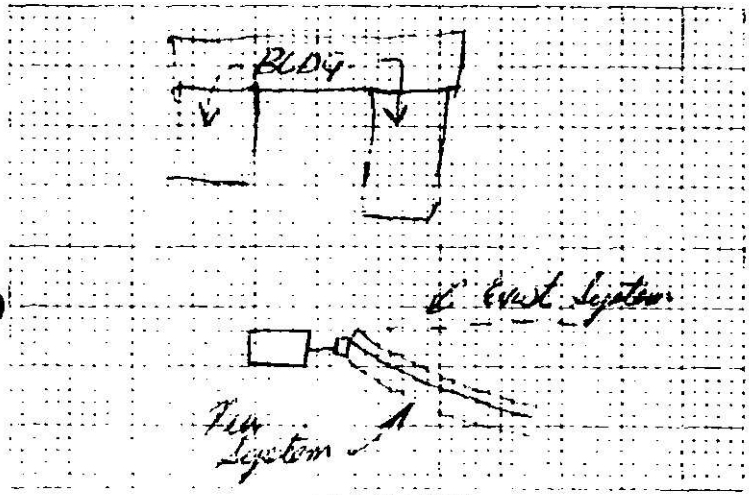

Permeability Rate —

Liquid Capacity of Tank 1000/gal.

Tank Construction PC

Absorption and Distribution Lines

Total Line Length 330

Number of Lines 5

Distance from Bldg 25'+

Distance from Property Line 25'+

Distance from Well —

SKETCH OF SYSTEM

NAME OF OWNER John H. Sieglers

LOCATION OF PROPERTY 4904 The Plaza

This [illegible] construction requirements as set forth in the Regulations of the Mecklenburg County [illegible] in effect on the date of the granting of this permit. A certificate of approval [illegible] Health Director before any system can be covered up or otherwise rendered [illegible] **The issuance of this permit does not in any way guarantee that the system anticipated to be constructed will operate properly, or relieve any person now or hereafter owning, controlling or using such system from any liability resulting from the failure of the system to operate properly.**

15' X 66' Trench Bore

Date Issued Environmentalist

* If this permit is for the installation or construction of a new system, it must be signed by the division or a section head of the Department of Environmental Health in order to be valid. Only the signature of the Environmentalist is required where an existing system is being altered or repaired.

EHS-5 78

[illegible] Health Department's Copy

Date Issued Dec. 18, 1978 Serial No. 2164

C of A (s) No. 14434

T C No. 091-128-14

MECKLENBURG COUNTY
DEPARTMENT OF ENVIRONMENTAL HEALTH
ENVIRONMENTAL HEALTH DIVISION

CERTIFICATE OF APPROVAL
(Individual Septic Tank System with Subsurface, Soil Absorption, Effluent Discharge)

Name of Owner Segura (LAST) John (FIRST) H. (MIDDLE)

Location of Property 4903 Via Plaza

Application Number 14434 Permit Number 14434

Inspection Date:

Liquid Capacity of Tank — Tank Material —

Total Length of Drain Tile 330 L/ft. Number of Lines 5

Depth of Filter Material 17" Cover Depth 18"

Water Supply Source City Distance from Water Source —

Excavation Inspected — (DATE) Tank Inspected — (DATE)

Nitrification Field Inspected 12-18-78 (DATE)

Washing Machine Line Inspected, If Applicable — (DATE)

The undersigned has inspected the Individual Septic Tank System with subsurface, soil absorption, effluent discharge as described above and it has been installed or constructed, ✓ and is approved in accordance with the permit issued and the regulations of the Mecklenburg County Health Commission in effect on the date of issuance of the permit. The issuance of this Certificate of Approval does not in any way guarantee that the system will operate properly or relieve any person now or hereafter owning, controlling, or using such system from any liability resulting from the failure of the system to operate properly. This Certificate of Approval is issued subject to those restrictions and conditions shown on the permit in addition to those listed below under comments. This Certificate of Approval shall be null and void if any information contained in the application is untrue or if any additions are made to the property which would increase the requirements for said system.

Comments Repair 15'x66'

Eddie Segura
Environmentalist

EHD-5-76

Environmental Health Department's Copy