

4823 CAMILLA DR

21113223

1/7/2008

duponbj

Groundwater and Wastewater Services File Imaging Project
May 2007
Barcode Font = IDAutomationHC39M

Mecklenburg County
Health Department

June 6, 2002

Eric Markel
15614 McMullens Court
Charlotte, NC 28277

Re: Application for improvement permit for Chris C. Kearns
Property Site: Camilla Drive, Lot #1
Health Department file no. 4954B

Dear Property Owner or Owner's Agent:

The Mecklenburg County Health Department, Environmental Health Division on May 31, 2002 evaluated the above-referenced property at the site designated on the plat/site plan that accompanied your improvement permit application. According to your application the site is to serve a 6-bedroom residence, with a design wastewater flow of ___720____gallons per day. The evaluation was done in accordance with the laws and rules governing wastewater systems in North Carolina General Statute 130A-333 and related statutes and Title 15A, Subchapter 18A, of the North Carolina Administrative Code, Rule .1900 and related rules.

Based on the criteria set out in Title 15A, Subchapter 18A, of the North Carolina Administrative Code, Rules .1940 through .1948, the evaluation indicated that the site is **UNSUITABLE for** a ground absorption sewage system. Therefore, your request for an improvement permit is **DENIED.** A copy of the site evaluation is enclosed. The site is unsuitable based on the following:

_____Unsuitable soil topography and/or landscape position (Rule .1940)
_____Unsuitable soil characteristics (structure or clay mineralogy) (Rule .1941)
_____Unsuitable soil wetness condition (Rule .1942)
___X___Unsuitable soil depth (Rule .1943)
_____Presence of restrictive horizon (Rule .1944)
___X___Insufficient space for septic system and repair area (Rule .1945)
_____Unsuitable for meeting required setbacks (Rule .1950)
_____Other (Rule .1946)

For the reasons set out above, the property is currently classified **UNSUITABLE,** and an improvement permit shall not be issued for this site in accordance with Rule .1948 (c).

However, the site classified as **UNSUITABLE** may be classified as **PROVISIONALLY SUITABLE** if written documentation is provided that meets the requirements of Rule .1948(d). A copy of this rule is enclosed. You may hire a consultant to assist you if you wish to try to develop a plan under which your site could be reclassified as **PROVISIONALLY SUITABLE.**

You have a right to an informal review of this decision. You may request an informal review by the soil scientist or environmental health supervisor at the local health department. You may also request an informal review by the N. C. Department of Environment and Natural Resources regional soil specialist. A request for informal review must be made in writing to the local health department.

You also have a right to a formal appeal of this decision. To pursue a formal appeal, you must file a petition for a contested case hearing with the Office of Administrative Hearings, 6714 Mail Center, Raleigh, NC 27699-6714. To get a copy of a petition form, you may write the Office of Administrative Hearings or call the office at (919) 733-0926. The petition for a contested case hearing must be filed in accordance with the provision of North Carolina General Statutes 130A-24 and 150B-23 and all other applicable provisions of Chapter 150B. N. C. General Statue 130A-335(g) provides that your hearing would be held in the county where your property is located.

Please note: If you wish to pursue a formal appeal, you must file the petition form with the Office of Administrative Hearings **WITHIN 30 DAYS OF THE DATE OF THIS LETTER.** The date of this letter is June 6, 2002. Meeting the 30-day deadline is critical to your right to a formal appeal. Beginning a formal appeal within 30 days will not interfere with any informal review that you might request. Do no wait for the outcome of any informal review if you wish to file a formal appeal.

If you file a petition for a contested case hearing with the Office of Administrative Hearings, you are required by law (N.C. General Statute 150B-23) to send a copy of your petition to the North Carolina Department of Environment and Natural Resources. Send the copy to: Office of General Counsel, N. C. Department of Environment and Natural Resources, 1601 Mail Service Center, Raleigh, NC. 27699-1601. Do **NOT** send the copy of the petition to your local health department. Sending a copy of your petition to the local health department will **NOT** satisfy the legal requirement in N.C. General Statute 150B-23 that you send a copy to the Office of General Counsel, NCDENR.

You may call or write the local health department if you need any additional information or assistance.

Sincerely,

Joshua R. Sellers R. S.

Joshua R. Sellers, R.S.
Authorized Agent - DENR

Encl: (2)

Department of Environment, Health, and Natural Resources
Division of Environmental Health
On-site Wastewater Section

Sheet: 1
Property ID: PO 211-132-07
Lot #: 1
File #: 4954B
Code: 2

SOIL/SITE EVALUATION
for ON-SITE WASTEWATER SYSTEM

Owner: Eric Markel
Applicant: Chris Kearns
Address: 15614 Mccullers Ct., Charlotte, N. C. 28277
Date Evaluated: 05/23/2002
Proposed Facility: Residence
Design Flow (.1949): 720gpd
Property Size: .6a
Location of Site: 4823 Camilla Drive
Property Recorded:
Water Supply: [x] Public [ ] Individual [ ] Well [ ] Spring [ ] Other
Evaluation Method: [x] Auger Boring [ ] Pit [ ] Cut
Type of Wastewater: [x] Sewage [ ] Industrial Process [ ] Mixed

PROFILE #	1940 Landscape Position/ Slope%	Horizon Depth (IN.)	SOIL MORPHOLOGY .1941 .1941 Structure/ Texture	.1941 Consistence Mineralogy	OTHER PROFILE FACTORS .1942 Soil Wetness/ Color	.1943 Soil Depth (IN.)	.1956 Sapro Class	.1944 Restr Horiz	Profile Class & LTAR
1	LS, 10	0-9	M/CL	FR/SEXP/SS/SP	>28" TO SOIL WETNESS	28	N/A	NONE	US, IV .15GPD/FT^2 LPP
		9-28	SBK/C	FI/SEXP/S/P					
		28+	M/SL	FR/SEXP/NS/NP					
2	"	0-3	GR/CL	FR/SEXP/SS/SP	>40" TO SOIL WETNESS	40	"	"	PS, IV .3GPD/FT^2
		3-30	SBK/C	FI/SEXP/S/P					
		30-40	SBK/CL	FR/SEXP/SS/SP					
3	"	0-22	GR/CL	FR/SEXP/SS/SP	>26" TO SOIL WETNESS	26+	"	"	IV
		22-26	SBK/C	FI/SEXP/S/P					
		BORING TERMINATED @26", FLOATER ROCK							
4	LS, 15	0-4	GR/CL	FR/SEXP/SS/SP	>48" TO SOIL WETNESS	48+	"	"	PS, IV .3GPD/FT^2
		4-31	SBK/CL	FR/SEXP/SS/SP					
		31-48+	SBK/C	FI/ SEXP/S/P					
5	LS, 10	0-4	GR/CL	FR/SEXP/SS/SP	>49" TO SOIL WETNESS	49	"	"	"
		4-49	SBK/C	FI/SEXP/S/P					

Description	Initial System	Repair System
Available Space (.1945)	US	US
System Type(s)		
Site LTAR	.3GPD/FT^2	.3GPD/FT^2

Other Factors (.1946): _____
Site Classification (.1948): UNSUITABLE
Evaluated By: W. R. Martin, LSS, 5/28/02 W. R. Martin
Others Present:


FILE # 49548

COMMENTS 100% Repair - area to rear of lot 3 to be considered for drainfield installation also

LANDSCAPE POSITION	GROUP	TEXTURE	.1955 LTAR
R-RIDGE	I	S-SAND	1.2-0.8
S-SHOULDER SLOPE		LS-LOAMY SAND	
L-LINEAR SLOPE			
FS-FOOT SLOPE	II	SL-SANDY LOAM	0.8-0.6
N-NOSE SLOPE		L-LOAM	
H-HEAD SLOPE			
CC-CONCLAVE SLOPE	III	SI-SILT	0.6-0.3
CV-CONVEX SLOPE		SICL-SILTY CLAY LOAM	
T-TERRACE		CL-CLAY LOAM	
FP-FLOOD PLAIN		SCL-SANDY CLAY LOAM	
	IV	SC-SANDY CLAY	0.4-0.1
		SIC-SILTY CLAY	
		O-ORGANIC	

CONSISTENCE MOIST	CONSISTENCE WET
VFR-VERY FRIABLE	NS-NON-STICKY
FR-FRIABLE	SS-SLIGHTLYSTICKY
FI-FIRM	S-STICKY
VFI-VERY FIRM	VS-VERY STICKY
EFI-EXTREMELY FIRM	NP-NON-PLASTIC
	SP-SLIGHTLYSTICKY
	P-PLASTIC
	VP-VERY PLASTIC

STRUCTURE	MINERALOGY
SG-SINGLE GRAIN	SLIGHTLY EXPANSIVE
M-MASSIVE	
CR-CRUMB	EXPANSIVE
GR-GRANULAR	
SBK-SUBANGULAR BLOCKY	
ABK-ANGULAR BLOCKY	
PL-PLATY	
PR-PRISMATIC	

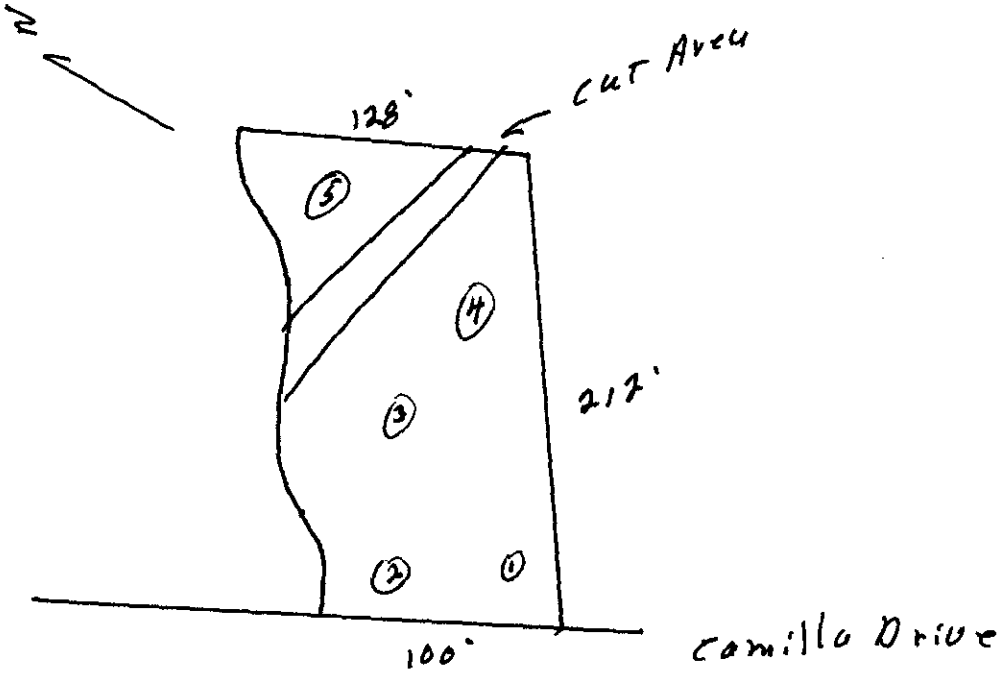

FEE: 300
DATE: 5/9/02

APPLICATION FOR IMPROVEMENT PERMIT FOR RESIDENTIAL SITE INDIVIDUAL WATER AND WASTEWATER SYSTEMS PROGRAM

[ ] CRT

TYPE APPLICATION: [X] NEW SYSTEM [ ] EXPANSION/ ALTERATION OF EXISTING SYSTEM [ ] REPAIR OF EXISTING SYSTEM

NORTH CAROLINA
DEPARTMENT OF ENVIRONMENT,
HEALTH, AND NATURAL RESOURCES
DIVISION OF ENVIRONMENTAL HEALTH
ON-SITE WASTEWATER SECTION

FILE #: 49548

PROPERTY INFORMATION (FROM ENGINEERING FORM) FOR JOB LOCATION:

TAX/PARCEL NUMBER: 211-132-07

STREET ADDRESS: CAMILLA DRIVE

SUBDIVISION OR MOBILE HOME PARK NAME:

LOT NUMBER: 1

TYPE OF BUILDING (CHECK ONE): RESIDENCE

[ ] SINGLE MOBILE HOME(S) [ ] MODULAR HOME (M)
[ ] DOUBLE WIDE (D) [ ] MULTIPLE FAMILY (U)
[X] HOUSE (H) [ ] OTHER (O)

HEATED SQUARE FOOTAGE: 5850

NUMBER OF BEDROOMS: 6 NUMBER OF OCCUPANTS:

FOUNDATION FOR RESIDENCE:

[ ] WITHOUT BASEMENT
[X] ON SLAB
[ ] CRAWL SPACE
[X] WITH BASEMENT /PLUMBING
[ ] WITH BASEMENT /NO PLUMBING

TOWNSHIP (CHECK ONE):

[ ] 0 MECKLENBURG
[X] 1 CHARLOTTE
[ ] 2 DAVIDSON
[ ] 3 CORNELIUS
[ ] 4 PINEVILLE
[ ] 5 MATTHEWS
[ ] 6 HUNTERSVILLE
[ ] 7 MINT HILL

CLOSING DATE _____

IF EXPANSION/ALTERATION OF EXISTING SYSTEM, DESCRIBE THE PROPOSED BUILDING ADDITION:

WILL THERE BE A HOME BUSINESS IN THE RESIDENCE: [ ] YES [X] NO TYPE: _____

WATER SUPPLY (CHECK ONE):
[ ] COMMUNITY (C) [X] MUNICIPAL (M) [ ] PRIVATE WELL (P)
[ ] SHARED WELL (S) [ ] OTHER 'SPRINGS' (O)

IF ANY OF THE FOLLOWING ARE LOCATED ON THE PROPERTY, PLEASE SHOW LOCATION ON PLAT:

BURIED CABLES, LANDFILLS, STUMPHOLES [ ] YES [X] NO
EXISTING WASTEWATER SYSTEMS [ ] YES [X] NO
EASTMENTS OR RIGHT-OF-WAYS [ ] YES [X] NO
WELL, SPRINGS OR WATERLINES [ ] YES [X] NO
DESIGNATED WETLANDS [ ] YES [X] NO

PROPERTY OWNER:

NAME: MARKEL, ERIC
(LAST) (FIRST) (MI)

ADDRESS: 15614 McCullers Ct.

CITY: CHARLOTTE STATE: NC ZIP: 28277

DAYTIME PHONE: (704) 341-4297

LEGAL AGENT FOR PROPERTY OWNER, IF APPLICABLE:

NAME: KEARNS, CHRIS C.
(LAST) (FIRST) (MI)

DAYTIME PHONE: (704) 309-2700

Please call me to meet on site 11 00

WHAT DATE WAS THE PROPERTY ORIGINALLY DEEDED AND RECORDED? _____

An Improvement Permit is subject to suspension or revocation if site plans or the intended use change or if information submitted in this application is falsified or changed. The undersigned, owner, or legal agent for the owner, of the property described above as the "Job Location" has read the foregoing application, acknowledges that the contents of same are true, and authorizes agents of the Mecklenburg County Health Department to enter onto the property for the purpose of processing this request.

SIGNED: [signature] DATE: 5/9/02

MECKLENBURG COUNTY HEALTH DEPARTMENT
ENVIRONMENTAL HEALTH DIVISION
c/o HAL MARSHALL CTR., SUITE 211, 700 N. TRYON ST., CHARLOTTE, N.C. 28202., (704) 336-5102


PROPOSED PLOT PLAN

HEALTH DEPARTMENT
ENVIRONMENTAL HEALTH DIVISION
700 NORTH TRYON STREET
CHARLOTTE, NC 28202
PHONE (704) 336-5102

FILE: 4954B

TC: 211.132.07

Draw in and name all roads adjoining the property. Draw in and accurately dimension the lot concerned. Accurately indicate property boundaries proposed and/or existing structures and driveways, underground utilities, and wells and springs within 100 feet of the proposed building or drainfield.

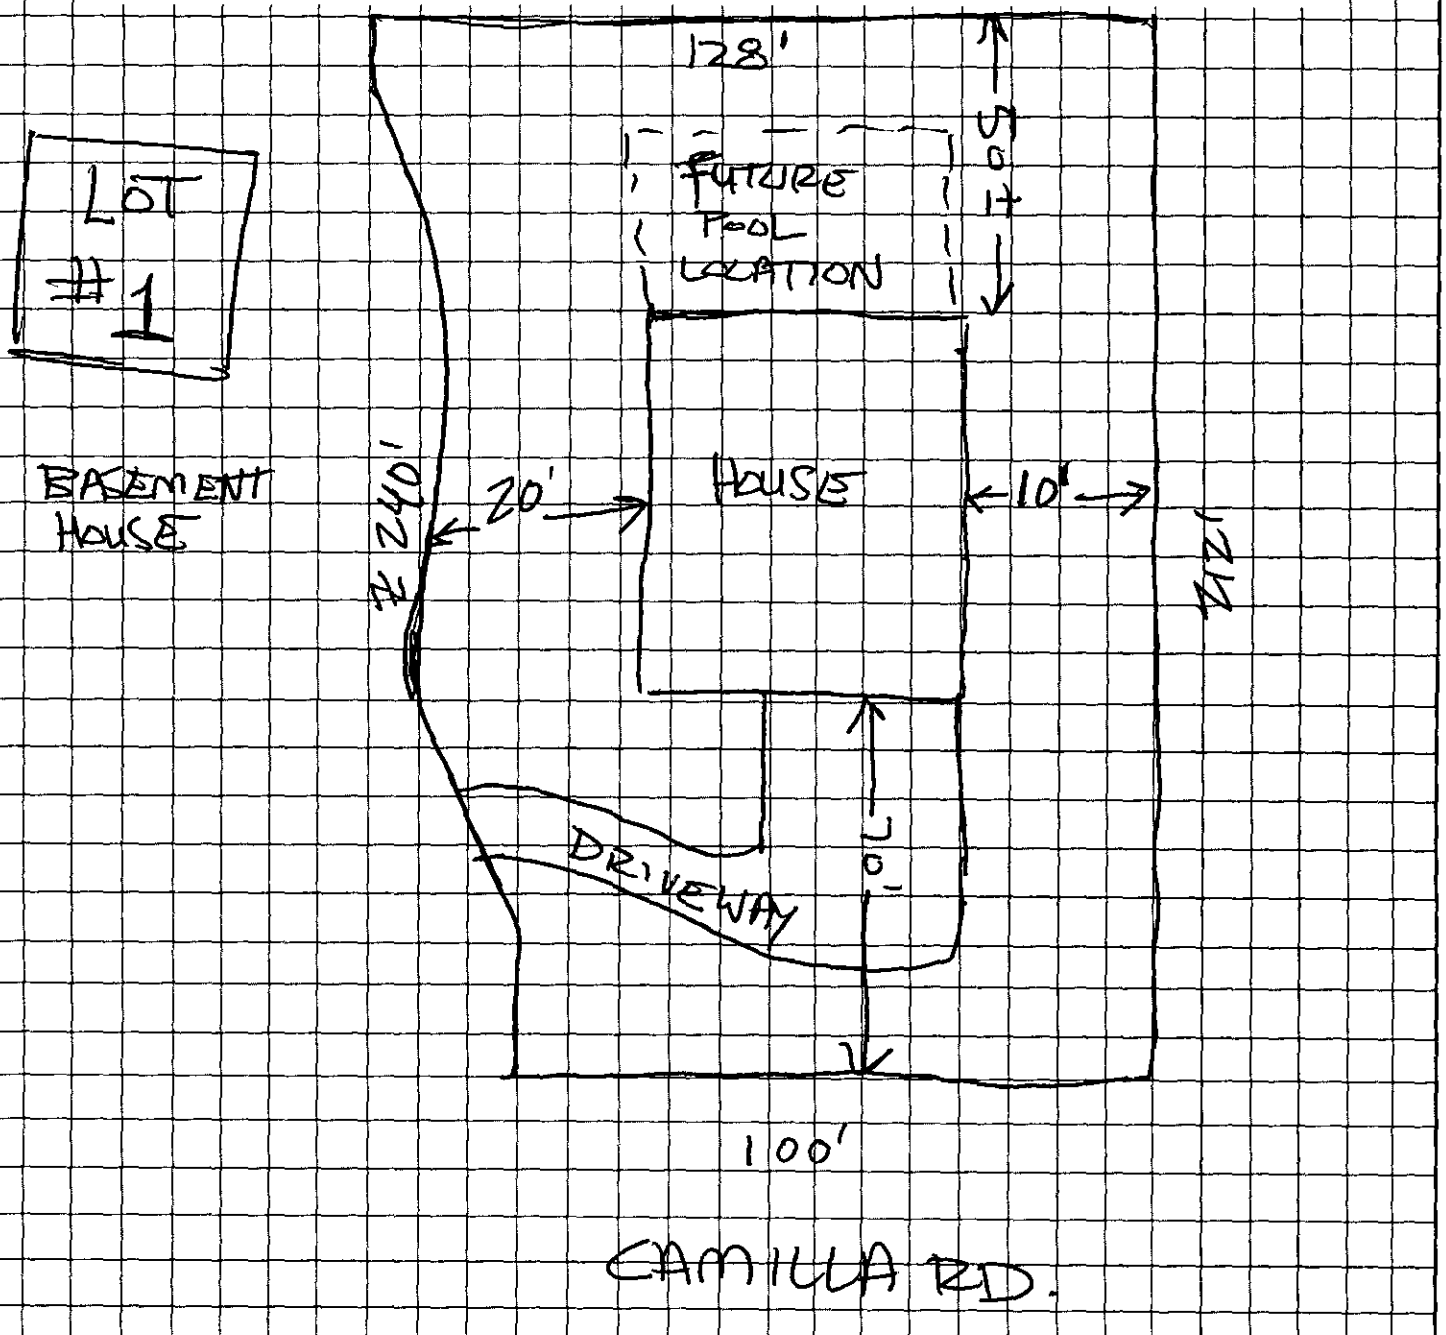

OWNER/AGENT SIGNATURE

DATE 5/9/02

APPROVAL DATE _____

White - Health Department's Copy Canary - E.H.S. Copy Pink - Owner's Copy

1- 2.54 4/1 @ 21"

0- 4"SQ S

4- 2 4" SQ S

2- 0 - 4/1 S1

4-2 1" C ABOVE

2.54 1/1 @ 21"

1-0- 3/1 C1

5-30+C

2-0-6/1 C1

6-46" C

46-50'-4 C1

3- 2.34 3/1 @ 37"

0-4'/1

4-37" C1

37" + 3/1

1-0- 6/1 S C1

6-26" C


26-4/1 B/1

2-0-6" SQ C1

6-16 C1 SB/1

16-40 C

40-46" C1

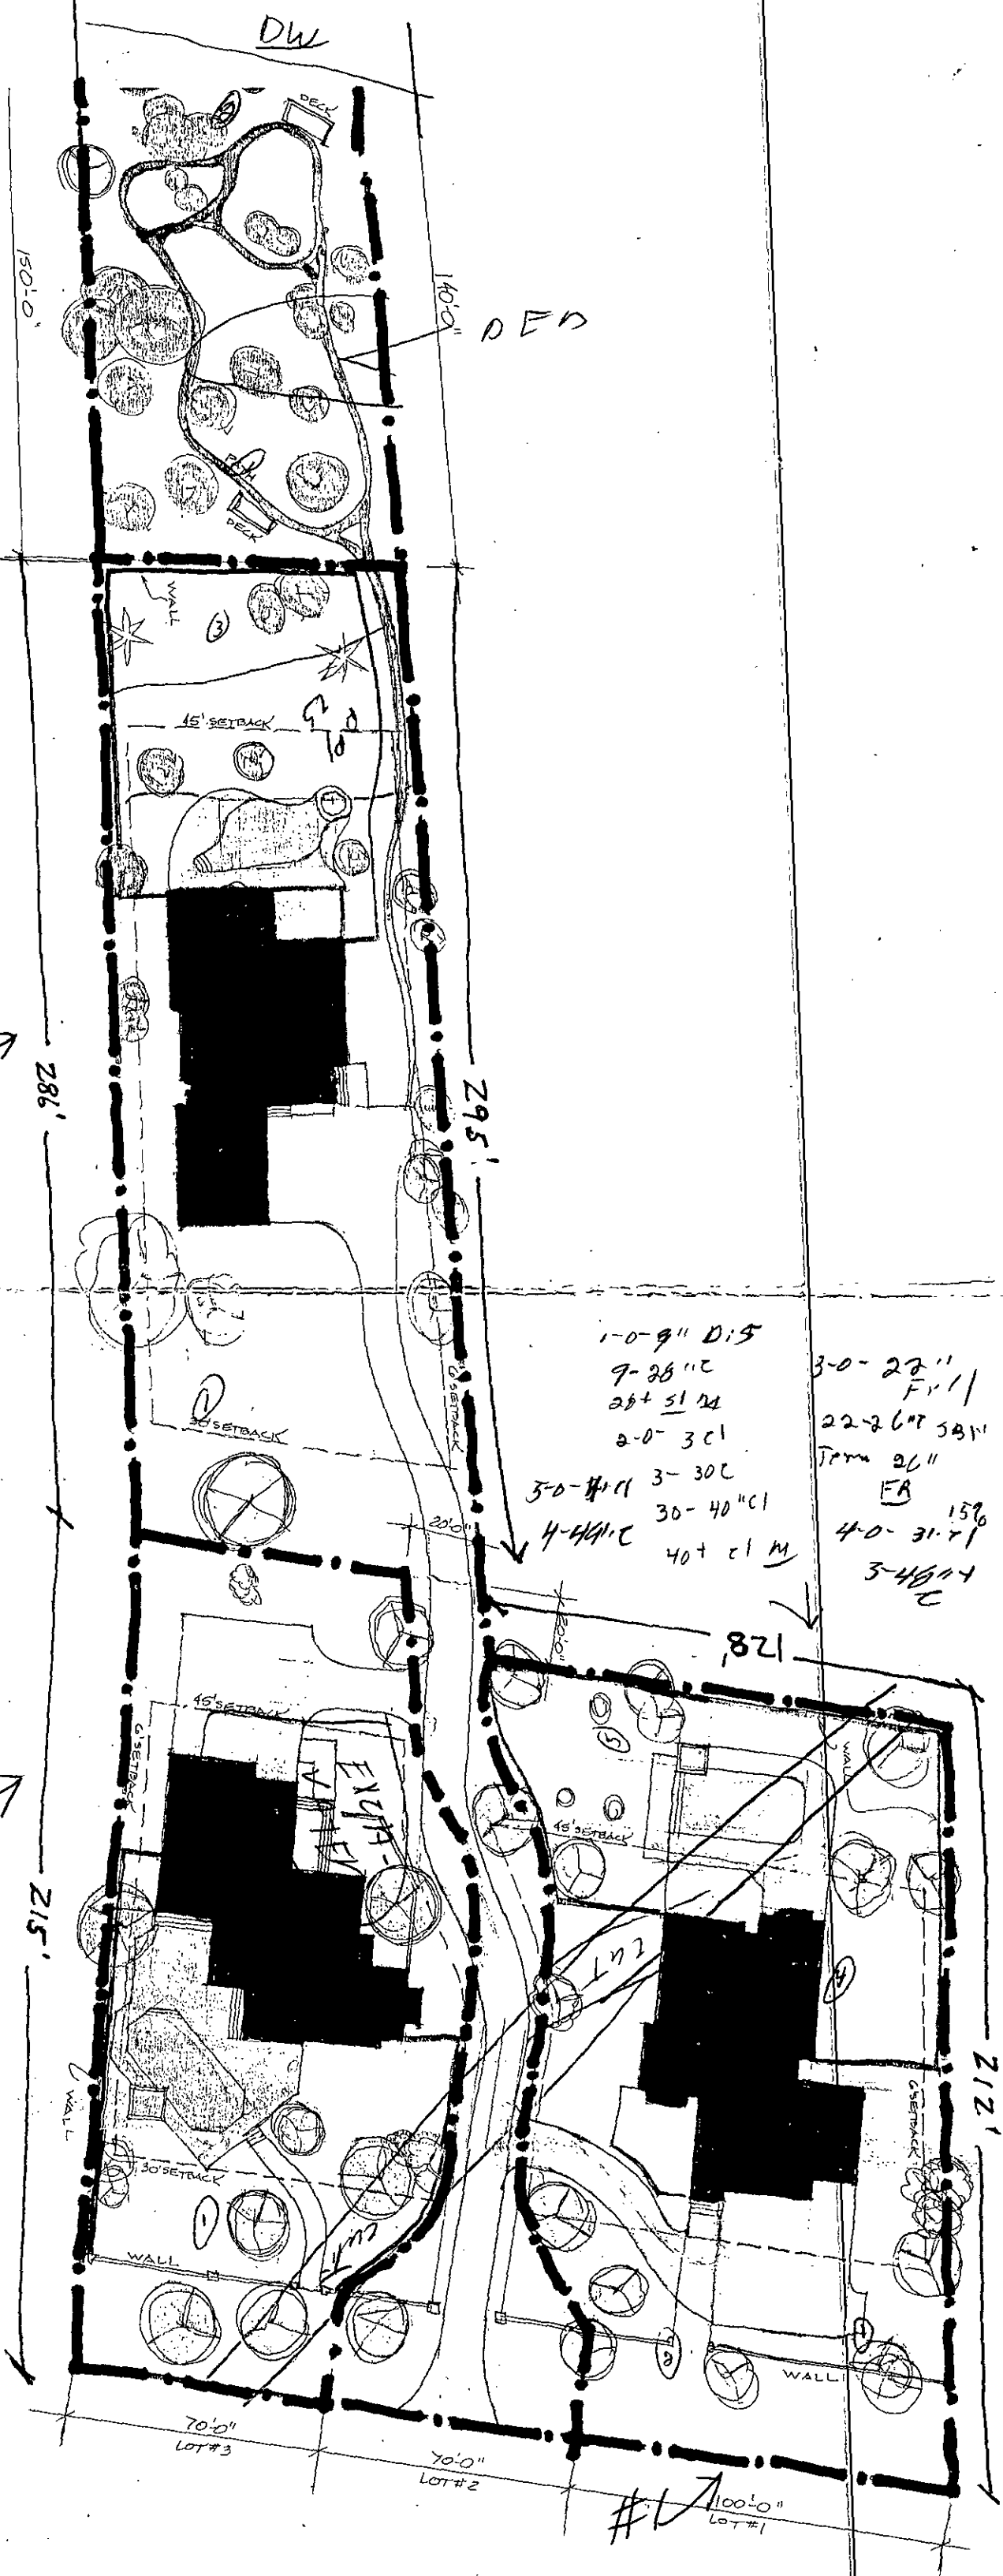

PROPOSED SITE PLAN
CAMILLA PARK
1"=20'
SCHRADER DESIGN
5-5-02

1-0-9" D.S
9-26" C
26+ S1 M
2-0- 3 C1
3-0-4+C1 3- 30 C
4-46/1 C 30- 40" C1
40+ C1 M

3-0- 22" F.1/
22-26" SB/1
Term 26"
FR
4-0- 31.7 15%
3-46/1 C


