

5101 CAMP STEWART RD

12/31/2007

duponbj

Groundwater and Wastewater Services File Imaging Project
May 2007
Barcode Font = IDAutomationHC39M

FEE: 350.00 CK# 0087
DATE: 6-19-98
V&S

APPLICATION FOR IMPROVEMENT PERMIT FOR RESIDENTIAL SITE INDIVIDUAL WATER AND WASTEWATER SYSTEMS PROGRAM

[ ] CRT

TYPE APPLICATION: ___ NEW SYSTEM __ EXPANSION/ ALTERATION OF EXISTING SYSTEM ___ REPAIR OF EXISTING SYSTEM

NORTH CAROLINA
DEPARTMENT OF ENVIRONMENT,
HEALTH, AND NATURAL RESOURCES
DIVISION OF ENVIRONMENTAL HEALTH
ON-SITE WASTEWATER SECTION

Consultation

FILE #: 23778

PROPERTY INFORMATION (FROM ENGINEERING FORM) FOR JOB LOCATION:

TAX/PARCEL NUMBER: 111-092-31

STREET ADDRESS: 9901 LONG BRANCH

SUBDIVISION OR MOBILE HOME PARK NAME:

LOT NUMBER:

TYPE OF BUILDING (CHECK ONE):

___ SINGLE MOBILE HOME(S)
___ DOUBLE WIDE (D)
X HOUSE (H)
___ MODULAR HOME (M)
___ MULTIPLE FAMILY (U)
___ OTHER (O)

TOWNSHIP (CHECK ONE):

___ 0 MECKLENBURG
___ 1 CHARLOTTE
___ 2 DAVIDSON
___ 3 CORNELIUS
___ 4 PINEVILLE
___ 5 MATTHEWS
___ 6 HUNTERSVILLE
___ 7 MINT HILL

HEATED SQUARE FOOTAGE:

NUMBER OF BEDROOMS: NUMBER OF OCCUPANTS:

CLOSING DATE _____

7/1/98 Met w/ Doug Boone on lot. Septic tanks were located on lot for future Abandonment. (See back)

FOUNDATION FOR RESIDENCE:

___ WITHOUT BASEMENT
___ ON SLAB
___ CRAWL SPACE
___ WITH BASEMENT /PLUMBING
___ WITH BASEMENT /NO PLUMBING

IF EXPANSION/ALTERATION OF EXISTING SYSTEM, DESCRIBE THE PROPOSED BUILDING ADDITION:

WILL THERE BE A HOME BUSINESS IN THE RESIDENCE: ___ YES ___ NO TYPE: _____

WATER SUPPLY (CHECK ONE):

___ COMMUNITY (C)
___ MUNICIPAL (M)
X PRIVATE WELL (P)
___ SHARED WELL (S)
___ OTHER 'SPRINGS' (O)

IF ANY OF THE FOLLOWING ARE LOCATED ON THE PROPERTY, PLEASE SHOW LOCATION ON PLAT:

BURIED CABLES, LANDFILLS, STUMPHOLES ___ YES ___ NO
EXISTING WASTEWATER SYSTEMS ___ YES ___ NO
EASTMENTS OR RIGHT-OF-WAYS ___ YES ___ NO
WELL, SPRINGS OR WATERLINES ___ YES ___ NO
DESIGNATED WETLANDS ___ YES ___ NO

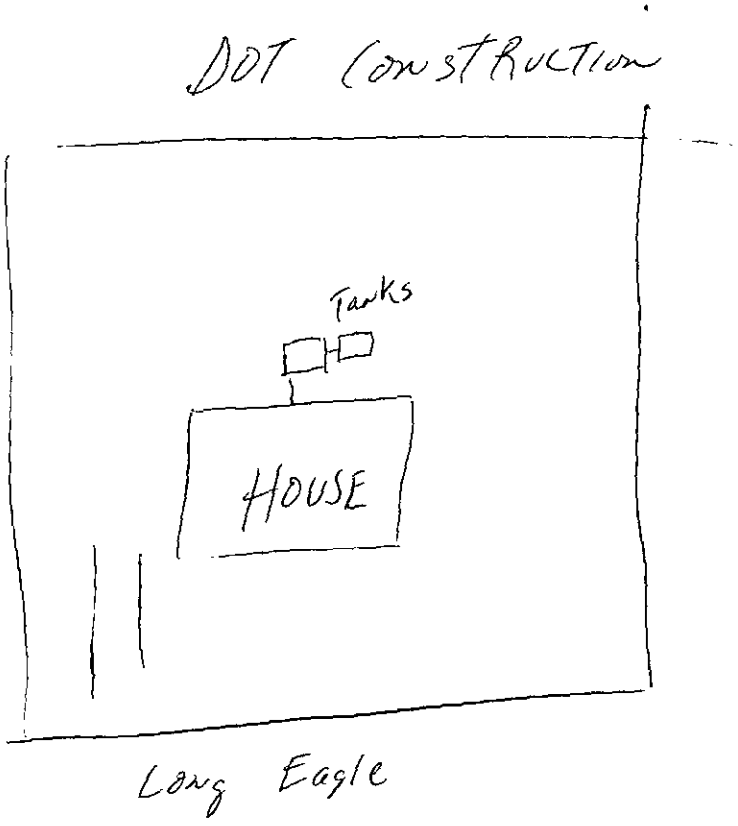
PROPERTY OWNER:	LEGAL AGENT FOR PROPERTY OWNER, IF APPLICABLE:
NAME: NC DEPT. OF TRANSPORTATION (LAST) (FIRST) (MI)	NAME: BOONE DOUGLAS L (LAST) (FIRST) (MI)
ADDRESS:	DAYTIME PHONE: (704) 366-0185
CITY: ASHEMARLE STATE: NC ZIP:	PO BOX 11838
DAYTIME PHONE: ( ) -	CHARLOTTE NC 28220

WHAT DATE WAS THE PROPERTY ORIGINALLY DEEDED AND RECORDED? _____

An Improvement Permit is subject to suspension or revocation if site plans or the intended use change or if information submitted in this application is falsified or changed. The undersigned, owner, or legal agent for the owner, of the property described above as the "Job Location" has read the foregoing application, acknowledges that the contents of same are true, and authorizes agents of the Mecklenburg County Health Department to enter onto the property for the purpose of processing this request.

SIGNED: [signature] DATE: 6/19/98

MECKLENBURG COUNTY HEALTH DEPARTMENT
ENVIRONMENTAL HEALTH DIVISION
c/o HAL MARSHALL CTR., SUITE 211, 700 N. TRYON ST., CHARLOTTE, N.C. 28202., (704) 336-5102


DOT CONSTRUCTION
Tanks
HOUSE
Long Eagle

1"=100'

2572B

= septic FIELDS

