MECKLENBURG COUNTY
HEALTH DEPARTMENT

APPLICATION FOR A RESIDENTIAL SITE IMPROVEMENT PERMIT/ CONSTRUCTION AUTHORIZATION
FOR AN ON-SITE WASTEWATER SYSTEM, NEW WELL INSTALLATION, OR REPAIR OF EXISTING WELL

1. SEPTIC / TYPE APPLICATION: ○ N/A ○ NEW SYSTEM ○ ALTERATION ◉ REPAIR ○ MODIFIED PLOT PLAN

2. WELL / TYPE APPLICATION: ○ N/A ○ NEW WELL ○ MAJOR REPAIR ○ ABANDONMENT

3. JOB LOCATION INFORMATION:

TAX PARCEL NUMBER: _____
STREET ADDRESS: 1135 Trestle Lane
CITY: Charlotte
STATE: NC ZIP: 28216
SUBDIVISION NAME: _____
LOT #: _____ LOT SIZE (acres): 3.44 ac
TOWNSHIP:
◉ MECKLENBURG ○ CORNELIUS ○ HUNTERSVILLE
○ DAVIDSON ◉ CHARLOTTE ○ PINEVILLE
○ MATTHEWS ○ MINT HILL

4. BUILDING INFORMATION:

BUILDING TYPE:
○ SINGLE MOBILE HOME ○ MODULAR HOME
○ DOUBLE WIDE ○ MULTIPLE FAMILY
◉ HOUSE ○ OTHER _____
HEATED SQUARE FOOTAGE: _____
NUMBER OF BEDROOMS: 3
NUMBER OF OCCUPANTS: 2
FOUNDATION TYPE:
○ CONCRETE SLAB ○ BASEMENT WITH PLUMBING
◉ CRAWL SPACE ○ BASEMENT WITH NO PLUMBING

5. IF PLANNING TO EXPAND OR ALTER THE EXISTING SEPTIC SYSTEM PLEASE COMPLETE THE FOLLOWING SECTION: ☐ N/A

NUMBER OF BEDROOMS TO BE ADDED: X NUMBER OF ADDITIONAL OCCUPANTS IN THE RESIDENCE: _____

6. WATER SUPPLY: ○ MUNICIPAL ◉ PRIVATE WELL ○ PUBLIC WELL ○ SHARED WELL ○ OTHER _____

7. PROPOSED USE OF WELL: ○ N/A ○ IRRIGATION ○ POTABLE (DRINKING WATER) ○ OTHER _____

8. PLEASE INDICATE AND RANK DESIRED SEPTIC SYSTEM TYPE(S) IN ORDER OF PREFERENCE (1-MOST DESIRED 5-LEAST DESIRED)

☐ N/A ☑ ANY TYPE ☐ CONVENTIONAL ☐ ACCEPTED ☐ INNOVATIVE ☐ ALTERNATIVE ☐ OTHER _____

8A. RANK: ____ ____ ____ ____ ____

9. DO ANY OF THE FOLLOWING APPLY TO THE PROPERTY IN QUESTION? IF "YES" PLEASE ATTACH SUPPORTING DOCUMENTATION.

RUINED CABLES, LANDFILLS, STUMPHOLES	○ YES ◉ NO	GRADING/SOIL REMOVAL PERFORMED	○ YES ○ NO
EXISTING WASTEWATER (SEPTIC) SYSTEMS	○ YES ◉ NO	JURISDICTIONAL WETLANDS	○ YES ○ NO
WELLS, SPRINGS, OR WATER LINES	○ YES ◉ NO	APPROVAL REQUIRED BY ANY OTHER PUBLIC AGENCY	○ YES ○ NO
EASEMENTS OR RIGHT-OF-WAYS	○ YES ◉ NO	WASTEWATER OTHER THAN DOMESTIC SEWAGE	○ YES ○ NO
CHEMICAL/PETROLEUM STORAGE TANKS	○ YES ◉ NO	KNOWN UNDERGROUND CONTAMINATION	○ YES ○ NO
WASTE STORAGE	○ YES ◉ NO	GROUNDWATER USE RESTRICTIONS/VARIANCES	○ YES ○ NO

10. WHAT DATE WAS THE PROPERTY ORIGINALLY DEEDED AND RECORDED? May, 1999 ☐ UNKNOWN

11. WHAT IS THE ANTICIPATED CLOSING DATE FOR THIS PROPERTY? _____ ☐ N/A

12. PROPERTY OWNER:
NAME: Frederick C. Hinkle & Pamela Hinkle
ADDRESS: 1135 Trestle Lane
CITY: Charlotte
STATE: NC ZIP: 28216
WORK PHONE: _____
MOBILE PHONE: _____
FAX: _____
E-MAIL: fhinkle@carolina.rr.com
Home # 704-399-1445

13. OWNER'S LEGAL REPRESENTATIVE, IF APPLICABLE:
NAME: _____
ADDRESS: _____
CITY: _____
STATE: _____ ZIP: _____
WORK PHONE: _____
MOBILE PHONE: _____
FAX: _____
E-MAIL: _____

MECKLENBURG COUNTY – GROUNDWATER & WASTEWATER SERVICES
700 N. TRYON ST. SUITE 211 CHARLOTTE, NC 28202, OFFICE: 980-314-1680, FAX: 704 336-5604
email: Weldogg@MecklenburgCountyNC.gov

Revised on: 4/20/17

14. SEPTIC SYSTEM PERMIT APPLICATION:

If the information in this application is falsified, changed, or the site is altered, then the Improvement Permit and Authorization to Construct shall become invalid. I have read this application and certify that the information provided herein is true, complete and correct. Authorized county and state officials are granted right of entry to conduct necessary inspections to determine compliance with applicable laws and rules. I understand that I am solely responsible for the proper identification and labeling of all property lines and corners and making the site accessible so that a complete site evaluation can be performed. The permit is valid for either sixty (60) months or is non-expiring depending upon the documentation submitted: complete site plan = 60 months; complete plat = non-expiring. _____ (initial here for septic system applications)

15. WELL PERMIT APPLICATION:

If the information in this application is falsified, changed, or the site is altered, then the Well Permit shall become invalid. I have read this application and certify that the information provided herein is true, complete and correct. Authorized county and state officials are granted right of entry to conduct necessary inspections to determine compliance with applicable laws and rules. I understand that I am solely responsible for the proper identification and labeling of all property lines and corners and making the site accessible so that a complete site evaluation can be performed. The permit is valid for a period of twelve (12) months from the date of issuance.

_____ (initial here for well applications)

16. APPLICATION SIGNATURE SECTION:

ONLY COMPLETE APPLICATIONS WILL BE PROCESSED. A proper signature is required in order to process your application. Please review the application carefully and sign in the space provided below. A PROPOSED PLOT PLAN is required to be submitted with each application.

_____ May 4 2018

Property Owner's or Owner's Legal Representative Signature — Date

OFFICE USE ONLY

○ SURVEY PLAT TO SCALE SUBMITTED ○ SCALED SITE PLAN SUBMITTED ○ UN-SCALED SITE PLAN SUBMITTED

SEPTIC APPLICATION FEE RECEIVED: $ _____ DATE FEE RECEIVED: _____

WELL APPLICATION FEE RECEIVED: $ _____ DATE FEE RECEIVED: _____

APPLICATION PROCESSED BY: _____

GWS FILE NUMBER ASSIGNED: _____

APPLICATION ID NUMBER ASSIGNED: _____

COMMENTS:

MECKLENBURG COUNTY – GROUNDWATER & WASTEWATER SERVICES
700 N. TRYON ST. SUITE 211 CHARLOTTE, NC 28202, OFFICE: 980-314-1680, FAX: 704-336-6894
Email: Wellreg@MecklenburgCountyNC.gov

Revised on: 4/20/17

Mecklenburg County Groundwater & Wastewater Services
3205 Freedom Dr. Suite 8000 Charlotte, NC 28208
Phone: (980) 314-1680 Fax: (704) 336-6894

NC DHHS
Division of Environmental Health
On-Site Wastewater Section

IMPROVEMENT PERMIT/CONSTRUCTION AUTHORIZATION for REPAIRING an ON-SITE WASTEWATER TREATMENT & DISPOSAL SYSTEM

File #: 11799 Permit #: _____ Tax Parcel #: 03703112

Property Owner: Frederick & Pamela Huntley

Job Location Address: 1133 Beagle Lane

City: Charlotte State: NC Zip Code: 28216

Improvement Permit Issuance Date: _____ **Construction Authorization Issuance Date:** 4-15-2020

Permission is hereby given to **repair** an on-site wastewater treatment & and disposal system, with subsurface soil absorption and effluent discharge, as specified herein at the described location. This approval is granted based upon the application information submitted to our office. All work shall be completed on or before 4-15-2021. The system shall meet all of the construction requirements of 15A NCAC 18A. 1900 which are in effect on the date of granting this approval. An **Operation Permit** must be obtained from the Mecklenburg County Health Department before any system can be covered up or placed into service. The issuance of this permit does not in any way guarantee that the system anticipated to be constructed will operate properly, or relieve any person now of hereafter owning, controlling or using such system from any liability resulting from the failure of the system to operate properly.

Permitted Design Flow: 360 GPD

Site LTAR: _____ GPD/ft²

Liquid Capacity of Septic Tank: Existing gallons

Liquid Capacity of Dosing Tank: _____ gallons

Drainfield Design ☑ N/A

Trench Depth: _____ inches

Trench Width: _____ feet

Line Spacing: _____ feet (O.C.)

Total line length: _____ feet

# of Lines: _____ @ _____ feet

Depth of Media: _____ inches (Type) _____

Distribution Device: _____

Bed Design *(For Repair Installations ONLY.)* ☐ N/A

Bed Depth: 48 inches

Bed Width: 6 feet

Total line length: 55' feet

# of Lines: 2 @ 55 feet

Depth of Media: _____ inches (Type) Sand & Stone

Distribution Device: DBox

Water Supply Source

☐ Municipal ☑ Private Well ☐ Community Well

☐ Other _____


Minimum System Setbacks

Distance from Building Foundation: 5 feet

Distance from Property Line: 10 feet

Distance from Water Supply Source: 50 feet

SKETCH OF SYSTEM LAYOUT
(Proposed Layout)

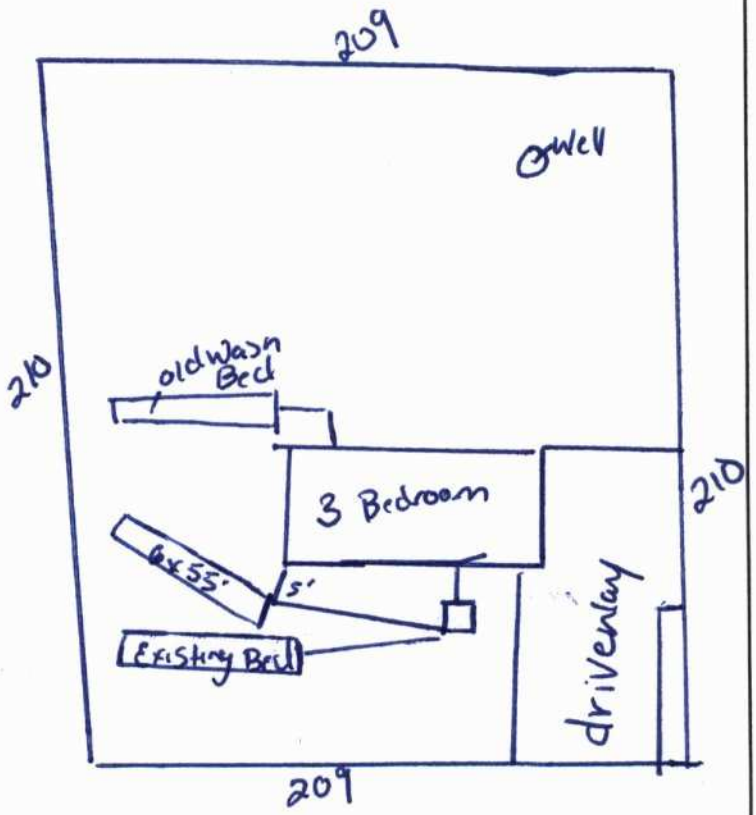

Comments: System Classification & Type: 1961d Soil Conditions are unsuitable no sewer available. Permitted using best professional judgement

Authorized Agent: Heather Ray Signature: Heather Ray

Owner Signature: _____ Date: _____