

8800 BEDFORD RD

05315501

1/10/2008

duponbj

Groundwater and Wastewater Services File Imaging Project
May 2007
Barcode Font = IDAutomationHC39M

Mecklenburg County Groundwater & Wastewater Services
700 N. Tryon St., Suite 211 Charlotte, NC 28202
Phone: (704) 336-5103 Fax: (704) 336-6894

NC DENR
Division of Environmental Health
On-Site Wastewater Section

OPERATION PERMIT for an ON-SITE WASTEWATER TREATMENT & DISPOSAL SYSTEM

File #: 6469B Permit #: _____ Tax Parcel #: 053-155-01

Property Owner: Elizabeth Nash

Job Location Address: 8800 Bedford Rd. C

City: Charlotte State: NC Zip Code: 28214

Operation Permit Issuance Date: 5-11-06 Contractor Name: Stanley Septic

Permitted Design Flow: ~~1500~~ 360 GPD

Liquid Capacity of Septic Tank: 1500 gallons

Liquid Capacity of Dosing Tank: N/A gallons

Effluent Pump Model: N/A

Drainfield Installation ☒ N/A

Trench Depth: _____ inches

Trench Width: ~~2~~ _____ feet

Line Spacing: _____ feet (O.C.)

Total line length: _____ feet

# of Lines: _____ @ _____ feet

Depth of Media: _____ inches (Type) _____

Depth of Cover: _____ inches

Distribution Device: _____

Inspection Dates

Tank(s) Inspected: 5-11-06

Excavation Inspected: 5-11-06

Pump & Controls Inspected: N/A

Bed Installation *(For Repair Installations ONLY.)* ☐ N/A

Bed Depth: 66" inches

Bed Width: 6 feet

Total line length: 75' feet

# of Lines: 1 @ 75' feet

Depth of Media: 18" inches (Type) Gravel

Depth of Cover: 48" inches

Distribution Device: N/A

Water Supply Source

☐ Municipal ☒ Private Well ☐ Community Well

☐ Other _____


System Installation Setbacks

Distance from Building Foundation: 75' feet

Distance from Property Line: >10' feet

Distance from Water Supply Source: >50' feet

SKETCH OF SYSTEM INSTALLATION
(As-Built Drawing)

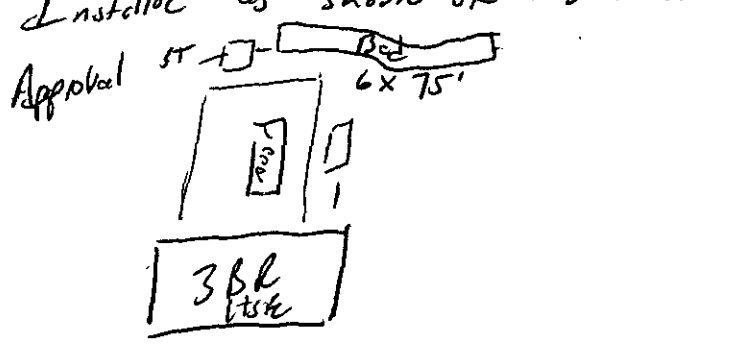

- Crush and fill old tank

The undersigned has inspected the Septic Tank System described above, and certifies it has been ☑ installed ☐ altered ☐ repaired ☐ as detailed in the plot above ☐ in accordance with the permit issued and meets the provisions of 15A NCAC 18A. 1900, "Laws and Rules for Sewage Treatment and Disposal Systems" in effect on the date of issuance of the permit. The issuance of this Operation Permit does not in any way guarantee that the system will operate properly or relieve any person now or hereafter owning, controlling, or using such system from any liability resulting from the failure of the system to operate properly. This document is issued subject to those restrictions and conditions shown on the permit(s) and the provisions of 15A NCAC 18A. 1900 in addition to those listed below under "Comments." This document shall be null and void if any information contained in the application is untrue or if any additions are made to the property which would increase the requirements for said system.

Notice: Disturbance of the designated repair area may result in the Suspension or Revocation of this permit.

Comments: System Classification & Type: II-b

DENR Authorized Agent: Zach Petersen EHS Signature: _____ EHS

Mecklenburg County Groundwater & Wastewater Services
700 N. Tryon St., Suite 211 Charlotte, NC 28202
Phone: (704) 336-5103 Fax: (704) 336-6894

NC DENR
Division of Environmental Health
On-Site Wastewater Section

INSTALLATION APPROVAL for an ON-SITE WASTEWATER TREATMENT & DISPOSAL SYSTEM

File #: 64698 Permit #: _____ Tax Parcel #: 053-155-01

Property Owner: Elizabeth Nash

Job Location Address: 8500 Bedford Rd 704

City: Charlotte State: NC Zip Code: _____

Installation Approval Issuance Date: _____

Permission is hereby given to ☐ install ☐ alter ☑ repair an on-site wastewater treatment & and disposal system, with subsurface soil absorption and effluent discharge, as specified herein at the described location. This approval is granted based upon the application information submitted to our office. All work shall be completed on or before 5/26/06, after which date this approval shall be null and void. The system shall meet all of the construction requirements of 15A NCAC 18A. 1900 which are in effect on the date of granting this approval. An **Operation Permit** must be obtained from the Mecklenburg County Health Department before any system can be covered up or placed into service. The issuance of this permit does not in any way guarantee that the system anticipated to be constructed will operate properly, or relieve any person now of hereafter owning, controlling or using such system from any liability resulting from the failure of the system to operate properly.

***NOTICE: This system shall not be installed while soils are in a wet condition.**

Permitted Design Flow: _____ GPD

Site LTAR: 0.3 GPD/ft² (For new installations only.)

Liquid Capacity of Septic Tank: 1500 gallons

Liquid Capacity of Dosing Tank: N/A gallons

Drainfield Design ☐ N/A

Trench Depth: _____ inches

Trench Width: _____ feet

Line Spacing: _____ feet (O.C.)

Total line length: _____ feet

# of Lines: _____ @ _____ feet

Depth of Media: _____ inches (Type) _____

Distribution Device: _____

Bed Design *(For Repair Installations ONLY.)* ☐ N/A

Bed Depth: 30-35" inches

Bed Width: 9' feet

Total line length: 50' feet

# of Lines: N/A @ _____ feet

Depth of Media: 24" inches (Type) Gravel

Distribution Device: D-Box

Water Supply Source

☐ Municipal ☑ Private Well ☐ Community Well

☐ Other _____


Minimum System Setbacks

Distance from Building Foundation: ~~10~~ 5' feet

Distance from Property Line: 75' feet

Distance from Water Supply Source: 150' feet

SKETCH OF SYSTEM LAYOUT (Proposed Layout)

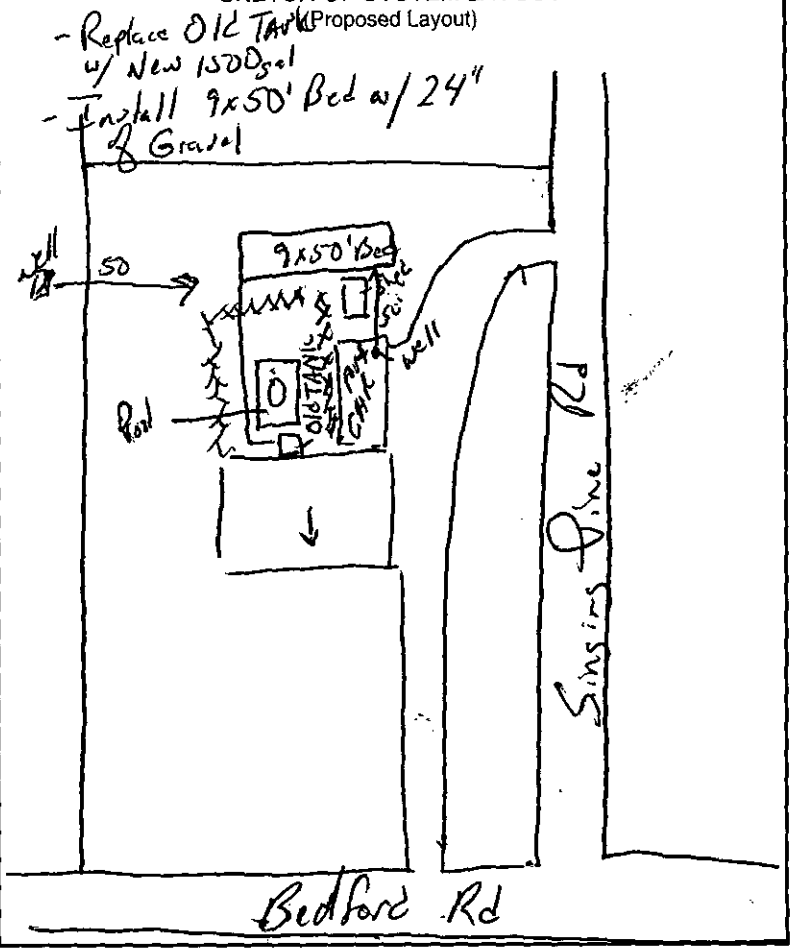

Comments: System Classification & Type: I+b

DENR Authorized Agent: Zach Peterson ES/RS Signature: Zach Peterson ES/RS

#737

GWS – RES. APP 07/05

SEPTIC FEE:
DATE:
CRT #:

PERMIT APPLICATION FOR A RESIDENTIAL SITE IMPROVEMENT PERMIT / CONSTRUCTION AUTHORIZATION FOR ON-SITE WASTEWATER SYSTEM NEW WELL INSTALLATION OR REPAIR OF EXISTING WELL MECKLENBURG COUNTY GROUNDWATER & WASTEWATER SERVICES

WELL FEE:
DATE:
CRT #:

FILE # 64690

COPY

SEPTIC / TYPE APPLICATION: ☐ NONE ☐ NEW SYSTEM ☐ ALTERATION ☑ REPAIR ☐ MODIFY PLOT PLAN

WELL / TYPE APPLICATION: ☐ NONE ☐ NEW WELL ☑ MAJOR REPAIR ☐ ABANDONMENT

Zeck

JOB LOCATION INFORMATION:

TAX/PARCEL #: 053-155-01
STREET ADDRESS: 8800 Bedford Rd
CITY: Charlotte
STATE: NC ZIP: 28214
SUBDIVISION OR MOBILE HOME PARK NAME: Westmoreland
LOT #: 1 BE 1960
TOWNSHIP:

☒ 0-MECKLENBURG ☐ 4-PINEVILLE
☐ 1-CHARLOTTE ☐ 5-MATTHEWS
☐ 2-DAVIDSON ☐ 6-HUNTERSVILLE
☐ 3-CORNELIUS ☐ 7-MINT HILL

BUILDING INFORMATION:

TYPE OF BUILDING:

☐ SINGLE MOBILE HOME (S) ☐ MODULAR HOME (M)
☐ DOUBLE WIDE (D) ☐ MULTIPLE FAMILY (U)
☑ HOUSE (H) ☐ OTHER
HEATED SQUARE FOOTAGE: 1786
NUMBER OF BEDROOMS: 3
NUMBER OF OCCUPANTS: 3

FOUNDATION FOR RESIDENCE:

☐ CONCRETE SLAB ☐ BASEMENT WITH PLUMBING
☑ CRAWLSPACE ☐ BASEMENT WITH NO PLUMBING

IF PLANNING TO EXPAND/ALTER THE EXISTING SYSTEM INDICATE THE FOLLOWING CHANGES:

NUMBER OF BEDROOMS TO BE ADDED: NUMBER OF ADDITIONAL OCCUPANTS IN THE RESIDENCE:
WILL THERE BE A HOME BUSINESS IN THE RESIDENCE? ☐ YES ☐ NO TYPE:

WATER SUPPLY:

☐ MUNICIPAL (M) ☐ PUBLIC (C) ☒ PRIVATE WELL (P) ☐ SHARED WELL (S) ☐ OTHER 'SPRINGS' (O)

PROPOSED USE OF WELL: ☐ N/A ☐ IRRIGATION ☐ POTABLE ☐ GEOTHERMAL ☐ OTHER

ARE ANY OF THE FOLLOWING LOCATED ON THE PROPERTY? IF SO, PLEASE SHOW LOCATION ON SITE PLAN/PLAT.

BURIED CABLES, LANDFILLS, STUMPHOLES	☐ YES	☑ NO	WELLS, SPRINGS, OR WATER LINES	☑ YES	☐ NO
EXISTING WASTEWATER SYSTEMS	☒ YES	☐ NO	DESIGNATED WETLANDS	☐ YES	☑ NO
EASEMENTS OR RIGHT-OF-WAYS	☐ YES	☑ NO	GRADING/SOIL REMOVAL PERFORMED	☐ YES	☐ NO

PROPERTY OWNER:

NAME: Elizabeth Nash
ADDRESS: 8800 Bedford Rd.
CITY: Charlotte
STATE: N.C. ZIP: 28214
HOME PHONE: 704-388-7069 WORK PHONE: 704-667-1871
MOBILE PHONE: 397-7069 FAX:

LEGAL AGENT FOR PROPERTY OWNER, IF APPLICABLE:

NAME:
ADDRESS:
CITY:
STATE: ZIP:
HOME PHONE: WORK PHONE:
MOBILE PHONE: FAX:

WHAT DATE WAS THE PROPERTY ORIGINALLY DEEDED AND RECORDED?
WHAT IS THE ANTICIPATED CLOSING DATE FOR THIS PROPERTY?

*An Improvement Permit is subject to suspension or revocation if site plans or the intended use change or if information submitted in this application is falsified or changed. The undersigned, owner, or legal agent for the owner, of the property described above as the "Job Location" has read the foregoing application, acknowledges that the contents of same are true, and authorizes the Mecklenburg County Health Department to enter onto the property for the purpose of processing this request.

Elizabeth Nash 4-26-06
Owner's/Agent's Signature Date

NORTH CAROLINA DEPARTMENT OF
ENVIRONMENT & NATURAL RESOURCES DIVISION
OF ENVIRONMENTAL HEALTH ON-SITE
WASTEWATER SECTION

*A Well Permit is subject to suspension or revocation if site plans or the intended use change or if information submitted in this application is falsified or changed. The undersigned, owner, or legal agent for the owner, of the property described above as the "Job Location" has read the foregoing application, acknowledges that the contents of same are true, and authorizes the Mecklenburg County Health Department to enter onto the property for the purpose of processing this request.

Owner's/Agent's Signature Date

MECKLENBURG COUNTY HEALTH DEPARTMENT
GROUNDWATER & WASTEWATER SERVICES
700 N. TRYON ST., SUITE 211
CHARLOTTE, NC 28202 704-336-5103 / FAX: 704-336-6894