MECKLENBURG COUNTY
HEALTH DEPARTMENT

455A #869

13 JAN '17 PM12:26

APPLICATION FOR APPROVAL TO USE AN EXISTING ON-SITE WASTEWATER TREATMENT & DISPOSAL SYSTEM / WATER SUPPLY WELL

APPLICATION TYPE: ☑ SEPTIC ONLY ○ WELL ONLY ○ SEPTIC & WELL
○ ADDITION OR RENOVATION WITH OCCUPANCY INCREASE
○ ADDITION OR RENOVATION WITH NO OCCUPANCY INCREASE
◉ EXCHANGE MOBILE HOME (SAME # BEDROOMS) Modular Home
○ COMMERCIAL OR INDUSTRIAL

PERSON FILING APPLICATION:
NAME: Scott Smith
ADDRESS: 828 Piedmont Dr
CITY: Lexington
STATE: N.C ZIP: 27295
PHONE: 336-782-1647
ALTERNATE PHONE:
E-MAIL: carolinamhs@aol.com

PROPERTY OWNER: ☐ SAME AS PERSON FILING APPLICATION
NAME: Peter Volpe
ADDRESS: 1543 George Dunn Rd
CITY: Rock Hill
STATE: SC ZIP: 29730
PHONE: 803-829-8198
ALTERNATE PHONE:
E-MAIL:

JOB LOCATION INFORMATION
TAX PARCEL #: 02317218
STREET ADDRESS: 4311 Eagle Chase Dr
CITY: Charlotte
STATE: NC ZIP: 28216

SUBDIVISION OR MOBILE HOME PARK NAME: Eagle Chase
LOT #: 7

WATER SUPPLY:
☒ MUNICIPAL ○ PRIVATE WELL ○ PUBLIC WELL ○ SHARED WELL ○ OTHER

RESIDENTIAL PROPERTY TYPE: ○ N/A
○ HOUSE ☑ MODULAR HOME ○ MULTIPLE FAMILY
○ SINGLE MOBILE HOME ○ DOUBLE WIDE
○ OTHER

OCCUPANCY (both fields are required):
NUMBER OF BEDROOMS: 3
NUMBER OF OCCUPANTS: 3

COMMERCIAL / INDUSTRIAL PROPERTY TYPE: ☐ N/A
TYPE OF BUSINESS:
EMPLOYEES PER SHIFT:
OF SHIFTS:
INDUSTRIAL WASTES? ○ YES ○ NO
UNDERGROUND STORAGE TANKS? ○ YES ○ NO

ADDITION/RENOVATION TYPE ATTACHED TO EXISTING STRUCTURE:
☐ BEDROOM ☐ BATHROOM ☐ KITCHEN ☐ DINING ROOM ☐ LIVING ROOM ☐ DEN
☐ GARAGE ☐ SUNROOM ☐ PORCH ☐ DECK ☒ OTHER

ADDITION/RENOVATION TYPE DETACHED FROM EXISTING STRUCTURE:
☐ DETACHED GARAGE ☐ DETACHED GARAGE WITH PLUMBING ☐ POOL HOUSE ☐ SHOP ☐ BARN
☐ STORAGE SHED ☐ DETACHED PORCH / DECK ☐ OTHER

*The undersigned, owner, or legal agent for the owner, of the property described above as the "Job Location" has read the foregoing application, acknowledges that the contents of same are true, and authorizes the Mecklenburg County Health Department to enter onto the property for the purpose of processing this request.

Owner's/Agent's Signature

1-9-16
Date


A PROPOSED PLOT PLAN (see page 2) is required to be submitted with each application.

File #: _____

PROPOSED PLOT PLAN

A drawing showing the locations of the following items is required: existing and proposed property lines with dimensions, easements or right-of-ways, proposed building pad(s) or existing building footprint(s), all appurtenances (garage, driveway, deck, pool, etc.), location of existing or proposed well(s), location of existing or proposed sewer lines and sewage disposal systems, surface water bodies, and any aboveground or underground storage tanks. Provide names for all roads that adjoin the property.

Street Address: 4311 Eagle Chase Dr Tax Parcel #: 02311218

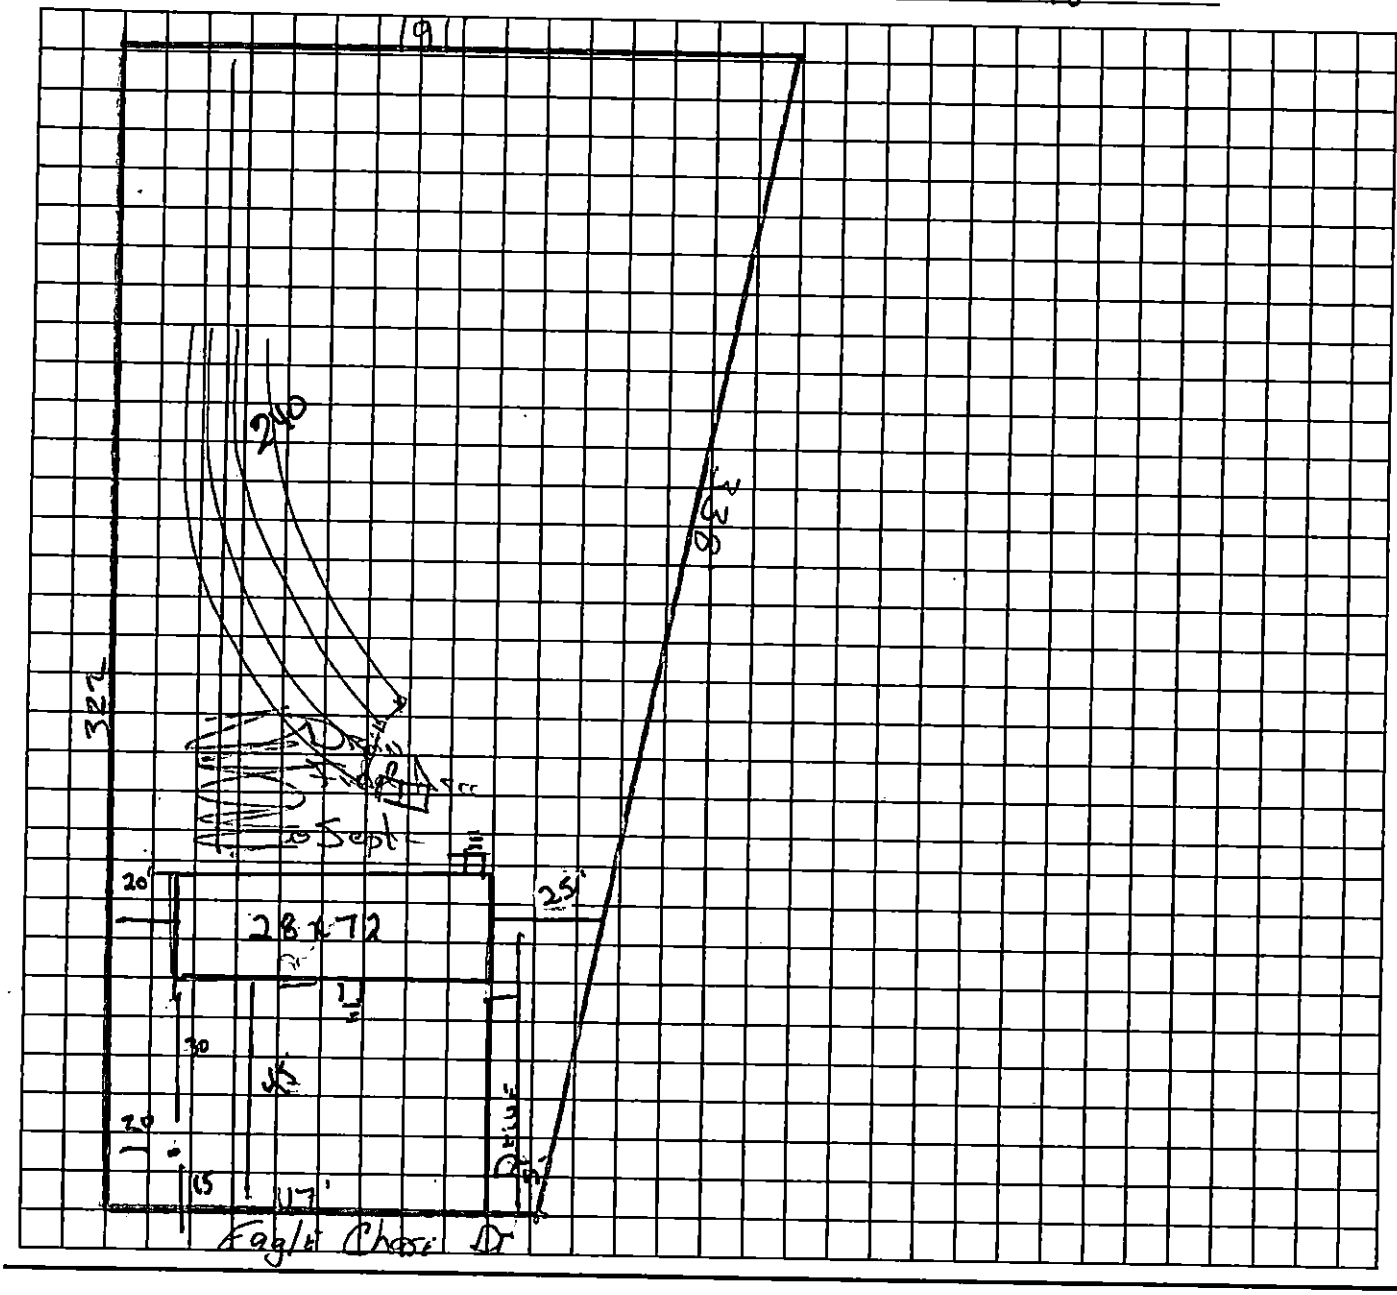

"The undersigned, an authorized agent of the Mecklenburg County Health Department, certifies that the Department has approved the Request for the "Job Location" contained in this document. This approval is granted in accordance with the provisions of Laws and Rules for Sanitary Sewage Collection, Treatment, and Disposal and Water Supply Wells in effect at the time of issuance of the permit and is subject to the following provisions:

- No work shall be conducted on the septic tank system until an installation, construction, alteration and/or repair approval is granted by this Department.
- This permit is not transferable.
- Addition/Renovation approval valid 1 year from issuance date
- Mobile home exchange approval valid 6 months from issuance date

OK. TO UES FOR A 3 Bedroom Mobile Home Exchange

REHS Signature 1/31/17 Date

MECKLENBURG COUNTY – GROUNDWATER & WASTEWATER SERVICES
700 N. TRYON ST. SUITE 211 CHARLOTTE, NC 28202, OFFICE: 704-336-5103, FAX: 704-336-6894

Revised on: 01/03/11

* Original system was installed for 4 Bedrooms.

MECKLENBURG COUNTY
LAND USE AND ENVIRONMENTAL SERVICES
Payment Receipt

Receipt Information

Date:	01/13/17	**Amount:**	100.00
Receipt #:	103263	**Tendered:**	100.00
Check / Auth #:	CHECK 3086	**Returned:**	0.00
Received By:	ELLISLW		

Account Information

Account #: 200000
Contractor: SMITH, WILLIAM SCOTT
Attn:
Address: 113 FOSTALL DR
Address:
City/State/Zip: MOCKSVILLE, NC 27028

Item	Description	Permit#	Quantity	Unit Price	Total Price
0705	Use Existing System 4311 EAGLE CHASE DR		1	100.00	100.00

----------Outstanding Balances----------

Month-To-Date	Prior Month	30 Days	60 Days	90 Days	Balance