Mecklenburg County Groundwater & Wastewater Services
700 N. Tryon St., Suite 211 Charlotte, NC 28202
Phone: (704) 336-5103 Fax: (704) 336-6894

NC DENR
Division of Environmental Health
On-Site Wastewater Section

OPERATION PERMIT for an ON-SITE WASTEWATER TREATMENT & DISPOSAL SYSTEM

File #: 7291B Permit #: _____ Tax Parcel #: 139-042-03

Property Owner: KORBEN HOMES

Job Location Address: 9216 ARLINGTON HILLS DR. LOT #2

City: CHARLOTTE State: NC Zip Code: 28227

Operation Permit Issuance Date: 1/31/08 Contractor Name: W.T. NORWOOD

Permitted Design Flow: 600 GPD

Liquid Capacity of Septic Tank: 1500 gallons

Liquid Capacity of Dosing Tank: 1000 gallons

Effluent Pump Model: LIBERTY 283 1/2 HP

Drainfield Installation ☐ N/A INNOVATIVE 25% REDUCTION CHAMBERS

Trench Depth: 22 inches

Trench Width: 3 feet

Line Spacing: 9 feet (O.C.) 116, 116, 115, 104, 96

Total line length: 545 feet

# of Lines: 5 @ VAR feet

Depth of Media: N/A inches (Type) IIIDQ

Depth of Cover: 12 inches

Distribution Device: DROP T

Inspection Dates

Tank(s) Inspected: 1/31/08

Excavation Inspected: 1/31/08

Pump & Controls Inspected: 1/31/08

SKETCH OF SYSTEM INSTALLATION
(As-Built Drawing)

INSTALLED AS SHOWN ON IP.

Bed Installation *(For Repair Installations ONLY.)* ☑ N/A

Bed Depth: _____ inches

Bed Width: _____ feet

Total line length: _____ feet

# of Lines: _____ @ _____ feet

Depth of Media: _____ inches (Type) _____

Depth of Cover: _____ inches

Distribution Device: _____

Water Supply Source

☐ Municipal ☑ Private Well ☐ Community Well

☐ Other _____

System Installation Setbacks

Distance from Building Foundation: 10 feet

Distance from Property Line: 10 feet

Distance from Water Supply Source: 750 feet

The undersigned has inspected the Septic Tank System described above, and certifies it has been ☑ installed ☐ altered ☐ repaired ☐ as detailed in the plot above ☑ in accordance with the permit issued and meets the provisions of 15A NCAC 18A. 1900, "Laws and Rules for Sewage Treatment and Disposal Systems" in effect on the date of issuance of the permit. The issuance of this Operation Permit does not in any way guarantee that the system will operate properly or relieve any person now or hereafter owning, controlling, or using such system from any liability resulting from the failure of the system to operate properly. This document is issued subject to those restrictions and conditions shown on the permit(s) and the provisions of 15A NCAC 18A. 1900 in addition to those listed below under "Comments." This document shall be null and void if any information contained in the application is untrue or if any additions are made to the property which would increase the requirements for said system.

Notice: Disturbance of the designated repair area may result in the Suspension or Revocation of this permit.

Comments: System Classification & Type: IIIDQ, INNOVATIVE, 25% REDUCTION, CHAMBERS.
5 LINES INSTALLED @ (116', 116', 115', 104', 96') 750' FROM WELL.

DENR Authorized Agent: DAVID CARNELLUS Signature: _____

Mecklenburg County Groundwater & Wastewater Services
700 N. Tryon St., Suite 211 Charlotte, NC 28202
Phone: (704) 336-5103 Fax: (704) 336-6894

NC DENR
Division of Environmental Health
On-Site Wastewater Section

OPERATION PERMIT for an
ON-SITE WASTEWATER TREATMENT & DISPOSAL SYSTEM

File #: 7291B Permit #: _____ Tax Parcel #: 139-042-03

Property Owner: KOZBEN HOMES

Job Location Address: 9216 ARLINGTON HILLS DR. LOT #2

City: CHARLOTTE State: NC Zip Code: 28227

OPERATION PERMIT CONDITIONS:

I. Performance: System shall perform in accordance with 15A NCAC 18A .1961.

II. Monitoring: System shall be monitored as required by 15A NCAC 18A .1961.

III. Maintenance: Ground absorption sewage treatment and disposal systems shall be checked, and the contents of the septic tank removed, periodically from all compartments, to ensure proper operation of the system. The contents shall be pumped whenever the solids level is found to be more than 1/3 of the liquid depth in any compartment.

IV. Operation: System shall be operated in accordance with 15A NCAC 18A .1961.

System Classification: III bg

*Operation Permits for Type V and VI systems expire five (5) years from the date of issuance (in accordance with Table V(a)). The system owner must contact GWS six (6) months prior to expiration for permit renewal.

Subsurface system operator required: Yes ☐ No ☒

☐ This type of system requires the system owner to maintain a contract with a certified operator to perform system inspection, maintenance, and reporting as required in 15A NCAC 18A .1961. and Table V(a). The system owner is responsible for all fees associated with these services.

☐ System does not require inspection by GWS on a routine frequency.

☒ System requires inspection by GWS once every five (5) years. The system owner is responsible for all fees associated with the inspection.

☐ System requires inspection by GWS once every three (3) years. The system owner is responsible for all fees associated with the inspection.

☐ System requires inspection by GWS once every twelve (12) months. The system owner is responsible for all fees associated with the inspection.

☐ System requires inspection by GWS once every six (6) months. The system owner is responsible for all fees associated with the inspection.

V. Other:

_____

_____

_____

_____

DENR Authorized Agent: DAVID CASTELLOS Date: 2/1/08

Signature: _____

Mecklenburg County Groundwater & Wastewater Services
700 N. Tryon St., Suite 211 Charlotte, NC 28202
Phone: (704) 336-5103 Fax: (704) 336-6894

NC DENR
Division of Environmental Health
On-Site Wastewater Section

INSTALLATION APPROVAL for an
ON-SITE WASTEWATER TREATMENT & DISPOSAL SYSTEM

File #: 72918 Permit #: _____ Tax Parcel #: 139-042-03

Property Owner: KORBEN HOMES

Job Location Address: 9216 ARLINGTON HILLS DR. LOT #2

City: CHARLOTTE State: NC Zip Code: 28227

Installation Approval Issuance Date: 1/30/08

Permission is hereby given to ☑ install ☐ alter ☐ repair an on-site wastewater treatment & and disposal system, with subsurface soil absorption and effluent discharge, as specified herein at the described location. This approval is granted based upon the application information submitted to our office. All work shall be completed on or before 2/30/08, after which date this approval shall be null and void. The system shall meet all of the construction requirements of 15A NCAC 18A. 1900 which are in effect on the date of granting this approval. An **Operation Permit** must be obtained from the Mecklenburg County Health Department before any system can be covered up or placed into service. The issuance of this permit does not in any way guarantee that the system anticipated to be constructed will operate properly, or relieve any person now of hereafter owning, controlling or using such system from any liability resulting from the failure of the system to operate properly.

***NOTICE: This system shall not be installed while soils are in a wet condition.**

Permitted Design Flow: 600 GPD

Site LTAR: 0.275 GPD/ft² (For new installations only.)

Liquid Capacity of Septic Tank: 1500 gallons

Liquid Capacity of Dosing Tank: 1000 gallons

Drainfield Design ☐ N/A INNOVATIVE 25% REDUCTION

Trench Depth: 22 inches

Trench Width: 3 feet

Line Spacing: 9 feet (O.C.)

Total line length: 545 feet

# of Lines: 5 @ VAR. feet

Depth of Media: N/A inches (Type) IIIBa

Distribution Device: PRESSURE MANIFOLD

Bed Design *(For Repair Installations ONLY.)* ☑ N/A

Bed Depth: _____ inches

Bed Width: _____ feet

Total line length: _____ feet

# of Lines: _____ @ _____ feet

Depth of Media: _____ inches (Type) _____

Distribution Device: _____

Water Supply Source

☐ Municipal ☑ Private Well ☐ Community Well

☐ Other _____


Minimum System Setbacks

Distance from Building Foundation: 5 feet

Distance from Property Line: 10 feet

Distance from Water Supply Source: 50 feet

SKETCH OF SYSTEM LAYOUT
(Proposed Layout)

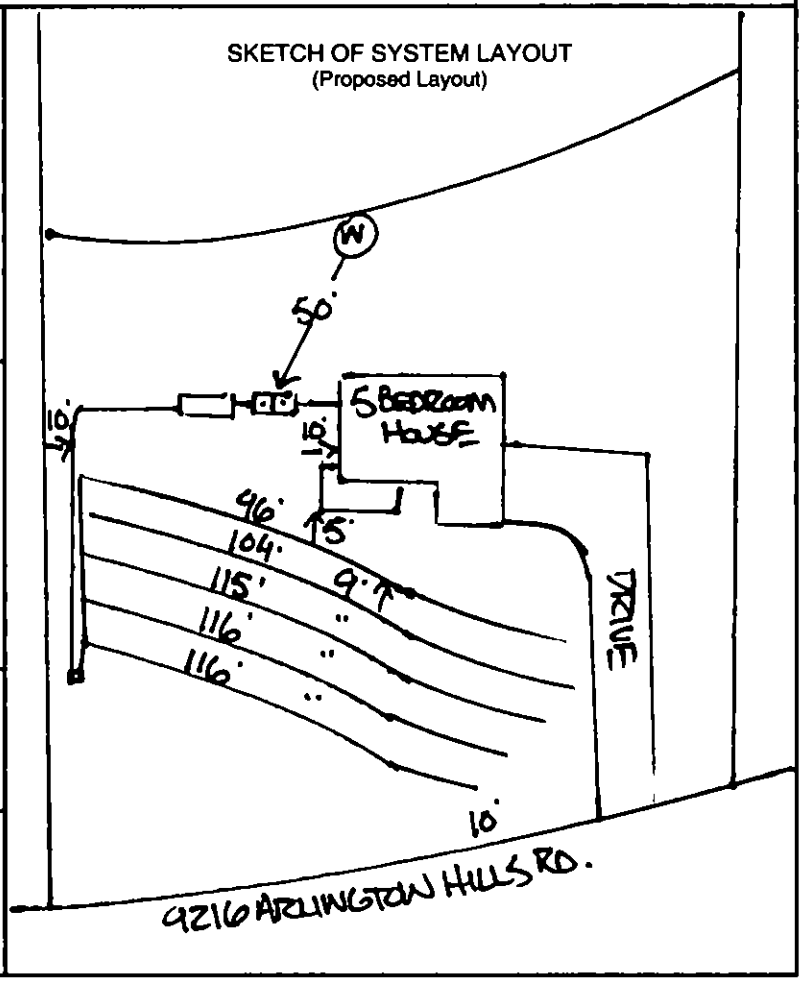

Comments: System Classification & Type: IIIBa, INNOVATIVE, 25% REDUCTION. 22" MAX TRENCH DEPTH
KEEP ALL PARTS OF SEPTIC SYSTEM >50' FROM WELL.

DENR Authorized Agent: DAVID CORNELIUS Signature: _____, RS

CUPP 758267

FEE: 100
DATE: 3/7/08
CRT I 1 92

APPLICATION FOR APPROVAL TO USE AN EXISTING ON-SITE WASTEWATER TREATMENT & DISPOSAL SYSTEM
MECKLENBURG COUNTY - GROUNDWATER & WASTEWATER SERVICES
700 N. Tryon St., Suite 211 Charlotte, NC 28202
Phone: (704) 336-5103 Fax: (704) 336-6894

GWS – UES.APP 06/07

FILE #: 7291B

P#272746 3324

TYPE APPLCATION:

- ☐ ADDITION - INCREASE ROOMS/OCCUPANCY/MOBILE HOME SIZE (A / M)
- ☒ ADDITION - RENOVATION OR GARAGE WITH NO MAJOR CHANGES (X)
- ☐ EXCHANGE MOBILE HOME - SAME # BEDROOMS (Y)
- ☐ COMMERCIAL OR INDUSTRIAL (N)

PERSON FILING APPLICATION:
NAME: Rick Pinto
ADDRESS: 9920 Hanging Moss Tr.
CITY: Charlotte
STATE: ~~NC~~ ZIP: 28227
PHONE: 704-264-9866 p/s call
ALTERNATE PHONE: ~~704-545-8188~~ wkw LO

PROPERTY OWNER:
NAME: Korben Homes, Inc.
ADDRESS: same
CITY:
STATE: ZIP:
PHONE:
ALTERNATE PHONE:

JOB LOCATION INFORMATION
TAX/PARCEL #: 139-042-03
STREET ADDRESS: 9216 Arlington Hills Dr.
CITY: Charlotte
STATE: NC ZIP: 28227
SUBDIVISION OR MOBILE HOME PARK NAME: Arlington Hills
LOT #: 2

TOWNSHIP:

- ☐ 0-MECKLENBURG
- ☐ 1-CHARLOTTE
- ☐ 2-DAVIDSON
- ☐ 3-CORNELIUS
- ☐ 4-PINEVILLE
- ☐ 5-MATTHEWS
- ☐ 6-HUNTERSVILLE
- ☒ 7-MINT HILL

WATER SUPPLY:

- ☐ MUNICIPAL (M)
- ☐ COMMUNITY (C)
- ☒ PRIVATE WELL (P)
- ☐ SHARED WELL (S)
- ☐ OTHER 'SPRINGS' (O)

RESIDENTIAL PROPERTY TYPE:

- ☒ HOUSE (H)
- ☐ MODULAR HOME (M)
- ☐ MULTIPLE FAMILY (U)
- ☐ SINGLE MOBILE HOME (S)
- ☐ DOUBLE WIDE (D)
- ☐ OTHER (O)

OCCUPANCY (both fields are required):
NUMBER OF BEDROOMS: 5
NUMBER OF OCCUPANTS: 4

COMMERCIAL / INDUSTRIAL PROPERTY TYPE:
TYPE OF BUSINESS:
EMPLOYEES PER SHIFT:
OF SHIFTS:
INDUSTRIAL WASTES? ☐ YES ☐ NO
UNDERGROUND STORAGE TANKS? ☐ YES ☐ NO

ADDITION TYPE ATTACHED TO EXISTING STRUCTURE:

- ☐ BEDROOM
- ☐ BATHROOM
- ☐ KITCHEN
- ☐ DINING ROOM
- ☐ LIVING ROOM
- ☐ DEN
- ☐ GARAGE
- ☐ SUNROOM
- ☐ PORCH
- ☒ DECK
- ☐ OTHER

ADDITION TYPE DETACHED FROM EXISTING STRUCTURE:

- ☐ DETACHED GARAGE
- ☐ DETACHED GARAGE WITH PLUMBING
- ☐ POOL HOUSE
- ☐ SHOP
- ☐ BARN
- ☐ STORAGE SHED
- ☐ DETACHED PORCH / DECK
- ☐ OTHER

"The undersigned, owner, or legal agent for the owner, of the property described above as the "Job Location" has read the foregoing application, acknowledges that the contents of same are true, and authorizes the Mecklenburg County Health Department to enter onto the property for the purpose of processing this request.

Rick Pinto — Owner's/Agent's Signature
3/6/08 — Date

"The undersigned, an authorized agent of the Mecklenburg County Health Department, certifies that the Department has approved the Request for the Job Location contained in this document. This approval is granted in accordance with the provisions of Laws and Rules for Sanitary Sewage Collection, Treatment and Disposal in effect at the time of issuance of the permit and is subject to the following provisions:

- No work shall be conducted on the septic tank system until an installation, construction, alteration and/or repair approval is granted y this Department.
- This permit is not transferable.

☐ ADDITION / RENOVATION APPROVAL - VALID 1 YEAR FROM ISSUANCE
☐ MOBILE HOME EXCHANGE APPROVAL - VALID 6 MONTHS FROM ISSUANCE

DECK ADDITION APPROVED.
O.K. TO USE EXISTING SYSTEM.

GWS Signature — Date 3/10/08


File # 7291B

THIS IS TO CERTIFY THAT ON THE 29th DAY OF AUG. A.D. 07 I, SURVEYED THE PROPERTY SHOWN ON THIS PLAT AND THAT THE TITLE LINES AND THE WALLS OF THE BUILDINGS IF ANY ARE SHOWN HEREON.

SIGNED _____
REGISTERED SURVEYOR

PRELIMINARY

CURVE TABLE				
CURVE	LENGTH	RADIUS	CHORD BRG.	CHORD
C1	64.81	230.00	S36°27'42"E	64.59

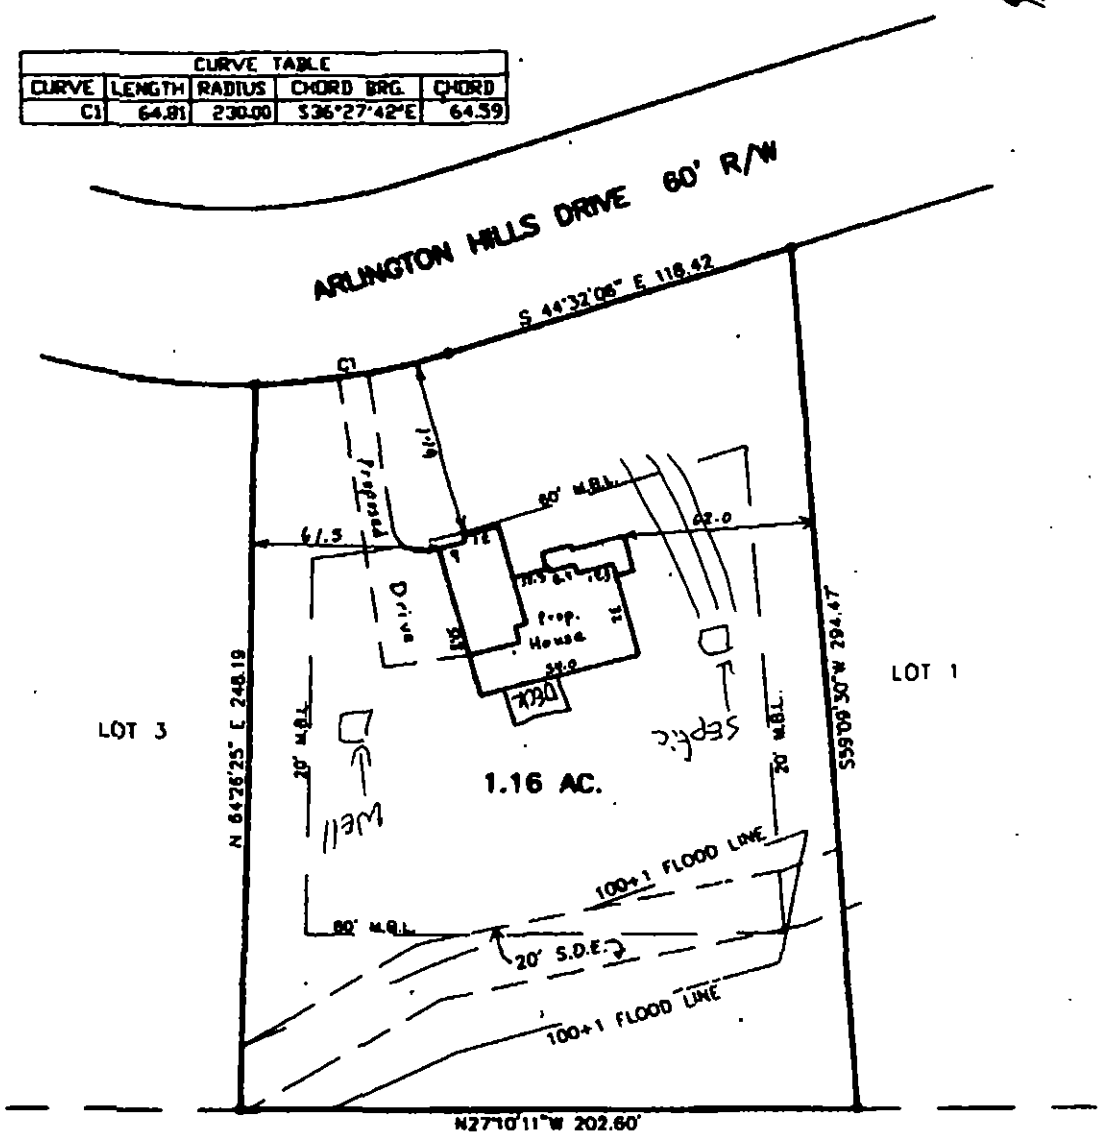

PLOT PLAN OF SURVEY

LOT 2 ARLINGTON HILLS, MAP 1

SCALE 1" = 50' TOWN OF MINT HILL MECK. COUNTY, N.C.

THE PROPERTY OF KORDEN HOMES

MAP RECORDED IN BOOK 43 AT PAGE 707 DEED RECORDED IN BOOK ____ PAGE ____

DI-7697

8/30/07
3/6/08

Rik Pauls
Rik Pauls

FEE: 300.00
DATE: 10/5/2007

CONSTRUCTION AUTHORIZATION FOR AN ON-SITE WASTEWATER TREATMENT & DISPOSAL SYSTEM

MECKLENBURG COUNTY
GROUNDWATER & WASTEWATER SERVICES

FILE NUMBER: 7291B

PERMIT NUMBER: 30002651

PARCEL NUMBER: 13904203

JOB LOCATION INFORMATION

ADDRESS: 9216 ARLINGTON HILLS DR

CITY: CHARLOTTE **STATE: NC** **ZIP:** 28227

ISSUED TO: KORBEN HOMES, INC.

CONSTRUCTION AUTHORIZATION ISSUANCE DATE: 10/5/2007

CONSTRUCTION AUTHORIZATION CONDITIONS

1. WASTEWATER SYSTEM CONSTRUCTION AND INSTALLATION MUST MEET ALL CONDITIONS AND SPECIFICATIONS AS SET FORTH IN IMPROVEMENT PERMIT NUMBER 30002651, AND THE ATTACHED SITE PLAN WITH SYSTEM DETAILS. CONSTRUCTION AND INSTALLATION MUST ALSO MEET ALL REQUIREMENTS SET FORTH IN THE RULES GOVERNING SANITARY SEWAGE COLLECTION, TREATMENT, AND DISPOSAL AND ANY OTHER APPLICABLE RULES AND LAWS.

2. AN INSTALLATION APPROVAL MUST BE SECURED PRIOR TO INSTALLATION OF THE SEPTIC TANK SYSTEM. THE INSTALLER OF THE SYSTEM SHALL BE A REGISTERED SEPTIC TANK CONTRACTOR WITH THE MECKLENBURG COUNTY HEALTH DEPARTMENT.

3. ANY ALTERATION IN SITE OR SOIL CONDITIONS (INCLUDING LOCATION OF STRUCTURES AND APPURTENANCES) OR MODIFICATION IN USE, DESIGN WASTEWATER FLOW, OR WASTEWATER CHARACTERISTICS AS SPECIFIED IN THE ASSOCIATED IMPROVEMENT PERMIT AND APPLICATION, MAY SUBJECT THIS CONSTRUCTION AUTHORIZATION AND ASSOCIATED PERMIT(S) TO REVOCATION.

4. THIS CONSTRUCTION AUTHORIZATION AS PROVIDED IN G.S. 130A-335(f) AND G.S. 130A-336(b) SHALL BE VALID FOR A PERIOD EQUAL TO THE VALIDITY OF THE IMPROVEMENT PERMIT, NOT TO EXCEED 60 MONTHS.
   *CONSTRUCTION AUTHORIZATION EXPIRATION DATE: 10/2/2012

Mecklenburg County Groundwater & Wastewater Services
700 N. Tryon St, Suite 211 Charlotte, NC 28202
Phone: (704) 336-5103 Fax: (704) 336-8894

NC DENR
Division of Environmental Health
On-Site Wastewater Section

IMPROVEMENT PERMIT for a RESIDENTIAL ON-SITE WASTEWATER TREATMENT & DISPOSAL SYSTEM

Permit #: 30002651 GWS File #: 7291B Tax Parcel #: 139-041-13

- This IMPROVEMENT PERMIT is subject to revocation if site plans or the intended use change. There is to be NO grading, filling, or disturbance of the soil in the area of the septic tank system or repair area.
- CONSTRUCTION AUTHORIZATION must be obtained prior to receiving a Building Permit. The Construction Authorization is NOT transferable. Do not clear, grade, fill or disturb soil prior to obtaining a Construction Authorization.
- Domestic-type wastewater only. No industrial process wastewater may be discharged into the system.

I. This Improvement Permit Shall: Expire in Five (5) Years **Expiration Date (If Applicable):** 10/2/2012

Type of Installation: Residential - New System Lot Number: 2

Structure Type: HOUSE Size (ft^2): 3280 # Bedrooms: 5 # Occupants: 4

Building Foundation: Crawl Space Water Supply: Private Well

II. Initial System Type: Pump to Innovative **System Classification:** IIIb

Initial System Specifications:

Design Flow (gpd):	600	LTAR (gpd/ft^2):	0.275	Septic Tank Size (gal):	1500	Pump Tank Size (gal):	1000
Trench Width (ft):	3	Trench Spacing (ft):	9	Absorption Area (ft^2):	1635	Total Trench Length (ft):	545
Maximum Trench Depth (in):	22	Depth of Media (in):	N/A	Distribution Device:	Drop Boxes		

III. Repair System Type: PPBPS (pressurized) **System Classification:** IVa

Repair System Specifications:

Design Flow (gpd):	600	LTAR (gpd/ft^2):	0.275	Septic Tank Size (gal):	1500	Pump Tank Size (gal):	1000
Trench Width (ft)	3	Trench Spacing (ft):	9	Absorption Area (ft^2):	1092	Total Trench Length (ft):	364
Maximum Trench Depth (in):	30	Depth of Media (in):	N/A	Distribution Device:	Pressure Manifold		

IV. Permit Conditions/Comments:

(Please See the Following Page for Permit Conditions.)

The undersigned, an authorized agent of the MECKLENBURG COUNTY HEALTH DEPARTMENT, certifies that the Department is issuing an IMPROVEMENT PERMIT for the above referenced property. This permit is being issued in accordance with the *Laws and Rules For Sewage Treatment and Disposal Systems* and is subject to the following provisions:

- No work shall be conducted on the septic system until an INSTALLATION APPROVAL is granted by the Department.
- The septic system installer shall be a registered septic contractor with Mecklenburg County Health Department.
- The permitted system shall be installed in accordance with the included PLOT PLAN.
- This IMPROVEMENT PERMIT is transferable.

DENR Authorized Agent: David Cornelius Owner/Legal Agent: Rick Pinto
Print Name

Signature: Signature: Rick Pinto 10/5/07

Date Issued: 10/2/2007

Mecklenburg County Groundwater & Wastewater Services
700 N. Tryon St, Suite 211 Charlotte, NC 28202
Phone: (704) 336-5103 Fax: (704) 336-6894

NC DENR
Division of Environmental Health
On-Site Wastewater Section

IMPROVEMENT PERMIT for a RESIDENTIAL ON-SITE WASTEWATER TREATMENT & DISPOSAL SYSTEM

Permit #: 30002651 GWS File #: 7291B

IV. Permit Conditions/Comments:

- This type of septic system requires an inspection once every 5 years by our office. The system owner is responsible for any fees, as determined by the Mecklenburg County Board of Commissioners, associated with this inspection.
- Additional soil cover, as specified on the plot plan, required over the drain field must be inspected and approved prior to issuance of an Operation Permit.
- All components of the septic system must be installed in accordance with the required setbacks listed on the corresponding plot plan.
- All components of the septic system must be located at least 100 ft. (50 ft. minimum) from all private wells.

The undersigned, an authorized agent of the MECKLENBURG COUNTY HEALTH DEPARTMENT, certifies that the Department is issuing an IMPROVEMENT PERMIT for the above referenced property. This permit is being issued in accordance with the *Laws and Rules For Sewage Treatment and Disposal Systems* and is subject to the following provisions:

- No work shall be conducted on the septic system until an INSTALLATION APPROVAL is granted by the Department.
- The septic system installer shall be a registered septic contractor with Mecklenburg County Health Department.
- The permitted system shall be installed in accordance with the included PLOT PLAN.
- This IMPROVEMENT PERMIT is transferable.

DENR Authorized Agent: David Cornelius

Signature: [signature]

Date Issued: 10/2/2007

Owner/Legal Agent: Rick Pinto
Print Name

Signature: Rick Pinto 10/5/07

Department of Environment, Health, and Natural Resources
Division of Environmental Health
On-site Wastewater Section

Sheet: 1 of 2
Property ID: PO 139-042-03
Lot #: 2
File #: 7291B
AppID: 2651

SOIL/SITE EVALUATION for ON-SITE WASTEWATER SYSTEM

Owner: Korben Homes, Inc. Applicant:
Address: 9920 Hanging Moss Trail, Charlotte, N. C. 28227 Date Evaluated: 9/18/07
Proposed Facility: Residence Design Flow (.1949): 600gpd Property Size: 1.16a
Location of Site: 9216 Arlington Hills drive Property Recorded:
Water Supply: [ ] Public [x] Individual [ ] Well [ ] Spring [ ] Other
Evaluation Method: [x] Auger Boring [ ] Pit [ ] Cut
Type of Wastewater: [x] Sewage [ ] Industrial Process [ ] Mixed

PROFILE #	.1940 Landscape Position/ Slope%	Horizon Depth (IN.)	SOIL MORPHOLOGY .1941 .1941 Structure/ Texture	.1941 Consistence Mineralogy	b PROFILE FACTORS .1942 Soil Wetness/ Color	.1943 Soil Depth (IN.)	.1956 Sapro Class	.1944 Restr Horiz	Profile Class & LTAR
1	LS, 6	0-6	GR/CL	FR/SEXP/SS/SP	>48" TO SOIL WETNESS	48	N/A	NONE	PS, IV .3GPD/FT^2
		6-34	SBK/ABK/C	FI/SEXP/S/P					
		34-48	SBK/CL	FR/SEXP/SS/SP					
2	"	0-4	GR/CL	"	>34" TO SOIL WETNESS	34	"	"	US, IV .275GPD/FT^2
		4-31	SBK/ABK/C	FI/SEXP/S/P					
		31-34	SBK/CL	FR/SEXP/SS/SP					
3	"	0-5	GR/CL	"	>24" TO SOIL WETNESS	24+	"	"	US
		5-20	SBK/CL	"					
		20-24	SBK/ABK/C	VFI/EXP/VP/S					
4	"	0-8	GR/CL	FR/SEXP/SS/SP	>34" TO SOIL WETNESS	34	"	"	US, IV .275GPD/FT^2
		8-34	SBK/ABK/C	FI/SEXP/S/P					
					SITE LTAR .275GPD/FT^2				

Description	Initial System	Repair System
Available Space (.1945)	PS	PS
System Type(s)	IIIbg	Iva
Site LTAR	0.275	0.275

Other Factors (.1946):
Soil Evaluation By: W. R. Martin, LSS, 9/20/2007
Others Present:
Site Classification (.1948): Provisionally Suitable
Site Evaluation By: David Cornelius, RS
Others Present:


W. R. Martin, RS

COMMENTS:
100% repair

Landscape Position	Group	Texture	.1955 LTAR	Structure
R-Ridge	I	S-Sand	1.2 - 0.8	SG-Single Grain
SS-Shoulder Slope		LS-Loamy Sand		M-Massive
LS-Linear Slope				CR-Crumb
FS-Foot Slope	II	SL-Sandy Loam	0.8 - 0.6	GR-Granular
NS-Nose Slope		L-Loam		SBK-Subangular Blocky
HS-Head Slope				ABK-Angular Blocky
CC-Concave Slope	III	SI-Silt	0.6 - 0.3	PL-Platy
CV-Convex Slope		SICL-Silty Clay Loam		PR-Prismatic
T-Terrace				
FP-Flood Plain		CL-Clay Loam		
		SCL-Sandy Clay Loam		
	IV	SC-Sandy Clay	0.4 - 0.1	
		SIC-Silty Clay		
		C-Clay		

Consistence Moist	Consistence Wet	Mineralogy
VFR-Very Friable	NS-Non-Sticky	SEXP-Slightly Expansive
FR-Friable	SS-Slightly Sticky	EXP-Expansive
FI-Firm	S-Sticky	
VFI-Very Firm	VS-Very Sticky	
EFI-Extremely Firm	NP-Non-Plastic	
	SP-Slightly Plastic	
	P-Plastic	
	VP-Very Plastic	

Sketch of Soil Evaluation Locations

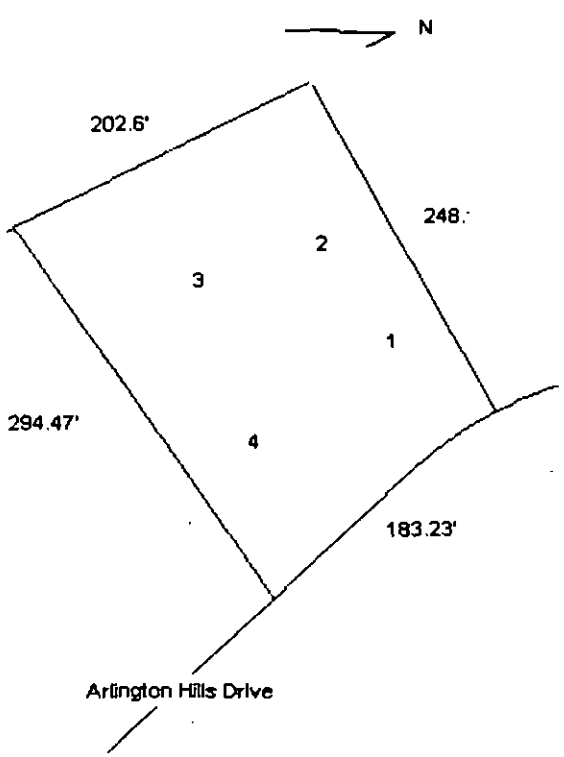






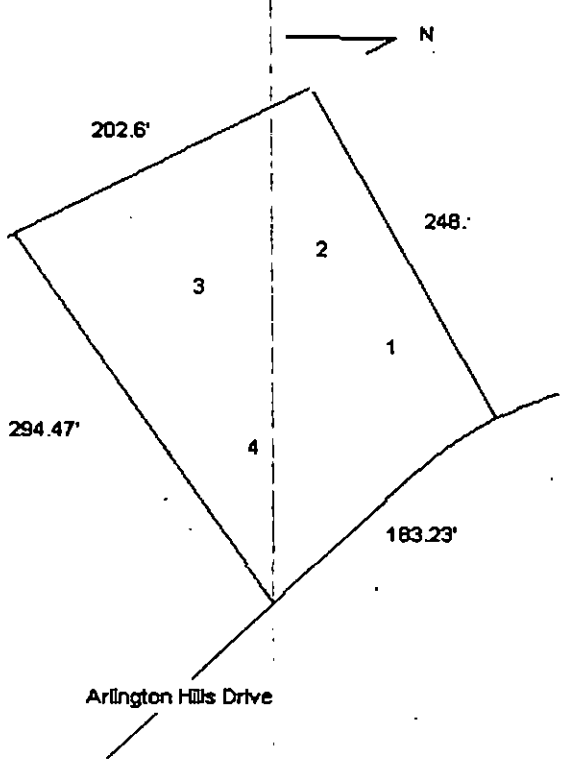

PROPOSED PLOT PLAN


HEALTH DEPARTMENT
ENVIRONMENTAL HEALTH DIVISION
700 NORTH TRYON ST., SUITE 211
CHARLOTTE, NC 28202
PHONE (704) 336-5103

ARLINGTON HILLS LOT #2

FILE: 7291B

TC: 139-042-03

Draw in and name all roads adjoining the property. Draw in and accurately dimension the lot concerned. Accurately indicate property boundaries proposed and/or existing structures and driveways, underground utilities, and wells and springs within 100 feet of the proposed building or drainfield.

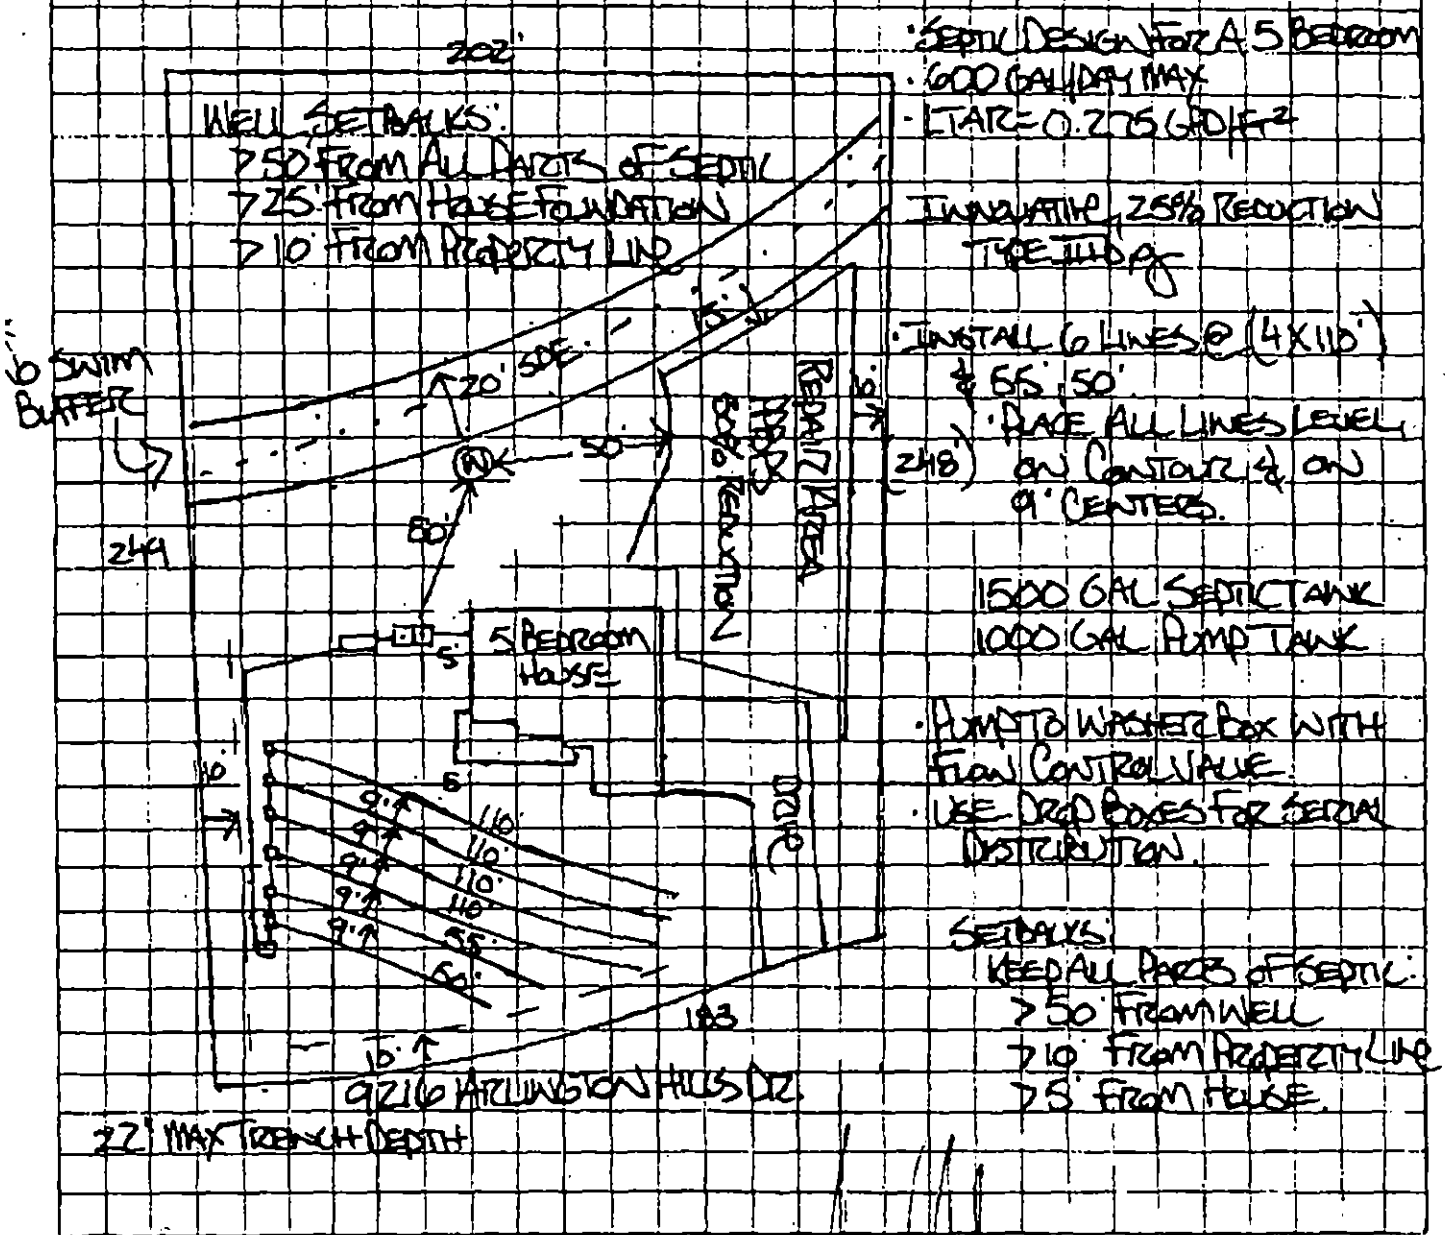

OWNER/AGENT SIGNATURE

DATE 10/5/07

APPROVAL DATE 10/2/07

"PAID IN FULL"

FILE NUMBER: 7291B

SEPTIC FEE: 500.00
DATE: 8/30/07
CK/CC 3413

Revised On: January 3, 2007
MECKLENBURG COUNTY GROUNDWATER & WASTEWATER SERVICES
APPLICATION FOR A RESIDENTIAL SITE IMPROVEMENT PERMIT/ CONSTRUCTION AUTHORIZATION FOR AN ON-SITE WASTEWATER SYSTEM, NEW WELL INSTALLATION, OR REPAIR OF EXISTING WELL

APPLICATION NUMBER: 2651

WELL FEE: 400.00
DATE: 8/30/07

CK 3413 GC

1. SEPTIC / TYPE APPLICATION: ☐ NONE ☒ NEW SYSTEM ☐ ALTERATION ☐ REPAIR ☐ MODIFIED PLOT PLAN

2. WELL / TYPE APPLICATION: ☐ NONE ☒ NEW WELL ☐ MAJOR REPAIR ☐ ABANDONMENT

3. JOB LOCATION INFORMATION:

TAX PARCEL NUMBER: 139-042-03
STREET ADDRESS: 9216 Arlington Hills Dr.
CITY: Charlotte
STATE: NC ZIP: 28227
SUBDIVISION NAME: Arlington Hills
LOT #: 2 LOT SIZE (acres): 1.16 AC
TOWNSHIP:

☐ 0-MECKLENBURG ☐ 3-CORNELIUS ☐ 6-HUNTERSVILLE
☐ 1-CHARLOTTE ☐ 4-PINEVILLE ☒ 7-MINT HILL
☐ 2-DAVIDSON ☐ 5-MATTHEWS

4. BUILDING INFORMATION:

BUILDING TYPE:
☐ SINGLE MOBILE HOME ☐ MODULAR HOME
☐ DOUBLE WIDE ☐ MULTIPLE FAMILY
☒ HOUSE ☐ OTHER _____
HEATED SQUARE FOOTAGE: 3280
NUMBER OF BEDROOMS: 5
NUMBER OF OCCUPANTS: 4
FOUNDATION TYPE:
☐ CONCRETE SLAB ☐ BASEMENT WITH PLUMBING
☒ CRAWL SPACE ☐ BASMENT WITH NO PLUMBING

5. IF PLANNING TO EXPAND OR ALTER THE EXISTING SYSTEM PLEASE COMPLETE THE FOLLOWING SECTION: ☐ N/A
NUMBER OF BEDROOMS TO BE ADDED: _____ NUMBER OF ADDITIONAL OCCUPANTS IN THE RESIDENCE: _____

6. WATER SUPPLY: ☐ MUNICIPAL ☐ PUBLIC WELL ☑ PRIVATE WELL ☐ SHARED WELL ☐ SPRING

7. PROPOSED USE OF WELL: ☐ N/A ☐ IRRIGATION ☑ POTABLE ☐ GEOTHERMAL ☐ OTHER

8. PLEASE INDICATE AND RANK DESIRED SEPTIC SYSTEM TYPE(S) IN ORDER OF PREFERENCE (1-MOST DESIRED 5-LEAST DESIRED):

☐ ANY TYPE ☑ CONVENTIONAL ☐ ACCEPTED ☑ INNOVATIVE ☐ ALTERNATIVE ☐ OTHER _____

8A. RANK: 1 — 2 — — —

9. DO ANY OF THE FOLLOWING APPLY TO THE PROPERTY IN QUESTION? IF "YES" PLEASE ATTACH SUPPORTING DOCUMENTATION.

BURIED CABLES, LANDFILLS, STUMPHOLES	☐ YES ☑ NO	GRADING/SOIL REMOVAL PERFORMED	☐ YES ☑ NO
EXISTING WASTEWATER SYSTEMS	☐ YES ☑ NO	JURISDICTIONAL WETLANDS	☐ YES ☑ NO
WELLS, SPRINGS, OR WATER LINES	☐ YES ☑ NO	APPROVAL REQUIRED BY ANY OTHER PUBLIC AGENCY	☐ YES ☑ NO
EASEMENTS OR RIGHT-OF-WAYS	☑ YES ☐ NO	WASTEWATER OTHER THAN DOMESTIC SEWAGE	☐ YES ☑ NO

10. PROPERTY OWNER: SEE SURVEY
NAME: Korben Homes, Inc.
ADDRESS: 9920 Hanging Moss Trail
CITY: Charlotte
STATE: NC ZIP: 28227
HOME PHONE: WORK PHONE: Cell 704-264-9866
MOBILE PHONE: FAX: 704-545-8679

Rick Pinto

11. OWNER'S LEGAL REPRESENTATIVE, IF APPLICABLE:
NAME:
ADDRESS:
CITY:
STATE: ZIP:
HOME PHONE: WORK PHONE:
MOBILE PHONE: FAX:

12. WHAT DATE WAS THE PROPERTY ORIGINALLY DEEDED AND RECORDED? 8/30/07
13 WHAT IS THE ANTICIPATED CLOSING DATE FOR THIS PROPERTY? 2/08

14. SEPTIC SYSTEM PERMIT APPLICATION SIGNATURE SECTION:
If the information in this application is falsified, changed, or the site is altered, then the Improvement Permit and Authorization to Construct shall become invalid. I have read this application and certify that the information provided herein is true, complete and correct. Authorized county and state officials are granted right of entry to conduct necessary inspections to determine compliance with applicable laws and rules. I understand that I am solely responsible for the proper identification and labeling of all property lines and corners and making the site accessible so that a complete site evaluation can be performed. The permit is valid for either 60 months or is non-expiring depending upon the documentation submitted: complete site plan = 60 months; complete plat = non-expiring.

Rick Pinto 08/30/07
Property Owner's or Owner's Legal Representative Signature Date

15. WELL PERMIT APPLICATION SIGNATURE SECTION:
If the information in this application is falsified, changed, or the site is altered, then the Well Permit shall become invalid. I have read this application and certify that the information provided herein is true, complete and correct. Authorized county and state officials are granted right of entry to conduct necessary inspections to determine compliance with applicable laws and rules. I understand that I am solely responsible for the proper identification and labeling of all property lines and corners and making the site accessible so that a complete site evaluation can be performed. The permit is valid for a period of 12 months from the date of issuance.

Rick Pinto 08/30/07
Property Owner's or Owner's Legal Representative Signature Date

☒ SURVEY PLAT TO SCALE SUBMITTED ☐ SCALED SITE PLAN SUBMITTED ☐ UN-SCALED SITE PLAN SUBMITTED

MECKLENBURG COUNTY-GROUNDWATER & WASTEWATER SERVICES
700 N. TRYON ST., SUITE 211, CHARLOTTE, NC 28202 PHONE: (704) 336-5103 FAX: (704) 336-6894


0701
0734
0703
0753

THIS IS TO CERTIFY THAT ON THE 29th DAY OF AUG. 20 07 I, SURVEYED THE PROPERTY SHOWN ON THIS PLAT AND THAT THE TITLE LINES AND THE WALLS OF THE BUILDINGS IF ANY ARE SHOWN HEREON.

SIGNED _____
REGISTERED SURVEYOR

PRELIMINARY

CURVE TABLE				
CURVE	LENGTH	RADIUS	CHORD BRG.	CHORD
C1	64.81	230.00	S36°27'42"E	64.59

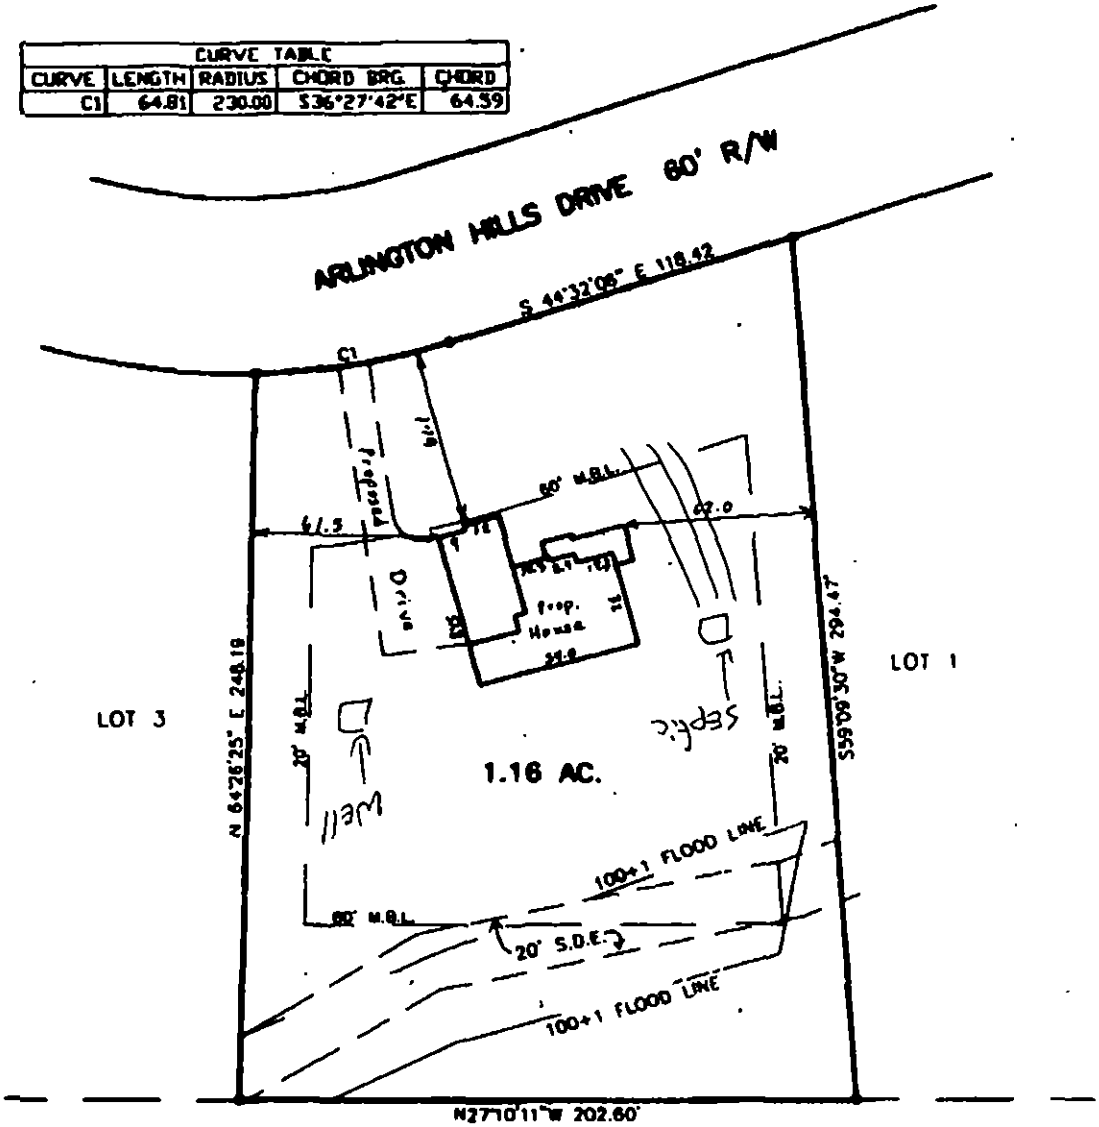

PLOT PLAN SURVEY
OF

LOT 2 ARLINGTON HILLS, MAP 1

SCALE 1" = 50' TOWN OF MINT HILL MECK. COUNTY, N.C.

THE PROPERTY OF KORBEN HOMES

MAP RECORDED IN BOOK 48 AT PAGE 707 DEED RECORDED IN BOOK ____ PAGE ____

8/30/07

DI-7697