

4501 QUAIL RIDGE DR

13537148

5/23/08

marliwr

Groundwater and Wastewater Services File Imaging Project
May 2007
Barcode Font = IDAutomationHC39M

JAM

FILE NUMBER: 4794

Revised On: January 3, 2007

APPLICATION NUMBER: _____

SEPTIC FEE: _____
DATE: _____

MECKLENBURG COUNTY GROUNDWATER & WASTEWATER SERVICES
APPLICATION FOR A RESIDENTIAL SITE IMPROVEMENT PERMIT/ CONSTRUCTION AUTHORIZATION FOR AN ON-SITE WASTEWATER SYSTEM, NEW WELL INSTALLATION, OR REPAIR OF EXISTING WELL

WELL FEE: _____
DATE: _____

1. SEPTIC / TYPE APPLICATION: ☐ NONE ☐ NEW SYSTEM ☐ ALTERATION ☒ REPAIR ☐ MODIFIED PLOT PLAN

2. WELL / TYPE APPLICATION: ☐ NONE ☐ NEW WELL ☐ MAJOR REPAIR ☐ ABANDONMENT

3. JOB LOCATION INFORMATION:
TAX PARCEL NUMBER: 135-356-12 (137-48)
STREET ADDRESS: 4501 Quail Ridge Dr.
CITY: Mint Hill
STATE: NC ZIP: 28227
SUBDIVISION NAME:
LOT #: 23 LOT SIZE (acres):
TOWNSHIP:
☐ 0-MECKLENBURG ☐ 3-CORNELIUS ☐ 6-HUNTERSVILLE
☐ 1-CHARLOTTE ☐ 4-PINEVILLE ☒ 7-MINT HILL
☐ 2-DAVIDSON ☐ 5-MATTHEWS

4. BUILDING INFORMATION:
BUILDING TYPE:
☐ SINGLE MOBILE HOME ☐ MODULAR HOME
☐ DOUBLE WIDE ☐ MULTIPLE FAMILY
☒ HOUSE ☐ OTHER _____
HEATED SQUARE FOOTAGE:
NUMBER OF BEDROOMS:
NUMBER OF OCCUPANTS:
FOUNDATION TYPE:
☐ CONCRETE SLAB ☒ BASEMENT WITH PLUMBING
☐ CRAWL SPACE ☐ BASMENT WITH NO PLUMBING

5. IF PLANNING TO EXPAND OR ALTER THE EXISTING SYSTEM PLEASE COMPLETE THE FOLLOWING SECTION: ☐ N/A
NUMBER OF BEDROOMS TO BE ADDED: _____ NUMBER OF ADDITIONAL OCCUPANTS IN THE RESIDENCE: _____

6. WATER SUPPLY: ☒ MUNICIPAL ☐ PUBLIC WELL ☐ PRIVATE WELL ☐ SHARED WELL ☐ SPRING

7. PROPOSED USE OF WELL: ☐ N/A ☐ IRRIGATION ☐ POTABLE ☐ GEOTHERMAL ☐ OTHER

8. PLEASE INDICATE AND RANK DESIRED SEPTIC SYSTEM TYPE(S) IN ORDER OF PREFERENCE *(1-MOST DESIRED 5-LEAST DESIRED)*:

☐ ANY TYPE ☐ CONVENTIONAL ☐ ACCEPTED ☐ INNOVATIVE ☐ ALTERNATIVE ☐ OTHER _____

8A. RANK: ____ ____ ____ ____ ____

9. DO ANY OF THE FOLLOWING APPLY TO THE PROPERTY IN QUESTION? IF "YES" PLEASE ATTACH SUPPORTING DOCUMENTATION.

BURIED CABLES, LANDFILLS, STUMPHOLES	☐ YES	☒ NO	GRADING/SOIL REMOVAL PERFORMED	☐ YES	☒ NO
EXISTING WASTEWATER SYSTEMS	☐ YES	☒ NO	JURISDICTIONAL WETLANDS	☐ YES	☒ NO
WELLS, SPRINGS, OR WATER LINES	☐ YES	☒ NO	APPROVAL REQUIRED BY ANY OTHER PUBLIC AGENCY	☐ YES	☒ NO
EASEMENTS OR RIGHT-OF-WAYS	☐ YES	☒ NO	WASTEWATER OTHER THAN DOMESTIC SEWAGE	☐ YES	☒ NO

10. PROPERTY OWNER:
NAME:
ADDRESS: 4501 Quail Ridge Dr.
CITY: Mint Hill
STATE: NC ZIP: 28227
HOME PHONE: 704-573-0531 WORK PHONE:
MOBILE PHONE: FAX:

11. OWNER'S LEGAL REPRESENTATIVE, IF APPLICABLE:
NAME:
ADDRESS:
CITY:
STATE: ZIP:
HOME PHONE: WORK PHONE:
MOBILE PHONE: FAX:

12. WHAT DATE WAS THE PROPERTY ORIGINALLY DEEDED AND RECORDED? _____
13 WHAT IS THE ANTICIPATED CLOSING DATE FOR THIS PROPERTY? _____

14. SEPTIC SYSTEM PERMIT APPLICATION SIGNATURE SECTION:
If the information in this application is falsified, changed, or the site is altered, then the Improvement Permit and Authorization to Construct shall become invalid. I have read this application and certify that the information provided herein is true, complete and correct. Authorized county and state officials are granted right of entry to conduct necessary inspections to determine compliance with applicable laws and rules. I understand that I am solely responsible for the proper identification and labeling of all property lines and corners and making the site accessible so that a complete site evaluation can be performed. The permit is valid for either 60 months or is non-expiring depending upon the documentation submitted: complete site plan = 60 months, complete plat = non-expiring.

Mary Graham
Property Owner's or Owner's Legal Representative Signature Date

15. WELL PERMIT APPLICATION SIGNATURE SECTION:
If the information in this application is falsified, changed, or the site is altered, then the Well Permit shall become invalid. I have read this application and certify that the information provided herein is true, complete and correct. Authorized county and state officials are granted right of entry to conduct necessary inspections to determine compliance with applicable laws and rules. I understand that I am solely responsible for the proper identification and labeling of all property lines and corners and making the site accessible so that a complete site evaluation can be performed. The permit is valid for a period of 12 months from the date of issuance.

Property Owner's or Owner's Legal Representative Signature Date

☐ SURVEY PLAT TO SCALE SUBMITTED ☐ SCALED SITE PLAN SUBMITTED ☐ UN-SCALED SITE PLAN SUBMITTED

MECKLENBURG COUNTY-GROUNDWATER & WASTEWATER SERVICES
700 N. TRYON ST., SUITE 211, CHARLOTTE, NC 28202 PHONE: (704) 336-5103 FAX: (704) 336-6894

Mecklenburg County Groundwater & Wastewater Services
700 N. Tryon St., Suite 211 Charlotte, NC 28202
Phone: (704) 336-5103 Fax: (704) 336-6894

NC DENR
Division of Environmental Health
On-Site Wastewater Section

INSTALLATION APPROVAL for an
ON-SITE WASTEWATER TREATMENT & DISPOSAL SYSTEM

File #: 4794 Permit #: _____ Tax Parcel #: _____

Property Owner: Mary Beagben

Job Location Address: 4502 Quail Ridge Dr.

City: Mint Hill State: NC Zip Code: 28227

Installation Approval Issuance Date: 06-12-2007

Permission is hereby given to ☐ install ☐ alter ☒ repair an on-site wastewater treatment & and disposal system, with subsurface soil absorption and effluent discharge, as specified herein at the described location. This approval is granted based upon the application information submitted to our office. All work shall be completed on or before 06-12-2007, after which date this approval shall be null and void. The system shall meet all of the construction requirements of 15A NCAC 18A. 1900 which are in effect on the date of granting this approval. An **Operation Permit** must be obtained from the Mecklenburg County Health Department before any system can be covered up or placed into service. The issuance of this permit does not in any way guarantee that the system anticipated to be constructed will operate properly, or relieve any person now of hereafter owning, controlling or using such system from any liability resulting from the failure of the system to operate properly.

***NOTICE: This system shall not be installed while soils are in a wet condition.**

Permitted Design Flow: 360 GPD Site LTAR: N/A GPD/ft² (For new installations only.)

Liquid Capacity of Septic Tank: N/A Wash Line gallons Liquid Capacity of Dosing Tank: _____ gallons

Drainfield Design ☒ N/A

Trench Depth: _____ inches

Trench Width: _____ feet

Line Spacing: _____ feet (O.C.)

Total line length: _____ feet

# of Lines: _____ @ _____ feet

Depth of Media: _____ inches (Type) _____

Distribution Device: _____

Bed Design *(For Repair Installations ONLY.)* ☐ N/A

Bed Depth: 36 inches

Bed Width: 9 feet

Total line length: 33 feet

# of Lines: 1 @ 33 feet

Depth of Media: 18 inches (Type) Stone

Distribution Device: Tie into existing wash line.

Water Supply Source

☒ Municipal ☐ Private Well ☐ Community Well

☐ Other _____


Minimum System Setbacks

Distance from Building Foundation: 10 feet

Distance from Property Line: 10 feet

Distance from Water Supply Source: 10 feet

SKETCH OF SYSTEM LAYOUT
(Proposed Layout)

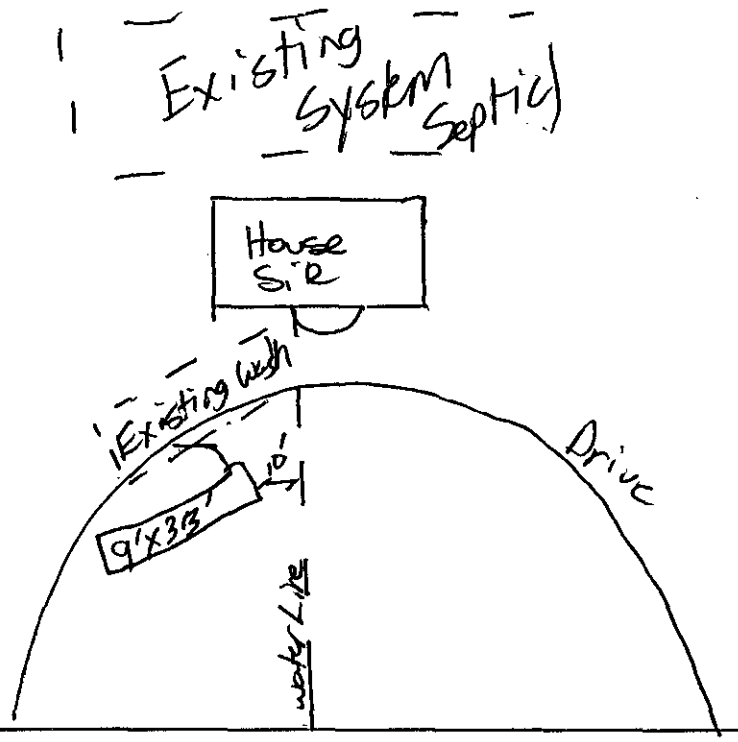

Comments: System Classification & Type: II a wash line.

DENR Authorized Agent: Jeremy Michael Signature: Jeremy Michael

Mecklenburg County Groundwater & Wastewater Services
700 N. Tryon St., Suite 211 Charlotte, NC 28202
Phone: (704) 336-5103 Fax: (704) 336-6894

HM

NC DENR
Division of Environmental Health
On-Site Wastewater Section

OPERATION PERMIT for an
ON-SITE WASTEWATER TREATMENT & DISPOSAL SYSTEM

File #: 4794 Permit #: _____ Tax Parcel #: _____

Property Owner: Mary Bagley

Job Location Address: 4501 Quail Ridge Dr.

City: Mint Hill State: NC Zip Code: 28227

Operation Permit Issuance Date: 06-13-2007 Contractor Name: Steve Autry

Permitted Design Flow: 360 GPD Liquid Capacity of Dosing Tank: _____ gallons

Liquid Capacity of Septic Tank: N/A gallons Effluent Pump Model: _____

Drainfield Installation ☑ N/A

Trench Depth: _____ inches

Trench Width: _____ feet

Line Spacing: _____ feet (O.C.)

Total line length: _____ feet

# of Lines: _____ @ _____ feet

Depth of Media: _____ inches (Type) _____

Depth of Cover: _____ inches

Distribution Device: _____

Inspection Dates

Tank(s) Inspected: N/A

Excavation Inspected: 06-13-2007

Pump & Controls Inspected: N/A

Bed Installation *(For Repair Installations ONLY.)* ☐ N/A

Bed Depth: 48 inches

Bed Width: 9 feet

Total line length: 33 feet


# of Lines: 1 @ 33 feet

Depth of Media: 18 inches (Type) Stone

Depth of Cover: 30 inches

Distribution Device: Tied into existing Bed

SKETCH OF SYSTEM INSTALLATION
(As-Built Drawing)

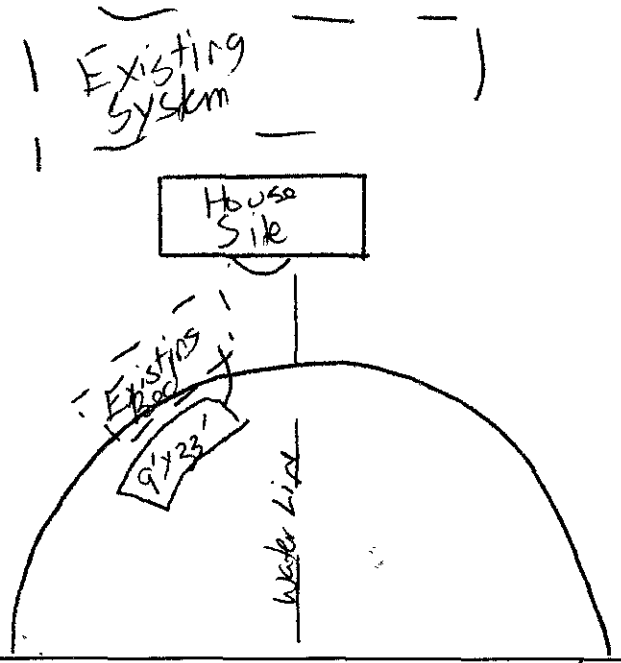

Water Supply Source

☑ Municipal ☐ Private Well ☐ Community Well

☐ Other _____

System Installation Setbacks

Distance from Building Foundation: 10 feet

Distance from Property Line: 10 feet

Distance from Water Supply Source: 10 feet

The undersigned has inspected the Septic Tank System described above, and certifies it has been ☐ installed ☐ altered ☑ repaired ☑ as detailed in the plot above ☐ in accordance with the permit issued and meets the provisions of 15A NCAC 18A. 1900, "Laws and Rules for Sewage Treatment and Disposal Systems" in effect on the date of issuance of the permit. The issuance of this Operation Permit does not in any way guarantee that the system will operate properly or relieve any person now or hereafter owning, controlling, or using such system from any liability resulting from the failure of the system to operate properly. This document is issued subject to *those restrictions and conditions shown on the permit(s) and the provisions of 15A NCAC 18A. 1900 in addition to those listed below* under "Comments." This document shall be null and void if any information contained in the application is untrue or if any additions are made to the property which would increase the requirements for said system.

Notice: Disturbance of the designated repair area may result in the Suspension or Revocation of this permit.

Comments: System Classification & Type: II a GBD, G, N/A, N/A

DENR Authorized Agent: Jeremy Michael Signature: Jeremy Michael

4796

INDIVIDUAL WATER AND WASTEWATER SYSTEMS PROGRAM
APPLICATION FOR SERVICES

Mecklenburg County Health Dept.
Environmental Health Division
c/o Hal Marshall Ctr., Suite 211
700 N. Tryon St.
Charlotte, NC 28202

(704)336-5102

Date: 4/17/95

PERSON FILING APPLICATION:

NAME: BEAGHEN (last) MARY (first) JEANETTE (mi)

ADDRESS: 9501 Quail Ridge Dr. PHONE: (704) 573-0831

CITY: Mint Hill STATE: NC ZIPCODE: 28227

PROPERTY OWNER:

NAME: SAME AS ABOVE (last) (first) (mi)

ADDRESS: _____ PHONE: (___) _____

CITY: STATE: ZIPCODE:

PROPERTY INFORMATION (FROM ENGINEERING FORM):

TAX/PARCEL NUMBER: # 135.356.12

STREET ADDRESS: 9501 Quail Ridge Dr.

Mint Hill, NC. 28227

ZONING:

SUBDIVISION OR MOBILE HOME PARK NAME: FARMWOOD SEC. #5

Township (check one):
[ ] 0 Mecklenburg County [ ] 2 Davidson [ ] 4 Pineville [ ] 6 Huntersville
[ ] 1 Charlotte [ ] 3 Cornelius [ ] 5 Matthews [X] 7 Mint Hill

TYPE APPLICATION (check one):

LOT NUMBER: 23 G. FARMWOOD SEC. 5 LOT SIZE (in acres): .9158

[ ] SOIL TEST - INDIVIDUAL LOT (D)
[X] NEW CONSTRUCTION ON VACANT LOT - 4 BEDROOMS OR LESS (N)
[ ] EXCHANGE MOBILE HOME - SAME # BEDROOMS (Y)
[ ] ADDITION - INCREASE ROOMS/OCCUPANCY/MOBILE HOME SIZE (A or M)
[ ] COMMERCIAL OR INDUSTRIAL (M)
[ ] SOIL TEST DEVELOPMENT (P)
[X] ADDITION - GARAGE OR RENOVATION/NO MAJOR CHANGES (X) ADDITION TO DECK
[ ] MODIFIED /ALTERNATIVE/ OR RESIDENCE > 4 BEDROOMS (Z)
[ ] REPAIR TO SYSTEM (R)

RESIDENTIAL PROPERTY (Type Building, check one):
[ ] SINGLE MOBILE HOME (S) [ ] HOUSE (H) [ ] MULTIPLE FAMILY (U)
[ ] DOUBLE WIDE (D) [ ] MODULAR HOME (M) [ ] OTHER _____ (O)

NUMBER BEDROOMS: 3 NUMBER OCCUPANTS: 2

SYSTEM CLASSIFICATION:

COMMERCIAL/INDUSTRIAL PROPERTY:
Type Business _____ # Employees ___ Per Shift ___ ___ ___
Industrial Wastes (Y/N) ___
Underground Storage Tanks On Property (Y/N) ___ Type _____

WATER SUPPLY (check one):
[X] Community (C) [ ] Shared Well (S)
[ ] Municipal (M) [ ] Other 'spring' (O)
[ ] Private Well (P)

FUTURE ADDITIONS - ALL PLANNED ADDITIONS MUST BE ENTERED (check all that apply):
[ ] Swimming Pool [ ] Jacuzzi [ ] Stable/Barn [ ] Workshop [ ] Bams
[ ] Garage [ ] Storage Building [ ] Deck/Patio [ ] Bedrooms [ ] Other

The undersigned, owner, or legal agent for the owner, of the property described above as the "JOB LOCATION" has read the foregoing application, acknowledges that the contents of same are true, and authorizes agents of the MECKLENBURG COUNTY HEALTH DEPARTMENT to enter onto the property for the purpose of processing this request.

Signed: Mary Beaghen Date: 4/17/95

NOTICE:

The undersigned, an authorized agent of the MECKLENBURG COUNTY HEALTH DEPARTMENT, certifies that the Department has approved the the Request for the Job Location contained in this document. This approval is granted in accordance with the provisions of Laws And Rules For Sanitary Sewage Collection, Treatment And Disposal in effect at the time of issuance of the permit and is subject to the following provisions:

...No work shall be conducted on the septic tank system until an installation, Construction, Alteration and/or Repair approval is granted by this Department.

...This permit is not transferable.

... Use existing system
Addition to deck only

[ ] IMPROVEMENT PERMIT - VALID 60 MONTHS FROM ISSUANCE
[ ] MOBILE HOME EXCHANGE APPROVAL - VALID 6 MONTHS FROM ISSUANCE
[X] ADDITION/RENOVATION APPROVAL - VALID 1 YEAR FROM ISSUANCE

Kenny Thompson, R.S. 4-18-95
Environmentalist Date

P. Walker for S. Daniel 5/10/95
Director or Authorized Section Head Date

WATER : 122791


PROPOSED PLOT PLAN

HEALTH DEPARTMENT
ENVIRONMENTAL HEALTH DIVISION
700 NORTH TRYON STREET
CHARLOTTE, NC 28202
PHONE (704) 336-5102

FILE: 47194

TC: _____

Draw in and name all roads adjoining the property. Draw in and accurately dimension the lot concerned. Accurately indicate property boundaries proposed and/or existing structures and driveways, underground utilities, and wells and springs within 100 feet of the proposed building or drainfield.

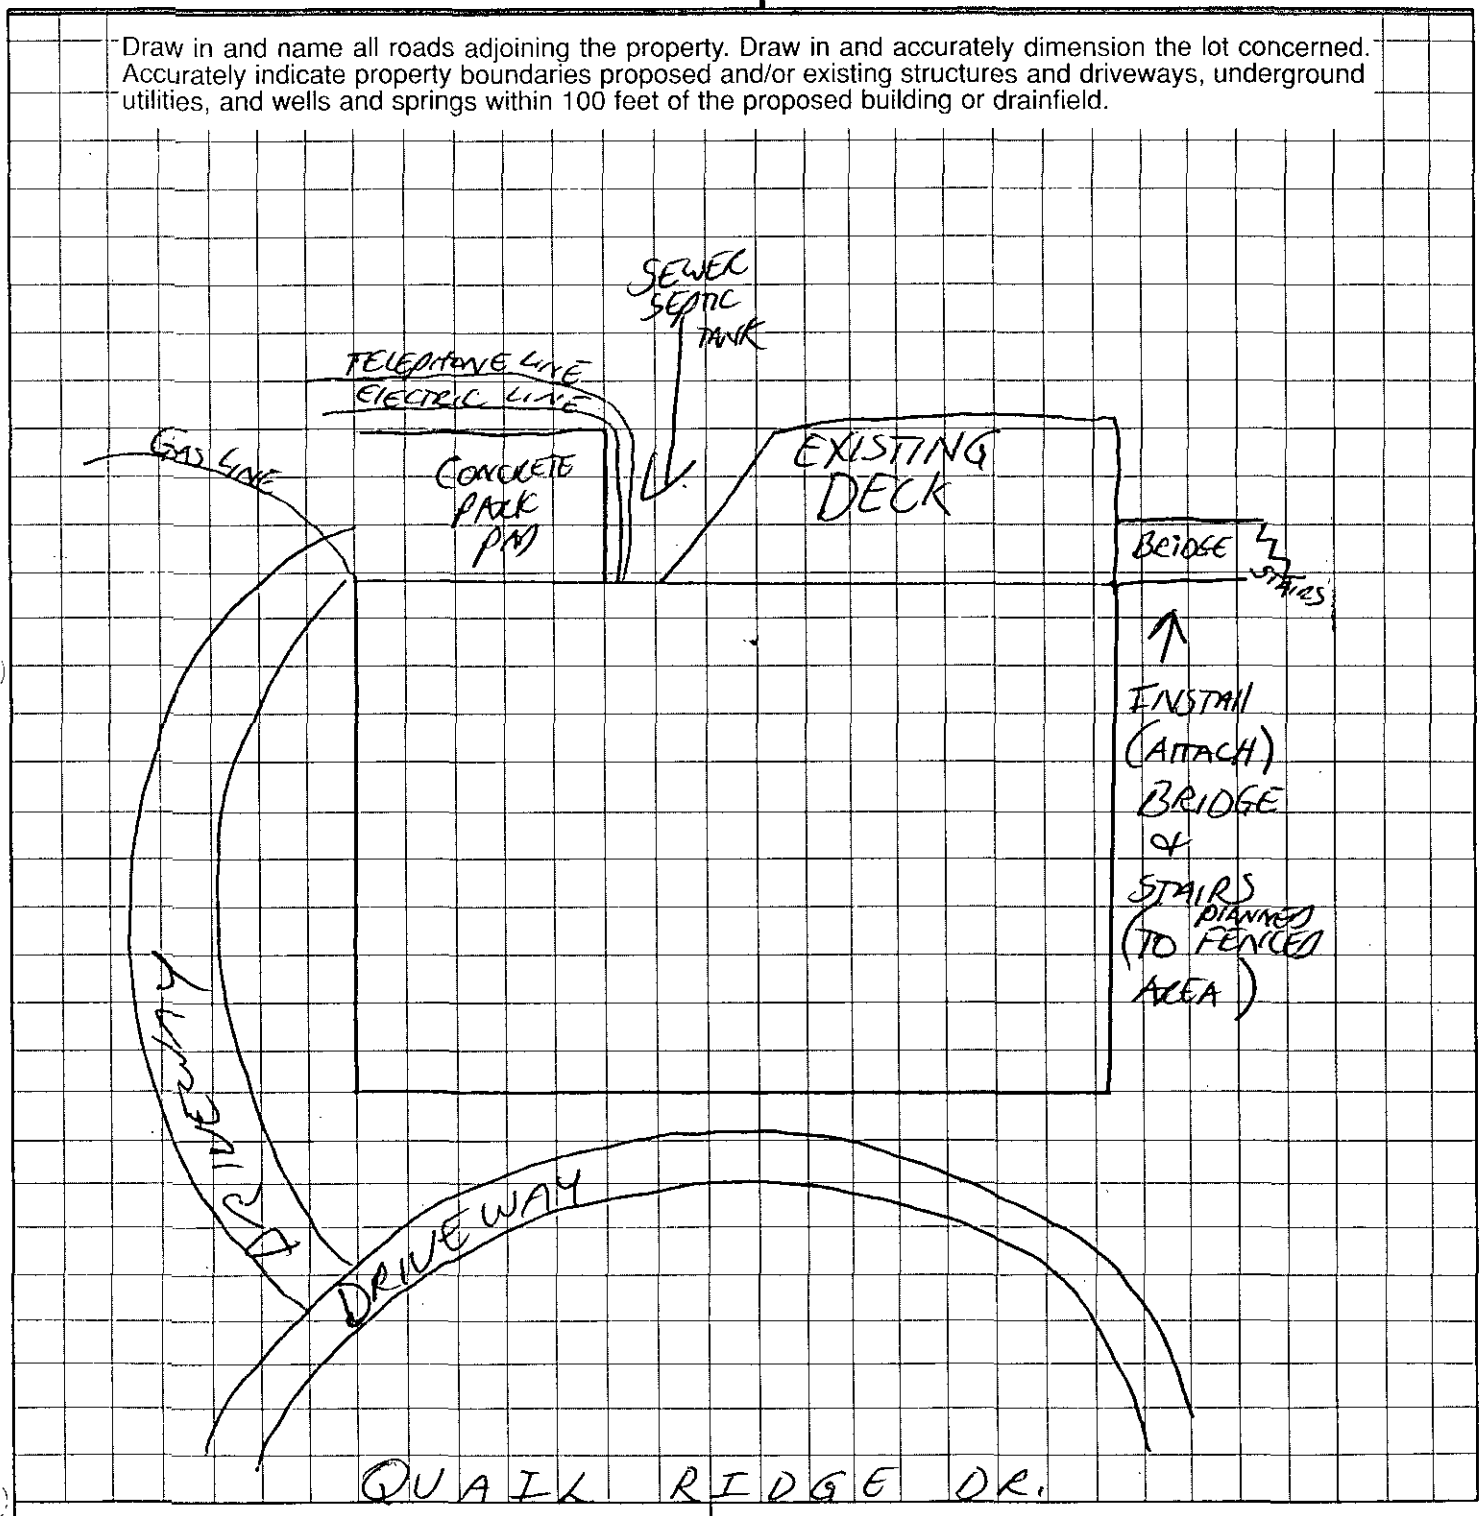

Mary Beaghen
OWNER/AGENT SIGNATURE

DATE 4/17/95

APPROVAL DATE _____

White - Health Department's Copy Canary - E.H.S. Copy Pink - Owner's Copy