PID # 19519103
DR. JOHN ROBERT SILVER
AND WIFE
LAURA U. SILVER
AND
MILDRED ANDERSON SILVER
D.B. 11540 PG. 229

PID # 19519104
BRIGETTE R. MCLEMORE
AND HUSBAND
KEVIN MCLEMORE
D.B. 20038 PG. 381

PID # 19510108
MARVIN G. LINEBERGER
AND WIFE
TAMMY T. LINEBERGER
D.B. 7434 PG. 258

IPF
CM
PLASTIC RAIL FENCE
CHAINLINK FENCE
PLASTIC RAIL FENCE

PID # 19510153
JOHN R. HIRSTON SR.
AND WIFE
KATHY R. HAIRSTON
D.B. 11534 PG. 255

AREA
3.02 ACRES

PID # 19510141
CHRISTOPHER M. MINICH
AND WIFE
HOLLY C. MINICH
D.B. 8592 PG. 31

PID # 19510138
JULIAN BROOKS DAVIS
AND WIFE
JEAN S. DAVIS
D.B. 6859 PG. 422

S40°29'11"E
12.60'

PROPOSED SEPTIC
THIS SIDE OF FENCE

IPS
IPPF

PID # 19510107
DEBRA N. TAYLOR
AND HUSBAND
JOHNNY L. TAYLOR
D.B. 18976 PG. 57
M.B. 27 PG. 585

50.8'
ONE STORY
METAL BUILDING
N32°34'15"E
168.25'
CHAINLINK FENCE
OLD PROPERTY LINE
TWO CAR
BLOCK BUILDING
COMPOSITE ROOF
24" OAK
LP

ACQUIRED BY
JULIAN BROOKS DAVIS
AND WIFE
JEAN S. DAVIS
D.B. 24127 PG. 877

51.0'
41.50'
N85°39'33"W
20.1'
IPS
AXLE FOUND
NCSPC NAD 83 (1986)
NORTH 508,183.98 FEET
EAST 1,501,982.27 FEET

CHAINLINK FENCE
EXISTING PROPERTY LINE


PID # 19510113
JOHN E. EASON
AND WIFE
LINDA H. EASON
D.B. 3756 PG. 789

IPPF

CP
CONCRETE APRON
GRAVEL DRIVEWAY
IPF
BARNEY DRIVE
EXISTING 50' PUBLIC R/W
MAP BOOK 27 PAGE 872

PLASTIC RAIL FENCE

PID # 19510151
FRANK MCCRADY WILLIAMS
D.B. 15831 PG. 404

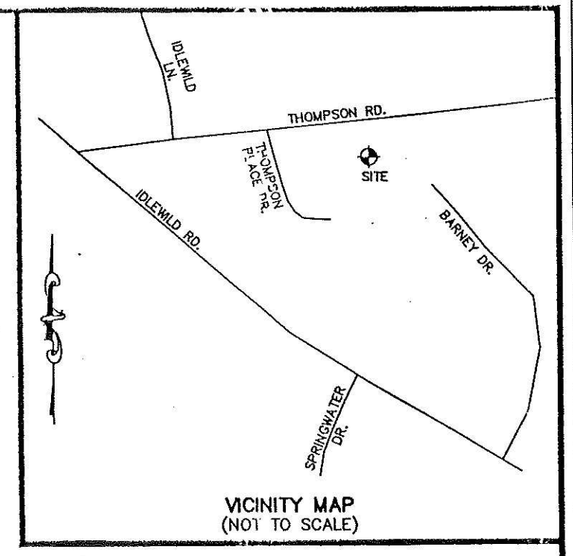

VICINITY MAP
(NOT TO SCALE)

NOTES:
ERROR OF CLOSURE 1:10,000+
AREA BY COMPUTER (COORDINATE METHOD)
THIS IS NOT A BOUNDARY SURVEY. THE PURPOSE OF THIS MAP
IS TO SHOW THE LOCATION OF THE EXISTING BUILDING.
THE FINAL AS-BUILT SURVEY WILL HAVE ALL BOUNDARY INFORMATION SHOWN.

LEGEND:
CM = CONCRETE MONUMENT FOUND
CP = COMPUTED POINT
IPF = IRON PIN FOUND
IPPF = IRON PIPE FOUND
IPS = IRON PIN SET
LP = LIGHT POLE

NORTH CAROLINA
PROFESSIONAL
SEAL
L-1519
LAND SURVEYOR
EDWARD L. KILLOUGH

BUILDING LOCATION SURVEY
ON
TAX PARCEL NO. 19510138
FOR
JULIAN BROOKS DAVIS and wife, JEAN S. DAVIS

MINT HILL, MECKLENBURG COUNTY, NORTH CAROLINA
SEPTEMBER 19, 2008

GRAPHIC SCALE

50 0 25 50 100 200
(IN FEET)
1 inch = 50 ft.

SURVEYED BY EDWARD L. KILLOUGH, N.C.P.L.S. L-1519
5823 HIGHWAY 74
P.O. BOX 369
INDIAN TRAIL, NORTH CAROLINA 28079
TEL (704) 821-7111
FAX (704) 821-7152
EMAIL: e_killo@yahoo.com

STAT13\BARNEY_JR.DWG

7273B
195-101-51