

417 VALLEYDALE RD

03101116

5/17/2007

duponbj

Groundwater and Wastewater Services File Imaging Project
May 2007
Barcode Font = IDAutomationHC39M

CERTIFICATE OF COMPLETION/OPERATION PERMIT


MECKLENBURG COUNTY ENVIRONMENTAL HEALTH
1200 BLYTHE BOULEVARD
CHARLOTTE, NC 28203
PHONE (704) 376-4603

FILE: 4303 A DATE: 8/10/89
TC: 031-011-16 ☐ L ☐ CRT
SERIAL № 12077

Name of Owner: Brigman Joe Juris.:
Address of Property: 417 Valleydale Rd

Inspection Data:

Tank Material: Pcc
Total Length of Drainfield: 450'
Number of Lines: 3 @ 150'
Cover Depth: 18-24"
Water Supply Source: Well
Distance to Water Source: >50'
Excavation Inspected: 8/9/89
Tank(s) Inspected: 8/9/89
Wash Line Inspected:
High Water Alarm Inspected:

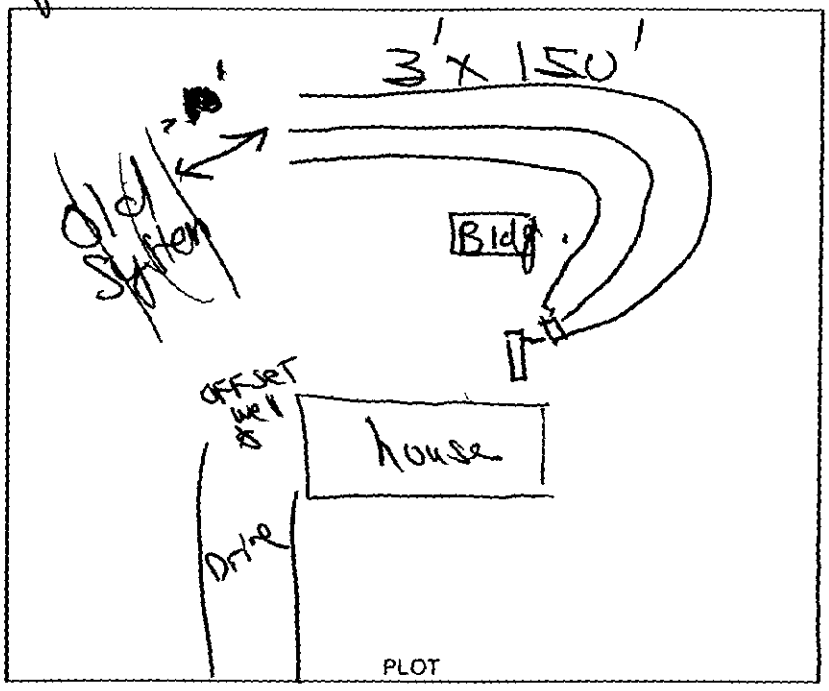

Design: 1989 Repair CTR# 140

The undersigned has inspected the Septic Tank System described above, and certifies it has been
☐ installed or constructed ☐ ~~altered~~ or repaired
☐ ~~in accordance~~ with the permit issued ☐ as detailed in the plot above
and meets the provisions of 10 NCAC 10A .1900, "Laws And Rules For Sanitary Sewage Collection, Treatment, And Disposal" ~~in effect~~ on the date of issuance of the permit. The issuance of this
☐ ~~Certificate~~ of Completion ☐ Operation Permit
does not in any way guarantee that the system will operate properly or relieve any person now or hereafter owning, controlling, or using such system from any liability resulting from the failure of the system to operate properly. This document is issued subject to those restrictions and conditions shown on the permit(s) and the provisions of 10 NCAC 10A .1900 in addition to those listed below under "COMMENTS." This document shall be null and void if any information contained in the application is untrue or if any additions are made to the property which would increase the requirements for said system.

COMMENTS:

Judy J. Kuri R.S.
Environmentalist

Mecklenburg County services are available without regard to ethnic origin, sex, or disability.

INSTALLATION, CONSTRUCTION, ALTERATION, AND/OR REPAIR PERMIT

MECKLENBURG COUNTY · ENVIRONMENTAL HEALTH


1200 BLYTHE BOULEVARD
CHARLOTTE, NC 28203
PHONE (704) 376-4603

FILE: 4303A DATE: 8/2/89

TC: D31-011-16 ☐ L

SERIAL № 12893

Permission is hereby given to _____ Install or Construct, ✓ Alter ~~or Repair the~~ individual septic tank wastewater treatment system with subsurface, soil absorption, effluent discharge as specified herein for the described location. This permit is granted based upon the information supplied in the application dated 2/23/88. All work shall be completed on or before 9/2/89, after which date this permit shall be null and void. The system shall meet all of the construction requirements of 10 NCAC 10A .1900 which are in effect on the date of the granting of this permit. A Certificate of Completion or an Operation Permit must be obtained from the Mecklenburg County Department of Environmental Health before any system can be covered up or placed into service. The issuance of this permit does not in any way guarantee that the system anticipated to be constructed will operate properly, or relieve any person now or hereafter owning, controlling or using such system from any liability resulting from the failure of the system to operate properly.

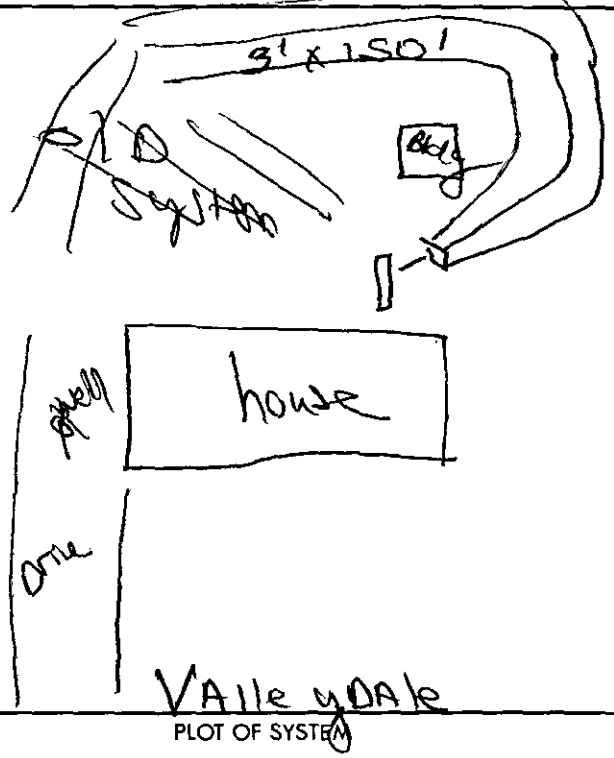

PLOT OF SYSTEM

Liquid Capacity of Septic Tank _____ gallons

Liquid Capacity of Dosing Tank _____ gallons

Tank Construction Repair

Absorption and/or Nitrification Lines:

Trench Width 3 feet

Total Line Length 450 feet

Number of Lines 3

Depth of Stone 12 inches

Distance from House 5 feet

Distance from Property Line 10 feet

Distance from Well ≥ 50' feet

NAME OF OWNER ~~Brigman~~ Joe

LOCATION OF PROPERTY 417 Valleydale Rd

Comments: Set New "T" IN TANK New D. Box. Run 3 trenches 3'x150' 12" Stone Straw Cover. (Keep Trenches between Garden & Building

Division or Section Head

Environmentalist Judy J. Kweir RS


* If this permit is for the installation or construction of a new system, it must be signed by the division or a section head of the Department of Environmental Health in order to be valid. Only the signature of the Environmentalist is required where an existing system is being altered or repaired.

WHITE - ENVIRONMENTAL HEALTH DEPARTMENT'S COPY ● CANARY - ENVIRONMENTALIST'S COPY ● PINK - OWNER OR AGENTS COPY

4303A

THIS IS TO CERTIFY THAT I SURVEYED THIS PROPERTY AND THAT IMPROVEMENTS ARE SHOWN HEREON. THIS MAP IS NOT INTENDED TO MEET GS 47-30 RECORDING REQUIREMENTS.

Andy G. Zoutewelle

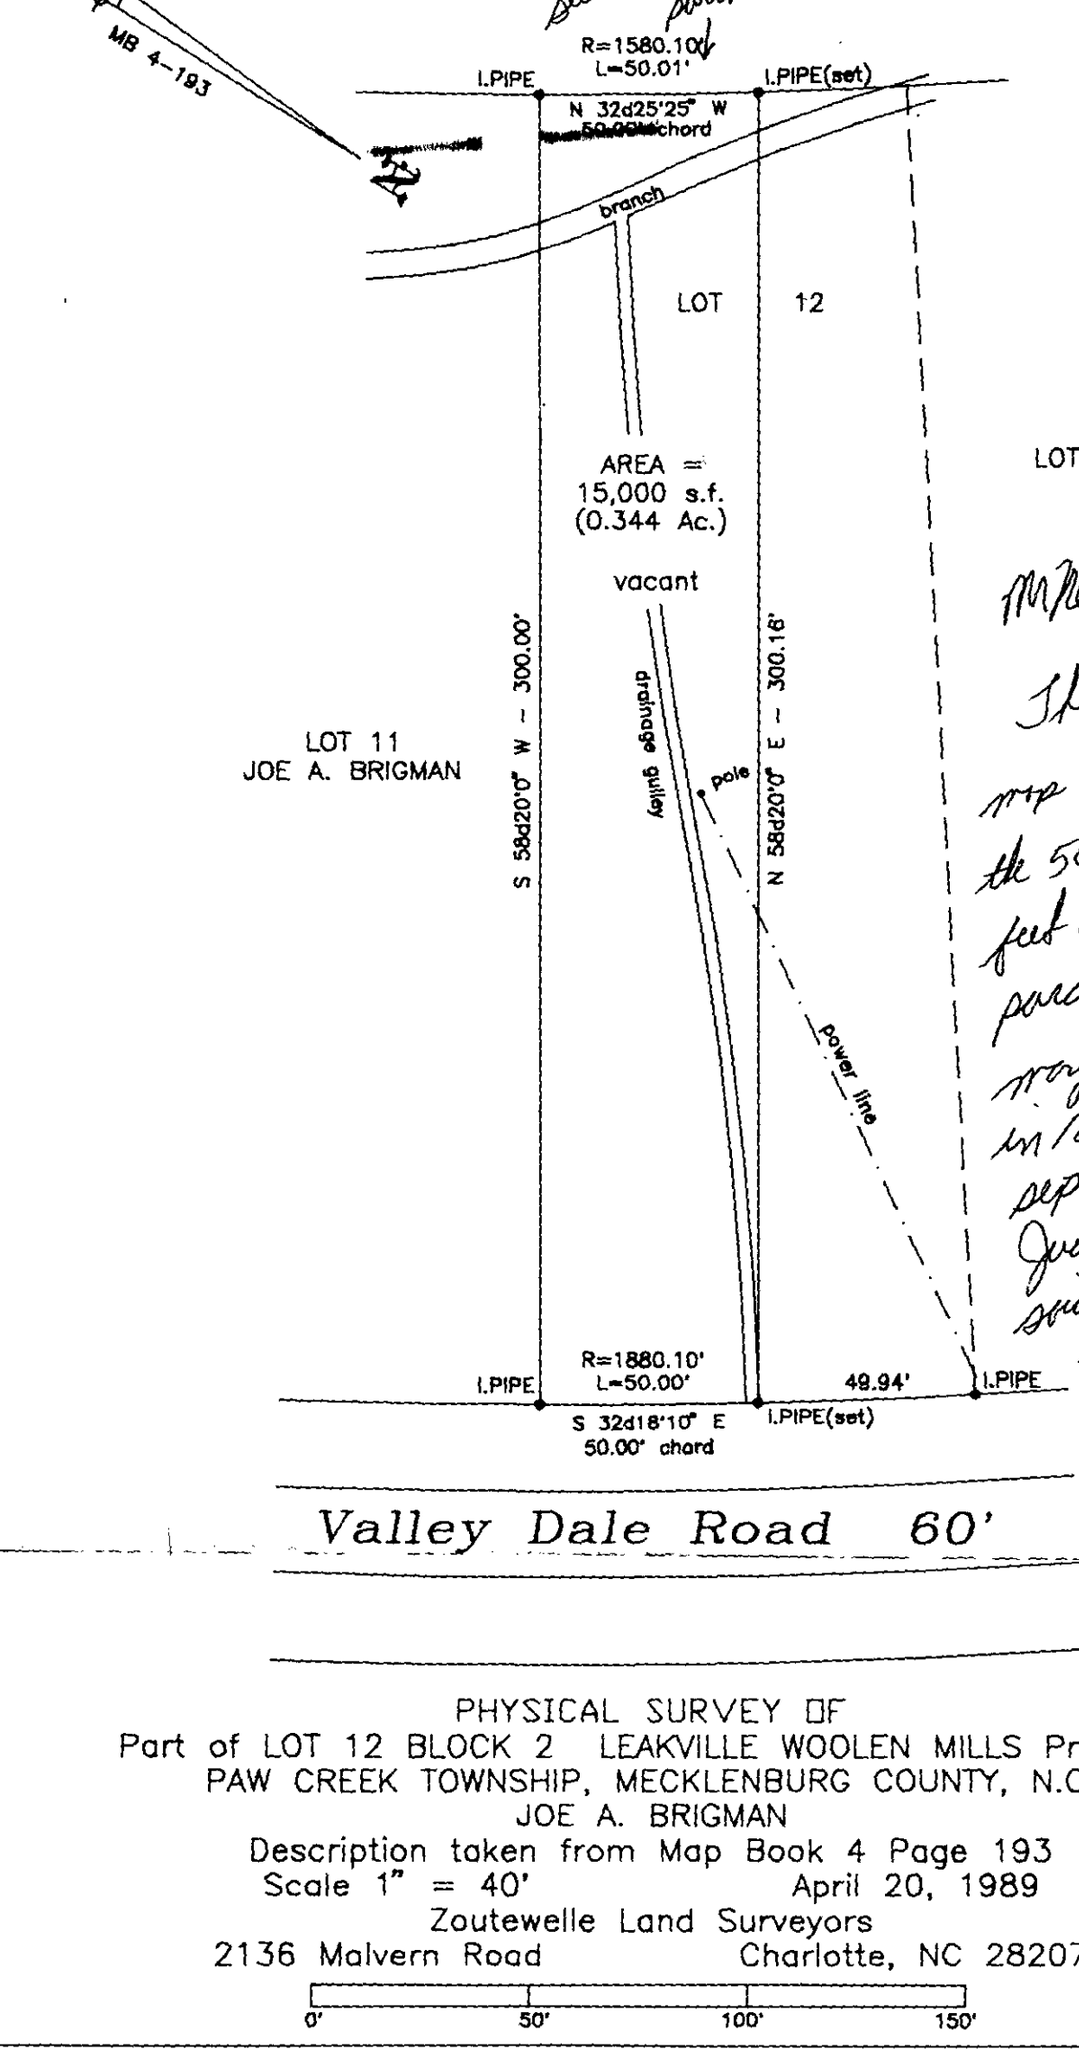

Mr Ellis,

This is a map showing the 50 additional feet I recently purchased that may be used in running septic lines. Judy Kaiser said you would need a copy.

Thanks,

Joe Brigman

PHYSICAL SURVEY OF
Part of LOT 12 BLOCK 2 LEAKVILLE WOOLEN MILLS Property
PAW CREEK TOWNSHIP, MECKLENBURG COUNTY, N.C.
JOE A. BRIGMAN
Description taken from Map Book 4 Page 193
Scale 1" = 40' April 20, 1989
Zoutewelle Land Surveyors
2136 Malvern Road Charlotte, NC 28207

0' 50' 100' 150'

INSTALLATION, CONSTRUCTION, ALTERATION, AND/OR REPAIR PERMIT


MECKLENBURG COUNTY ENVIRONMENTAL HEALTH
1200 BLYTHE BOULEVARD
CHARLOTTE, NC 28203
PHONE (704) 376-4603

FILE: 4303A DATE: 6/29/88

TC: 031-011-16 ☐ L

SERIAL № 11999

Permission is hereby given to ____ Install or Construct, ✓ Alter or Repair the individual septic tank wastewater treatment system with subsurface, soil absorption, effluent discharge as specified herein at the described location. This permit is granted based upon the information supplied in the application dated 2/23/88. All work shall be completed on or before 8/29/88, after which date this permit shall be null and void. The system shall meet all of the construction requirements of 10 NCAC 10A .1900 which are in effect on the date of the granting of this permit. A Certificate of Completion or an Operation Permit must be obtained from the Mecklenburg County Department of Environmental Health before any system can be covered up or placed into service. The issuance of this permit does not in any way guarantee that the system anticipated to be constructed will operate properly, or relieve any person now or hereafter owning, controlling or using such system from any liability resulting from the failure of the system to operate properly.

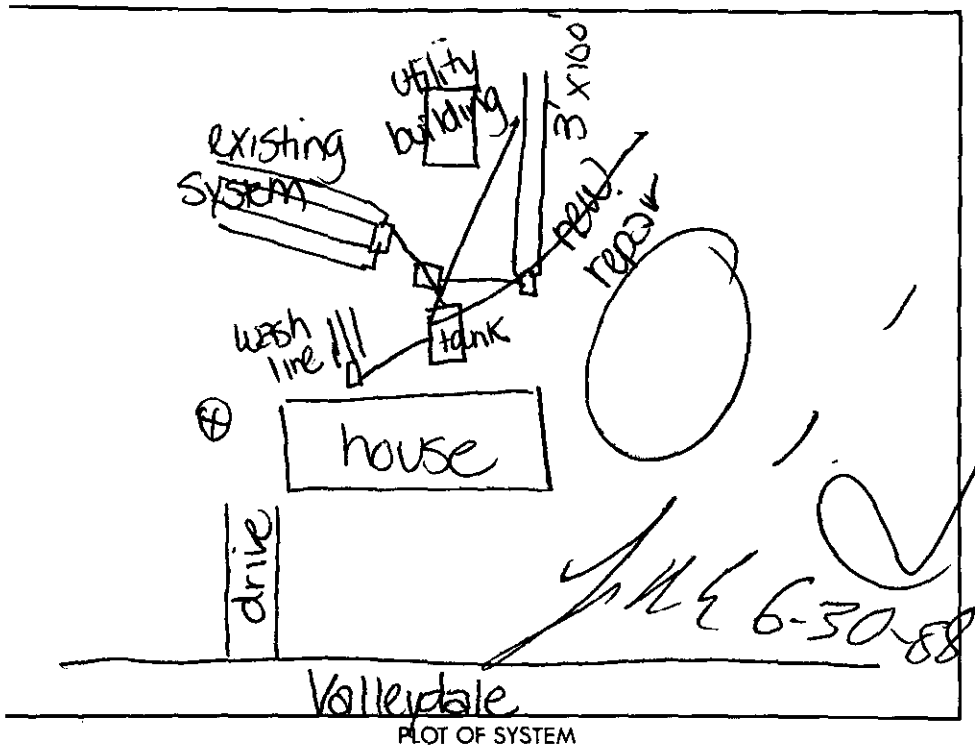

PLOT OF SYSTEM

Repair

Liquid Capacity of Septic Tank ____ gallons

Liquid Capacity of Dosing Tank ____ gallons

Tank Construction ____

Absorption and/or Nitrification Lines:

Trench Width 3 feet

Total Line Length 200 feet

Number of Lines 2

Depth of Stone 12 inches

Distance from House >5 feet

Distance from Property Line >10 feet

Distance from Well >50 feet

NAME OF OWNER Joe Brigman

LOCATION OF PROPERTY 417 Valleydale Rd

Comments: 2 trenches 3' x 100' x 12" stone; Straw Cover tie washing machine line into septic tank; set new distribution box to feed new repair and existing system evenly.

Division or Section Head

Environmentalist Darlene Johnson RS

* If this permit is for the installation or construction of a new system, it must be signed by the division or a section head of the Department of Environmental Health in order to be valid. Only the signature of the Environmentalist is required where an existing system is being altered or repaired.

WHITE - ENVIRONMENTAL HEALTH DEPARTMENT'S COPY ● CANARY - ENVIRONMENTALIST'S COPY ● PINK - OWNER OR AGENTS COPY

INSTALLATION, CONSTRUCTION, ALTERATION, AND/OR REPAIR PERMIT

MECKLENBURG COUNTY · ENVIRONMENTAL HEALTH


1200 BLYTHE BOULEVARD
CHARLOTTE, NC 28203
PHONE (704) 376-4603

FILE: 4303-A DATE: 3-28-88

TC: 031-011-16 ☐ L

SERIAL № 11725

Permission is hereby given to ____ Install or Construct, ✓ Alter or Repair the individual septic tank wastewater treatment system with subsurface, soil absorption, effluent discharge as specified herein at the described location. This permit is granted based upon the information supplied in the application dated 2-23-88. All work shall be completed on or before 4-20-88, after which date this permit shall be null and void. The system shall meet all of the construction requirements of 10 NCAC 10A .1900 which are in effect on the date of the granting of this permit. A Certificate of Completion or an Operation Permit must be obtained from the Mecklenburg County Department of Environmental Health before any system can be covered up or placed into service. The issuance of this permit does not in any way guarantee that the system anticipated to be constructed will operate properly, or relieve any person now or hereafter owning, controlling or using such system from any liability resulting from the failure of the system to operate properly.

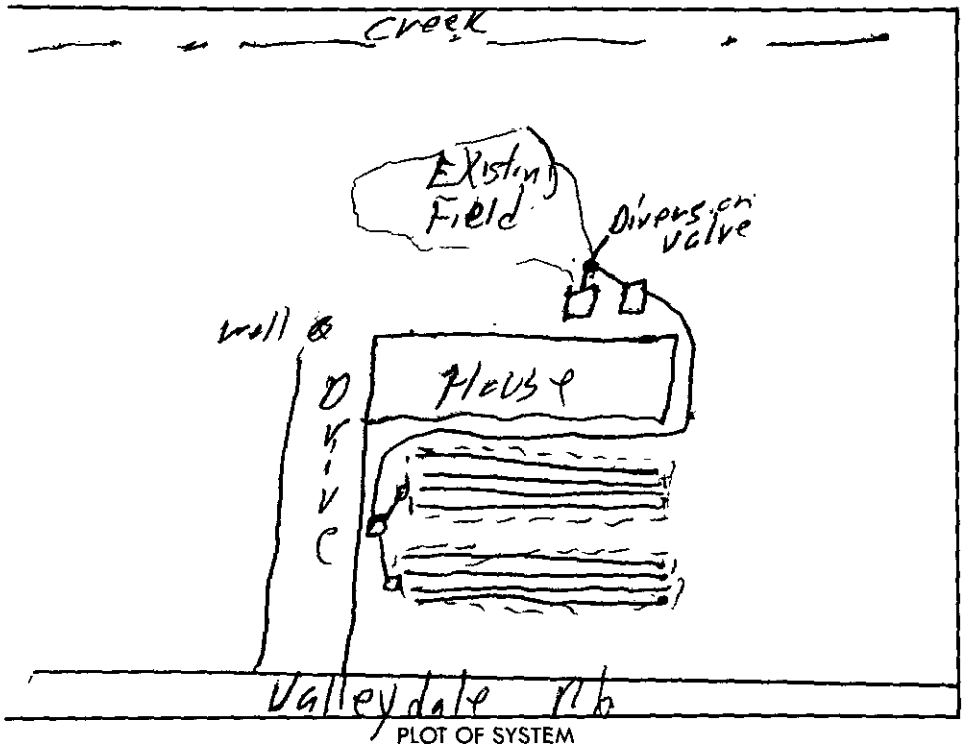

PLOT OF SYSTEM

Liquid Capacity of Septic Tank 1000 gallons

Liquid Capacity of Dosing Tank 1000 gallons

Tank Construction PCC

Absorption and/or Nitrification Lines:

Trench Width 12 feet

Total Line Length 480' feet

Number of Lines 8

Depth of Stone 12 inches

Distance from House 5 feet

Distance from Property Line 105' feet

Distance from Well 750' feet

NAME OF OWNER Joe Brikman

LOCATION OF PROPERTY 417 Valleydale Rd.

Comments: Two Beds 60'X12'X12" stone; 1000 l.f Stitch connected to existing Septic Tank, connect washing machine into Septic Tank install diversion valve to cut off old System

Jim Ennis
Division or Section Head


Jim Ennis
Environmentalist

* If this permit is for the installation or construction of a new system it must be signed by the division or a section head of the Department of Environmental Health in order to be valid. Only the signature of the Environmentalist is required where an existing system is being altered or repaired.

WHITE - ENVIRONMENTAL HEALTH DEPARTMENT'S COPY ● CANARY - ENVIRONMENTALIST'S COPY ● PINK - OWNER OR AGENTS COPY

4303A

The Front Yard is Worse That Back Yard. The First Two Feet is Clay Loam - Keep Lines Shallow, NO Need Trying To Divert Surface Water For it Will Flow Right Through The 1st Two Feet.

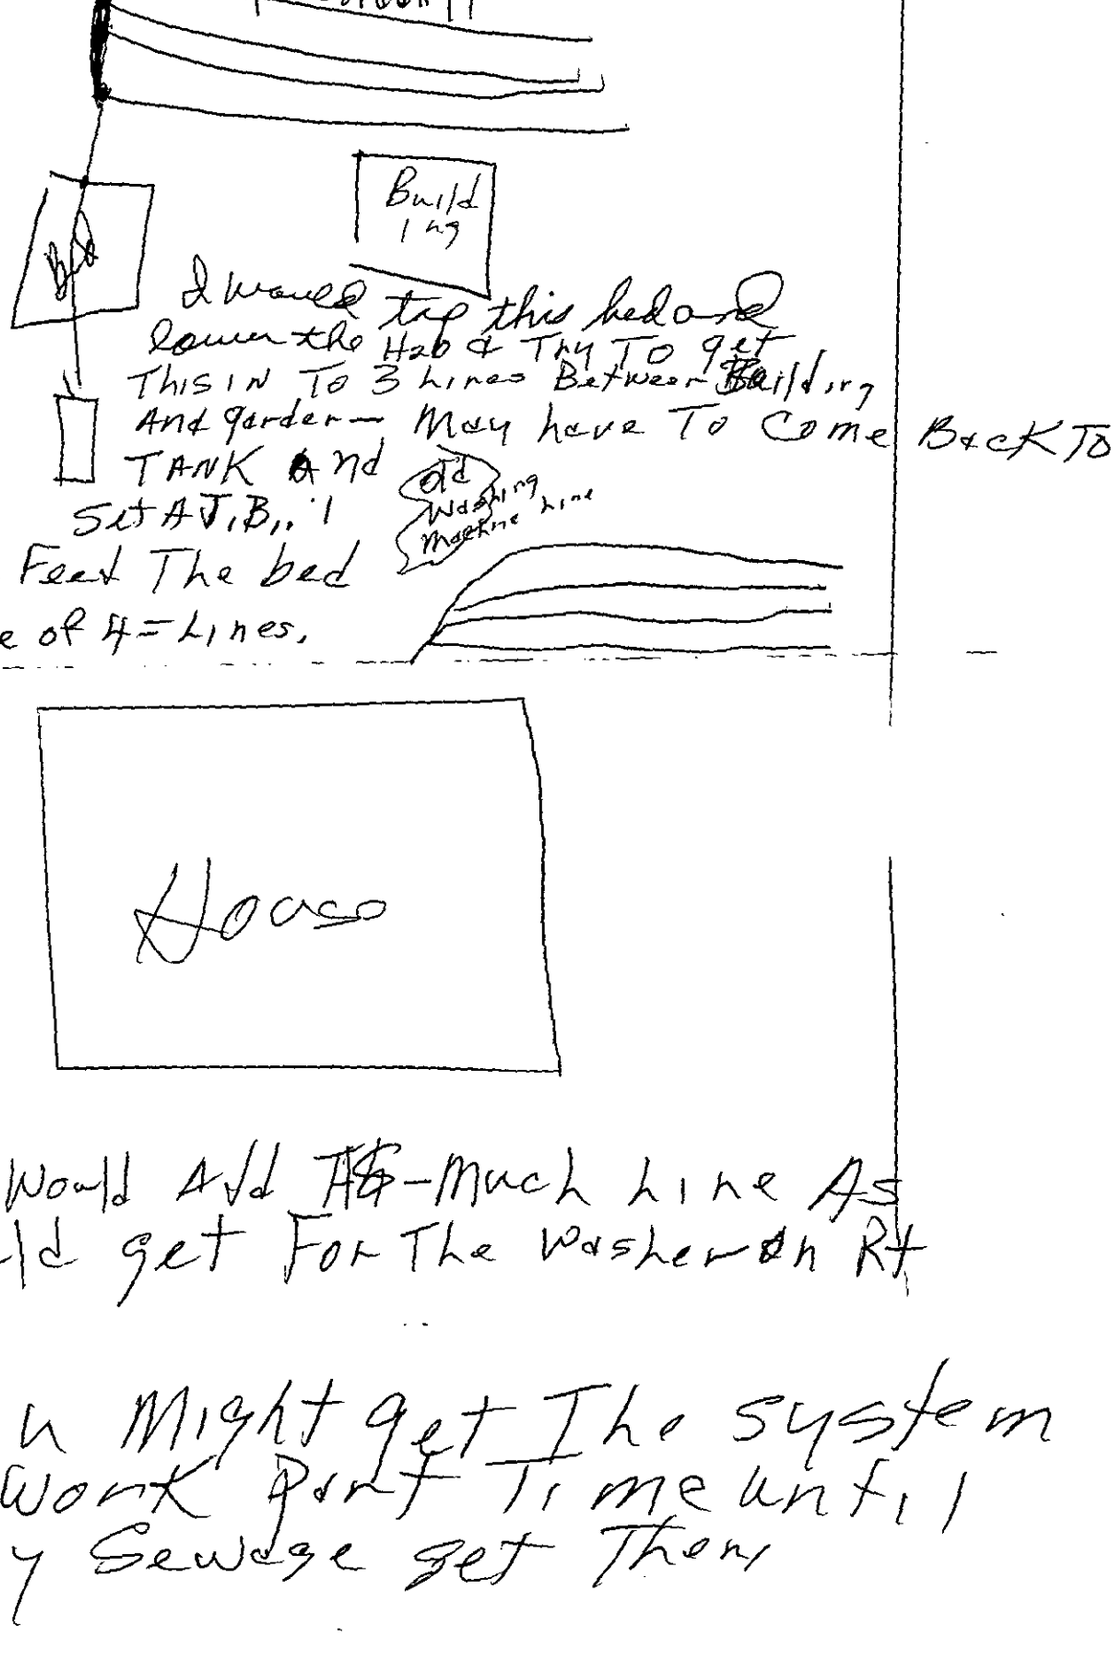

I Would Add As-Much Line As I Could get For The Washer on Rt

You Might get The System To Work Part Time until City Sewage get There

APPLICATION FOR AN IMPROVEMENT PERMIT

1200 BLYTHE BOULEVARD
CHARLOTTE, NC 28203
PHONE (704) 376-4603

Mecklenburg County services are available without regard to ethnic origin, sex, or disability.

(OFFICE USE ONLY)
FILE: 4303A
TC: 031-011-16
SERIAL: Nº 15564 ☐ L ☐ CRT

JOB LOCATION

① ADDRESS: 417 (STREET NO.) Valleydale Rd (STREET) ② FILE:
③ JURISDICTION: Mecklenburg Co. ④ TAX PARCEL NO.:
⑤ SUBDIVISION: Paw Creek ⑥ LOT: 11 ⑦ BLOCK: 2

OWNER

⑧ NAME: Joe (FIRST) Allen (MIDDLE) Brigman (LAST)
⑨ MAILING ADDRESS: 417 Valleydale Rd
⑩ CITY: Charlotte ⑪ STATE: N.C. ⑫ ZIP: 28214
⑬ PHONE: (WORK) 523-5910 ⑭ (HOME) 392-6020

REQUEST

This request is for a(n):

⑮ ☐ New permit
⑯ ☑ Repair or alteration permit
⑰ ☐ Authorization for mobile home exchange
⑱ ☐ Other (specify)

DESIGN CRITERIA

System will serve:

⑲ ☑ Residence ⑳ ☐ Mobile home
㉑ ☐ Business or place of public assembly
㉒ Number of bedrooms? 3
㉕ Type?
㉓ Maximum occupancy? 5
㉖ Maximum number of employees?
㉔ Basement? ☐ yes ☑ no
㉗ Maximum number of seats?

WATER SUPPLY

㉘ Water supply from (present or proposed):

A ☑ Individual well
B ☐ Municipal system
C ☐ Community well
D ☐ Community system

㉙ The undersigned, owner of the property described above as the "JOB LOCATION" has read the foregoing application, acknowledges that the contents of same are true, and authorizes agents of the MECKLENBURG COUNTY DEPARTMENT OF ENVIRONMENTAL HEALTH to enter onto the property for the purpose of processing this request.

Signed: Joe A. Brigman
Date: 2-23-88

IMPROVEMENT PERMIT

The undersigned, an authorized agent of the MECKLENBURG COUNTY DEPARTMENT OF ENVIRONMENTAL HEALTH, certifies that the Department has approved the Request for the Job Location contained in this document. This approval is granted in accordance with the provisions of Laws And Rules For Sanitary Sewage Collection, Treatment And Disposal in effect at the time of issuance of the permit and is subject to the following provisions:

. . . No work shall be conducted on the septic tank system until an Installation, Construction, Alteration and/or Repair permit is issued by this Department.

. . . This permit is not transferable, and shall become null and void 36 months from the date of issuance.

Environmentalist / Date

Director or Authorized Section Head / Date

*This permit must be signed by the Director of Environmental Health or an authorized section head in order to be valid.