Date Received 3/13/78

ICAR(S) Application No. P.C. No. 043-09204


Map Date

MECKLENBURG COUNTY
DEPARTMENT OF ENVIRONMENTAL HEALTH

Application for an
Installation, Construction, Alteration, and/or Repair Permit
(Individual Septic Tank System with Subsurface, Soil Absorption, Effluent Discharge)

The owner of that property described hereinafter hereby applies to the Mecklenburg County Department of Environmental Health for a permit to:

1) Install or Construct 2 N/A Alter or Repair Use existing System an individual septic tank wastewater treatment system with a subsurface, soil absorption, effluent discharge.

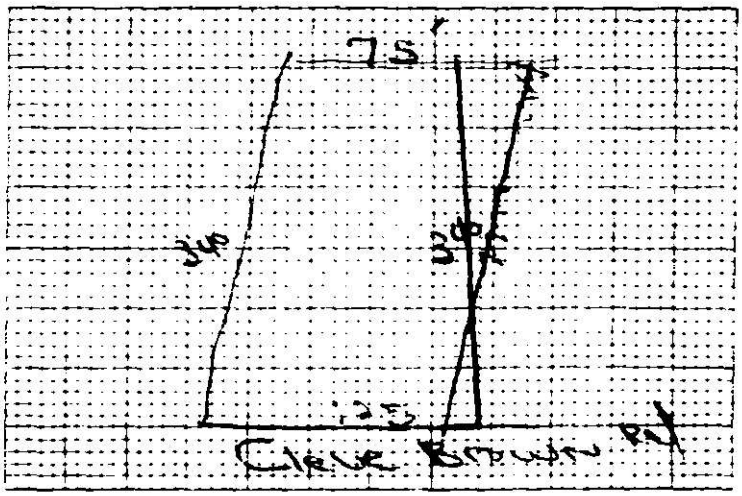

3) PLOT PLAN (ACCURATELY DIMENSIONED)

Mobile Home X Yes No
Residence Yes No
4 No. of Bedrooms 3
5 Business Use — Max No. Employees
6 Washing Machine Yes No
7 Garbage Disposal Yes X No
8 Dishwasher Yes X No
9) Water Supply
A) Individual well X
B) Governmental System
C) Community System
1 Well source
2 Governmental source
10 Sewage System
House located within 200 feet of public sewer Yes X No
House located within 200 feet of community sewer Yes X No
11) FHA Case No.
12 VA Case No.

13) NAME OF OWNER Brown (LAST) L (FIRST) R (MIDDLE)

14) ADDRESS OF OWNER Rt 7 Box 499 Charlotte

15) PHONE NO. Home 596-2397 Office

16) LOCATION OF SYSTEM Clarke Brown Rd. (STREET OR COUNTY ROAD)

17) SUBDIVISION Lot No. Block No.

Map Book No. Page No.

18) DEED REFERENCE — DEED BOOK AT PAGE

19) HAS A SOIL INVESTIGATION BEEN RUN? YES NO DATE RUN

20) PTR NUMBER (See Instructions)

The undersigned person hereby agrees that he has read the foregoing application and that the contents of same are true. It is understood that any permit applied for herein shall be void and of no effect if any of the above facts are not true.

DATE OF APPLICATION

L. R. Brown
OWNER

EHD-5-76

Environmental Health Department's Copy

Date Issued 3/14/78

Serial No. 1615

LA No. _____

T. C. No. P.O. 043-092-04

Map Date -

MECKLENBURG COUNTY
DEPARTMENT OF ENVIRONMENTAL HEALTH

TO THE BUILDING INSPECTION DEPARTMENT

APPROVAL OF LOT FOR INSTALLATION OF AN INDIVIDUAL SEPTIC TANK WITH SUBSURFACE, SOIL ABSORPTION, EFFLUENT DISCHARGE

NAME OF OWNER Brown (LAST) L. (FIRST) R. (MIDDLE)

ADDRESS OF OWNER Route 7, Box 499, Charlotte, N. C. ZIP _____

LOCATION OF LOT Cleve Brown Road (STREET OR COUNTY ROAD)

SUBDIVISION _____ LOT NO. _____ BLOCK NO. _____

MAP BOOK NO. _____ PAGE NO. _____

The above specified lot is approved by the Mecklenburg County Department of Environmental Health for the installation of an individual septic tank system with subsurface, soil absorption, effluent discharge based on the soil investigation, on an on-site inspection of the said lot; and upon the information supplied in the "Application for an Installation, Construction, Alteration, and/or Repair Permit", number 13711 This approval is subject to the following terms and conditions:

1. That the nitrification field be installed, constructed, altered and/or repaired in the same area where the soil investigation was run.
2. That an "Installation, Construction, Alteration and/or Repair Permit" be issued and in full force and effect when the system is installed, constructed, altred, and/or repaired and that the system be installed in accordance with same

This approval may be revoked and the building inspection department requested to revoke any building permit(s) which have been issued to authorize construction on the said lot if at any time it is determined that any information contained in the "Application for an Installation, Construction, Alteration, and/or Repair Permit" is not correct or is untrue or that the septic-tank system is not being installed, constructed, altered and/or repaired in accordance with a valid Installation, Construction, Alteration, and/or Repair Permit

*May use existing system


J M Reynolds
Environmentalist

John R. Atkinson
Environmental Health Director, or Authorized Section Head

EHD-5-76

Environmental Health Department's Copy

NOTE: Make sketch of installation showing location of house, septic tanks, privies, water supplies on adjacent property, etc. Write in measurements in order that installations may be located at later date.

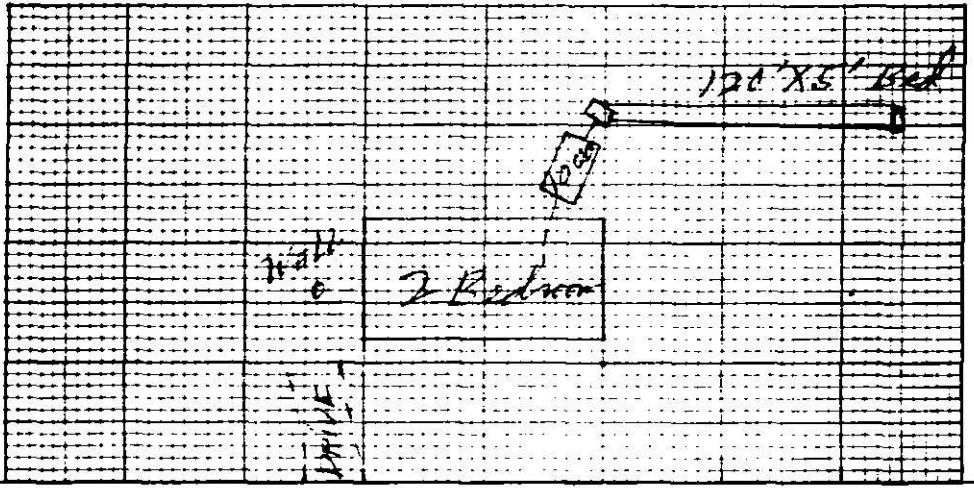

Rd. # 2456

LOCATION Mich OWNER G. C. Brown WHITE ✓ COLORED _____

ADDRESS Rt # 2486 OCCUPANT Same WHITE ✓ COLORED _____

Off Hwy #15 & Henderson-Gra Rd.

PRIVY:

Type — wood / concrete

Number

New — date

Repaired — date

WATER SUPPLY:

Source Well

If well, type

_____ (Bored)

✓ (Drilled)

_____ (Dug)

Distance from nearest pollution 60 ft.

SEPTIC TANK:

Material Precast

Dimensions 1000 gal

Volume 1000 gal

Type secondary treatment Rock — nitrification line / filter trench

No. of bedrooms 2

Permit Number 2651 Date 8-9-63

Approved Yes Date 8-9-63

Approved by W. F. Hensley

Contractor or Plumber Lowe Const. Co.

Address Louisburg, N. C.

Remarks Good Soil

FHA CASE NUMBER _____

VA CASE NUMBER _____

SEWAGE DISPOSAL RECORD

Form No. 473 (Rev. 8/58)