C of A (s) No. 9988

Serial 3340

T C No 213-021-21

Date Issued 13 Dec 79

MECKLENBURG COUNTY
DEPARTMENT OF ENVIRONMENTAL HEALTH
ENVIRONMENTAL HEALTH DIVISION

CERTIFICATE OF APPROVAL
(Individual Septic Tank System with Subsurface, Soil Absorption, Effluent Discharge)

Name of Owner Wiltbank (LAST) Thomas (FIRST) (MIDDLE)

Location of Property 301 Charing Cross Dr

Permit Number 9988

Application Number

Inspection Data:

Liquid Capacity of Tank 1500 gal

Total Length of Drain Tile 495' & 125'

Depth of Filter Material 17"

Water Supply Source Well

Excavation Inspected (DATE)

Nitrification Field Inspected 13 Dec (DATE)

Washing Machine Disposal Inspected If Applicable 13 Dec (DATE)

Tank Material P.C Conc

Number of Lines 5 & 4

Cover Depth 18"

Distance from Water Source to be 100'

Tank Inspected 13 Dec (DATE)

The undersigned has inspected the Individual Septic Tank System with subsurface, soil absorption of effluent discharge described above and it has been installed / constructed in accordance with the permit issued and the regulations of the Mecklenburg County Board of Health Commissioners in effect on the date of issuance of the permit. The issuance of this Certificate of Approval does not in any way guarantee that the system will operate properly or relieve any person now or hereafter owning, controlling, or using such system from any liability resulting from the failure of the system to operate properly. This Certificate of Approval is issued subject to those restrictions and conditions shown in the permit in addition to those listed below under comments. This Certificate of Approval shall be null and void if any information contained in the application is untrue or if any additions are made to the property which would increase the requirements for said system.

Comments Oaks

Environmentalist

EHD-5-76

Environmental Health Department's Copy

Serial 3504

Date Issued 12 Dec 79


ICAR(S) Permit No. 9988

T. C. No. 213-021-21

Map Date _____

MECKLENBURG COUNTY
DEPARTMENT OF ENVIRONMENTAL HEALTH
INSTALLATION, CONSTUCTION, ALTERATION, AND/OR REPAIR PERMIT
(Individual Septic Tank System with Subsurface, Soil Absorption, Effluent Discharge)

Permission is hereby given to ✓ Install or Construct ____ Alter or Repair the individual septic tank wastewater treatment system with subsurface soil absorption effluent discharge as specified herein at the described location. This permit is granted based upon the information supplied in application 9988 dated 5/15/79 and this permit may be void and of no effect if the information provided in the application is not true and correct. All work shall be completed on or before 12 June 80, after which date this permit shall be null and void.

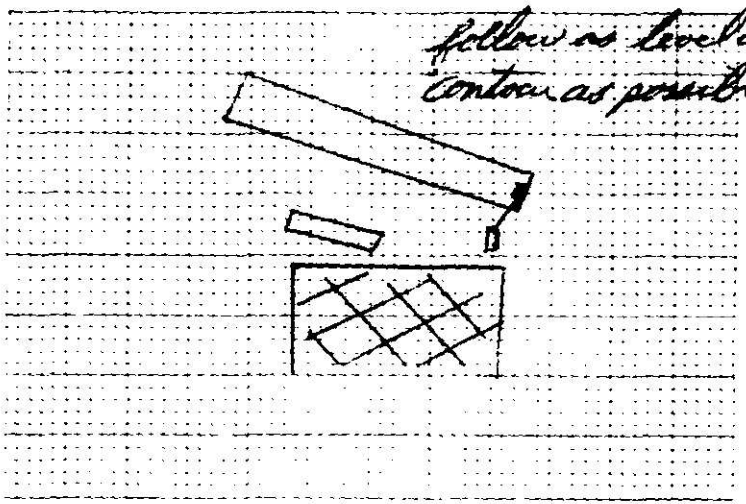

Permeability Rate: P.S.

Liquid Capacity of Tank: 1500 gal

Tank Construction: P.C. conc

Absorption and/or Nitrification Line

Total Line Length: 495' & 125'

Number of Lines: 5 & 4

Distance from Structures: 10'

Distance from Property Lines: 10'

Distance from Well: 100' - to be

Plot Plan of System

NAME OF OWNER: Thomas Wittbank

LOCATION OF PROPERTY: 301 Charing Cross Dr

The system shall meet all of the construction requirements as set forth in the Regulations of the Mecklenburg County Health Commission which are in effect on the date of the granting of this permit. A certificate of approval must be issued by the Environmental Health Director before any system can be covered up or otherwise rendered uninspectable or can be used. The issuance of this permit does not in any way guarantee that the system anticipated to be constructed will operate properly, or relieve any person now or hereafter owning, controlling or using such system from any liability resulting from the failure of the system to operate properly.

(15' x 99' x 17" stone)
12' x 32'

Division or Section Head

Steve Wood
Environmentalist

* If this permit is for the installation or construction of a new system, it must be signed by the division or a section head of the Department of Environmental Health in order to be valid. Only the signature of the Environmentalist is required where an existing system is being altered or repaired.

EHD-S-76

Environmental Health Department's Copy