


4300 ROCKY RIVER RD

10515317

1/8/2008

duponbj

Groundwater and Wastewater Services File Imaging Project
May 2007
*Barcode Font = IDAutomationHC39M*

Department of Environment, Health, and Natural Resources
Division of Environmental Health
On-site Wastewater Section

Sheet: 1
Property ID: PO 105-153-17
Lot #: 3
File #: 5360B
Code: 2

ACS

# SOIL/SITE EVALUATION for ON-SITE WASTEWATER SYSTEM

Owner: Joseph D. Prevette
Applicant: Darren Young
Address: 741 Romany Road, Charlotte, N. C. 28203
Date Evaluated: 09/15/2003
Proposed Facility: Residence
Design Flow (.1949): 360gpd
Property Size: .44a
Location of Site: Rocky River Road
Property Recorded:
Water Supply: [x] Public [ ] Individual [ ] Well [ ] Spring [ ] Other
Evaluation Method: [x] Auger Boring [ ] Pit [ ] Cut
Type of Wastewater: [x] Sewage [ ] Industrial Process [ ] Mixed

| PROFILE # | .1940 Landscape Position/ Slope% | Horizon Depth (IN.) | SOIL MORPHOLOGY .1941 .1941 Structure/ Texture | .1941 Consistence Mineralogy | OTHER PROFILE FACTORS .1942 Soil Wetness/ Color | .1943 Soil Depth (IN.) | .1956 Sapro Class | .1944 Restr Horiz | Profile Class & LTAR |
|---|---|---|---|---|---|---|---|---|---|
| 1 | LS, 8 | 0-10 | GR/SCL | FR/SEXP/SS/SP | >48" TO SOIL WETNESS | 48 | N/A | NONE | PS, IV .3GPD/FT$^2$ |
| | | 10-38 | SBK/C | FI/SEXP/S/P | | | | | |
| | | 38-48 | SBK/SCL | FR/SEXP/SS/SP | | | | | |
| 2 | " | 0-6 | GR/SL | FR/SEXP/NS/NP | 2.5y7/1@40" | " | " | " | PS, IV .25GPD/FT$^2$ |
| | | 6-11 | GR/SCL | FR/SEXP/SS/SP | | | | | |
| | | 11-48 | SBK/SC | FI/SEXP/S/P | | | | | |
| 3 | LS, 10 | 0-8 | GR/SCL | FR/SEXP/SS/SP | >48" TO SOIL WETNESS | " | " | " | PS, IV .3GPD/FT$^2$ |
| | | 8-44 | SBK/C | FI/SEXP/S/P | | | | | |
| | | 44-48 | SBK/SCL | FR/SEXP/SS/SP | | | | | |
| | | | | | | | | | |
| | | | | | | | | | |
| Description | Initial System | Repair System |
|---|---|---|
| Available Space (.1945) | PS | US |
| System Type(s) | | |
| Site LTAR | .275GPD/FT$^2$ | .275GPD/FT$^2$ |


Other Factors (.1946): _____
Site Classification (.1948): UNSUITABLE
Evaluated By: W. R. Marlin, LSS, 9/17/2003, W. R. Marlin
Others Present: D. Young


FILE # 5360B

## COMMENTS: 100% repair

| LANDSCAPE POSITIONS | GROUP | TEXTURES | .1955 LTAR | CONSISTENCE MOIST | WET |
|---|---|---|---|---|---|
| R-RIDGE | I | S-SAND | 1.2 - 0.8 | | |
| S-SHOULDER SLOPE | | LS-LOAMY SAND | | VFR-VERY FRIABLE | NS-NON-STICKY |
| L-LINEAR SLOPE | | | | FR-FRIABLE | SS-SLIGHTLY STICKY |
| FS-FOOT SLOPE | II | SL-SANDY LOAM | 0.8 – 0.6 | FI-FIRM | S-STICKY |
| N-NOSE SLOPE | | L-LOAM | | VFI-VERY FIRM | VS-VERY STICKY |
| H-HEAD SLOPE | | | | EFI-EXTREMELY FIRM | NP-NON-PLASTIC |
| CC-CONCLAVE SLOPE | III | SI-SILT- | 0.6 – 0.3 | | SP-SLIGHTLY STICKY |
| CV-CONVEX SLOPE | | SIL-SILT LOAM | | | P-PLASTIC |
| T-TERRACE | | CL-CLAY LOAM | | | VP-VERY PLASTIC |
| FP-FLOOD PLAN | | SCL-SANDY CLAY LOAM | | | |
| | | SICL-SILTY CLAY LOAM | | | |
| | IV | SIC-SILTY CLAY | 0.4 – 0.1 | | |
| | | C-CLAY | | | |
| | | SC-SANDY CLAY | | | |


| STRUCTURE | MINERALOGY |
|---|---|
| SG-SINGLE GRAIN | SLIGHTLY EXPANSIVE |
| M-MASSIVE | |
| CR-CRUMB | EXPANSIVE |
| GR-GRANULAR | |
| SBK-SUBANGULAR BLOCKY | |
| ABK-ANGULAR BLOCKY | |
| PL-PLATY | |
| PR-PRISMATIC | |

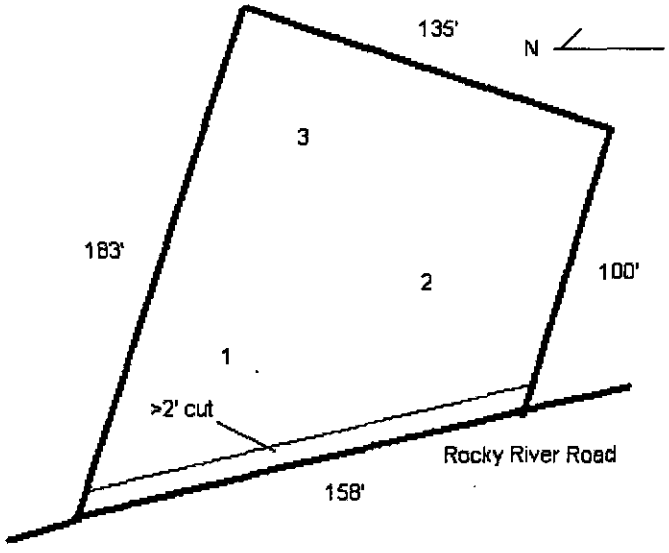

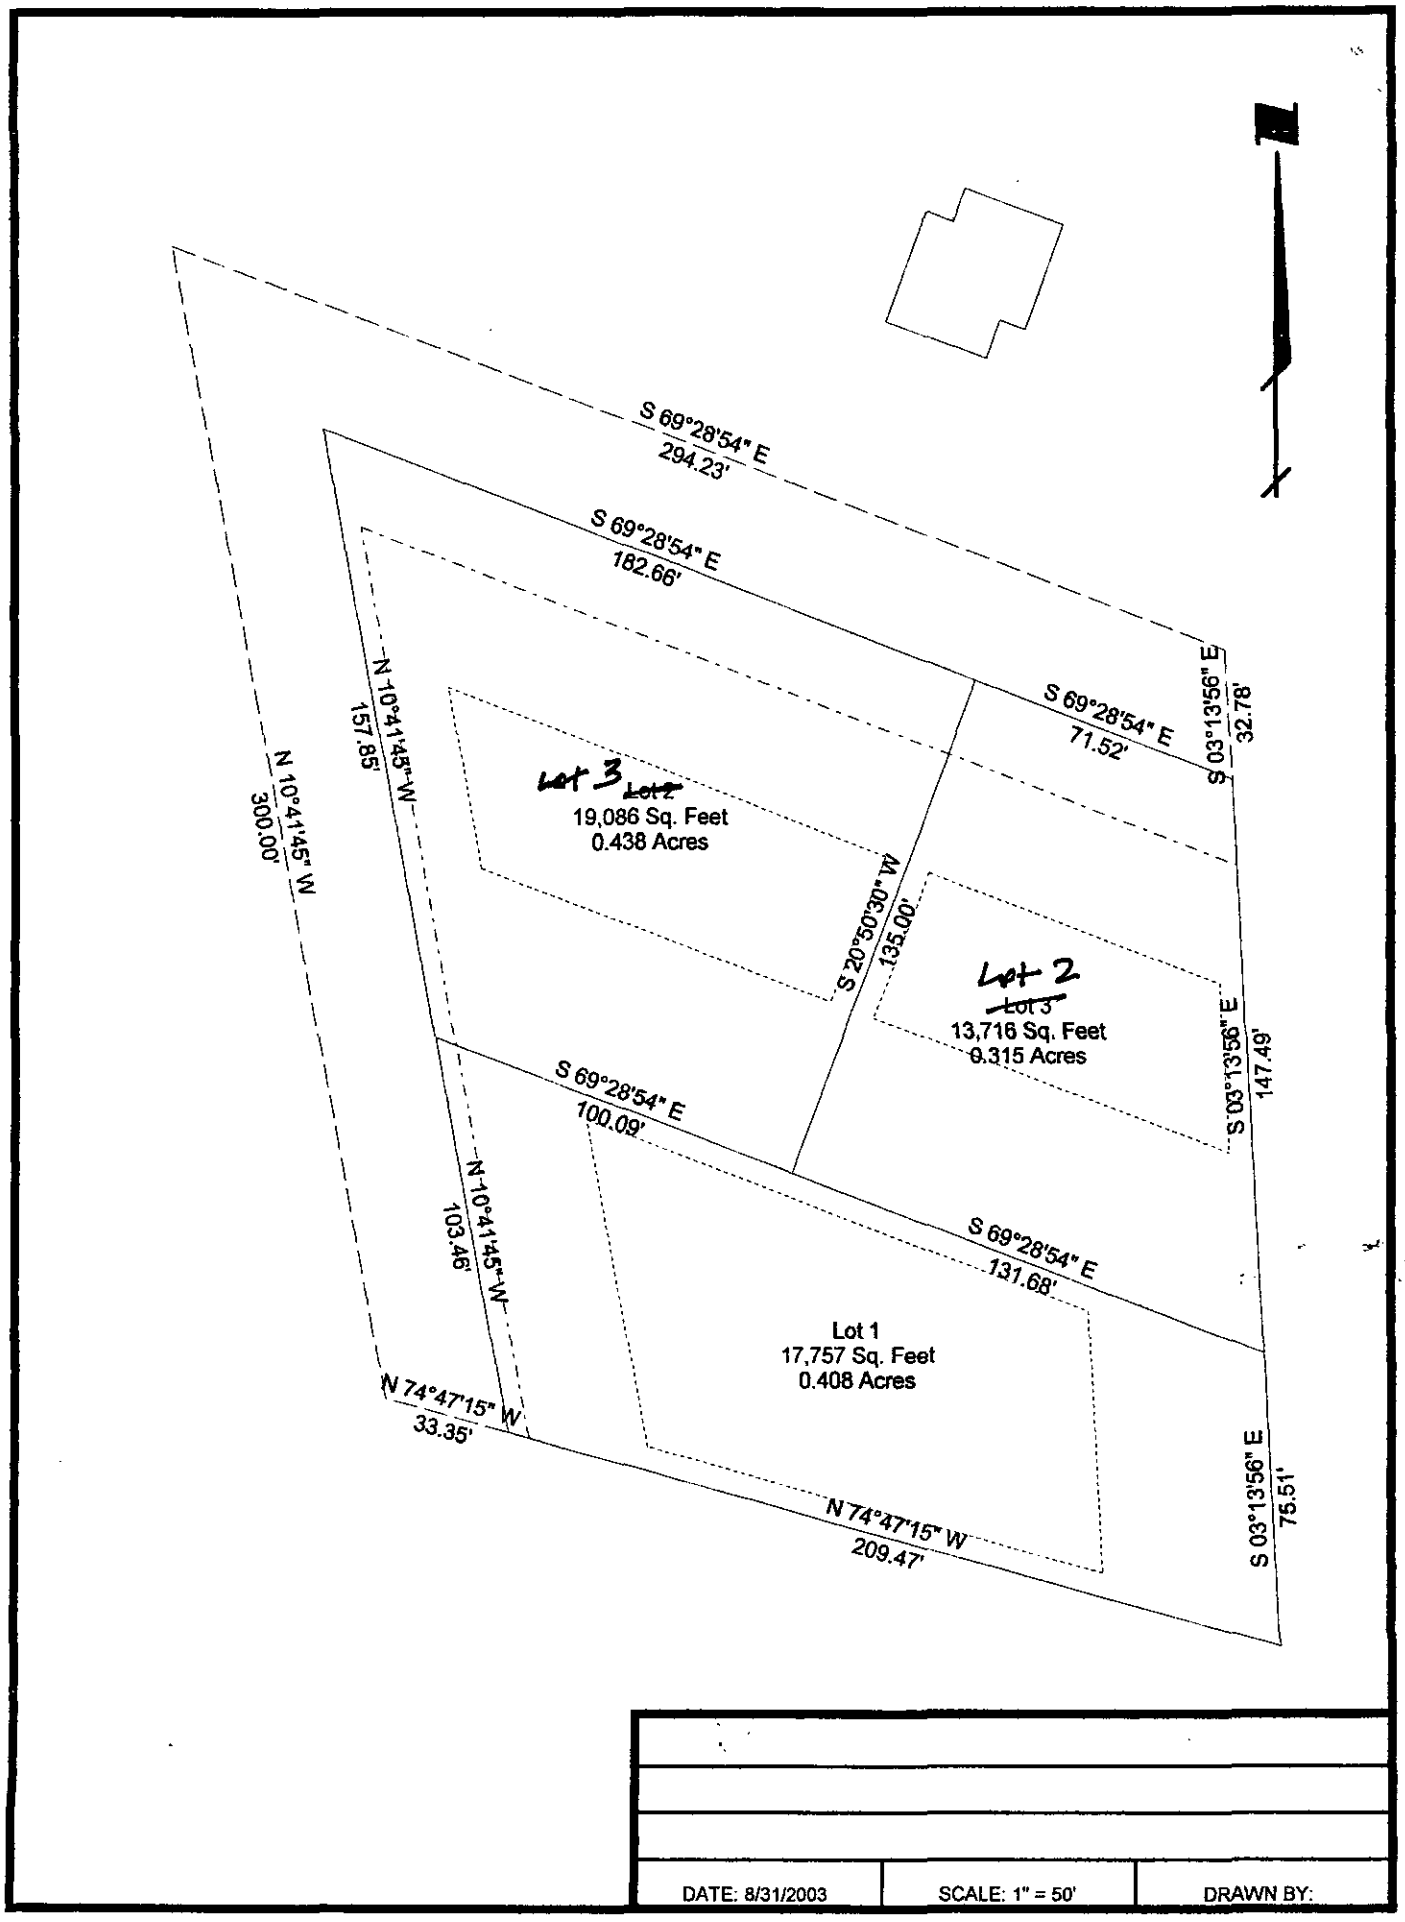


| | | |
|---|---|---|
| | | |
| | | |
| | | |
| DATE: 8/31/2003 | SCALE: 1" = 50' | DRAWN BY: |

Attn: Drew Walker

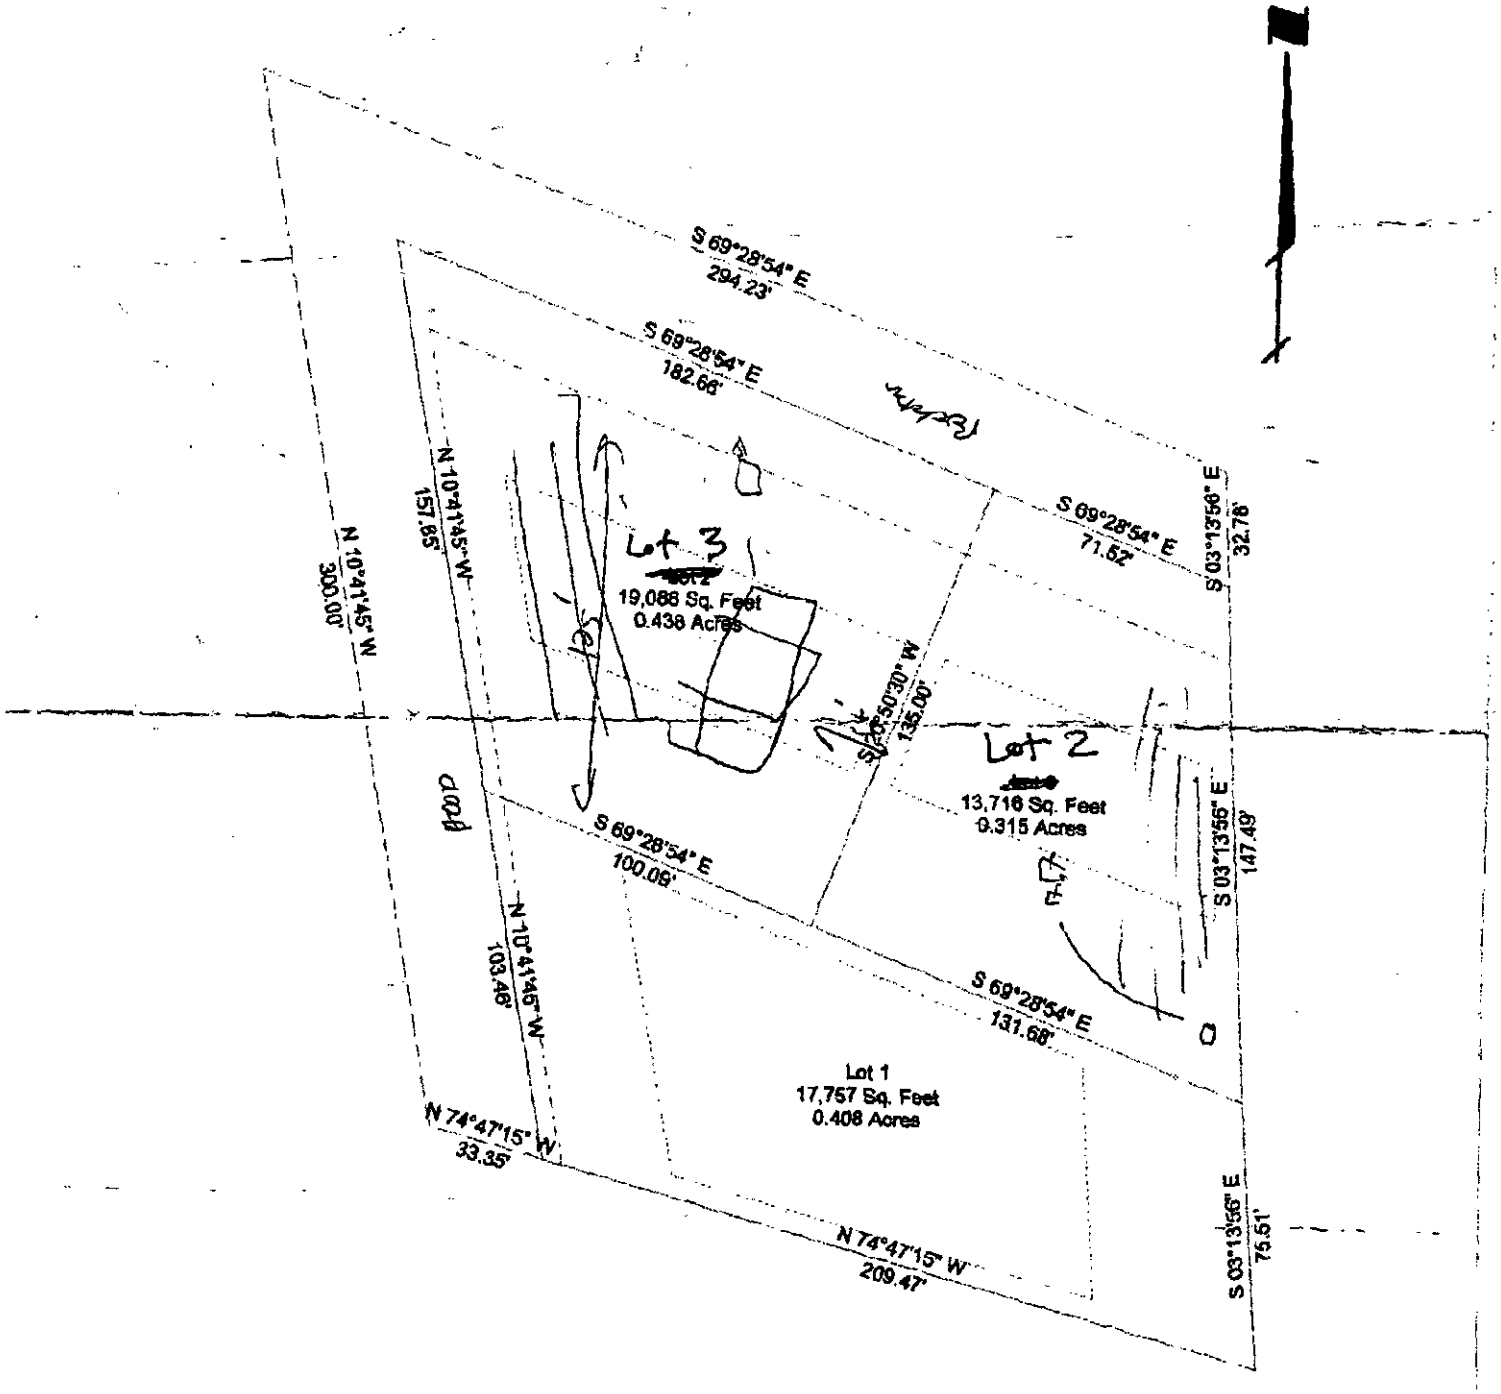

FEE: $200.00 + 3443

DATE: 8/27/03

**APPLICATION FOR IMPROVEMENT PERMIT FOR RESIDENTIAL SITE INDIVIDUAL WATER AND WASTEWATER SYSTEMS PROGRAM**

[ ] CRT

TYPE APPLICATION: ___ NEW SYSTEM ___ EXPANSION/ ALTERATION OF EXISTING SYSTEM ___ REPAIR OF EXISTING SYSTEM

NORTH CAROLINA
DEPARTMENT OF ENVIRONMENT,
HEALTH, AND NATURAL RESOURCES
DIVISION OF ENVIRONMENTAL HEALTH
ON-SITE WASTEWATER SECTION

FILE #: 5360B

PROPERTY INFORMATION (FROM ENGINEERING FORM) FOR JOB LOCATION:

TAX/PARCEL NUMBER: 10515317 (P.O.)

STREET ADDRESS: ~~4300~~ Rocky River Rd.

SUBDIVISION OR MOBILE HOME PARK NAME: ~~Lot 3~~

LOT NUMBER: Lot 3

TYPE OF BUILDING (CHECK ONE):

___ SINGLE MOBILE HOME(S)
___ DOUBLE WIDE (D)
✓ HOUSE (H)
___ MODULAR HOME (M)
___ MULTIPLE FAMILY (U)
___ OTHER (O)

HEATED SQUARE FOOTAGE: 1590

NUMBER OF BEDROOMS: 3 NUMBER OF OCCUPANTS: 2

FOUNDATION FOR RESIDENCE:

___ WITHOUT BASEMENT
✓ ON SLAB
___ CRAWL SPACE
___ WITH BASEMENT /PLUMBING
___ WITH BASEMENT /NO PLUMBING

TOWNSHIP (CHECK ONE):

✓ 0 MECKLENBURG
___ 1 CHARLOTTE
___ 2 DAVIDSON
___ 3 CORNELIUS
___ 4 PINEVILLE
___ 5 MATTHEWS
___ 6 HUNTERSVILLE
___ 7 MINT HILL

CLOSING DATE _____

IF EXPANSION/ALTERATION OF EXISTING SYSTEM, DESCRIBE THE PROPOSED BUILDING ADDITION:

WILL THERE BE A HOME BUSINESS IN THE RESIDENCE: ___ YES ✓ NO TYPE: _____

WATER SUPPLY (CHECK ONE):

___ COMMUNITY (C)
✓ MUNICIPAL (M)
___ PRIVATE WELL (P)
___ SHARED WELL (S)
___ OTHER 'SPRINGS' (O)

IF ANY OF THE FOLLOWING ARE LOCATED ON THE PROPERTY, PLEASE SHOW LOCATION ON PLAT:

BURIED CABLES, LANDFILLS, STUMPHOLES ___ YES ✓ NO
EXISTING WASTEWATER SYSTEMS ___ YES ✓ NO
EASTMENTS OR RIGHT-OF-WAYS ___ YES ✓ NO
WELL, SPRINGS OR WATERLINES ___ YES ✓ NO
DESIGNATED WETLANDS ___ YES ✓ NO

PROPERTY OWNER:

NAME: Provette Joseph Dean
(LAST) (FIRST) (MI)

ADDRESS: 241 Romany Rd

CITY: Charlotte STATE: NC ZIP: 28105

DAYTIME PHONE: ( ) ---

LEGAL AGENT FOR PROPERTY OWNER, IF APPLICABLE:

NAME: Young Darren M.
(LAST) (FIRST) (MI)

DAYTIME PHONE: ( ) 704-541-3000

WHAT DATE WAS THE PROPERTY ORIGINALLY DEEDED AND RECORDED? _____

An Improvement Permit is subject to suspension or revocation if site plans or the intended use change or if information submitted in this application is falsified or changed. The undersigned, owner, or legal agent for the owner, of the property described above as the "Job Location" has read the foregoing application, acknowledges that the contents of same are true, and authorizes agents of the Mecklenburg County Health Department to enter onto the property for the purpose of processing this request.

SIGNED: Darren M. Young DATE: 8-27-03

MECKLENBURG COUNTY HEALTH DEPARTMENT
ENVIRONMENTAL HEALTH DIVISION
c/o HAL MARSHALL CTR., SUITE 211, 700 N. TRYON ST., CHARLOTTE, N.C. 28202., (704) 336-5102


# PROPOSED PLOT PLAN

HEALTH DEPARTMENT
ENVIRONMENTAL HEALTH DIVISION
700 NORTH TRYON STREET
CHARLOTTE, NC 28202
PHONE (704) 336-5102

FILE: 5360B

TC: _____

Draw in and name all roads adjoining the property. Draw in and accurately dimension the lot concerned. Accurately indicate property boundaries proposed and/or existing structures and driveways, underground utilities, and wells and springs within 100 feet of the proposed building or drainfield.

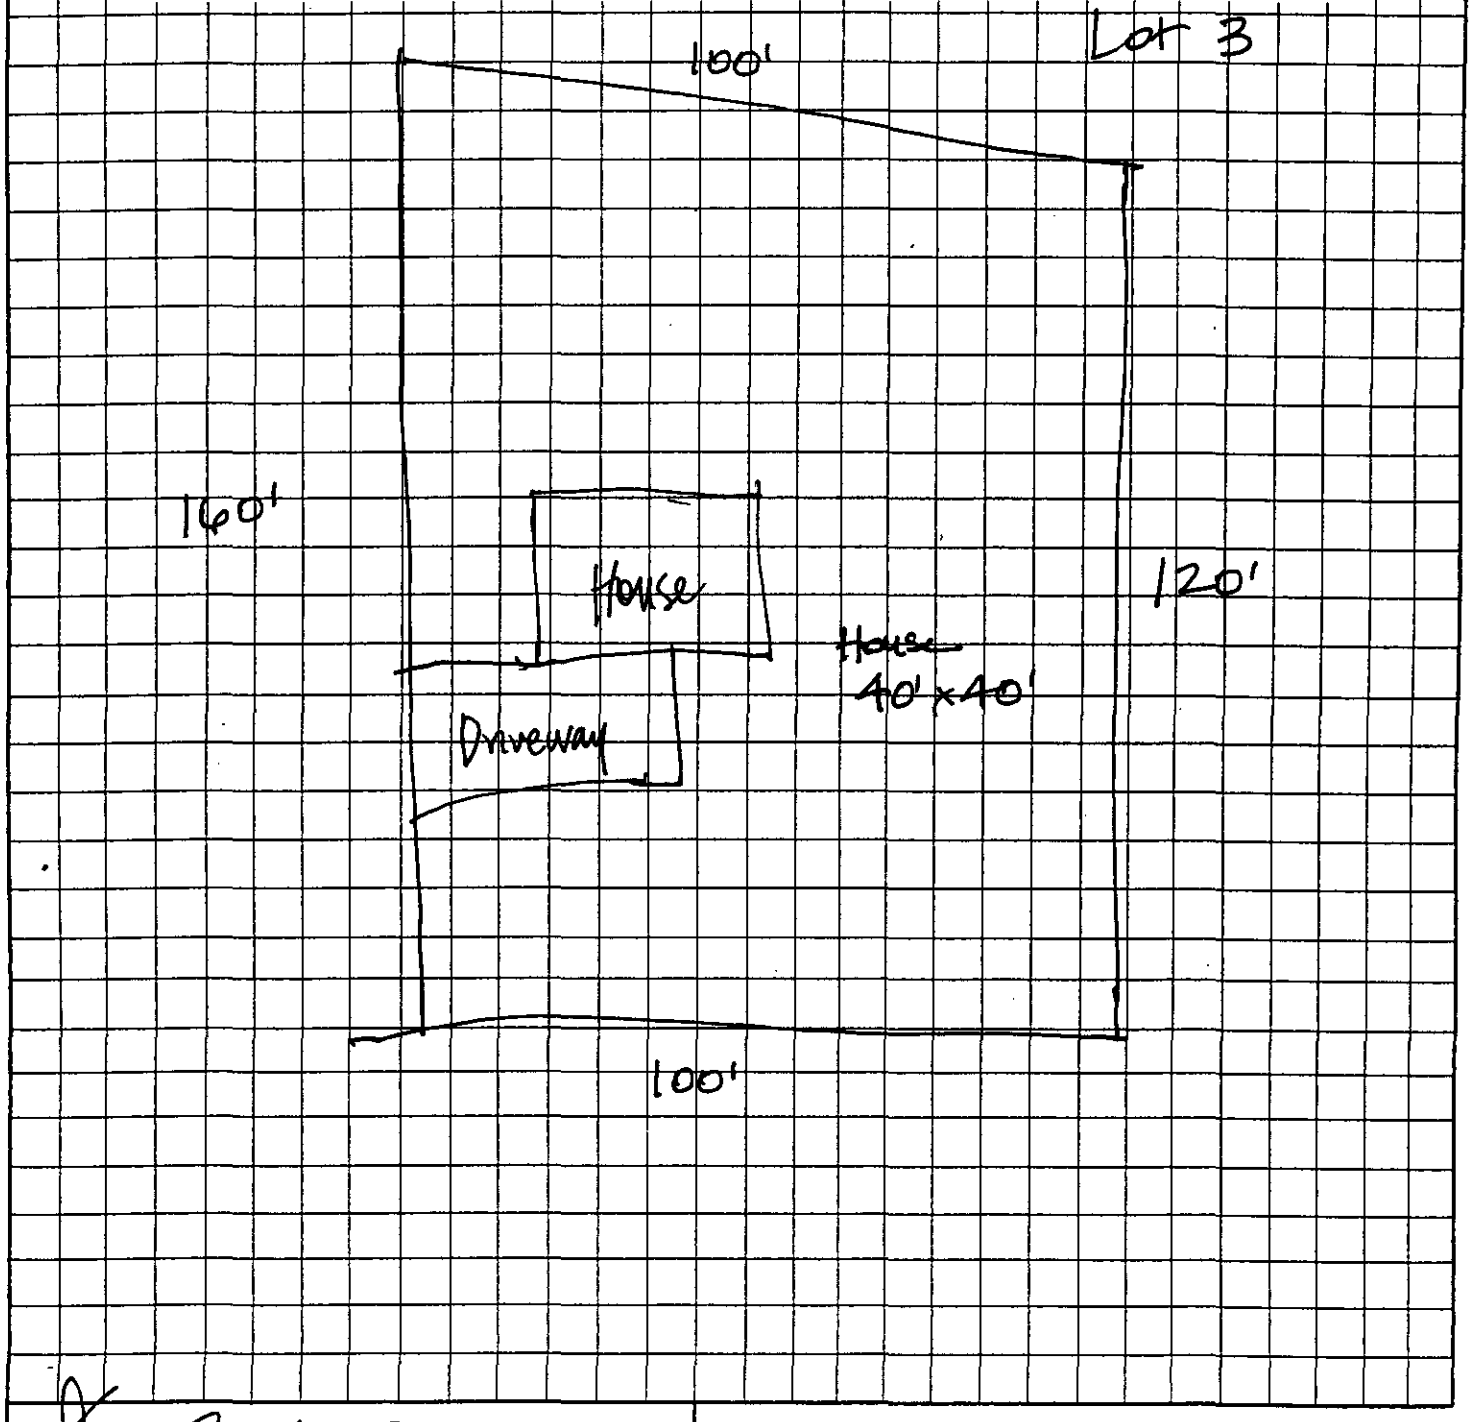



Dana Mahoney
OWNER/AGENT SIGNATURE

DATE 08-27-03

APPROVAL DATE _____

White - Health Department's Copy  Canary - E.H.S. Copy  Pink - Owner's Copy

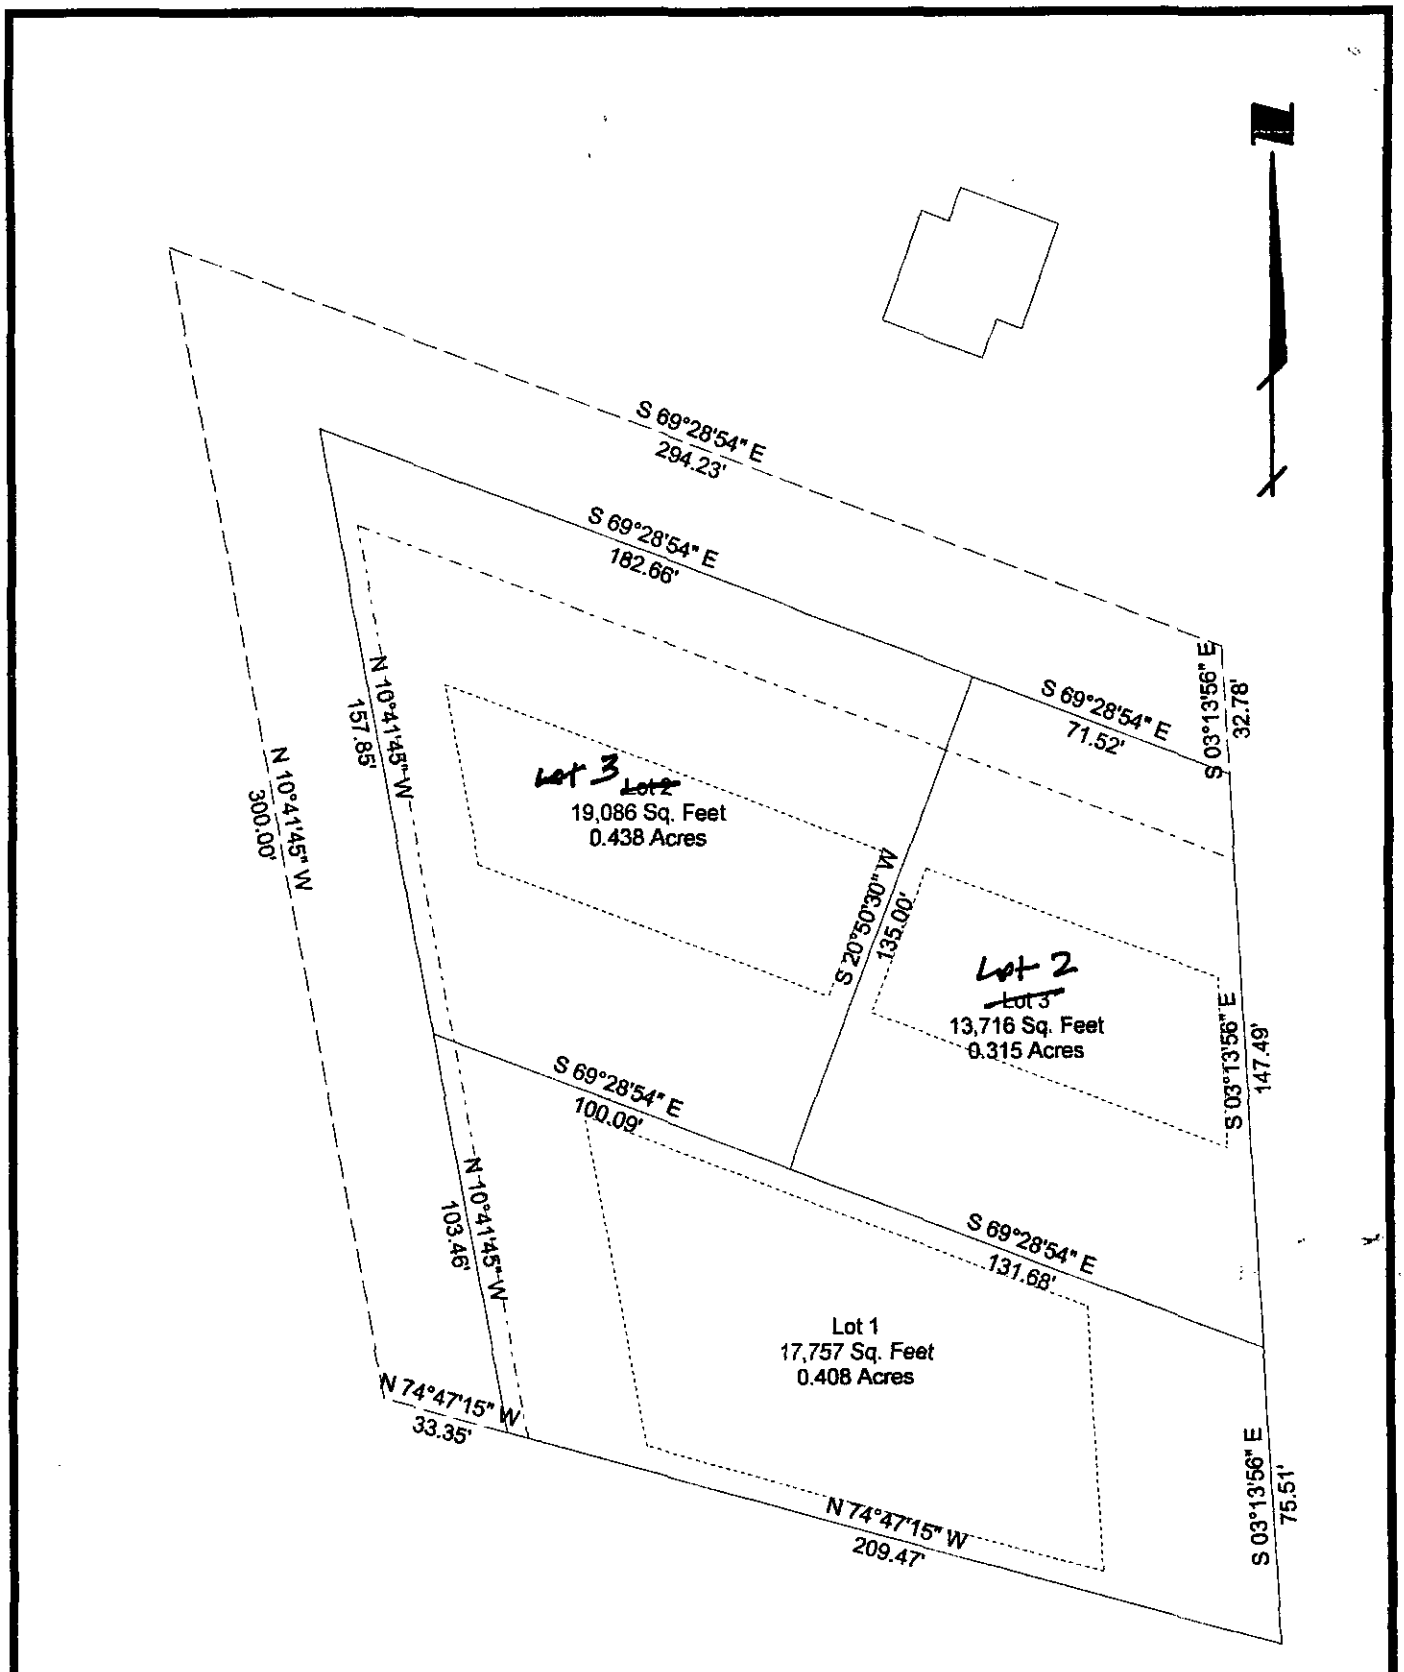


| | | |
|---|---|---|
| | | |
| | | |
| | | |
| DATE: 8/31/2003 | SCALE: 1" = 50' | DRAWN BY: |