Mecklenburg County Groundwater & Wastewater Services
700 N. Tryon St., Suite 211 Charlotte, NC 28202
Phone: (704) 336-5103 Fax: (704) 336-6894

NC DENR
Division of Environmental Health
On-Site Wastewater Section

OPERATION PERMIT for an ON-SITE WASTEWATER TREATMENT & DISPOSAL SYSTEM

File #: 6246B Permit #: _____ Tax Parcel #: 197-241-29

Property Owner: NVR Inc.

Job Location Address: 12035 Jumper Dr.

City: Charlotte State: NC Zip Code: 28227

Operation Permit Issuance Date: 05-07-08 Contractor Name: RCS

Permitted Design Flow: 480 GPD

Liquid Capacity of Septic Tank: 1500 gallons

Liquid Capacity of Dosing Tank: N/A gallons

Effluent Pump Model: N/A

Drainfield Installation ☐ N/A

Trench Depth: 36 inches

Trench Width: 3 feet

Line Spacing: 9 feet (O.C.)

Total line length: 270 feet

# of Lines: 5 @ 54 feet

Depth of Media: N/A inches (Type) I & S Panels

Depth of Cover: 12 inches

Distribution Device: D-Box to Flow Diviclors

Bed Installation *(For Repair Installations ONLY.)* ☒ N/A

Bed Depth: _____ inches

Bed Width: _____ feet

Total line length: _____ feet

# of Lines: _____ @ _____ feet

Depth of Media: _____ inches (Type) _____

Depth of Cover: _____ inches

Distribution Device: _____

Water Supply Source

☒ Municipal ☐ Private Well ☐ Community Well

☐ Other _____

System Installation Setbacks

Distance from Building Foundation: 5 feet

Distance from Property Line: 10 feet

Distance from Water Supply Source: 10 feet


Inspection Dates

Tank(s) Inspected: 05-07-08

Excavation Inspected: 05-07-08

Pump & Controls Inspected: N/A

SKETCH OF SYSTEM INSTALLATION
(As-Built Drawing)

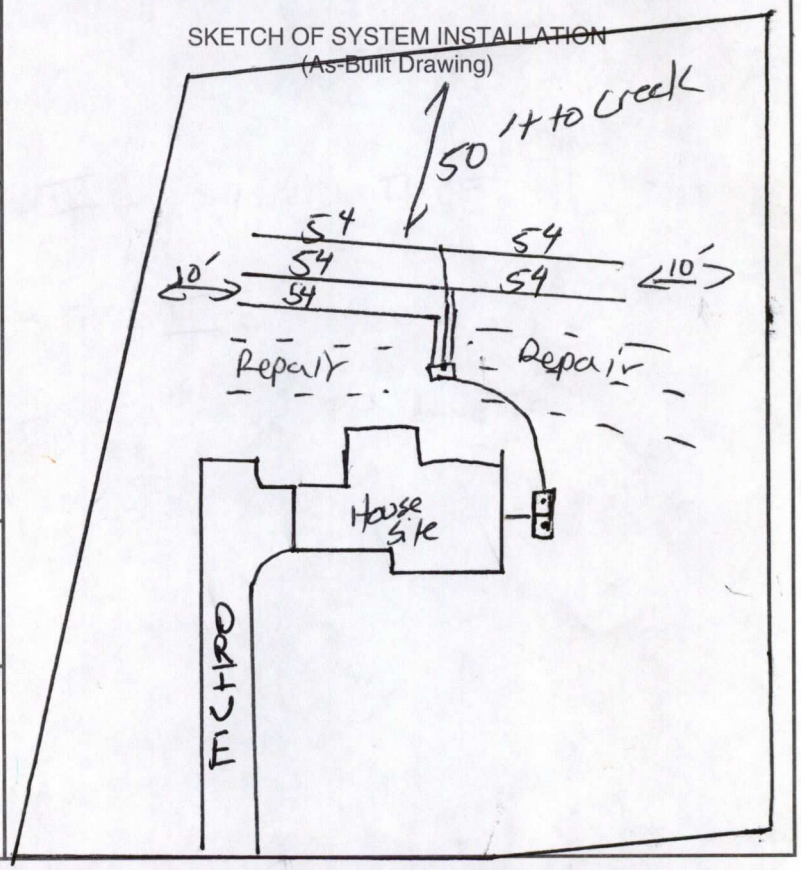

The undersigned has inspected the Septic Tank System described above, and certifies it has been ☐ installed ☐ altered ☐ repaired ☐ as detailed in the plot above ☐ in accordance with the permit issued and meets the provisions of 15A NCAC 18A. 1900, "Laws and Rules for Sewage Treatment and Disposal Systems" in effect on the date of issuance of the permit. The issuance of this Operation Permit does not in any way guarantee that the system will operate properly or relieve any person now or hereafter owning, controlling, or using such system from any liability resulting from the failure of the system to operate properly. This document is issued subject to those restrictions and conditions shown on the permit(s) and the provisions of 15A NCAC 18A. 1900 in addition to those listed below under "Comments." This document shall be null and void if any information contained in the application is untrue or if any additions are made to the property which would increase the requirements for said system.

Notice: Disturbance of the designated repair area may result in the Suspension or Revocation of this permit.

Comments: System Classification & Type: Gravity PANEL SYSTEM IIIc

PPBPS, G, NA, NA 1.5 hrs JAM

DENR Authorized Agent: Jeremy Michael Signature: Jeremy Michael

Mecklenburg County Groundwater & Wastewater Services
700 N. Tryon St., Suite 211 Charlotte, NC 28202
Phone: (704) 336-5103 Fax: (704) 336-6894

NC DENR
Division of Environmental Health
On-Site Wastewater Section

OPERATION PERMIT for an
ON-SITE WASTEWATER TREATMENT & DISPOSAL SYSTEM

File #: 6246B Permit #: _____ Tax Parcel #: 197-241-29

Property Owner: NVR INC

Job Location Address: 12035 Jumper Dr

City: Charlotte State: NC Zip Code: 28227

OPERATION PERMIT CONDITIONS:

I. Performance: System shall perform in accordance with 15A NCAC 18A .1961.

II. Monitoring: System shall be monitored as required by 15A NCAC 18A .1961.

III. Maintenance: Ground absorption sewage treatment and disposal systems shall be checked, and the contents of the septic tank removed, periodically from all compartments, to ensure proper operation of the system. The contents shall be pumped whenever the solids level is found to be more than 1/3 of the liquid depth in any compartment.

IV. Operation: System shall be operated in accordance with 15A NCAC 18A .1961.

System Classification: Title

*Operation Permits for Type V and VI systems expire five (5) years from the date of issuance (in accordance with Table V(a)). The system owner must contact GWS six (6) months prior to expiration for permit renewal.

Subsurface system operator required: Yes ☐ No ☒

☐ This type of system requires the system owner to maintain a contract with a certified operator to perform system inspection, maintenance, and reporting as required in 15A NCAC 18A .1961. and Table V(a). The system owner is responsible for all fees associated with these services.

☒ System does not require inspection by GWS on a routine frequency.

☐ System requires inspection by GWS once every five (5) years. The system owner is responsible for all fees associated with the inspection.

☐ System requires inspection by GWS once every three (3) years. The system owner is responsible for all fees associated with the inspection.

☐ System requires inspection by GWS once every twelve (12) months. The system owner is responsible for all fees associated with the inspection.

☐ System requires inspection by GWS once every six (6) months. The system owner is responsible for all fees associated with the inspection.

V. Other:

_____

_____

_____

_____

DENR Authorized Agent: Jeremy Mickel Date: 05-07-08

Signature: Jeremy Mickel


Sheet: 2 OF 2
FILE #: 6246B

COMMENTS: 100% REPAIR AREA

Landscape Position	Group	Texture	.1955 LTAR	Structure
R-Ridge	I	S-Sand	1.2 - 0.8	SG-Single Grain
SS-Shoulder Slope		LS-Loamy Sand		M-Massive
LS-Linear Slope				CR-Crumb
FS-Food Slope	II	SL-Sandy Loam	0.8 - 0.6	GR-Granular
NS-Nose Slope		L-Loam		SBK-Subangular Blocky
HS-Head Slope				ABK-Angular Blocky
CC-Concave Slope	III	SI-Silt	0.6 - 0.3	PL-Platy
CV-Convex Slope		SICL-Silty Clay Loam		PR-Prismatic
T-Terrace		CL-Clay Loam		
FP-Flood Plain		SCL-Sandy Clay Loam		
	IV	SC-Sandy Clay	0.4 - 0.1	
		SIC-Silty Clay		
		C-Clay		

Consistence Moist	Consistence Wet	Mineralogy
VFR-Very Friable	NS-Non-Sticky	SEXP-Slightly Expansive
FR-Friable	SS-Slightly Sticky	EXP-Expansive
FI-Firm	S-Sticky	
VFI-Very Firm	VS-Very Sticky	
EFI-Extremely Firm	NP-Non-Plastic	
	SP-Slightly Plastic	
	P-Plastic	
	VP-Very Plastic	

Sketch of Soil Evaluation Locations

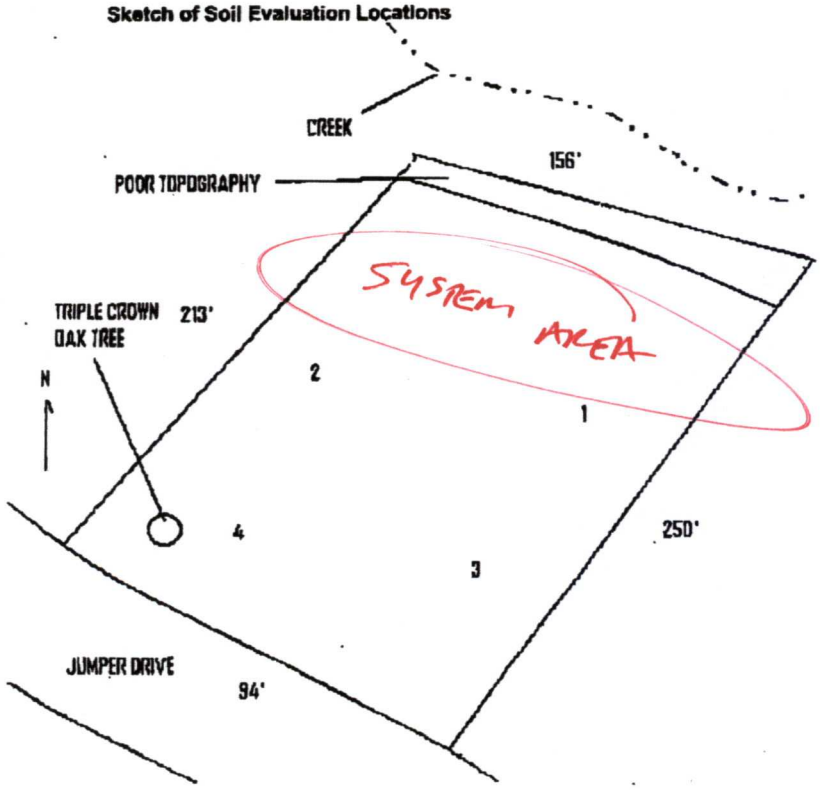


COMMENTS: 100% REPAIR AREA

Landscape Position	Group	Texture	.1955 LTAR	Structure
R-Ridge	I	S-Sand	1.2 - 0.8	SG-Single Grain
SS-Shoulder Slope		LS-Loamy Sand		M-Massive
LS-Linear Slope				CR-Crumb
FS-Food Slope	II	SL-Sandy Loam	0.8 - 0.6	GR-Granular
NS-Nose Slope		L-Loam		SBK-Subangular Blocky
HS-Head Slope				ABK-Angular Blocky
CC-Concave Slope	III	SI-Silt	0.6 - 0.3	PL-Platy
CV-Convex Slope		SICL-Silty Clay Loam		PR-Prismatic
T-Terrace				
FP-Flood Plain		CL-Clay Loam		
		SCL-Sandy Clay Loam		
	IV	SC-Sandy Clay	0.4 - 0.1	
		SIC-Silty Clay		
		C-Clay		

Consistence Moist	Consistence Wet	Mineralogy
VFR-Very Friable	NS-Non-Sticky	SEXP-Slightly Expansive
FR-Friable	SS-Slightly Sticky	EXP-Expansive
FI-Firm	S-Sticky	
VFI-Very Firm	VS-Very Sticky	
EFI-Extremely Firm	NP-Non-Plastic	
	SP-Slightly Plastic	
	P-Plastic	
	VP-Very Plastic	

Sketch of Soil Evaluation Locations

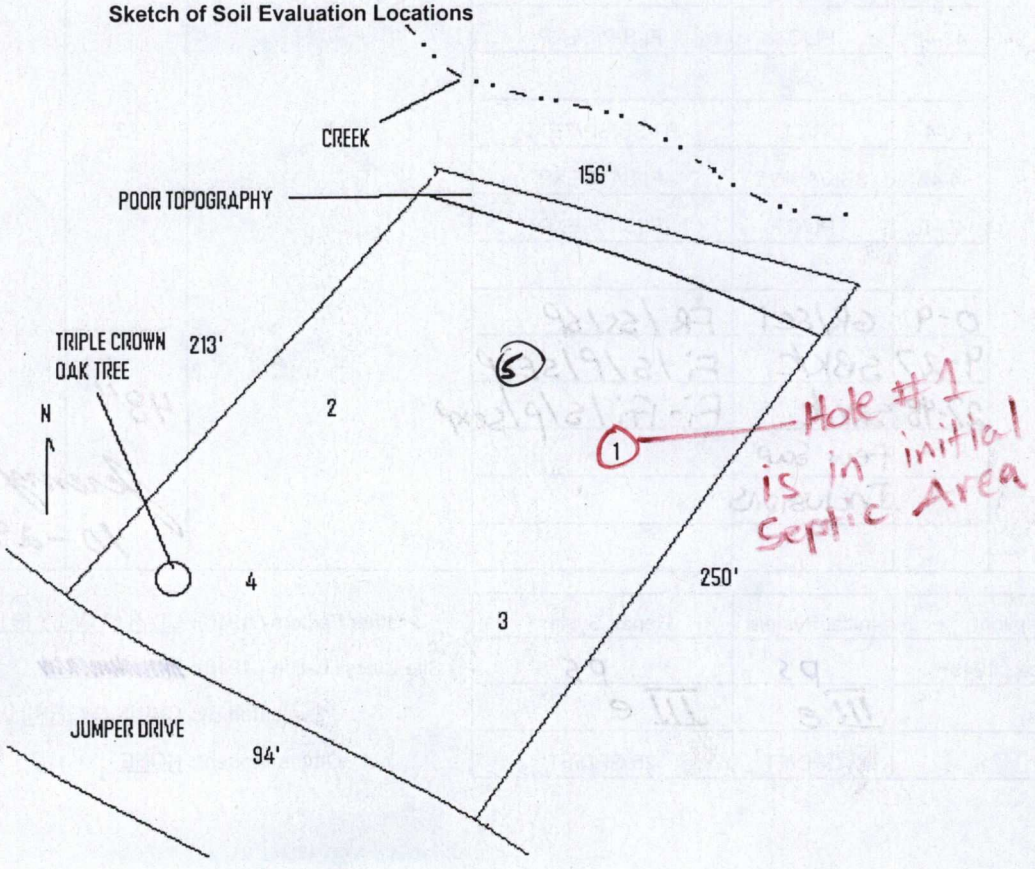

Department of Environment, Health, and Natural Resources
Division of Environmental Health
On-site Wastewater Section

RCJ

Sheet: 1 OF 2
Property ID: 197-241-28
Lot #: 39
File #: 6246B
Code: 3

SOIL/SITE EVALUATION
for ON-SITE WASTEWATER SYSTEM

Owner: NVR, INC
Address: 10815 DAVID TAYLOR DRIVE, CHARLOTTE, NC 28262
Proposed Facility: ~~SFR~~ AGR Design Flow (.1949): ~~600~~ 480 GPD SFAM
Location of Site: 12035 JUMPER DRIVE, MINT HILL, NC 28227
Water Supply: [X] Public [ ] Individual [ ] Well [ ] Spring [ ] Other
Evaluation Method: [X] Auger Boring [ ] Pit [ ] Cut
Type of Wastewater: [X] Sewage [ ] Industrial Process [ ] Mixed

Applicant: KIM STANLEY
Date Evaluated: 12/22/05
Property Size: 1
Property Recorded: YES

PROFILE #	.1940 Landscape Position/ Slope%	Horizon Depth (IN.)	SOIL MORPHOLOGY .1941 Structure/ Texture	SOIL MORPHOLOGY .1941 Consistence Mineralogy	OTHER PROFILE FACTORS .1942 Soil Wetness/ Color	.1943 Soil Depth (IN.)	.1956 Sapro Class	.1944 Restr Horiz	Profile Class & LTAR
1	LS, 12	0-7	GR/L	VFR/SS/SP/SEXP	>48"	>48"	NA	NA	PS, IV
		7-48	SBK/ABK/C	FI/S/P/SEXP					.3 GPD/FT^2
2	LS,15	0-14	GR/CL	FR/SS/SP/SEXP	"	"	"	"	"
		14-48	SBK/ABK/C	FI/S/P/SEXP					
3	LS,10	0-10	SBK/CL	FR/SS/SP/SEXP	"	42"	"	"	PS, IV
		10-42	SBK/ABK/C	FI/S/P/SEXP					.25 GPD/FT^2
		42-48	PL/C	FI/S/P/SEXP					
4	"	0-4	GR/CL	FR/SS/SP/SEXP	"	42"	"	"	"
		4-42	SBK/ABK/C	FI/S/P/SEXP					
		42-48	PL/C	FI/S/P/SEXP					
5		0-9	GR/SCL	FR/SS/SP					
		9-27	SBK/C	FI/S/P/SEXP					
		27-48	SBK/C	FI-FRI/S/P/SEXP		48"			PS IV
			few sap						.3 GPD/FT
			Inclusions						

Jeremy Medeiros 10-24-07

Description	Initial System	Repair System
Available Space (.1945)	100%	100%
System Type(s)	III e	III e
Site LTAR	.3 GPD/FT^2	.25 GPD/FT^2

Other Factors (.1946): LTAR .3 ONLY IF INITIAL SYSTEM IN REAR OF LOT
Site Classification (.1948): ~~UNSUITABLE~~ PROV. SUITABLE
Evaluated By: CHRIS SHERRILL, RS, LSS
Others Present: NONE

12-29-05

COMMENTS: 100% REPAIR AREA

Landscape Position	Group	Texture	.1955 LTAR
R-Ridge	I	S-Sand	1.2 - 0.8
SS-Shoulder Slope		LS-Loamy Sand	
LS-Linear Slope			
FS-Food Slope	II	SL-Sandy Loam	0.8 - 0.6
NS-Nose Slope		L-Loam	
HS-Head Slope			
CC-Concave Slope	III	SI-Silt	0.6 - 0.3
CV-Convex Slope		SICL-Silty Clay Loam	
T-Terrace			
FP-Flood Plain		CL-Clay Loam	
		SCL-Sandy Clay Loam	
	IV	SC-Sandy Clay	0.4 - 0.1
		SIC-Silty Clay	
		C-Clay	

Structure
SG-Single Grain
M-Massive
CR-Crumb
GR-Granular
SBK-Subangular Blocky
ABK-Angular Blocky
PL-Platy
PR-Prismatic

Consistence
Moist
VFR-Very Friable
FR-Friable
FI-Firm
VFI-Very Firm
EFI-Extremely Firm

Consistence
Wet
NS-Non-Sticky
SS-Slightly Sticky
S-Sticky
VS-Very Sticky
NP-Non-Plastic
SP-Slightly Plastic
P-Plastic
VP-Very Plastic

Mineralogy
SEXP-Slightly Expansive
EXP-Expansive

Sketch of Soil Evaluation Locations

