

3500 CARMEL RD

20915303

1/10/2008

duponbj

Groundwater and Wastewater Services File Imaging Project
May 2007
Barcode Font = IDAutomationHC39M

SEPTIC FEE: [illegible]
DATE: 8/11/06
CRT [ ] JKA

PERMIT APPLICATION FOR A RESIDENTIAL SITE
IMPROVEMENT PERMIT / CONSTRUCTION AUTHORIZATION
FOR ON-SITE WASTEWATER SYSTEM
NEW WELL INSTALLATION OR REPAIR OF EXISTING WELL
MECKLENBURG COUNTY GROUNDWATER & WASTEWATER SERVICES

GWS – RES. APP 07/05

WELL FEE: _____
DATE: _____
CRT [ ]

FILE # 6712B

SEPTIC / TYPE APPLICATION: ☐ NONE ☐ NEW SYSTEM ☐ ALTERATION ☑ REPAIR ☐ MODIFY PLOT PLAN

WELL / TYPE APPLICATION: ☐ NONE ☐ NEW WELL ☐ MAJOR REPAIR ☐ ABANDONMENT

JOB LOCATION INFORMATION:
TAX/PARCEL #: 209-153-03
STREET ADDRESS: 3500 Carmel rd
CITY: Charlotte
STATE: NC ZIP: 28226
SUBDIVISION OR MOBILE HOME PARK NAME:
LOT #:
TOWNSHIP:

☐ 0-MECKLENBURG ☐ 4-PINEVILLE
☑ 1-CHARLOTTE ☐ 5-MATTHEWS
☐ 2-DAVIDSON ☐ 6-HUNTERSVILLE
☐ 3-CORNELIUS ☐ 7-MINT HILL

BUILDING INFORMATION:
TYPE OF BUILDING:

☐ SINGLE MOBILE HOME (S) ☐ MODULAR HOME (M)
☐ DOUBLE WIDE (D) ☐ MULTIPLE FAMILY (U)
☑ HOUSE (H) ☐ OTHER

HEATED SQUARE FOOTAGE: 2995+
NUMBER OF BEDROOMS: 4 Bedroom
NUMBER OF OCCUPANTS: 3

FOUNDATION FOR RESIDENCE:

☐ CONCRETE SLAB ☑ BASEMENT WITH PLUMBING
☐ CRAWLSPACE ☐ BASEMENT WITH NO PLUMBING

IF PLANNING TO EXPAND/ALTER THE EXISTING SYSTEM INDICATE THE FOLLOWING CHANGES:
NUMBER OF BEDROOMS TO BE ADDED: None NUMBER OF ADDITIONAL OCCUPANTS IN THE RESIDENCE:
WILL THERE BE A HOME BUSINESS IN THE RESIDENCE? ☐ YES ☐ NO TYPE:

WATER SUPPLY:
☐ MUNICIPAL (M) ☑ PUBLIC (C) ☐ PRIVATE WELL (P) ☐ SHARED WELL (S) ☐ OTHER 'SPRINGS' (O)

PROPOSED USE OF WELL: ☐ N/A ☐ IRRIGATION ☐ POTABLE ☐ GEOTHERMAL ☐ OTHER

ARE ANY OF THE FOLLOWING LOCATED ON THE PROPERTY? IF SO, PLEASE SHOW LOCATION ON SITE PLAN/PLAT.

BURIED CABLES, LANDFILLS, STUMPHOLES	☑ YES	☐ NO	WELLS, SPRINGS, OR WATER LINES	☑ YES	☐ NO
EXISTING WASTEWATER SYSTEMS	☑ YES	☐ NO	DESIGNATED WETLANDS	☐ YES	☑ NO
EASEMENTS OR RIGHT-OF-WAYS	☐ YES	☑ NO	GRADING/SOIL REMOVAL PERFORMED	☐ YES	☑ NO

PROPERTY OWNER:
NAME: Saad Eligs Saad
ADDRESS: 3500 Carmel rd
CITY: (Charlotte)
STATE: NC ZIP: 28226
HOME PHONE: 704-248-7[illegible] WORK PHONE: 704-272-0887
MOBILE PHONE: 704-506-2911 FAX: 704-272-0936

LEGAL AGENT FOR PROPERTY OWNER, IF APPLICABLE:
NAME:
ADDRESS:
CITY:
STATE: ZIP:
HOME PHONE: WORK PHONE:
MOBILE PHONE: FAX:

WHAT DATE WAS THE PROPERTY ORIGINALLY DEEDED AND RECORDED? 9-2001
WHAT IS THE ANTICIPATED CLOSING DATE FOR THIS PROPERTY? 9-2001

*An Improvement Permit is subject to suspension or revocation if site plans or the intended use change or if information submitted in this application is falsified or changed. The undersigned, owner, or legal agent for the owner, of the property described above as the "Job Location" has read the foregoing application, acknowledges that the contents of same are true, and authorizes the Mecklenburg County Health Department to enter onto the property for the purpose of processing this request.

8-7-06
Owner's/Agent's Signature Date

NORTH CAROLINA DEPARTMENT OF
ENVIRONMENT & NATURAL RESOURCES DIVISION
OF ENVIRONMENTAL HEALTH ON-SITE
WASTEWATER SECTION

*A Well Permit is subject to suspension or revocation if site plans or the intended use change or if information submitted in this application is falsified or changed. The undersigned, owner, or legal agent for the owner, of the property described above as the "Job Location" has read the foregoing application, acknowledges that the contents of same are true, and authorizes the Mecklenburg County Health Department to enter onto the property for the purpose of processing this request.

Owner's/Agent's Signature Date

MECKLENBURG COUNTY HEALTH DEPARTMENT
GROUNDWATER & WASTEWATER SERVICES
700 N. TRYON ST., SUITE 211
CHARLOTTE, NC 28202 704-336-5103 / FAX: 704-336-6894

Mecklenburg County Groundwater & Wastewater Services
700 N. Tryon St., Suite 211 Charlotte, NC 28202
Phone: (704) 336-5103 Fax: (704) 336-6894

NC DENR
Division of Environmental Health
On-Site Wastewater Section

INSTALLATION APPROVAL for an
ON-SITE WASTEWATER TREATMENT & DISPOSAL SYSTEM

File #: 6712B Permit #: _____ Tax Parcel #: 209-153-03

Property Owner: SAAD E. SAAD

Job Location Address: 3500 CARMEL RD.

City: CHARLOTTE State: NC Zip Code: 28226

Installation Approval Issuance Date: 8/7/06

Permission is hereby given to ☐ install ☐ alter ☑ repair an on-site wastewater treatment & and disposal system, with subsurface soil absorption and effluent discharge, as specified herein at the described location. This approval is granted based upon the application information submitted to our office. All work shall be completed on or before 8/14/06, after which date this approval shall be null and void. The system shall meet all of the construction requirements of 15A NCAC 18A. 1900 which are in effect on the date of granting this approval. An **Operation Permit** must be obtained from the Mecklenburg County Health Department before any system can be covered up or placed into service. The issuance of this permit does not in any way guarantee that the system anticipated to be constructed will operate properly, or relieve any person now of hereafter owning, controlling or using such system from any liability resulting from the failure of the system to operate properly.

***NOTICE: This system shall not be installed while soils are in a wet condition.**

Permitted Design Flow: 480 GPD

Liquid Capacity of Septic Tank: NA (EXIST) gallons

Site LTAR: NA GPD/ft² (For new installations only.)

Liquid Capacity of Dosing Tank: 1000 gallons

Drainfield Design ☐ N/A

Trench Depth: 30 inches

Trench Width: 3 feet

Line Spacing: 9 feet (O.C.)

Total line length: 400 feet

# of Lines: 4 @ 400 feet

Depth of Media: 18 inches (Type) GRAVEL

Distribution Device: DROP BOXES

Bed Design *(For Repair Installations ONLY.)* ☑ N/A

Bed Depth: _____ inches

Bed Width: _____ feet

Total line length: _____ feet

# of Lines: _____ @ _____ feet

Depth of Media: _____ inches (Type) _____

Distribution Device: _____

Water Supply Source

☑ Municipal ☐ Private Well ☐ Community Well

☐ Other _____


Minimum System Setbacks

Distance from Building Foundation: 15 feet

Distance from Property Line: 10 feet

Distance from Water Supply Source: 10 feet

SKETCH OF SYSTEM LAYOUT (Proposed Layout)

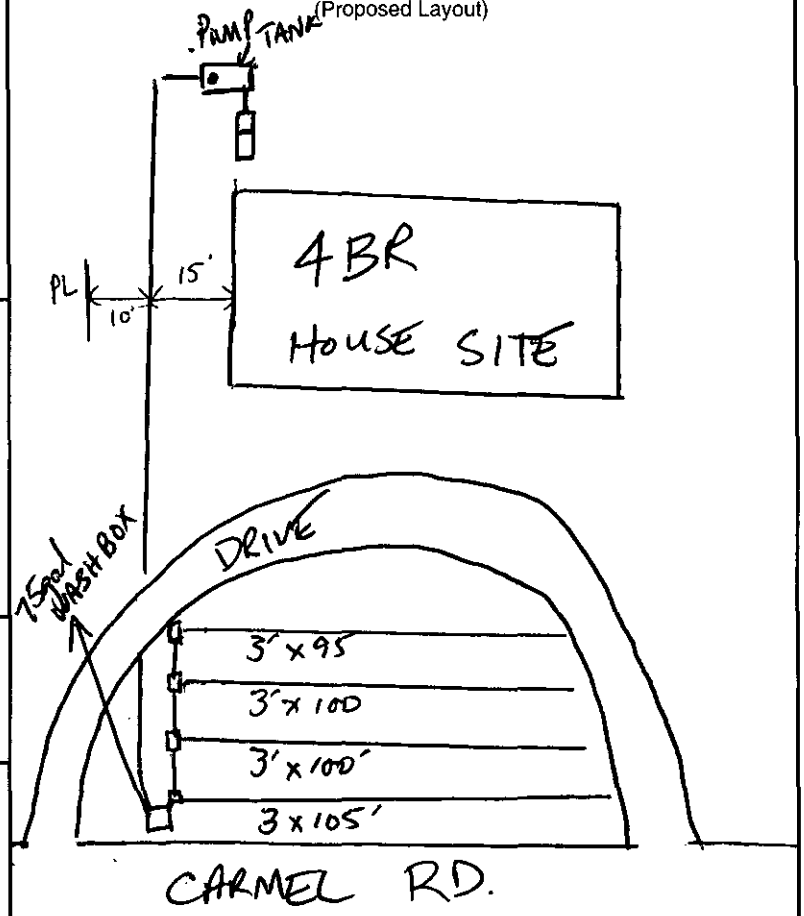

Comments: System Classification & Type: TYPE III b (PUMP CONVENTIONAL); 18" STONE; 1000 gal PT

DENR Authorized Agent: Chris Sherrill, RS, LSS Signature: Christopher M Sherrill