SEE INSTRUCTIONS ON BACK

Date Received 8/2/78

ICAR(S) Application No. 14166

T C No. 035-021-11

Map Date 2-21-75

MECKLENBURG COUNTY
DEPARTMENT OF ENVIRONMENTAL HEALTH

Application for an
Installation, Construction, Alteration, and/or Repair Permit
(Individual Septic Tank System with Subsurface, Soil Absorption, Effluent Discharge)

The owner of that property described hereinafter hereby applies to the Mecklenburg County Department of Environmental Health for a permit to: Adding to Septic Line / New Washing Machine P.T.

1) Install or Construct 2) X Alter or Repair an individual septic tank wastewater treatment system with a subsurface, soil absorption, effluent discharge

Mobile Home	Yes __ No
Residence	X Yes __ No
No. of Bedrooms	2
[illegible]	
Employees	
Washing Machine	Yes __ No
Garbage Disposal	Yes __ No
[illegible]	Yes __ No
Water Supply	X
[illegible]	
[illegible]	
[illegible]	
[illegible]	
[illegible]	
[illegible]	
[illegible]	feet
[illegible]	Yes __ No
[illegible]	feet of
[illegible]	Yes __ No
[illegible]	
[illegible]	

3) PLOT PLAN (ACCURATELY DIMENSIONED)

13) NAME OF OWNER McGinnis Swit (LAST / FIRST / MIDDLE)

14) ADDRESS OF OWNER 5841 Pease Rd. 28216

15) PHONE NO. Home 399-1878 Office

16) LOCATION OF SYSTEM 5813 Pease Rd. (STREET OR COUNTY ROAD)

17) SUBDIVISION Lot No. Block No.

Map Book No. Page No.

18) DEED REFERENCE - DEED BOOK 12 AT PAGE 511

19) HAS A [illegible] YES NO DATE RUN

20) [illegible]

The undersigned person hereby agrees that he has read the foregoing application and that the contents of same are true [illegible] understood that any permit applied for herein shall be void and of no effect if any of the above facts are not true.

DATE OF APPLICATION

X Dennis E. McGinnis
OWNER

[illegible]

Environmental Health Department's Copy


Date Issued 8-25-78 Serial No. 1898 ICAR(S) Permit No. 14466

T C M 035-021-11

Map Date

MECKLENBURG COUNTY
DEPARTMENT OF ENVIRONMENTAL HEALTH
INSTALLATION, CONSTUCTION, ALTERATION, AND/OR REPAIR PERMIT
(Individual Septic Tank System with Subsurface, Soil Absorption, Effluent Discharge)

Permission is hereby given to Install or Construct, ✓ Alter or Repair the individual septic tank wastewater treatment system with subsurface, soil absorption, effluent discharge as specified herein at the described location. This permit is granted based upon the information supplied in application 14466, dated 8-21-78 and this permit shall be void and of no effect if the information provided in the application is not true or is erroneous. All work shall be completed on or before 9-25-78, after which date this permit shall be null and void.

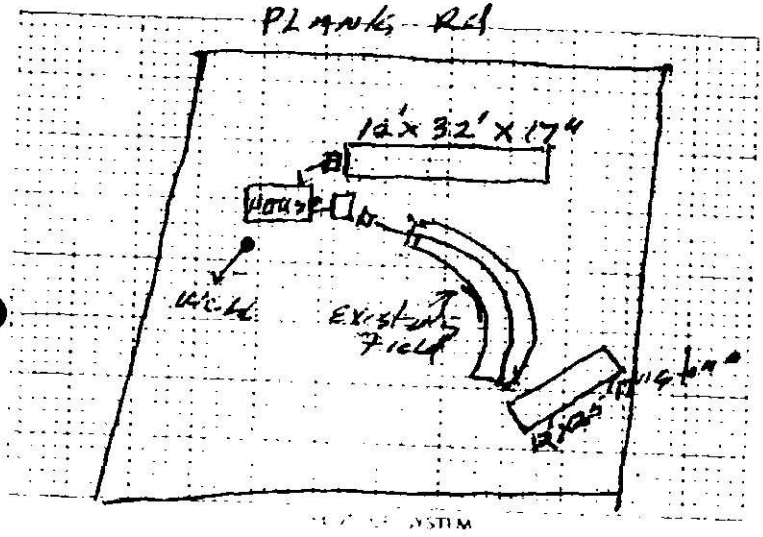

PLAN OF SYSTEM

Permitted Use Type: P/S

Liquid Capacity of Tank:

Tank Construction: Precast

Absorption Area or Distribution Line:

Total Line Length: 100' – 125'

Number of Lines: 4 – 4

Distance from House: 10'

Distance from Property Line: 10'

Distance from Well: 50'

NAME OF OWNER: Susie McGuinn

LOCATION OF PROPERTY: 5813 Plank Rd.

This [illegible] in accordance with the Regulations of the Mecklenburg County Board of Health governing the disposal of sewage. This permit does not authorize the grading of the property. A certificate of approval will be issued by the Department after the system has been inspected and found to be constructed in accordance with the Regulations governing the disposal of sewage. **The issuance of this permit does not in any way guarantee that the system anticipated to be constructed will operate properly, or relieve any person now or hereafter owning, controlling or using such system from any liability resulting from the failure of the system to operate properly.**

Sanitarian Marshall Edwards
Environmentalist

* If this permit is for the alteration or construction of a new system, it must be signed by the division or section head of the Department of Environmental Health in order to be valid. Only the signature of the Environmentalist is required when an existing system is being altered or repaired.

EHD-5-76

Sanitarian's Copy

Date Issued 9-8-78 Serial No. 1880 C of A (s) No. 14466

T C No 035-021-11

MECKLENBURG COUNTY
DEPARTMENT OF ENVIRONMENTAL HEALTH
ENVIRONMENTAL HEALTH DIVISION

CERTIFICATE OF APPROVAL
(Individual Septic Tank System with Subsurface, Soil Absorption, Effluent Discharge)

Name of Owner McGuinn (LAST) Susie (FIRST) A. (MIDDLE)

Location of Property 5813 Plank Rd.

Application Number ✓ Permit Number 14466

Inspection Data:

Liquid Capacity of Tank Existing Field Tank Material Present Tanks

Total Length of Drain Tile 100'-125' Number of Lines 4-4

Depth of Filter Material 17" Cover Depth 20"

Water Supply Source Well Distance from Water Source 50'

Excavation Inspected 9-8-78 (DATE) Tank Inspected 9-8-78 (DATE)

Nitrification Field Inspected 9-8-78 (DATE)

Washing Machine Line Inspected If Applicable — (DATE)

The undersigned has inspected the Individual Septic Tank System with subsurface, soil absorption, effluent discharge as described above and it has been ✓ installed or constructed, altered or repaired in accordance with the permit issued and the regulations of the Mecklenburg County Health Code now in effect on the date of issuance of the permit. The issuance of this Certificate of Approval does not in any way guarantee that the system will operate properly or relieve any person now or hereafter owning, controlling or using such system from any liability resulting from the failure of the system to operate properly. This Certificate of Approval is issued subject to those restrictions and conditions shown on the permit in addition to those listed below under comments. This Certificate of Approval must be modified if any information contained in the application is untrue or if any additions are made to the property which would increase the requirements for said system.

Comments

J. Marshall Edwards
Environmentalist

EHD-5-76

Environmental Health Department's Copy