

14700 STEELE CREEK RD

21912113

5/2/08

marliwr

Groundwater and Wastewater Services File Imaging Project
May 2007
Barcode Font = IDAutomationHC39M

$200 00

INDIVIDUAL WATER AND WASTEWATER SYSTEMS PROGRAM
APPLICATION FOR SERVICES

pd 4/50 8/30/94 ck #848 CRT

2924

Mecklenburg County Health Dept.
Environmental Health Division
c/o Hal Marshall Ctr., Suite 211
700 N. Tryon St.
Charlotte, NC 28202

(704)336-5102

PERSON FILING APPLICATION:
NAME: FOLTZ (last) RONNIE (first) G (mi)
ADDRESS: 14700 STEELE CRK RD PHONE: (__) 588-8960
CITY: CHARLOTTE STATE: NC ZIPCODE: 28273

Date:

PROPERTY OWNER:
NAME: SAME (last) (first) (mi)
ADDRESS: PHONE: (__)
CITY: STATE: ZIPCODE:

PROPERTY INFORMATION (FROM ENGINEERING FORM):
TAX/PARCEL NUMBER: 219-121-13
STREET ADDRESS: 14700 STEELE CRK. RD
ZONING:

Township (check one):
[X] 0 Mecklenburg County [ ] 2 Davidson [ ] 4 Pineville [ ] 6 Huntersville
[ ] 1 Charlotte [ ] 3 Cornelius [ ] 5 Matthews [ ] 7 Mint Hill

SUBDIVISION OR MOBILE HOME PARK NAME:

LOT NUMBER: LOT SIZE (in acres):

TYPE APPLICATION (check one):
[ ] SOIL TEST - INDIVIDUAL LOT (D)
[ ] NEW CONSTRUCTION ON VACANT LOT - 4 BEDROOMS OR LESS (N)
[ ] EXCHANGE MOBILE HOME - SAME # BEDROOMS (Y)
[ ] ADDITION - INCREASE ROOMS/OCCUPANCY/MOBILE HOME SIZE (A or M)
[ ] COMMERCIAL OR INDUSTRIAL (N)
[ ] SOIL TEST DEVELOPMENT (P)
[X] ADDITION - GARAGE OR RENOVATION/NO MAJOR CHANGES (X) Sunroom B/R
[ ] MODIFIED /ALTERNATIVE/ OR RESIDENCE > 4 BEDROOMS (Z)
[ ] REPAIR TO SYSTEM (R)

RESIDENTIAL PROPERTY (Type Building, check one):
[ ] SINGLE MOBILE HOME (S) [X] HOUSE (H) [ ] MULTIPLE FAMILY (U)
[X] DOUBLE WIDE (D) [ ] MODULAR HOME (M) [ ] OTHER _____ (O)

NUMBER BEDROOMS: 3 NUMBER OCCUPANTS:
SYSTEM CLASSIFICATION:

COMMERCIAL/INDUSTRIAL PROPERTY:
Type Business _____ # Employees ___ Per Shift ___ ___ ___
Industrial Wastes (Y/N) ___
Underground Storage Tanks On Property (Y/N) ___ Type _____

WATER SUPPLY (check one):
[ ] Community (C) [ ] Shared Well (S)
[ ] Municipal (M) [ ] Other 'spring' (O)
[X] Private Well (P)

FUTURE ADDITIONS - ALL PLANNED ADDITIONS MUST BE ENTERED (check all that apply):
[ ] Swimming Pool [ ] Jacuzzi [ ] Stable/Barn [ ] Workshop [ ] None
[ ] Garage [ ] Storage Building [ ] Deck/Patio [ ] Bedrooms [ ] Other

The undersigned, owner, or legal agent for the owner, of the property described above as the "JOB LOCATION" has read the foregoing application, acknowledges that the contents of same are true, and authorizes agents of the MECKLENBURG COUNTY HEALTH DEPARTMENT to enter onto the property for the purpose of processing this request.

Signed: Ronnie G. Foltz Date: 8-30-94

NOTICE:

The undersigned, an authorized agent of the MECKLENBURG COUNTY HEALTH DEPARTMENT, certifies that the Department has approved the Request for the Job Location contained in this document. This approval is granted in accordance with the provisions of Laws And Rules For Sanitary Sewage Collection, Treatment And Disposal in effect at the time of issuance of the permit and is subject to the following provisions:

...No work shall be conducted on the septic tank system until an installation, Construction, Alteration and/or Repair approval is granted by this Department.

...This permit is not transferable.


... Use existing system.

[ ] IMPROVEMENT PERMIT - VALID 60 MONTHS FROM ISSUANCE
[ ] MOBILE HOME EXCHANGE APPROVAL - VALID 6 MONTHS FROM ISSUANCE
[X] ADDITION/RENOVATION APPROVAL - VALID 1 YEAR FROM ISSUANCE

Jon W. Newell RS 9/8/94
Environmentalist Date

Jon W. Newell for S. David
Director or Authorized Section Head Date

WATER : 122791

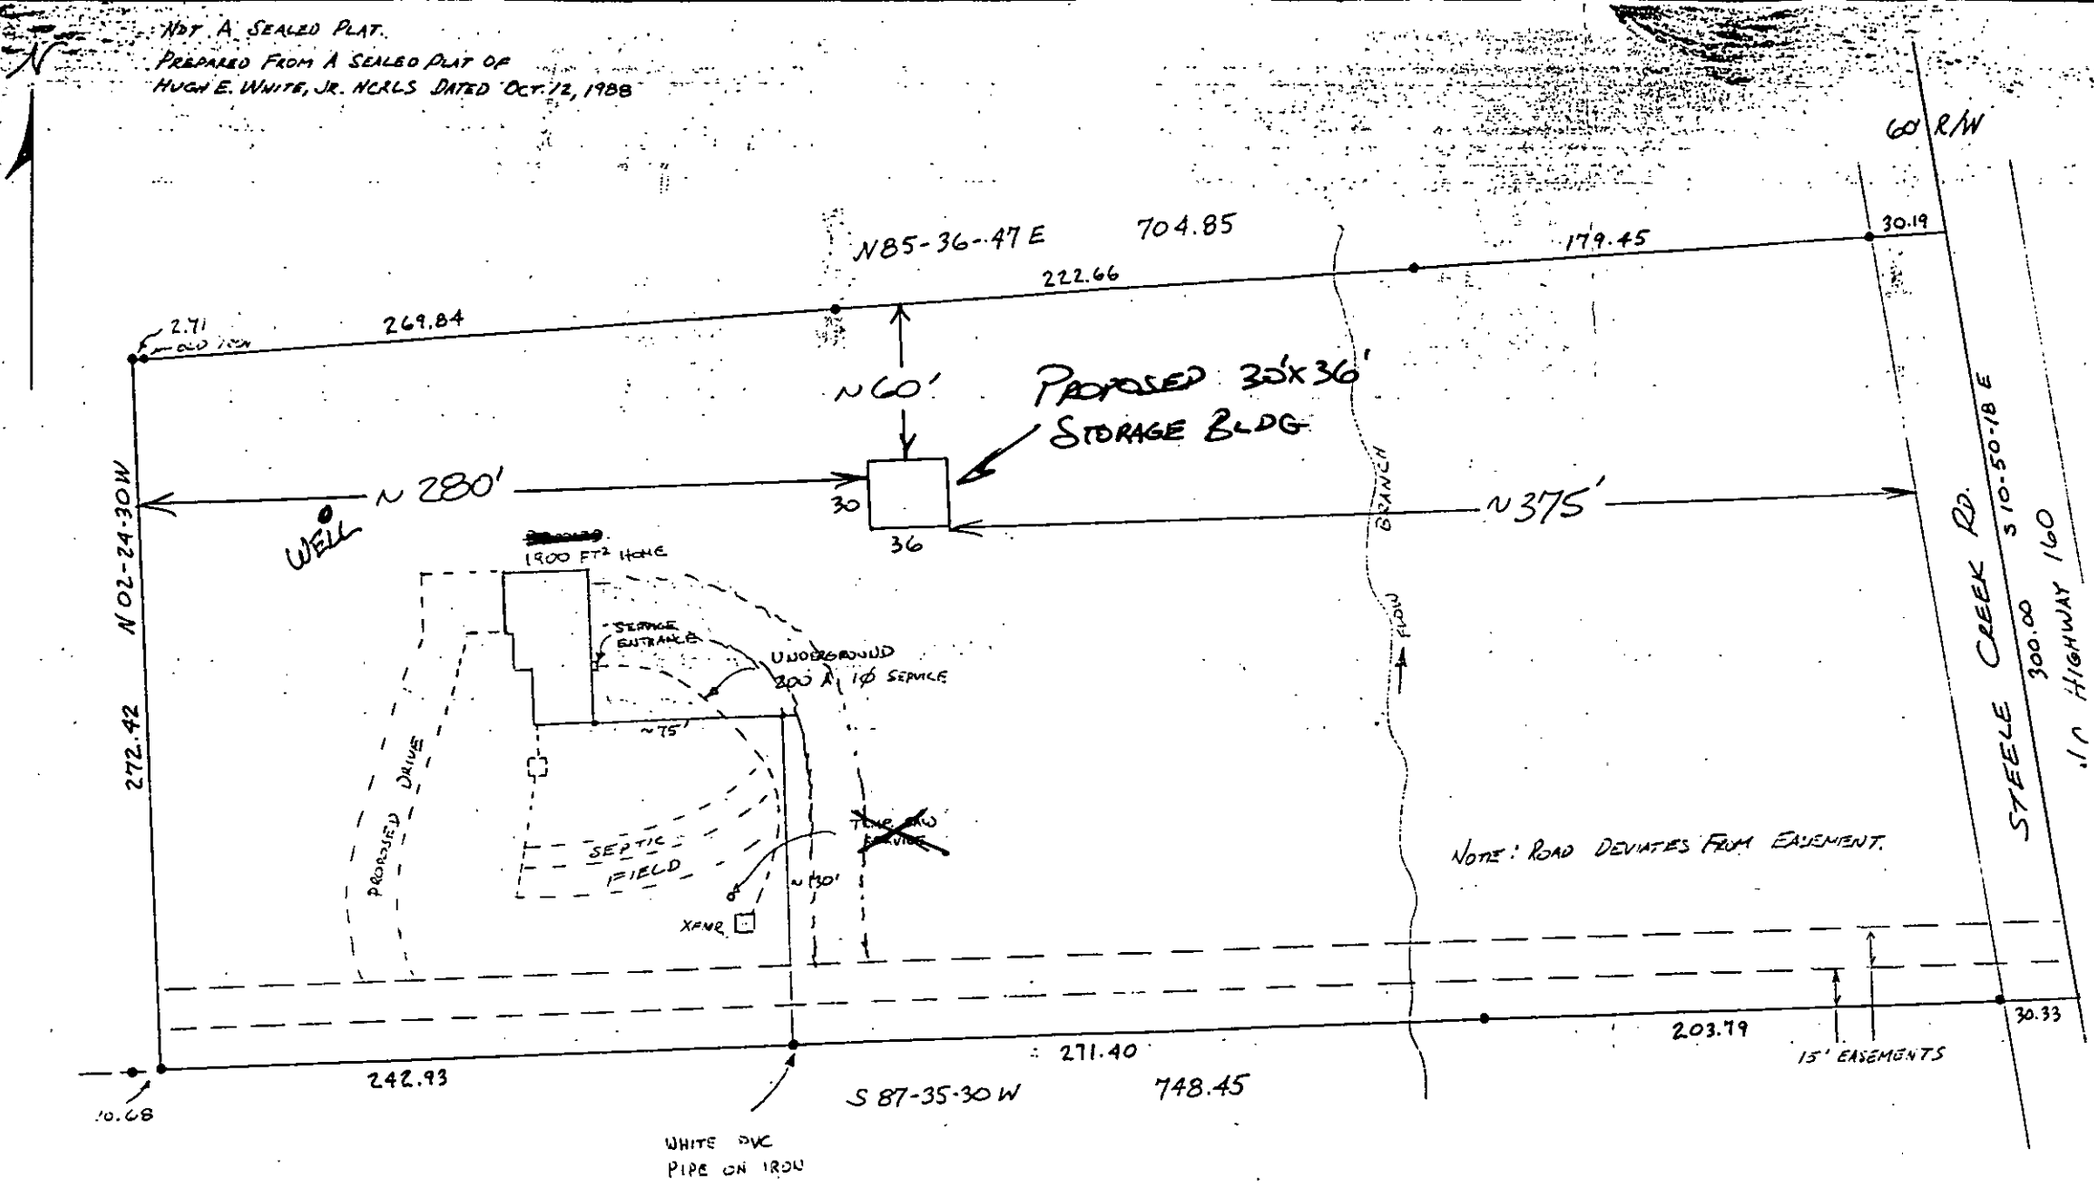

14700 STEELE CREEK RD.
MECKLENBURG CTY. TAX CODE 219-121-13
1"=CB' SCALE: 1"=~~200'~~ 4.752 AC.
DRAWN BY R.G. FOLTZ, P.E. DEC. 29, 1989
PROPOSED DETAIL AS OF ~~MAR. 27, 1990~~
6-13-94

File 29749

COPY