

1601 MCCORKLE RD

05308202

6/27/2007

duponbj

Groundwater and Wastewater Services File Imaging Project
May 2007
Barcode Font = IDAutomationHC39M

CERTIFICATE OF COMPLETION/OPERATION PERMIT

HEALTH DEPARTMENT
ENVIRONMENTAL HEALTH DIVISION
1200 BLYTHE BOULEVARD
CHARLOTTE, NC 28203
PHONE (704) 376-4603

FILE: 7308A DATE: 8/8/91

TO: 053-082-02 ☐ L ☐ CRT

SERIAL № 13838

Name of Owner Kiser, William N. Juris.:

Address of Property 1601 McCorkle Rd

Inspection Data:

Tank Material PCC

Total Length of Drainfield 400'

Number of Lines 4 @100'

Cover Depth 24" - 30"

Water Supply Source Well

Distance to Water Source >100

Excavation Inspected 8/8/91

Tank(s) Inspected 8/8/91

Wash Line Inspected

High Water Alarm Inspected

PLOT

Design: 1991 1500st con, 1200FT 12" G. Coil CTR# 48

The undersigned has inspected the Septic Tank System described above, and certifies it has been

☐ installed or constructed ☐ altered or repaired

☐ in accordance with the permit issued ☐ as detailed in the plot above

and meets the provisions of 10 NCAC 10A .1900, "Laws And Rules For Sanitary Sewage Collection, Treatment, And Disposal" in effect on the date of issuance of the permit. The issuance of this

☑ Certificate of Completion ☐ Operation Permit

does not in any way guarantee that the system will operate properly or relieve any person now or hereafter owning, controlling, or using such system from any liability resulting from the failure of the system to operate properly. This document is issued subject to those restrictions and conditions shown on the permit(s) and the provisions of 10 NCAC 10A .1900 in addition to those listed below under "COMMENTS." This document shall be null and void if any information contained in the application is untrue or if any additions are made to the property which would increase the requirements for said system.

COMMENTS: System designed for 3 bedroom home.

Judy A. Klein R.S.
Environmentalist

Mecklenburg County services are available without regard to ethnic origin, sex, or disability.

INSTALLATION, CONSTRUCTION, ALTERATION, AND/OR REPAIR PERMIT


HEALTH DEPARTMENT
ENVIRONMENTAL HEALTH DIVISION
1200 BLYTHE BOULEVARD
CHARLOTTE, NC 28203
PHONE (704) 376-4603

FILE: 7308A DATE: 8-2-91

TC: 053-082-02 ☐ L

SERIAL Nº 13766

Permission is hereby given to ✓ Install or Construct, _____ Alter or Repair the individual septic tank wastewater treatment system with subsurface, soil absorption, effluent discharge as specified herein at the described location. This permit is granted based upon the information supplied in the application dated 8-2-91. All work shall be completed on or before 9-2-91, after which date this permit shall be null and void. The system shall meet all of the construction requirements of 10 NCAC 10A .1900 which are in effect on the date of the granting of this permit. A Certificate of Completion or an Operation Permit must be obtained from the Mecklenburg County Health Department before any system can be covered up or placed into service. The issuance of this permit does not in any way guarantee that the system anticipated to be constructed will operate properly, or relieve any person now or hereafter owning, controlling or using such system from any liability resulting from the failure of the system to operate properly.

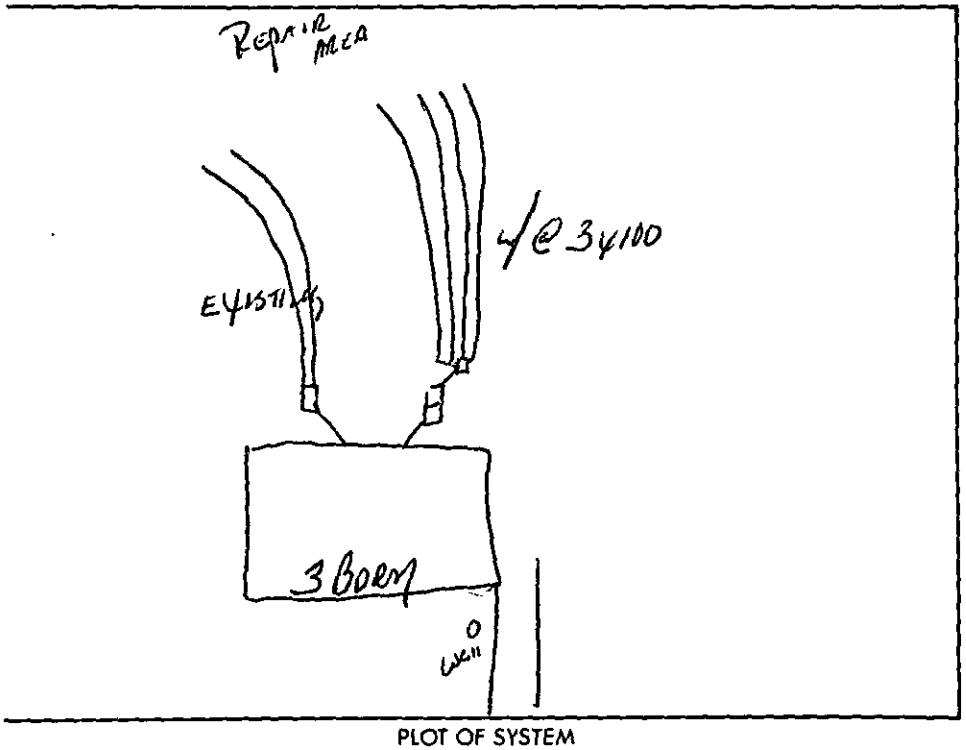

PLOT OF SYSTEM

Liquid Capacity of Septic Tank 1500 gallons

Liquid Capacity of Dosing Tank - gallons

Tank Construction PCC

Absorption and/or Nitrification Lines:

Trench Width 3 feet

Total Line Length 400 feet

Number of Lines 4

Depth of Stone 10 inches

Distance from House > 5 feet

Distance from Property Line > 10 feet

Distance from Well > 50 feet

NAME OF OWNER William H. Kiser

LOCATION OF PROPERTY 11601 McCorkle

Comments: Install 1,500 gal. ST, 3'x100' 4 trenches

Division or Section Head

Environmentalist

* If this permit is for the installation or construction of a new system, it must be signed by the division or a section head of the Mecklenburg County Health Department in order to be valid. Only the signature of the Environmentalist is required where an existing system is being altered or repaired.

WHITE - HEALTH DEPARTMENT'S COPY • CANARY - ENVIRONMENTALIST'S COPY • PINK - OWNER OR AGENT'S COPY

APPLICATION FOR AN IMPROVEMENT PERMIT

315

HEALTH DEPARTMENT
ENVIRONMENTAL HEALTH DIVISION
1200 BLYTHE BOULEVARD
CHARLOTTE, NC 28203
PHONE (704) 376-4603

Mecklenburg County services are available without regard to ethnic origin, sex, or disability.

(OFFICE USE ONLY)

FILE: 7308A

TC: _____

SERIAL: 21910 ☐ L ☐ CRT

JOB LOCATION

① ADDRESS: 1601 (STREET NO.) McCorkle (STREET) Rd. ② FILE: 7308A

③ JURISDICTION: _____ ④ TAX PARCEL NO.: 053-082-02

⑤ SUBDIVISION: _____ ⑥ LOT: _____ ⑦ BLOCK: _____

OWNER

⑧ NAME: William (FIRST) Henry (MIDDLE) Kiser II (LAST)

⑨ MAILING ADDRESS: 11921 McIntosh Dr

⑩ CITY: Huntersville ⑪ STATE: NC ⑫ ZIP: 28078

⑬ PHONE: (WORK) 372-6673 ⑭ (HOME) 875-2603

REQUEST

This request is for a(n):

⑮ ☑ New permit ⑰ ☐ Authorization for mobile home exchange

⑯ ☐ Repair or alteration permit ⑱ ☐ Other (specify) _____

DESIGN CRITERIA

System will serve:

⑲ ☑ Residence ⑳ ☐ Mobile home ㉑ ☐ Business or place of public assembly

㉒ Number of bedrooms? 3 ㉕ Type? _____

㉓ Maximum occupancy? 5 ㉖ Maximum number of employees? _____

㉔ Basement? ☐ yes ☑ no ㉗ Maximum number of seats? _____

WATER SUPPLY

㉘ Water supply from (present or proposed):

A ☑ Individual well

B ☐ Municipal system

C ☐ Community well

D ☐ Community system

IMPROVEMENT PERMIT

The undersigned, an authorized agent of the MECKLENBURG COUNTY HEALTH DEPARTMENT, certifies that the Department has approved the Request for the Job Location contained in this document. This approval is granted in accordance with the provisions of Laws And Rules For Sanitary Sewage Collection, Treatment And Disposal in effect at the time of issuance of the permit and is subject to the following provisions:

... No work shall be conducted on the septic tank system until an Installation, Construction, Alteration and/or Repair permit is issued by this Department.

... This permit is not transferable, and shall become null and void 36 60 months from the date of issuance.

JR 3/25/91
Environmentalist Date

_____
Director or Authorized Section Head Date

*This permit must be signed by the Director of Mecklenburg County Health Department or an authorized section head in order to be valid.

㉙ The undersigned, owner of the property described above as the "JOB LOCATION" has read the foregoing application, acknowledges that the contents of same are true, and authorizes agents of the MECKLENBURG COUNTY HEALTH DEPARTMENT to enter onto the property for the purpose of processing this request.

Signed: William H. Kiser II

Date: 3-18-91

INSTRUCTIONS

PLEASE PRINT OR TYPE ALL REQUESTED INFORMATION

ITEM(S) ....INSTRUCTIONS

① .....Indicate location of property for which the request is being made. Give **street number** and street or road name. If you do not know the street number, you must contact the Mecklenburg County Engineering Department to have one assigned.

② .....If a soil investigation has been run, copy the file number from the report. This may appear as SIR, ICAR(S) or APT numbers on older reports.

③ .....Indicate the jurisdiction in which the property is located. The jurisdiction is assigned by County Engineering.

④ .....Indicate the tax account or parcel number for the property (example 000-000-00). If the property is comprised of a portion of a large tract, precede the parcel number with the letters "PO."

⑤-⑦ .....Indicate the subdivision name and the lot and block numbers in the subdivision if applicable.

⑧-⑭ .....Indicate, in the requested format, the information as it pertains to the person to whom the permit should be issued.

⑮-⑱ .....Indicate the purpose of the request by placing an "X" in the appropriate box.

⑲-㉑ .....Indicate the type structure the system will serve by placing an "X" in the appropriate box.

- Residence means a single or multi-family dwelling (duplex, apartment, hotel, motel) or any other place where people reside.
- Mobile home means a trailer used as a residence that is designed without a permanent foundation and is capable of being moved to another location.
- Business or place of public assembly means non-residential use of buildings such as manufacturing, office space, warehousing operations, place of amusement or recreation, church, fairground, stadium, campground or any other place where people work or assemble.

㉒-㉖ .....If the system will serve a residence or a mobile home, indicate the number of bedrooms, the maximum occupancy of the residence and whether or not the structure will have a basement. When calculating the number of bedrooms include all rooms which are intended to be used as bedrooms or might later be furnished or converted to bedroom use and any additional bedrooms to be constructed in the future.

㉕-㉗ .....If the system will serve a business, indicate the type business, the maximum number of employees and the maximum number of seats to be provided. Include in these figures projections for future expansions.

㉘ .....Indicate the type water supply by placing an "X" in the appropriate box.

- Individual well means a well located on the lot, serving a building occupied by only one family or one business establishment and will not be a public place, a place of public gathering, or business which processes or manufactures any product which is used as, or is used in a food product.
- Municipal system means a water supply furnished by a city, county, town or other governmental authority.
- Community well means a privately owned water system originating from a well source.
- Community system means a privately owned water system originating from a source other than a well.

㉙ .....Once you have completed the application, read the certification statement in the lower, left hand corner. The statement must be signed, dated, and returned to the Department along with a Proposed Plot Plan and a copy of the Engineering Address Record prior to the issuance of any permits. **IN ORDER FOR YOU TO RECEIVE A COPY OF THE COMPLETED PERMIT FOR CONSTRUCTION, ALL COPIES OF THIS FORM MUST BE RETURNED TO THE ADDRESS LISTED ON THE FRONT OF THE APPLICATION.**


PROPOSED PLOT PLAN

HEALTH DEPARTMENT
ENVIRONMENTAL HEALTH DIVISION
1200 BLYTHE BOULEVARD
CHARLOTTE, NC 28203
PHONE (704) 376-4603

FILE: 7308 A

TC: ~~7308A~~ C53 -C32-C4

Draw in and name all roads adjoining the property. Draw in and accurately dimension the lot concerned. Accurately indicate property boundaries, proposed and/or existing structures and driveways, underground utilities, and wells and springs within 100 feet of the proposed building or drainfield.

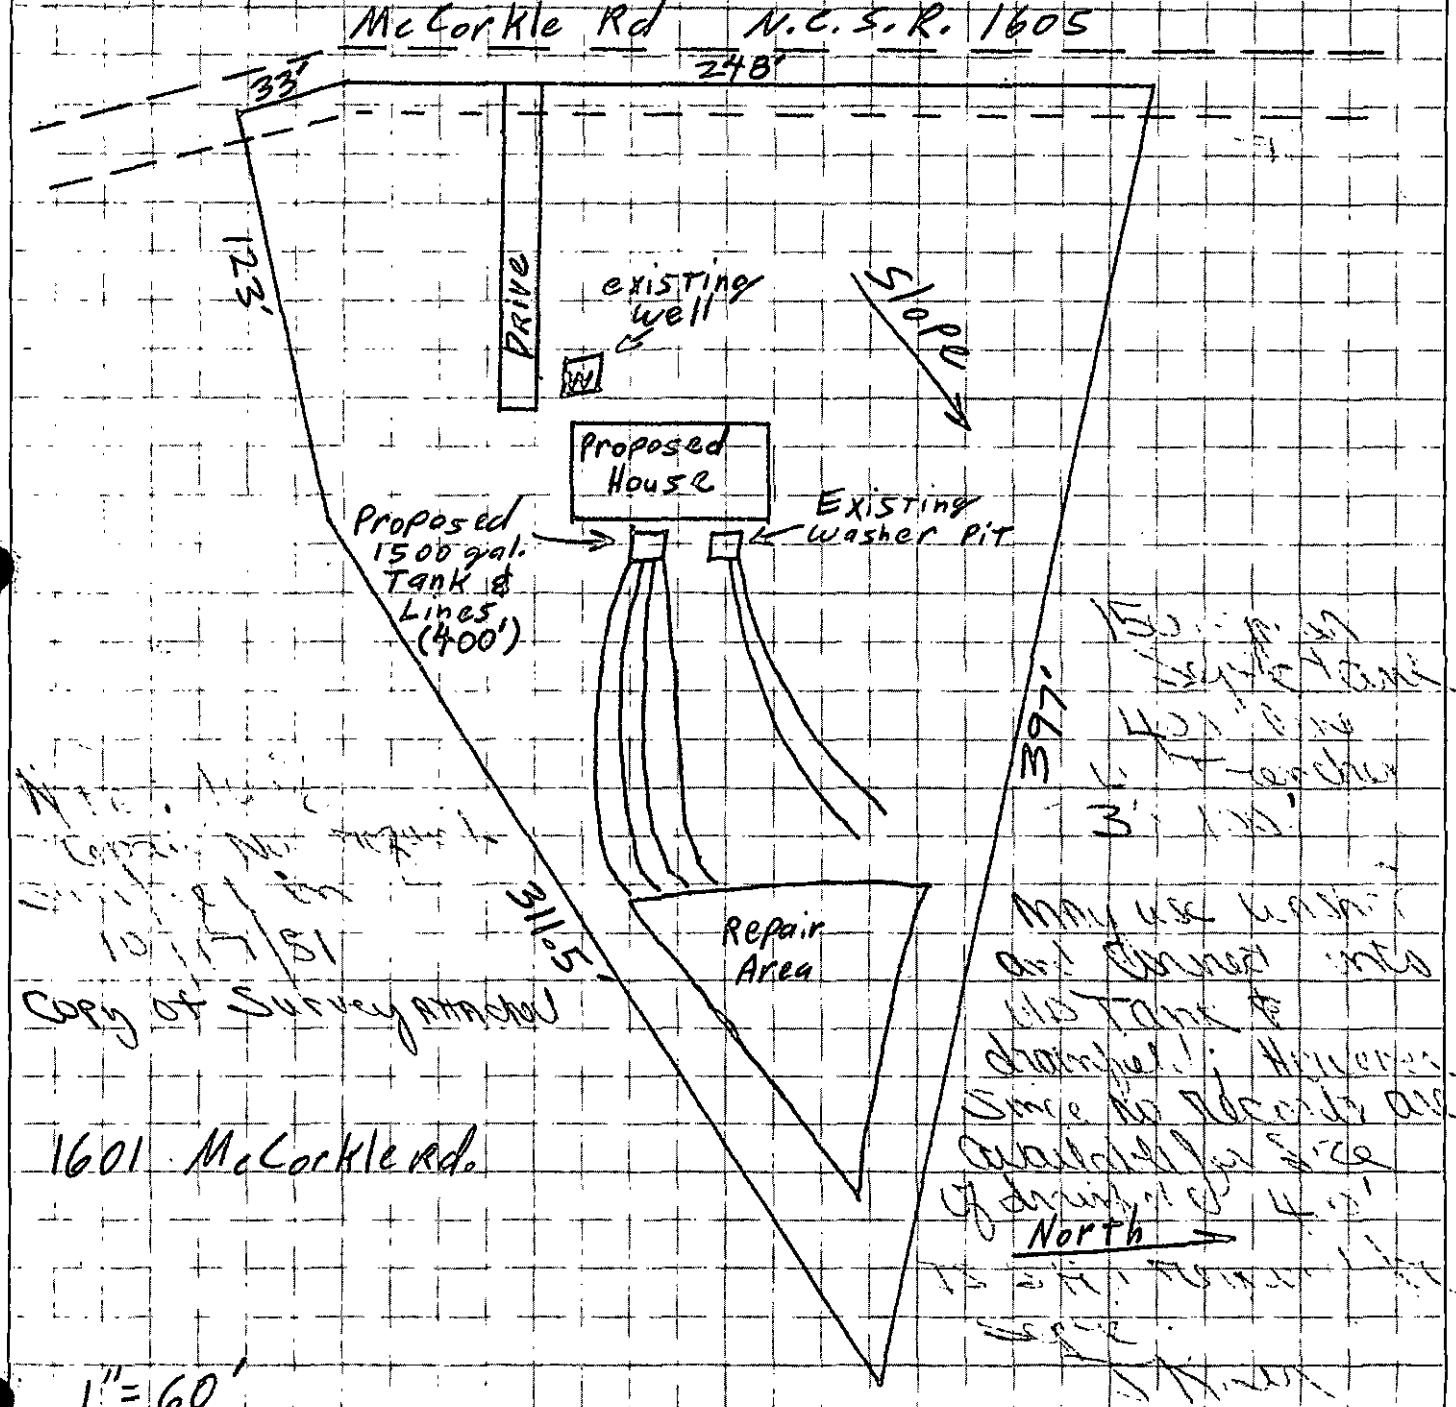

APPROVAL DATE _____

White - Health Department's Copy Canary - Environmentalist's Copy Pink - Owner's Copy

[redacted] COUNTY HEALTH DEPARTMENT

EVALUATION REPORT

INITIAL NUMBER 17035

Parcel: 053-062-02

PC

[redacted]ion: 1601 McConkle Rd

Subdivision:

Lot: Block: Acres: 1.0 ±


Owner: Blanche A. Wilkinson

Address: 10720 Moore's Chapel Rd.
Charlotte N.C.

Comments: Old system on lot - Tank may be inside footprint of proposed house - Recommend surface water diversion

Described by: William R. Marlin

Date: 3-6-91

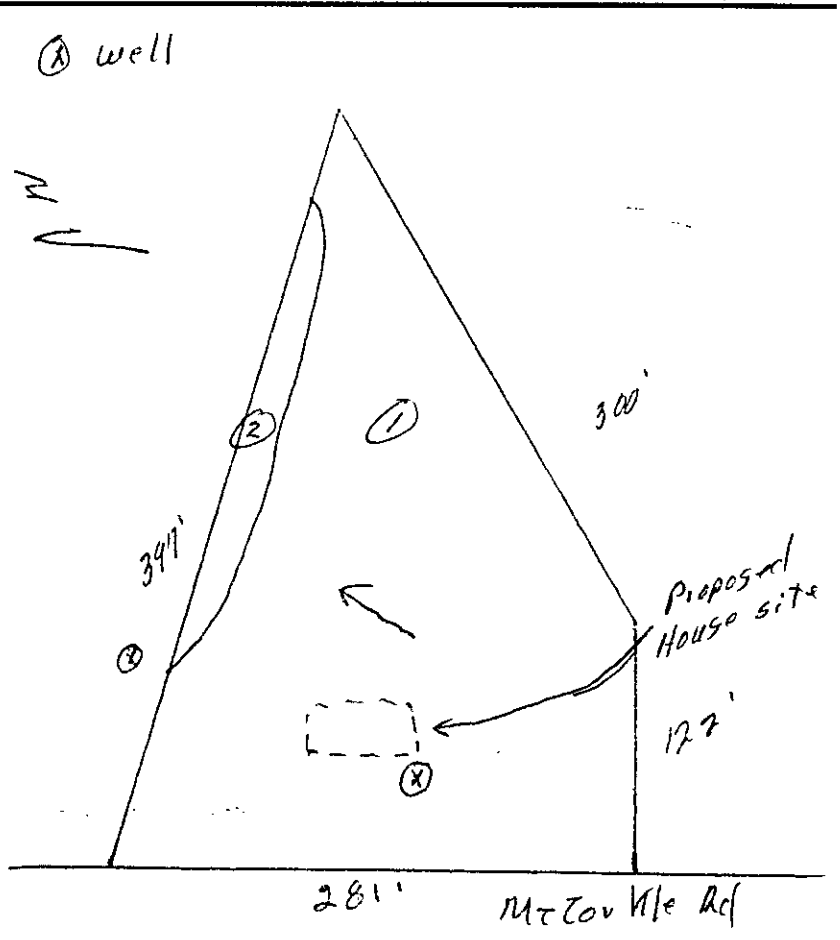

*** EVALUATION KEY ***

S = Suitable U = Unsuitable

PS = Provisionally Suitable

The "Area Classification" below indicates the suitability of areas in the diagram.

FACTORS	AREA 1	AREA 2	AREA 3	AREA 4	AREA 5	AREA 6
Topography	(S) PS U 2-12%	S PS (U) Slight Depression	S PS U	S PS U	S PS U	S PS U
Texture	S (PS) U Clay	S PS U	S PS U	S PS U	S PS U	S PS U
Structure	S (PS) U Blocky	S PS U	S PS U	S PS U	S PS U	S PS U
Drainage	(S) PS U 7+8" To Water	S PS U	S PS U	S PS U	S PS U	S PS U
Depth	(S) PS U 48"+	S PS U	S PS U	S PS U	S PS U	S PS U
Restrictive Horizons	(S) PS U 7+8"	S PS U	S PS U	S PS U	S PS U	S PS U
Available Space	S (PS) U somewhat limited	S PS U	S PS U	S PS U	S PS U	S PS U
O[redacted] (specify)	S PS U	S PS U	S PS U	S PS U	S PS U	S PS U
Soil Group/Series	III Cecil-Lilly	Depression				
Area Classification	S (PS) U	S PS (U)	S PS U	S PS U	S PS U	S PS U

MECKLENBURG COUNTY HEALTH DEPARTMENT
SITE EVALUATION REPORT
SERIAL NUMBER 17035

File:

Action X I

Parcel:

☐ PC

Location:

Subdivision:

Lot: Block: Acres:

Owner:
Address:

Comments: _____


_____

_____

_____

Described by: _____

Date: _____

 

***** EVALUATION KEY *****

S = Suitable U = Unsuitable
PS = Provisionally Suitable
The "Area Classification" below indicates the suitability of areas in the diagram.

FACTORS	AREA 1	AREA 2	AREA 3	AREA 4	AREA 5	AREA 6
Topography	S PS U	S PS U	S PS U	S PS U	S PS U	S PS U
Texture	S PS U	S PS U	S PS U	S PS U	S PS U	S PS U
Structure	S PS U	S PS U	S PS U	S PS U	S PS U	S PS U
Drainage	S PS U	S PS U	S PS U	S PS U	S PS U	S PS U
Depth	S PS U	S PS U	S PS U	S PS U	S PS U	S PS U
Restrictive Horizons	S PS U	S PS U	S PS U	S PS U	S PS U	S PS U
Available Space	S PS U	S PS U	S PS U	S PS U	S PS U	S PS U
Other (specify)	S PS U	S PS U	S PS U	S PS U	S PS U	S PS U
Soil Group/Series						
Area Classification	S PS U	S PS U	S PS U	S PS U	S PS U	S PS U

APPLICATION FOR AN IMPROVEMENT PERMIT

HEALTH DEPARTMENT
ENVIRONMENTAL HEALTH DIVISION
1200 BLYTHE BOULEVARD
CHARLOTTE, NC 28203
PHONE (704) 376-4603

Mecklenburg County services are available without regard to ethnic origin, sex, or disability.

(OFFICE USE ONLY)
FILE: 7308A
TC: _____
SERIAL: № 21810
☐ L ☑ CRT

JOB LOCATION

① ADDRESS: 1601 (STREET NO.) McCorkle Rd. (STREET) ② FILE: 7308A
③ JURISDICTION: _____ ④ TAX PARCEL NO.: 053-082-02
⑤ SUBDIVISION: _____ ⑥ LOT: _____ ⑦ BLOCK: _____

OWNER

⑧ NAME: William (FIRST) Henry (MIDDLE) Kiser II (LAST)
⑨ MAILING ADDRESS: 11921 McIntosh Dr
⑩ CITY: Huntersville ⑪ STATE: NC ⑫ ZIP: 28078
⑬ PHONE: (WORK) 372-6673 ⑭ (HOME) 875-2603

REQUEST

This request is for a(n):

⑮ ☑ New permit
⑯ ☐ Repair or alteration permit
⑰ ☐ Authorization for mobile home exchange
⑱ ☐ Other (specify) _____

DESIGN CRITERIA

System will serve:

⑲ ☑ Residence ⑳ ☐ Mobile home ㉑ ☐ Business or place of public assembly
㉒ Number of bedrooms? 3 ㉕ Type? _____
㉓ Maximum occupancy? 5 ㉖ Maximum number of employees? _____
㉔ Basement? ☐ yes ☑ no ㉗ Maximum number of seats? _____

WATER SUPPLY

㉘ Water supply from (present or proposed):

A ☑ Individual well
B ☐ Municipal system
C ☐ Community well
D ☐ Community system

㉙ The undersigned, owner of the property described above as the "JOB LOCATION" has read the foregoing application, acknowledges that the contents of same are true, and authorizes agents of the MECKLENBURG COUNTY HEALTH DEPARTMENT to enter onto the property for the purpose of processing this request.

Signed: William H. Kiser II
Date: 3-18-91

IMPROVEMENT PERMIT

The undersigned, an authorized agent of the MECKLENBURG COUNTY HEALTH DEPARTMENT, certifies that the Department has approved the Request for the Job Location contained in this document. This approval is granted in accordance with the provisions of Laws And Rules For Sanitary Sewage Collection, Treatment And Disposal in effect at the time of issuance of the permit and is subject to the following provisions:

... No work shall be conducted on the septic tank system until an Installation, Construction, Alteration and/or Repair permit is issued by this Department.

... This permit is not transferable, and shall become null and void 60 months from the date of issuance.

Judy J. Kiser R.S. 3/25/91
Environmentalist — Date

[signature] 3/26/91
Director or Authorized Section Head — Date

*This permit must be signed by the Director of Mecklenburg County Health Department or an authorized section head in order to be valid.

MECKLENBURG COUNTY HEALTH DEPARTMENT
ENVIRONMENTAL HEALTH DIVISION

CHARGE SLIP

Date: 03/18/91

Name/Company: William H. Kiser

Sanitation _____

Vector Control _____

O.P.W.D. ✓

Fire # 7308A

MECKLENBURG COUNTY
HEALTH DEPARTMENT
ENVIRONMENTAL HEALTH DIVISION
PAID
MAR 18 1991

CK #2583

Fee: $200.00 #200.00

NOTICE:

A processing fee of $15.00 will be charged for all returned checks in accordance with N.C. General Statute 25-3-512.

Completed by

Collected by


PROPOSED PLOT PLAN

HEALTH DEPARTMENT
ENVIRONMENTAL HEALTH DIVISION
1200 BLYTHE BOULEVARD
CHARLOTTE, NC 28203
PHONE (704) 376-4603

FILE: 7308 A

TC: ~~7308A~~ 053-082-01

Draw in and name all roads adjoining the property. Draw in and accurately dimension the lot concerned. Accurately indicate property boundaries, proposed and/or existing structures and driveways, underground utilities, and wells and springs within 100 feet of the proposed building or drainfield.

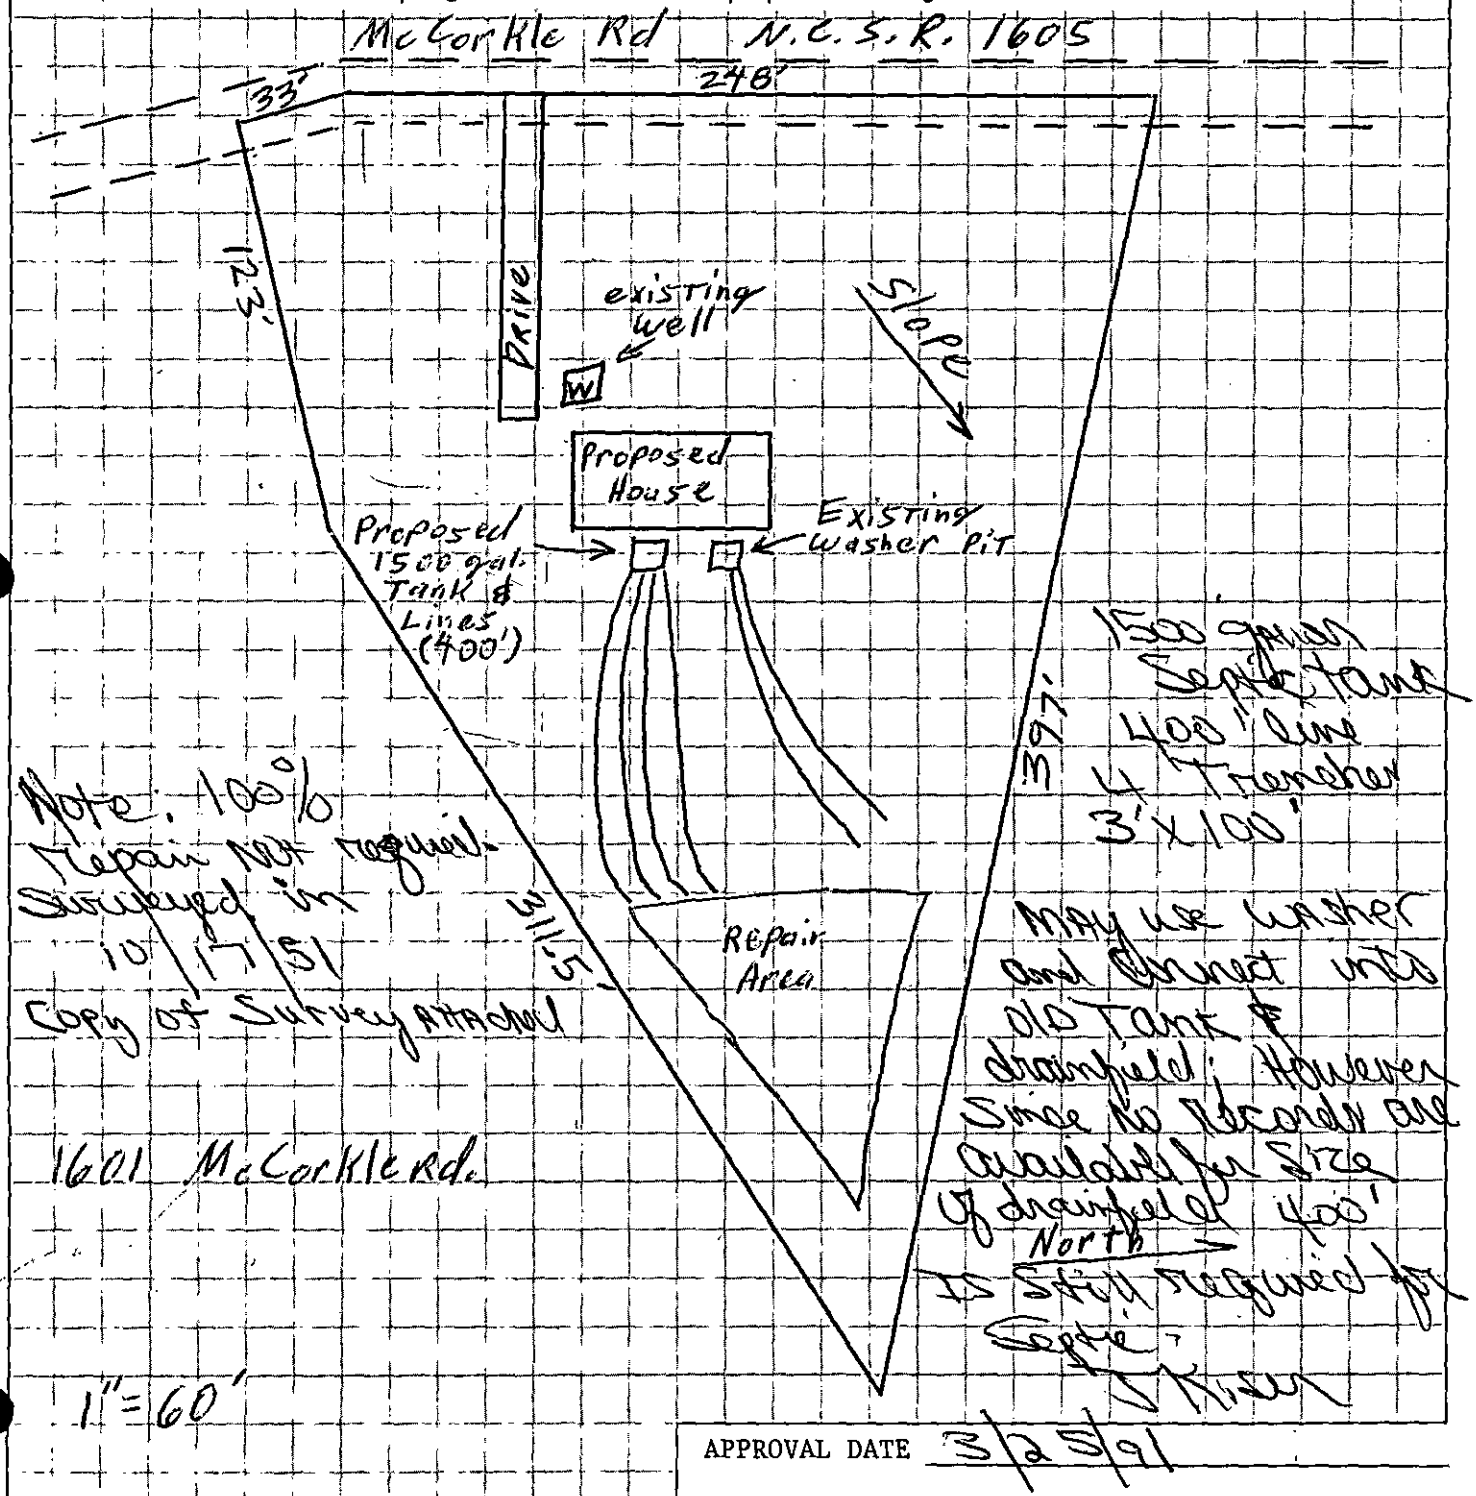


APPROVAL DATE 3/25/91

White - Health Department's Copy Canary - Environmentalist's Copy Pink - Owner's Copy

THIS IS TO CERTIFY THAT ON THE 17 DAY OF October 19 51, I SURVEYED THE PROPERTY SHOWN ON THIS PLAT, AND THAT THE PROPERTY LINES, WALLS AND BUILDINGS ARE AS SHOWN HEREON; THAT THE BUILDINGS LOCATED ON SAID LOT DO NOT ENCROACH OR PROJECT ON ADJACENT STREETS OR PROPERTY; AND THAT NO ADJACENT BUILDINGS OR WALLS ENCROACH OR PROJECT ON SAID PREMISES.

J. W. SPRATT. COUNTY SURVEYOR
FOR MECKLENBURG COUNTY, N. C.

SIGNED J. W. SPRATT, C.S.

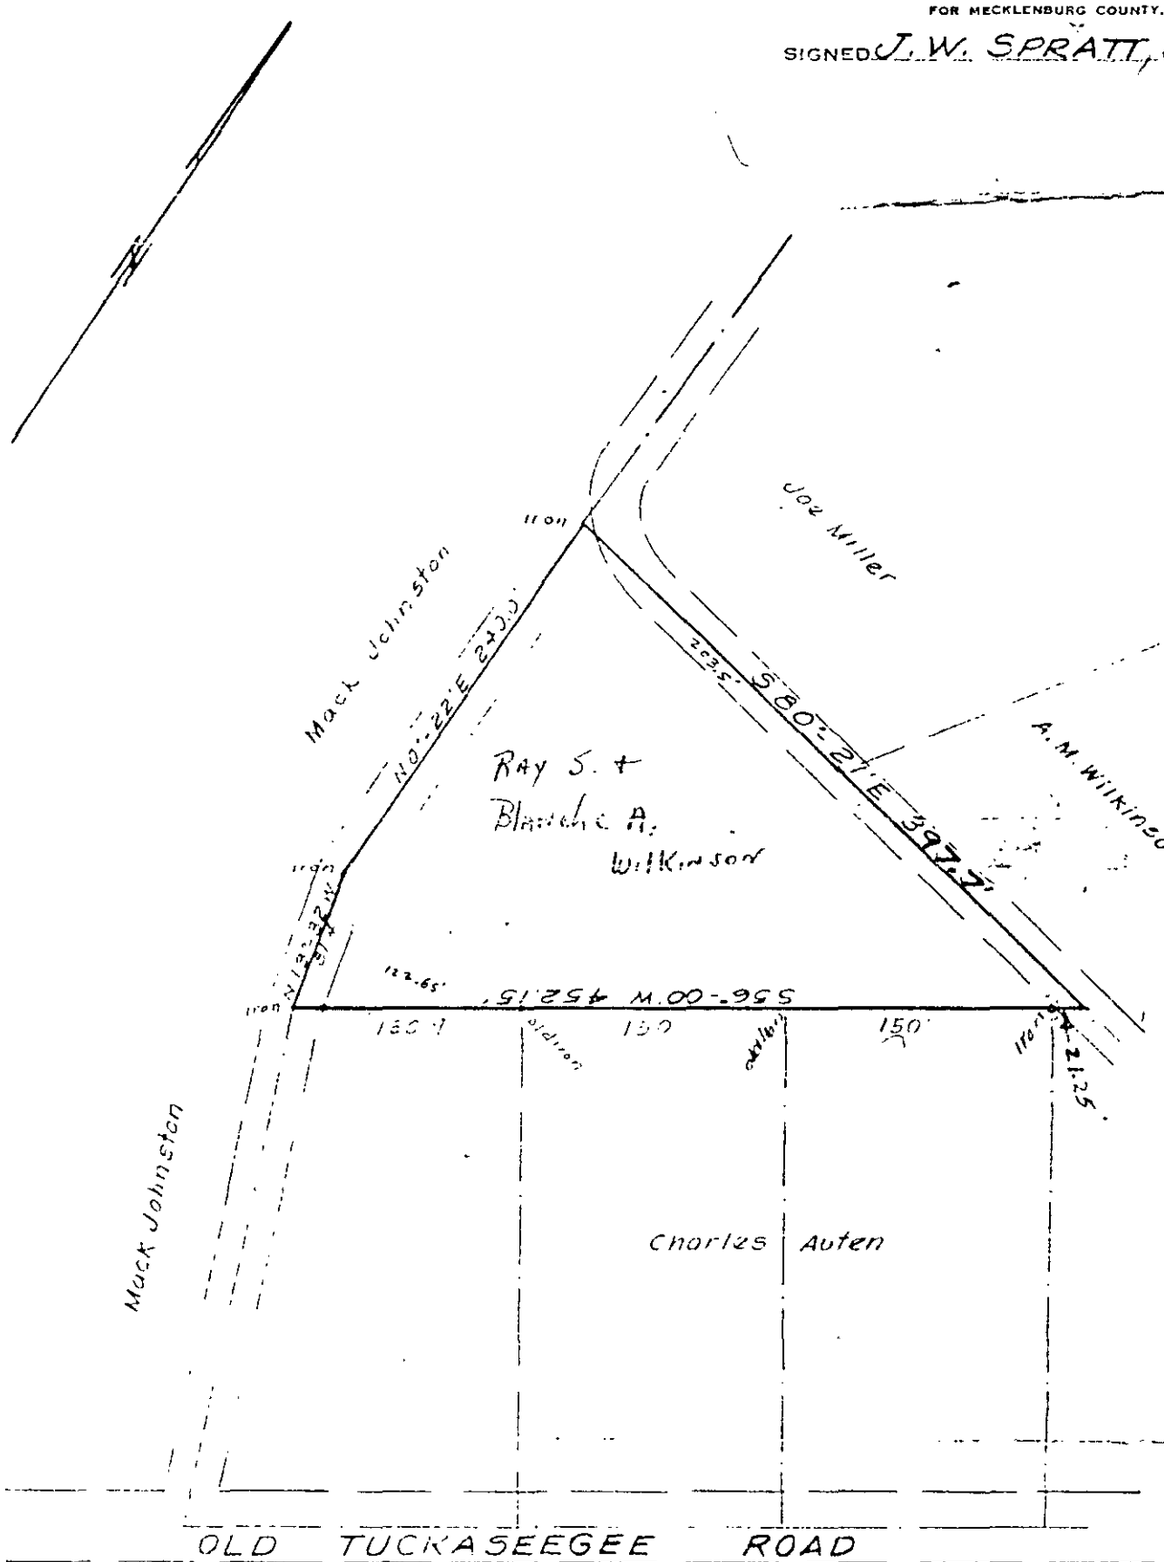

PHYSICAL SURVEY

OF

1.48 Acres

CHARLOTTE, N. C.

PROPERTY OF

R. S. WILKINSON

From
A. M. Wilkinson &
Ferrie Sa"

SCALE 1" = 100' DEED RECORDED MAP RECORDED

TO: ENVIRONMENTAL HEALTH DEPT.
BUILDING STANDARDS DEPT.
DEPT. OF ENVIRONMENTAL PROTECTION/
SOLID AND HAZARDOUS WASTE

DATE 3/26/91

FROM: COUNTY ENGINEERING DEPARTMENT

MED FILE _____ JURISDICTION CODE Meck

PARCEL NUMBER 053-082-02

ASSIGNED ADDRESS 1601 McCocklie Rd

EXISTING ADDRESS _____

PROJECT NAME N/A

THE ABOVE DESCRIBED LOCATION HAS BEEN CHECKED CONCERNING:

	APPROVED	DISAPPROVED
1. SUBDIVISION REGULATIONS	/ /	/ /*
2. FLOODWAY REGULATIONS	/ /	/ /*
3. EROSION CONTROL REGULATIONS	/ /	/ /*
4. PUBLIC UTILITY EASEMENT	/ /	/ /*

	PRESENT	NOT PRESENT
5. PUBLIC UTILITY EASEMENT	/ /*	/ /
6. PROPERTY FRONTS ON THOROUGHFARE	/ /*	/ /
7. DRIVEWAY PERMIT REQUIRED	/ /*	/ /

*If checked, further investigation will be required to determine whether a building permit can be issued by Building Standards for the site.

REMARKS: 1

NOTE: THIS FORM MUST BE TURNED IN AT THE CASHIER'S OFFICE AT BUILDING STANDARDS WHEN PAYING PERMIT FEES.
A CERTIFICATE OF OCCUPANCY WILL NOT BE GRANTED UNTIL THE TRANSPORTATION DIVISION GRANTS FINAL APPROVAL ON DRIVEWAY(S).

SIGNED: _____

OFWEAR 06-88

NEW ADDRESS / /*

FORM 100

Mecklenburg County
Health Department

March 9th, 1991

Blanche Auten Wilkinson
10720 Moore's Chapel Road
Charlotte, NC 28214

RE: Property located at 1601 McCorkle Road
FILE: 7308A
PARCEL: 053-082-02

Dear Sir:

At your request, a field investigation was conducted on the property designated above for the purpose of determining site suitability for the installation of a ground absorption sewage disposal system. The property was found to contain a limited area of soils which were classified as PROVISIONALLY SUITABLE for such an installation. A copy of the Site Evaluation Report (Serial Number 17035) is enclosed for your information.

Should you desire to file for permission to install a ground absorption sewage disposal system, please submit an Application For An Improvement Permit with an ACCURATELY dimensioned plot plan detailing the location of current and/or proposed buildings, wells and sewage disposal systems to this office. The plan will be reviewed and if it is found that the area of provisionally suitable soils is adequate for the proposed construction, an Improvement Permit will be issued by this Department.

If there are any questions concerning this matter, do not hesitate to contact me.

Sincerely,

Gene Vaughan, R.S., Supervisor
Individual Water and Wastewater Systems

Enclosure

Environmental Health Division
1200 Blythe Boulevard • Charlotte, North Carolina 28203 • (704) 376-4603

MECKLENBURG COUNTY HEALTH DEPARTMENT
SITE EVALUATION REPORT
SERIAL NUMBER 17035

File: 7308A

Action: X 1

Parcel: 053-082-07

PC

Location: 1601 McConkle Rd

Subdivision:


Lot: Block: Acres: 1.0 ±

Owner: Blanche A. Wilkinson
Address: 10720 Moore's Chapel Rd.
Charlotte N.C.

Comments: Old system on lot - Tank may be inside footprint of proposed house. Recommend surface water diversion

Described by: William R. Marlin

Date: 3-6-91

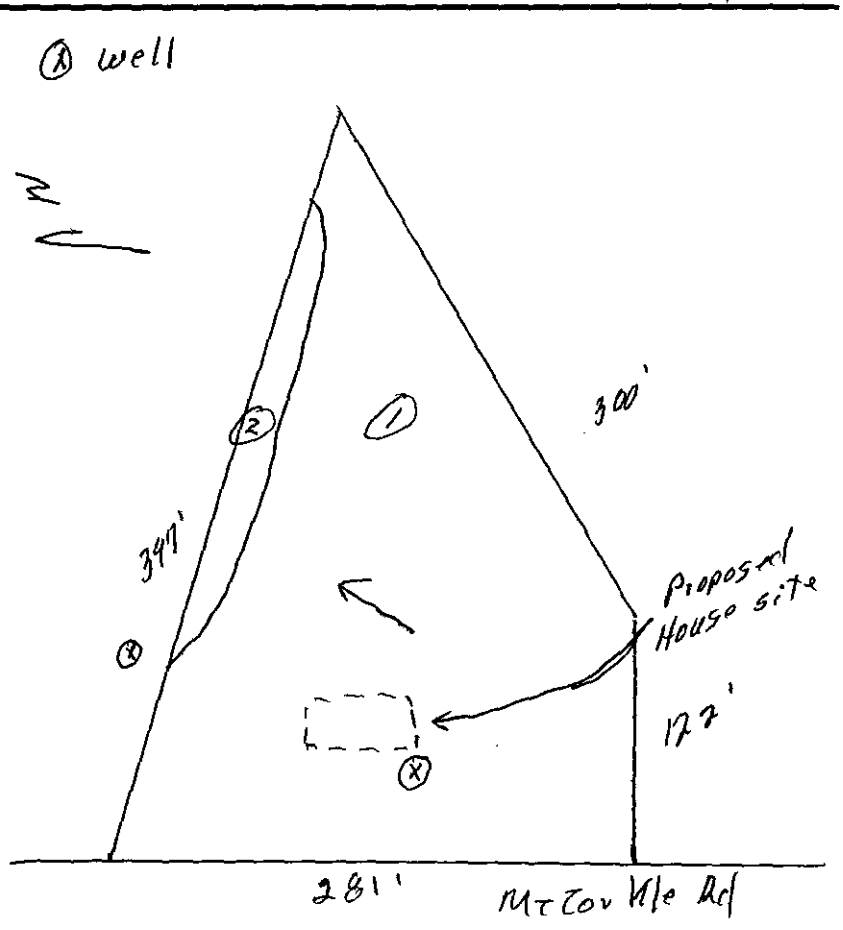

*** EVALUATION KEY ***

S = Suitable U = Unsuitable
PS = Provisionally Suitable
The "Area Classification" below indicates the suitability of areas in the diagram.

FACTORS	AREA 1	AREA 2	AREA 3	AREA 4	AREA 5	AREA 6
Topography	(S) PS U 2-12%	S PS (U) Slight Depression	S PS U	S PS U	S PS U	S PS U
Texture	S (PS) U clay	S PS U	S PS U	S PS U	S PS U	S PS U
Structure	S (PS) U Blocky	S PS U	S PS U	S PS U	S PS U	S PS U
Drainage	(S) PS U 7+8" To Water	S PS U	S PS U	S PS U	S PS U	S PS U
Depth	(S) PS U 48"+	S PS U	S PS U	S PS U	S PS U	S PS U
Restrictive Horizons	(S) PS U 7+8"	S PS U	S PS U	S PS U	S PS U	S PS U
Available Space	S (PS) U somewhat limited	S PS U	S PS U	S PS U	S PS U	S PS U
Other (specify)	S PS U	S PS U	S PS U	S PS U	S PS U	S PS U
Soil Group/Series	III Cecil-Lilly	Depression				
Area Classification	S (PS) U	S PS (U)	S PS U	S PS U	S PS U	S PS U

APPLICATION FOR SOIL INVESTIGATION

HEALTH DEPARTMENT
ENVIRONMENTAL HEALTH DIVISION
1200 BLYTHE BOULEVARD
CHARLOTTE, NC 28203
PHONE (704) 376-4603

(OFFICE USE ONLY)

FILE: 7308A

TC: 053-08202

☐ PC ☐ REPT

JOB LOCATION

① ADDRESS: 1601 McCorkle Rd

② SUBDIVISION: _____ ③ LOT: _____ ④ BLOCK: _____

⑤ PARCEL REFERENCE: BOOK NO.: 053 PAGE NO.: 082 PARCEL NO.: 02

⑥ DEED REFERENCE: BOOK NO.: 1530 PAGE NO.: 0282

OWNER

⑦ NAME: Blanche (FIRST) Auten (MIDDLE) Wilkinson (LAST)


⑧ MAILING ADDRESS: 10720 Moore's Chapel Rd.

⑨ CITY: Charlotte ⑩ STATE: NC ⑪ ZIP: 28214

⑫ PHONE: (WORK) N/A (HOME) 399-9888

⑬ Accurately diagram and dimension lot.

old system on lot
surface diversion
detached mobile w/ 4 bdrm
house proposed

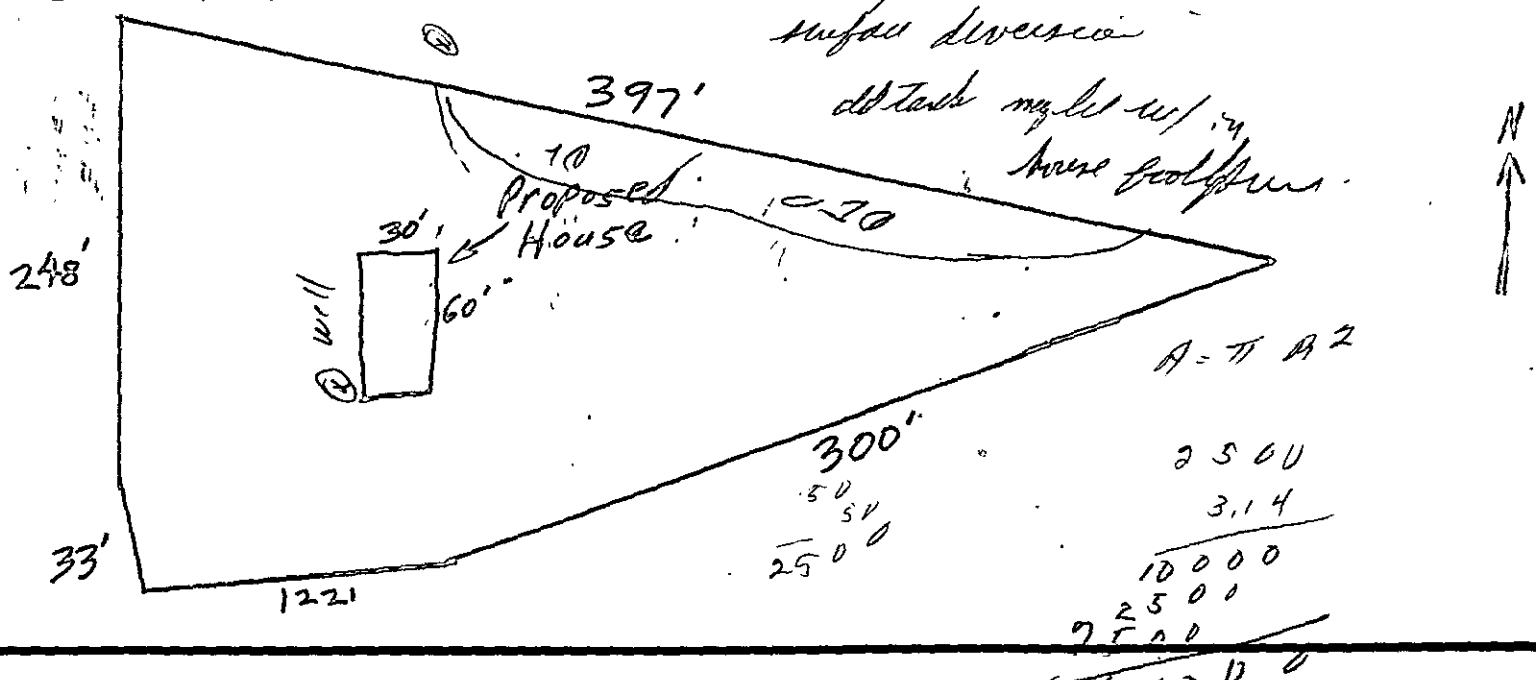

⑭ The undersigned, owner of the property described above as the "JOB LOCATION" has read the foregoing application, acknowledges that the contents of same are true, and authorizes agents of the MECKLENBURG COUNTY HEALTH DEPARTMENT to enter onto the property for the purpose of processing this request.

Signed: Blanche A. Wilkinson

Mecklenburg County services are available without regard to ethnic origin, sex, or disability.

Date: March 4, 1991.

WHITE - HEALTH DEPARTMENT'S COPY • CANARY - ENVIRONMENTALIST'S COPY • PINK - OWNER'S COPY

APPLICATION FOR SOIL INVESTIGATION

HEALTH DEPARTMENT
ENVIRONMENTAL HEALTH DIVISION
1200 BLYTHE BOULEVARD
CHARLOTTE, NC 28203
PHONE (704) 376-4603

(OFFICE USE ONLY)

FILE: 7308A

TC: 053-0282-02

☑ PC ☐ REPT

JOB LOCATION

① ADDRESS: 1601 McCorkle Rd

② SUBDIVISION: _____ ③ LOT: _____ ④ BLOCK: _____

⑤ PARCEL REFERENCE: BOOK NO.: 053 PAGE NO.: 082 PARCEL NO.: 02

⑥ DEED REFERENCE: BOOK NO.: 1530 PAGE NO.: 0282

OWNER


⑦ NAME: Blanche (FIRST) Auten (MIDDLE) Wilkinson (LAST)

⑧ MAILING ADDRESS: 10720 Moore's Chapel Rd.

⑨ CITY: Charlotte ⑩ STATE: NC ⑪ ZIP: 28214

⑫ PHONE: (WORK) N/A (HOME) 399-9888

⑬ Accurately diagram and dimension lot.

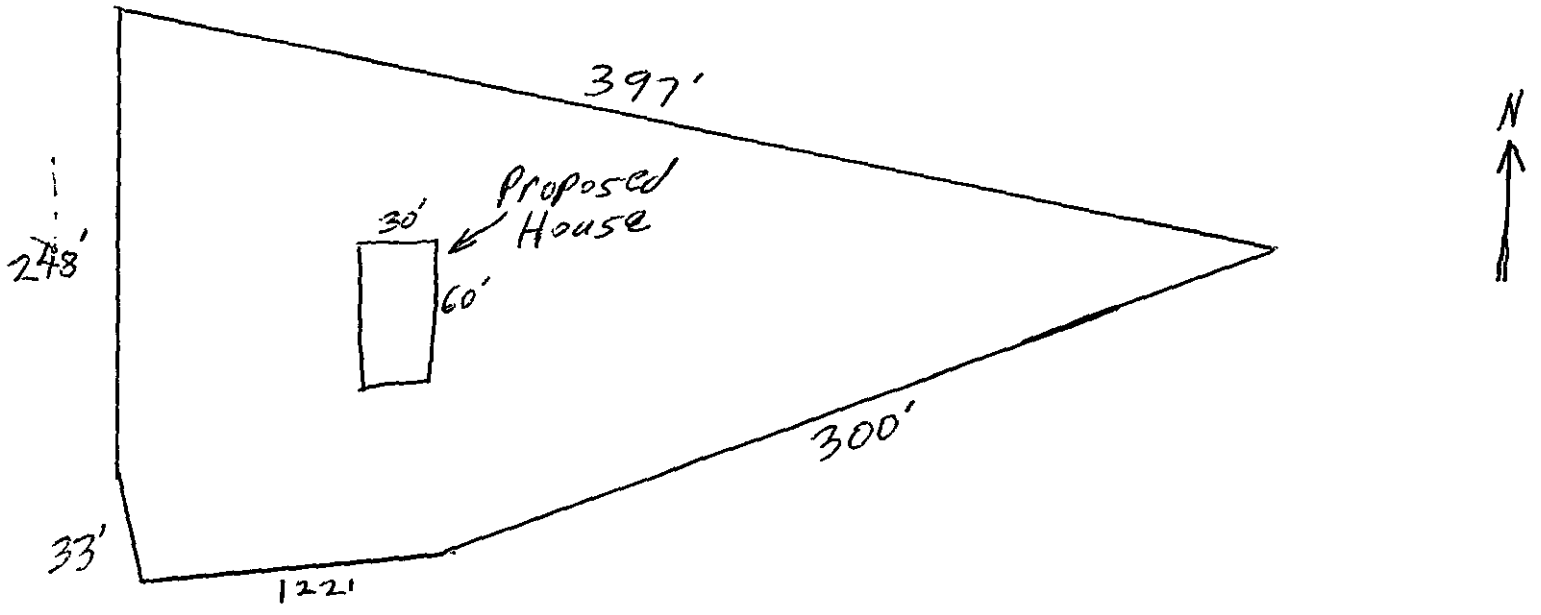

⑭ The undersigned, owner of the property described above as the "JOB LOCATION" has read the foregoing application, acknowledges that the contents of same are true, and authorizes agents of the MECKLENBURG COUNTY HEALTH DEPARTMENT to enter onto the property for the purpose of processing this request.

Signed: Blanche A. Wilkinson

Date: March 4, 1991

Mecklenburg County services are available without regard to ethnic origin, sex, or disability.

WHITE - HEALTH DEPARTMENT'S COPY • CANARY - ENVIRONMENTALIST'S COPY • PINK - OWNER'S COPY

MECKLENBURG COUNTY HEALTH DEPARTMENT
ENVIRONMENTAL HEALTH DIVISION

CHARGE SLIP

Date: 03/05/91

Name/Company: Duncan N. Kirkpatrick

Sanitation _____

Vector Control _____

O.P.W.D. ✓

Service: Well test
Fee # 7308A PO
1601 McCullough Rd

MECKLENBURG COUNTY
HEALTH DEPARTMENT
ENVIRONMENTAL HEALTH DIVISION
PAID

MAR 5 1991

Fee: $ 50.00 Ck# 2570 $50.00

NOTICE:

A processing fee of $15.00 will be charged for all returned checks in accordance with N.C. General Statute 25-3-512.

Completed by

Collected by

APPLICATION FOR SOIL INVESTIGATION

HEALTH DEPARTMENT
ENVIRONMENTAL HEALTH DIVISION
1200 BLYTHE BOULEVARD
CHARLOTTE, NC 28203
PHONE (704) 376-4603

(OFFICE USE ONLY)

FILE: M308A

TC: 053-08202

☐ PC ☐ REPT

JOB LOCATION

① ADDRESS: 1601 McCorkle rd

② SUBDIVISION: _____ ③ LOT: _____ ④ BLOCK: _____

⑤ PARCEL REFERENCE: BOOK NO.: 053 PAGE NO.: 082 PARCEL NO.: 02

⑥ DEED REFERENCE: BOOK NO.: 1530 PAGE NO.: 0282

OWNER


⑦ NAME: Blanche (FIRST) Auten (MIDDLE) Wilkinson (LAST)

⑧ MAILING ADDRESS: 10720 Moores Chapel Rd.

⑨ CITY: Charlotte ⑩ STATE: NC ⑪ ZIP: 28214

⑫ PHONE: (WORK) N/A (HOME) 399-9888

⑬ Accurately diagram and dimension lot.

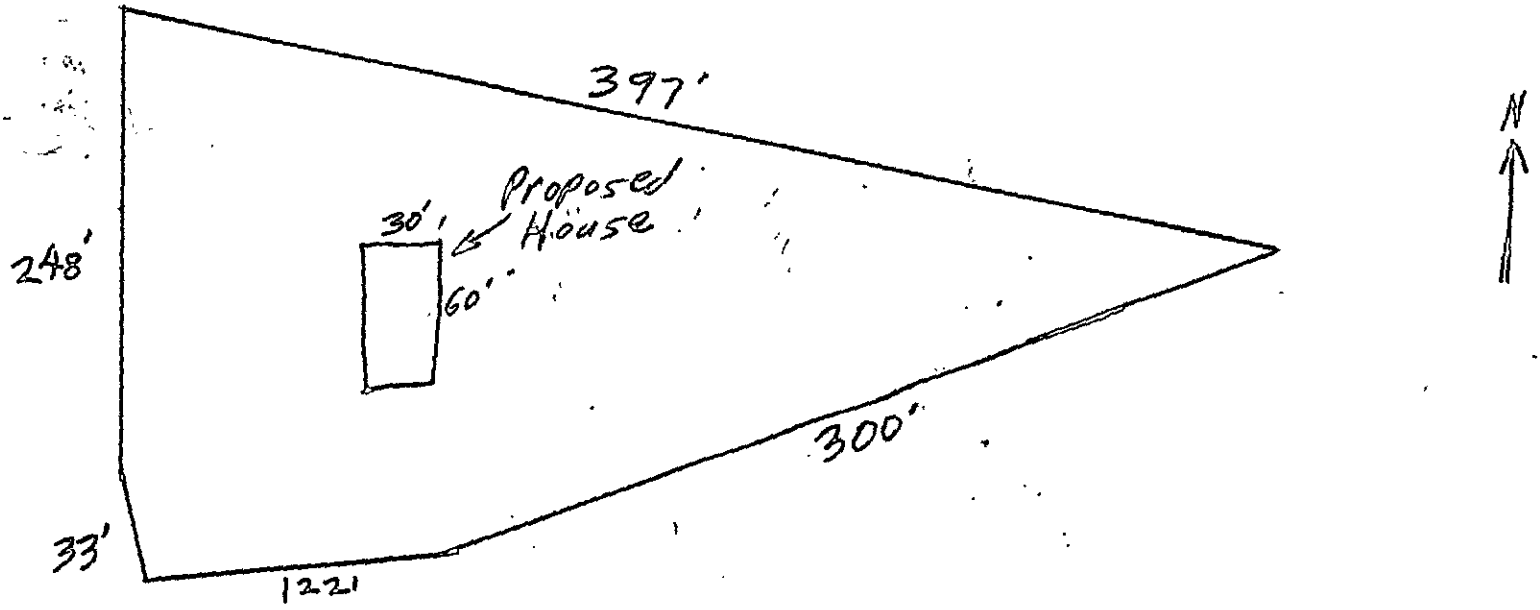

⑭ The undersigned, owner of the property described above as the "JOB LOCATION" has read the foregoing application, acknowledges that the contents of same are true, and authorizes agents of the MECKLENBURG COUNTY HEALTH DEPARTMENT to enter onto the property for the purpose of processing this request.

Signed: Blanche A. Wilkinson

Date: March 4, 1991.

Mecklenburg County services are available without regard to ethnic origin, sex, or disability.

WHITE - HEALTH DEPARTMENT'S COPY • CANARY - ENVIRONMENTALIST'S COPY • PINK - OWNER'S COPY