

10825 WINDY GROVE RD

11325102

1/4/2008

duponbj

Groundwater and Wastewater Services File Imaging Project
May 2007
Barcode Font = IDAutomationHC39M

FEE: 100.00
DATE: 1/11/2006
CRT#: Check #10325 JKA

APPLICATION FOR APPROVAL TO USE AN EXISTING ON-SITE WASTEWATER TREATMENT & DISPOSAL SYSTEM
MECKLENBURG COUNTY - GROUNDWATER & WASTEWATER SERVICES

700 N. Tryon St., Suite 211 Charlotte, NC 28202
Phone: (704) 336-5103 Fax: (704) 336-6894

GWS – UES.APP 01/05

FILE #: [illegible]

ASE HD 162060

TYPE APPLCATION:

☐ ADDITION - INCREASE ROOMS/OCCUPANCY/MOBILE HOME SIZE (A / M)
☐ ADDITION - RENOVATION OR GARAGE WITH NO MAJOR CHANGES (X)
☐ EXCHANGE MOBILE HOME - SAME # BEDROOMS (Y)
☐ COMMERCIAL OR INDUSTRIAL (N)

PERSON FILING APPLICATION:

NAME: Keith Thompson
ADDRESS: 10825 Windy Grove Rd
CITY: Charlotte
STATE: NC ZIP: 28278
PHONE: (704) 391-2333
ALTERNATE PHONE:

PROPERTY OWNER:

NAME: ← SAME
ADDRESS:
CITY:
STATE: ZIP:
PHONE:
ALTERNATE PHONE:

JOB LOCATION INFORMATION

TAX/PARCEL #: 11325102
STREET ADDRESS: Same
CITY:
STATE: NC ZIP:
SUBDIVISION OR MOBILE HOME PARK NAME:
LOT #:

TOWNSHIP:

☒ 0-MECKLENBURG
☒ 1-CHARLOTTE
☐ 2-DAVIDSON
☐ 3-CORNELIUS
☐ 4-PINEVILLE
☐ 5-MATTHEWS
☐ 6-HUNTERSVILLE
☐ 7-MINT HILL

WATER SUPPLY:

☐ MUNICIPAL (M) ☐ COMMUNITY (C) ☒ PRIVATE WELL (P) ☐ SHARED WELL (S) ☐ OTHER 'SPRINGS' (O)

RESIDENTIAL PROPERTY TYPE:

☒ HOUSE (H) ☐ MODULAR HOME (M) ☐ MULTIPLE FAMILY (U)
☐ SINGLE MOBILE HOME (S) ☐ DOUBLE WIDE (D)
☐ OTHER (O)

NUMBER OF BEDROOMS:
NUMBER OF OCCUPANTS:

COMMERCIAL / INDUSTRIAL PROPERTY TYPE:

TYPE OF BUSINESS:
EMPLOYEES PER SHIFT:
OF SHIFTS:

INDUSTRIAL WASTES? ☐ YES ☐ NO
UNDERGROUND STORAGE TANKS? ☐ YES ☐ NO

ADDITION TYPE ATTACHED TO EXISTING STRUCTURE:

☐ BEDROOM ☐ BATHROOM ☐ KITCHEN ☐ DINING ROOM ☐ LIVING ROOM ☐ DEN
☐ GARAGE ☐ SUNROOM ☐ PORCH ☐ DECK ☒ OTHER Carport

ADDITION TYPE DETACHED FROM EXISTING STRUCTURE:

☐ DETACHED GARAGE ☐ DETACHED GARAGE WITH PLUMBING ☐ POOL HOUSE ☐ SHOP ☐ BARN
☐ STORAGE SHED ☐ DETACHED PORCH / DECK ☐ OTHER

*The undersigned, owner, or legal agent for the owner, of the property described above as the "Job Location" has read the foregoing application, acknowledges that the contents of same are true, and authorizes the Mecklenburg County Health Department to enter onto the property for the purpose of processing this request.

Keith Thompson — 1-11-06
Owner's/Agent's Signature — Date

*The undersigned, an authorized agent of the Mecklenburg County Health Department, certifies that the Department has approved the Request for the Job Location contained in this document. This approval is granted in accordance with the provisions of Laws and Rules for Sanitary Sewage Collection, Treatment and Disposal in effect at the time of issuance of the permit and is subject to the following provisions:

- No work shall be conducted on the septic tank system until an installation, construction, alteration and/or repair approval is granted by this Department.
- This permit is not transferable.

☐ ADDITION / RENOVATION APPROVAL - VALID 1 YEAR FROM ISSUANCE
☐ MOBILE HOME EXCHANGE APPROVAL - VALID 6 MONTHS FROM ISSUANCE

Use Existing System
System OK 1/12/06
[illegible] EHS CS
EHS Signature — Date


PROPOSED PLOT PLAN

HEALTH DEPARTMENT
ENVIRONMENTAL HEALTH DIVISION
700 NORTH TRYON ST., SUITE 211
CHARLOTTE, NC 28202
PHONE (704) 336-5103

FILE: 4152B

TC: 113-251-02

Draw in and name all roads adjoining the property. Draw in and accurately dimension the lot concerned. Accurately indicate property boundaries proposed and/or existing structures and driveways, underground utilities, and wells and springs within 100 feet of the proposed building or drainfield.

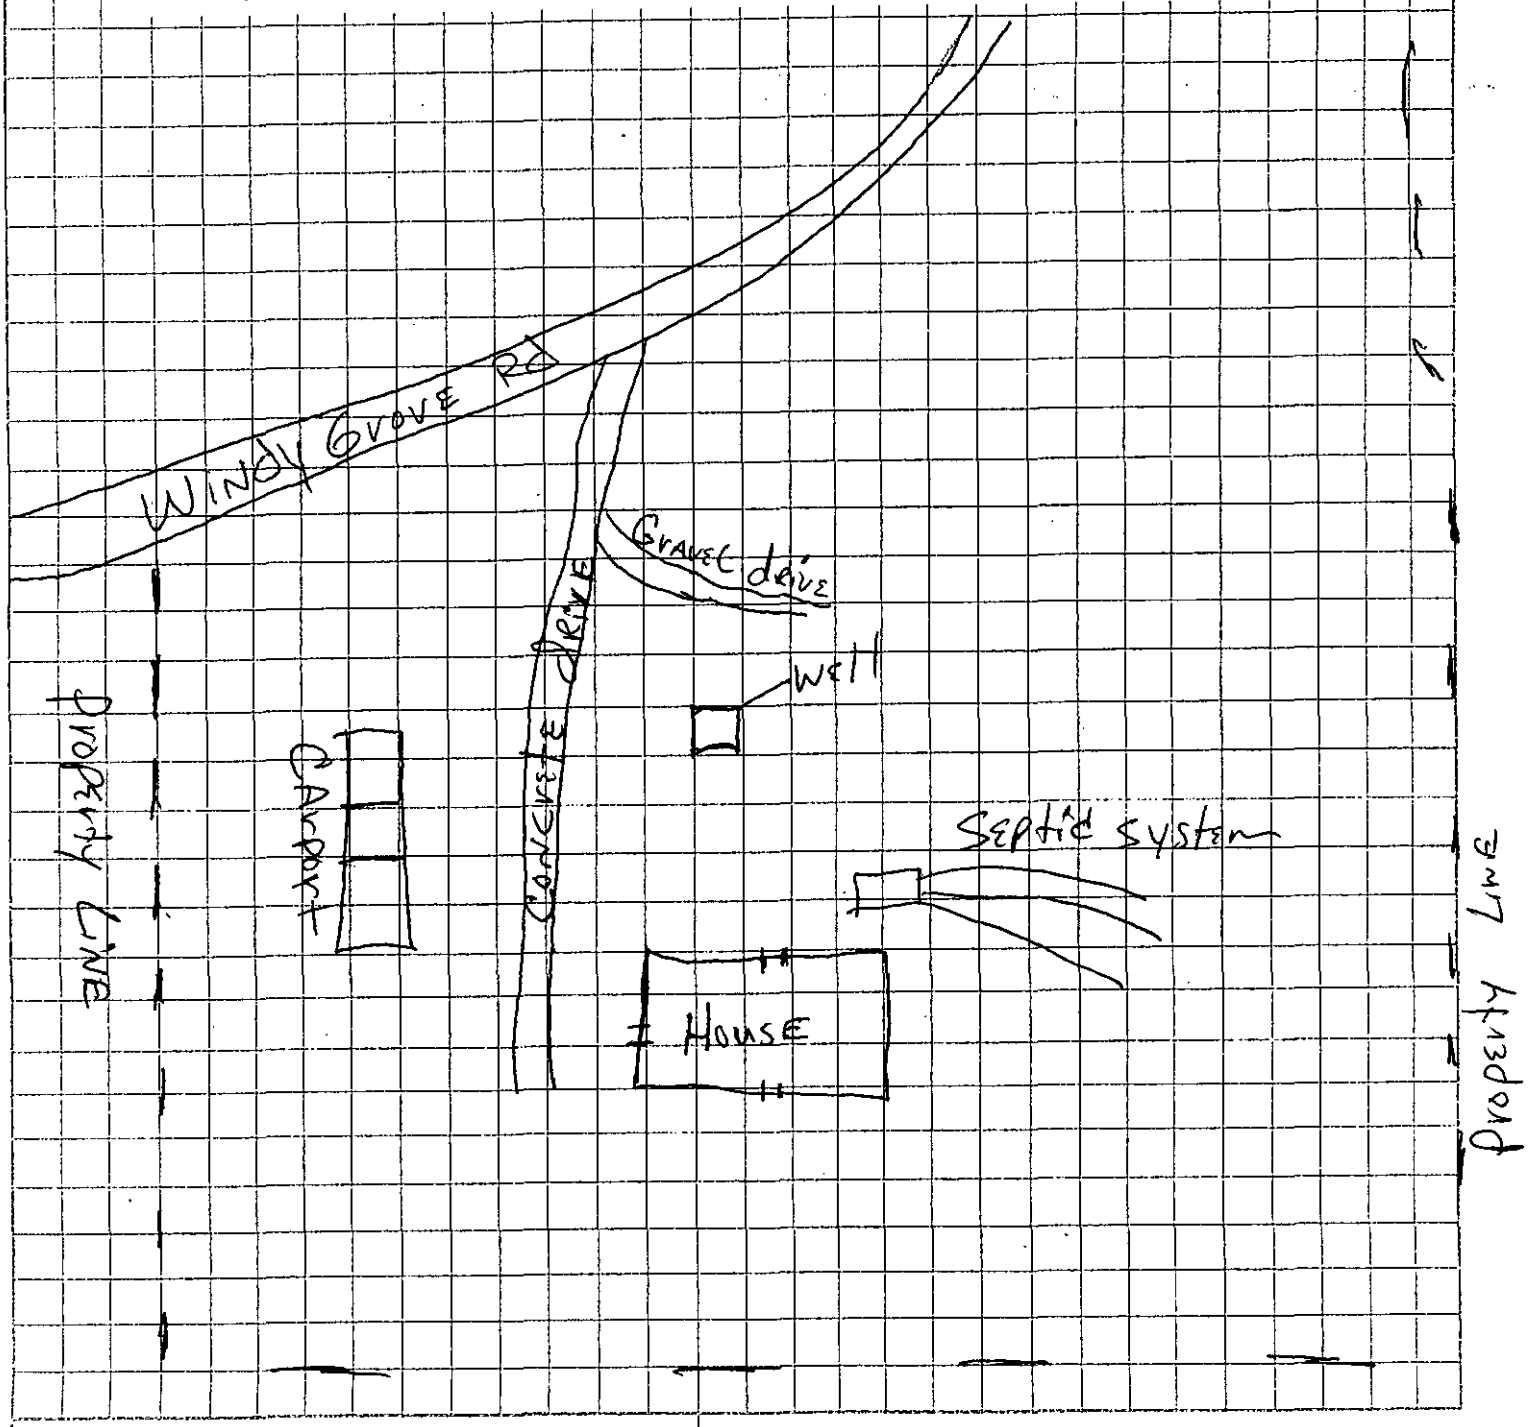

APPROVAL DATE _____

OWNER/AGENT SIGNATURE

DATE Keith Jr

White - Health Department's Copy Canary - E.H.S. Copy Pink - Owner's Copy

FEE: _____ **AUTHORIZATION FOR WASTEWATER SYSTEM CONSTRUCTION**
DATE: _____ **VOID SIXTY (60) MONTHS FROM DATE OF ISSUANCE**

DATE: 12/15/99 PERMIT NO: 4152-B
PARCEL NO: 113-251-02

JOB LOCATION ADDRESS: 10825 Windy Grove Road
PROPERTY OWNER: Keith C. Thompson
BUILDING CONTRACTOR: _____
SUBDIVISION NAME: _____
AUTHORIZATION ISSUED BY: Jeremy P. Michelson DATE: 12/15/99
DEHNR AUTHORIZED AGENT

AUTHORIZATION CONDITIONS

1. WASTEWATER SYSTEM CONSTRUCTION AND INSTALLATION MUST MEET ALL CONDITIONS AND SPECIFICATIONS AS SET FORTH IN IMPROVEMENT PERMIT NO. 4152-B, AND THE ATTACHED SITE PLAN WITH SYSTEM DETAILS. CONSTRUCTION AND INSTALLATION MUST ALSO MEET ALL REQUIREMENTS SET FORTH IN THE RULES GOVERNING SANITARY SEWAGE COLLECTION, TREATMENT, AND DISPOSAL AND ANY OTHER APPLICABLE RULES AND LAWS.

2. AN INSTALLATION, CONSTRUCTION, ALTERATION AND/OR REPAIR APPROVAL MUST BE SECURED **PRIOR** TO INSTALLATION OF THE SEPTIC TANK SYSTEM. THE INSTALLER OF THE SYSTEM SHALL BE A REGISTERED SEPTIC TANK CONTRACTOR WITH MECKLENBURG COUNTY HEALTH DEPARTMENT.

3. ANY ALTERATION IN SITE OR SOIL CONDITIONS (INCLUDING LOCATION OF STRUCTURES AND APPURTENANCES) OR MODIFICATION IN USE, DESIGN WASTEWATER FLOW, OR WASTEWATER CHARACTERISTICS AS SPECIFIED IN THE ASSOCIATED IMPROVEMENT PERMIT AND APPLICATION, MAY SUBJECT THIS AUTHORIZATION AND ASSOCIATED PERMIT(S) TO REVOCATION.

4. OTHER CONDITIONS: See plot plan.

OWNER CERTIFICATION

I CERTIFY THAT THERE HAVE BEEN NO ALTERATIONS IN SITE OR SOIL CONDITIONS OR MODIFICATIONS TO FACILITY, WASTEWATER FLOW, OR WASTEWATER CHARACTERISTICS FROM THOSE SPECIFIED IN THE ORIGINAL APPLICATION OR ASSOCIATED IMPROVEMENT PERMIT UNLESS AUTHORIZED IN WRITING BY THE MECKLENBURG COUNTY HEALTH DEPARTMENT. I ALSO UNDERSTAND THAT ANY SUCH ALTERATIONS, MODIFICATIONS, OR FALSE INFORMATION ARE GROUNDS FOR REVOCATION OF PERMITS AND AUTHORIZATION TO CONSTRUCT.

Keith C Thompson 12-17
SIGNATURE OF OWNER/OWNER'S REPRESENTATIVE DATE

Permit Number 4152-B Tax Number 113-251-02

The IMPROVEMENT PERMIT is subject to revocation if site plans or the intended use change. There is to be NO grading, filling or disturbance of the soil in the area of the septic tank system or repair area.

CONSTRUCTION AUTHORIZATION must be obtained prior to receiving a Building Permit. The Construction Authorization is NOT transferable. Do not clear, grade, fill or disturb soil prior to obtaining a Construction Authorization.

(1)

Domestic-type wastewater only. No industrial process wastewater may be discharged into the system.

Basement	___ Yes	X No	___ Partial Basement
Type Primary Wastewater System Type (circle one): I II III IV V VI	___ Conventional ___ Prefabricated, permeable block panel system ___ Shallow Placed Conventional	___ Low Pressure Pipe ___ Large Diameter Pipe ___ Fill ___ Other	___ Innovative or Experimental: ___ IWWS-93-1 ___ IWWS-93-2 ___ IWWS-94-1
___ Long-term acceptance rate	___ Max gallons/day wastewater flow	___ Absorption Area (sq ft)	___ Trench spacing (min. on centers)
___ Serviced by private well	___ Gallon septic tank	___ Total trench length (ft)	___ Maximum trench depth (At least 12" of provisionally suitable soil must remain between trench bottom and unsuitable soil conditions)
___ Bedrooms in residence	___ Gallon pump tank	___ Depth of stone	

Any surface waters present: Yes Type: Lake Wylie Minimum separation distance: 50'

Site modifications required:

Additional Conditions: ① Use existing system in addition to new bed.
② Water diversion drain shall be installed.
③ Existing septic tank shall be pumped.

Repair Area System Type Type (circle one): I (II) III IV V VI	X Conventional ___ Prefabricated, permeable block panel system ___ Shallow Placed Conventional	___ Low Pressure Pipe ___ Large Diameter Pipe ___ Fill ___ Other	___ Innovative or Experimental: ___ IWWS-93-1 ___ IWWS-93-2 ___ IWWS-94-1
450 Absorption Area (Sq ft) 75' Bed Total Trench Length (Ft)	18" Depth of Stone Trench	Bed Trench spacing (min. on centers)	36" Maximum Trench Depth

For existing system, enter the year originally installed:

The undersigned, an authorized agent of the MECKLENBURG COUNTY HEALTH DEPARTMENT, certifies that the Department has approved the Request for the Job Location contained in this document. This approval is granted in accordance with the provisions of Laws and Rules For Sewage, Treatment and Disposal in effect at the time of issuance of the permit and is subject to the following provisions:

- No work shall be conducted on the septic tank system until an Installation, Construction, Alteration and/or Repair Approval is granted by this Department.
- This Improvement permit is transferable.

Jeremy Mickelson 12-15-99
DEHNR Authorized Agent Date

Keith C Ly 12-17
Owner/Agent Signature Date

MECKLENBURG COUNTY
HEALTH DEPARTMENT
ENVIRONMENTAL HEALTH DIVISION
c/o HAL MARSHALL CTR.
SUITE 211
700 N. TRYON ST.
CHARLOTTE, N.C. 28202.
(704) 336-5102

NORTH CAROLINA DEPARTMENT OF
ENVIRONMENTAL, HEALTH,
AND NATURAL RESOURCES
DIVISION OF ENVIRONMENTAL HEALTH
ON-SITE WASTEWATER SECTION

IWWS-100125


PROPOSED PLOT PLAN

HEALTH DEPARTMENT
ENVIRONMENTAL HEALTH DIVISION
700 NORTH TRYON STREET
CHARLOTTE, NC 28202
PHONE (704) 336-5102

FILE: 4152-B

TC: 113-251-02

Draw in and name all roads adjoining the property. Draw in and accurately dimension the lot concerned. Accurately indicate property boundaries proposed and/or existing structures and driveways, underground utilities, and wells and springs within 100 feet of the proposed building or drainfield.

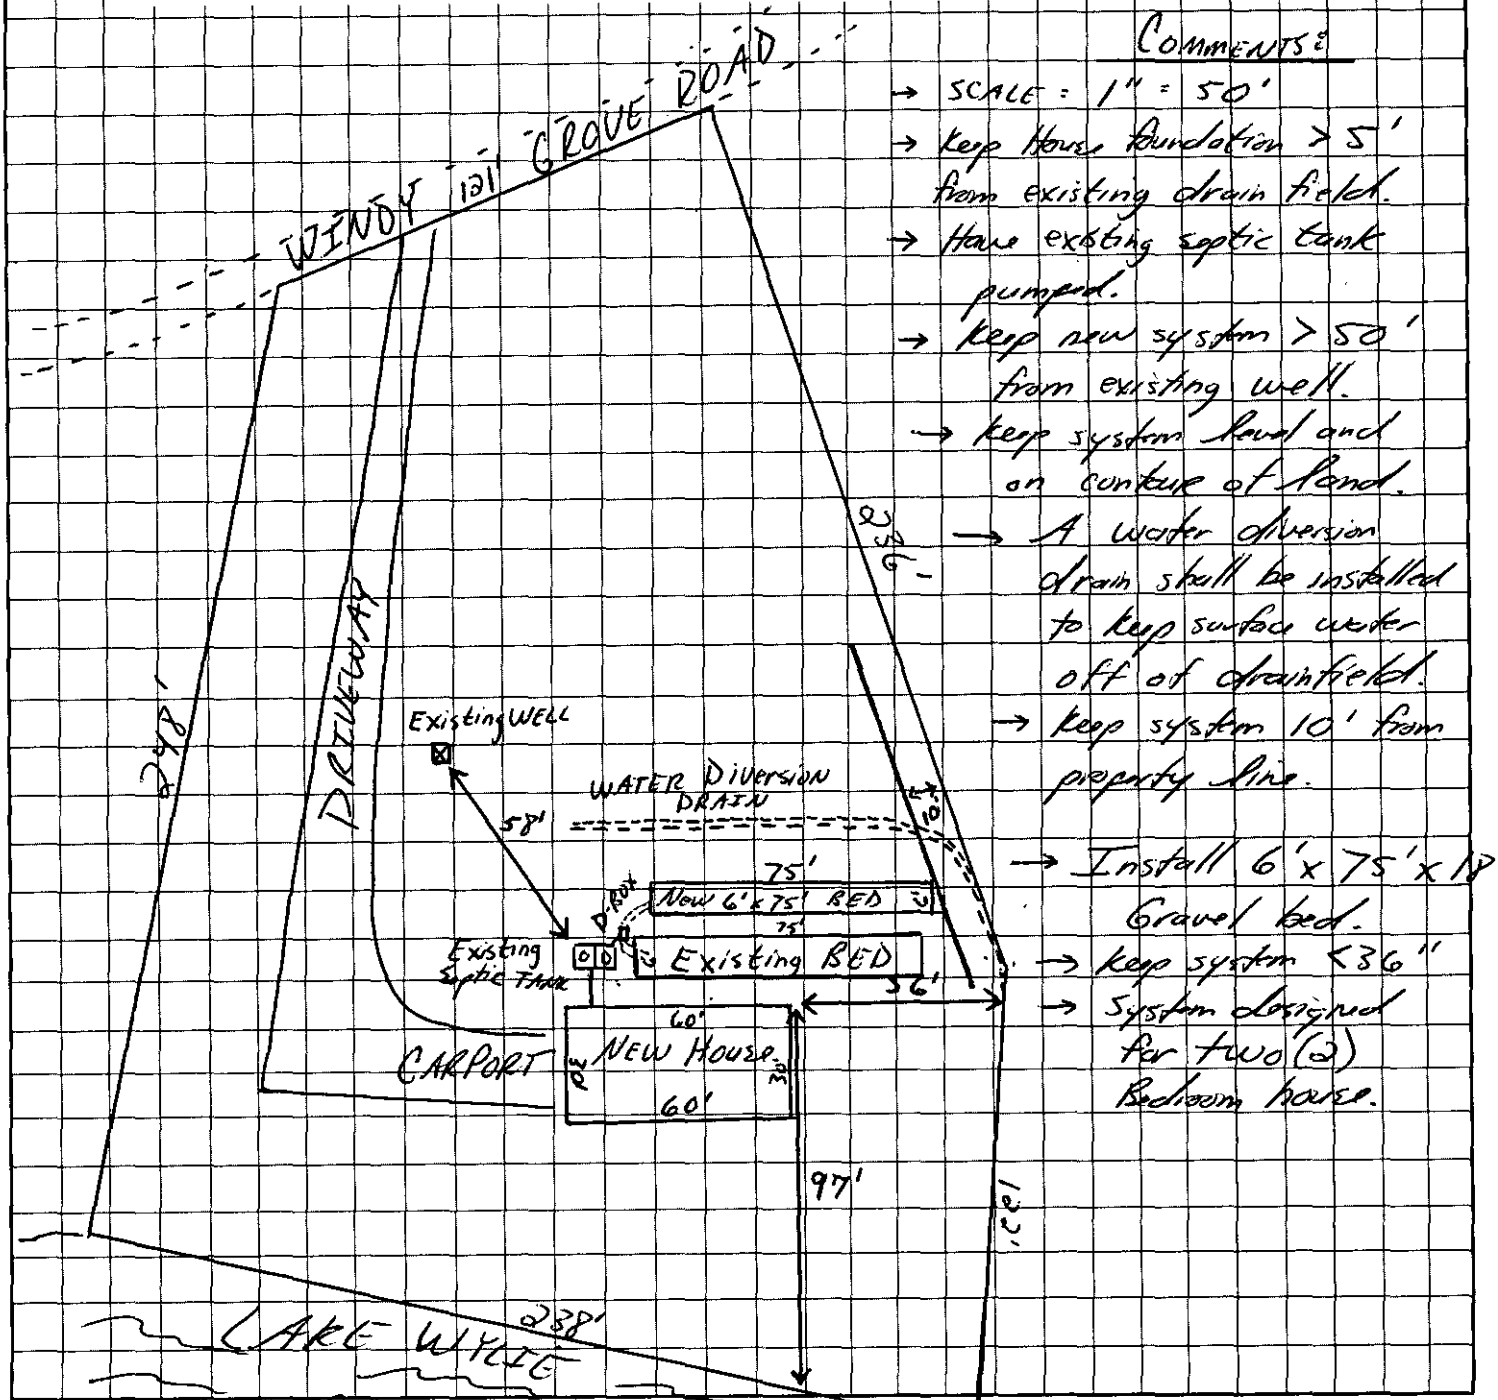

Comments:

→ SCALE: 1" = 50'

→ Keep House foundation > 5' from existing drain field.

→ Have exiting septic tank pumped.

→ Keep new system > 50' from existing well.

→ keep system level and on contour of land.

→ A water diversion drain shall be installed to keep surface water off of drainfield.

→ keep system 10' from property line.

→ Install 6'x75'x12" Gravel bed.

→ keep system < 36"

→ System designed for two (2) Bedroom house.

Keith C Flynn
OWNER/AGENT SIGNATURE

DATE 12-17-99

APPROVAL DATE _____

White - Health Department's Copy Canary - E.H.S. Copy Pink - Owner's Copy

FEE: 300.00 ck#1032

DATE: 8-13-99 V.W

APPLICATION FOR IMPROVEMENT PERMIT FOR RESIDENTIAL SITE INDIVIDUAL WATER AND WASTEWATER SYSTEMS PROGRAM

I ICRT

TYPE APPLICATION: ___ NEW SYSTEM X EXPANSION/ ALTERATION OF EXISTING SYSTEM ___ REPAIR OF EXISTING SYSTEM

NORTH CAROLINA
DEPARTMENT OF ENVIRONMENT,
HEALTH, AND NATURAL RESOURCES
DIVISION OF ENVIRONMENTAL HEALTH
ON-SITE WASTEWATER SECTION

FILE #: [illegible] 4152B

PROPERTY INFORMATION (FROM ENGINEERING FORM) FOR JOB LOCATION:

TAX/PARCEL NUMBER: 125-251-02

STREET ADDRESS: 10825 Windy Grove Rd

SUBDIVISION OR MOBILE HOME PARK NAME:

LOT NUMBER:

TOWNSHIP (CHECK ONE):

X 0 MECKLENBURG
X 1 CHARLOTTE
___ 2 DAVIDSON
___ 3 CORNELIUS
___ 4 PINEVILLE
___ 5 MATTHEWS
___ 6 HUNTERSVILLE
___ 7 MINT HILL

CLOSING DATE_____

TYPE OF BUILDING (CHECK ONE):

___ SINGLE MOBILE HOME(S)
___ DOUBLE WIDE (D)
X HOUSE (H)
___ MODULAR HOME (M)
___ MULTIPLE FAMILY (U)
___ OTHER (O)

HEATED SQUARE FOOTAGE: 1800

NUMBER OF BEDROOMS: 2 NUMBER OF OCCUPANTS:

FOUNDATION FOR RESIDENCE:

___ WITHOUT BASEMENT ON SLAB
X CRAWL SPACE
___ WITH BASEMENT /PLUMBING
___ WITH BASEMENT /NO PLUMBING

IF EXPANSION/ALTERATION OF EXISTING SYSTEM, DESCRIBE THE PROPOSED BUILDING ADDITION:

NEW home

WILL THERE BE A HOME BUSINESS IN THE RESIDENCE: ___ YES X NO TYPE: _____

WATER SUPPLY (CHECK ONE):

___ COMMUNITY (C)
___ MUNICIPAL (M)
X PRIVATE WELL (P)
___ SHARED WELL (S)
___ OTHER 'SPRINGS' (O)

IF ANY OF THE FOLLOWING ARE LOCATED ON THE PROPERTY, PLEASE SHOW LOCATION ON PLAT:

BURIED CABLES, LANDFILLS, STUMPHOLES	X YES ___ NO	WELL, SPRINGS OR WATERLINES	X YES ___ NO
EXISTING WASTEWATER SYSTEMS.	X YES ___ NO	DESIGNATED WETLANDS	___ YES X NO
EASTMENTS OR RIGHT-OF-WAYS	___ YES X NO		

PROPERTY OWNER:

NAME: Thompson (LAST) Keith (FIRST) C (MI) III

ADDRESS: 10825 Windy Grove Rd

CITY: Charlotte STATE: N.C ZIP: 28216

DAYTIME PHONE: (704) 522 - 6650

LEGAL AGENT FOR PROPERTY OWNER, IF APPLICABLE:

NAME: SAME (LAST) (FIRST) (MI)

DAYTIME PHONE: ( ) 522 - 6650

WHAT DATE WAS THE PROPERTY ORIGINALLY DEEDED AND RECORDED? ?

An Improvement Permit is subject to suspension or revocation if site plans or the intended use change or if information submitted in this application is falsified or changed. The undersigned, owner, or legal agent for the owner, of the property described above as the "Job Location" has read the foregoing application, acknowledges that the contents of same are true, and authorizes agents of the Mecklenburg County Health Department to enter onto the property for the purpose of processing this request.

SIGNED: Keith C Thompson III DATE: 11-30-99

MECKLENBURG COUNTY HEALTH DEPARTMENT
ENVIRONMENTAL HEALTH DIVISION
c/o HAL MARSHALL CTR., SUITE 211, 700 N. TRYON ST., CHARLOTTE, N.C. 28202., (704) 336-5102

PROPOSED PLOT PLAN


COPY

HEALTH DEPARTMENT
ENVIRONMENTAL HEALTH DIVISION
700 NORTH TRYON STREET
CHARLOTTE, NC 28202
PHONE (704) 336-5102

FILE: 4152B

TC: 113-251-02

Draw in and name all roads adjoining the property. Draw in and accurately dimension the lot concerned. Accurately indicate property boundaries proposed and/or existing structures and driveways, underground utilities, and wells and springs within 100 feet of the proposed building or drainfield.

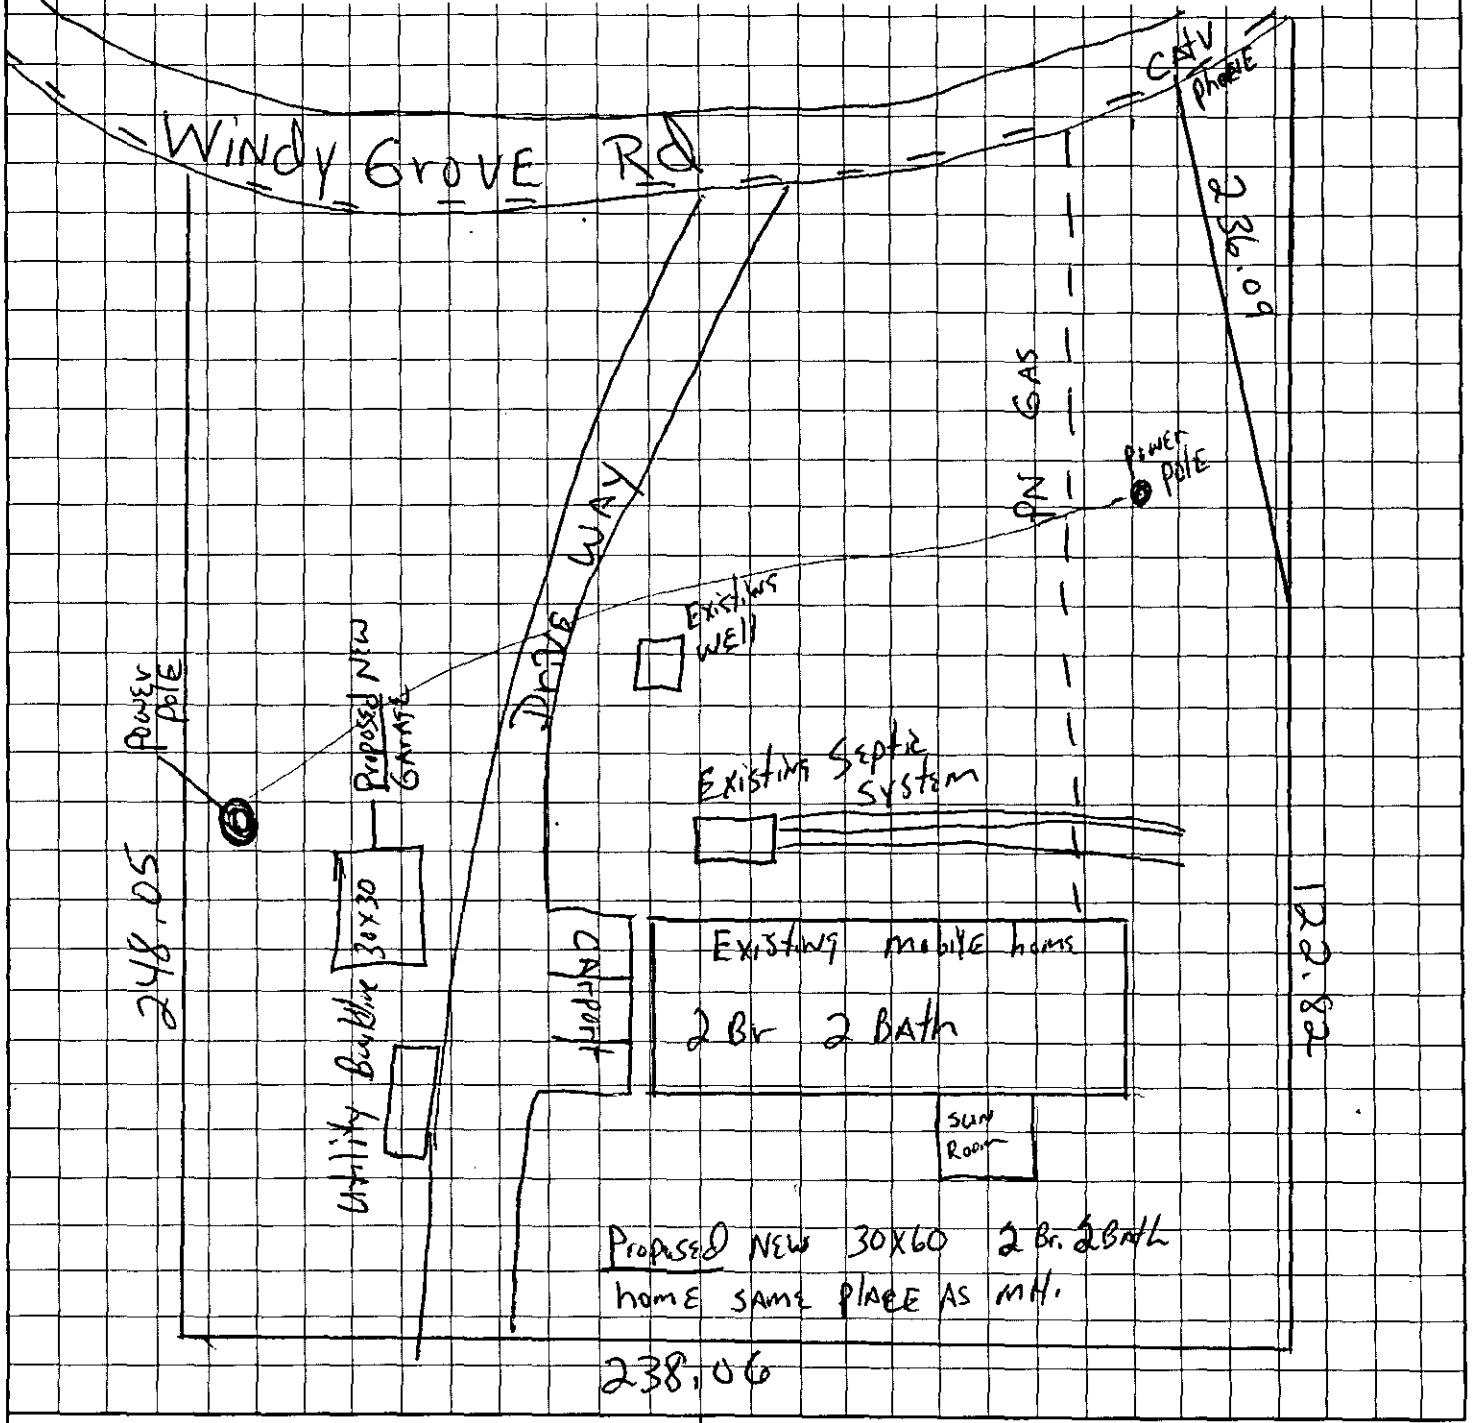

APPROVAL DATE _____

OWNER/AGENT SIGNATURE Chris Flynn

DATE 12-13-99

White - Health Department's Copy Canary - E.H.S. Copy Pink - Owner's Copy