

2801 HOUSTON BRANCH RD

22710708

6/5/08

marliwr

Groundwater and Wastewater Services File Imaging Project
May 2007
Barcode Font = IDAutomationHC39M

Ck #2249
7-30-99

INDIVIDUAL WATER AND WASTEWATER SYSTEMS PROGRAM
APPLICATION FOR SERVICES

ACS

[ ] CRT

Mecklenburg County Health Dept.
Environmental Health Division
c/o Hal Marshall Ctr., Suite 211
700 N. Tryon St.
Charlotte, NC 28202

(704)336-5102 8931

Date: 7/29/99

PERSON FILING APPLICATION:

NAME: Kirkland (last) Dorothy (first) M (mi)

ADDRESS: 2801 Houston Br. Rd PHONE: (704) 846-2871

CITY: Charlotte STATE: NC ZIPCODE: 28270

PROPERTY INFORMATION (FROM ENGINEERING FORM):

TAX/PARCEL NUMBER: 227-10108

STREET ADDRESS: 2801 Houston Rd.

ZONING:

SUBDIVISION OR MOBILE HOME PARK NAME:

PROPERTY OWNER:

NAME: Same as above (last) (first) (mi)

ADDRESS: _____ PHONE: (__) _____

CITY: STATE: ZIPCODE:

Township (check one):
[ ] 0 Mecklenburg County [ ] 2 Davidson [ ] 4 Pineville [ ] 6 Huntersville
[X] 1 Charlotte [ ] 3 Cornelius [ ] 5 Matthews [ ] 7 Mint Hill

LOT NUMBER: LOT SIZE (in acres): 1.3 < >

TYPE APPLICATION (check one):

[ ] EXCHANGE MOBILE HOME - SAME # BEDROOMS (Y)
[ ] ADDITION - INCREASE ROOMS/OCCUPANCY/MOBILE HOME SIZE (A or M)
[ ] COMMERCIAL OR INDUSTRIAL (N)

[X] ADDITION - GARAGE OR RENOVATION/NO MAJOR CHANGES (X) Deck

RESIDENTIAL PROPERTY (Type Building, check one):
[ ] SINGLE MOBILE HOME (S) [X] HOUSE (H) [ ] MULTIPLE FAMILY (U)
[ ] DOUBLE WIDE (D) [ ] MODULAR HOME (M) [ ] OTHER _____ (O)

NUMBER BEDROOMS: 4 NUMBER OCCUPANTS: 2

SYSTEM CLASSIFICATION:

COMMERCIAL/INDUSTRIAL PROPERTY:
Type Business _____ # Employees ___ Per Shift ___ ___ ___
Industrial Wastes (Y/N) ___
Underground Storage Tanks On Property (Y/N) ___ Type _____

WATER SUPPLY (check one):
[ ] Community (C) [ ] Shared Well (S)
[X] Municipal (M) [ ] Other 'spring' (O)
[ ] Private Well (P)

FUTURE ADDITIONS - ALL PLANNED ADDITIONS MUST BE ENTERED (check all that apply):
[ ] Swimming Pool [ ] Jacuzzi [ ] Stable/Barn [ ] Workshop [ ] None
[ ] Garage [ ] Storage Building [X] Deck/Patio [ ] Bedrooms [ ] Other

The undersigned, owner, or legal agent for the owner, of the property described above as the "JOB LOCATION" has read the foregoing application, acknowledges that the contents of same are true, and authorizes agents of the MECKLENBURG COUNTY HEALTH DEPARTMENT to enter onto the property for the purpose of processing this request.

Signed: Dorothy M. Kirkland Date: 7/29/99

NOTICE:

The undersigned, an authorized agent of the MECKLENBURG COUNTY HEALTH DEPARTMENT, certifies that the Department has approved the Request for the Job Location contained in this document. This approval is granted in accordance with the provisions of Laws And Rules For Sanitary Sewage Collection, Treatment And Disposal in effect at the time of issuance of the permit and is subject to the following provisions:

...No work shall be conducted on the septic tank system until an installation, Construction, Alteration and/or Repair approval is granted by this Department.

...This permit is not transferable.

...OK to Screen in Porch existing. No New additions to Deck.

[ ] IMPROVEMENT PERMIT - VALID 60 MONTHS FROM ISSUANCE
[ ] MOBILE HOME EXCHANGE APPROVAL - VALID 6 MONTHS FROM ISSUANCE
[ ] ADDITION/RENOVATION APPROVAL - VALID 1 YEAR FROM ISSUANCE

Joshua R. Sellers R.S. 8-05-99
Environmentalist Date

WATER : 122791


PROPOSED PLOT PLAN

HEALTH DEPARTMENT
ENVIRONMENTAL HEALTH DIVISION
700 NORTH TRYON STREET
CHARLOTTE, NC 28202
PHONE (704) 336-5102

FILE: 8931

TC: 227-107-08

Draw in and name all roads adjoining the property. Draw in and accurately dimension the lot concerned. Accurately indicate property boundaries proposed and/or existing structures and driveways, underground utilities, and wells and springs within 100 feet of the proposed building or drainfield.

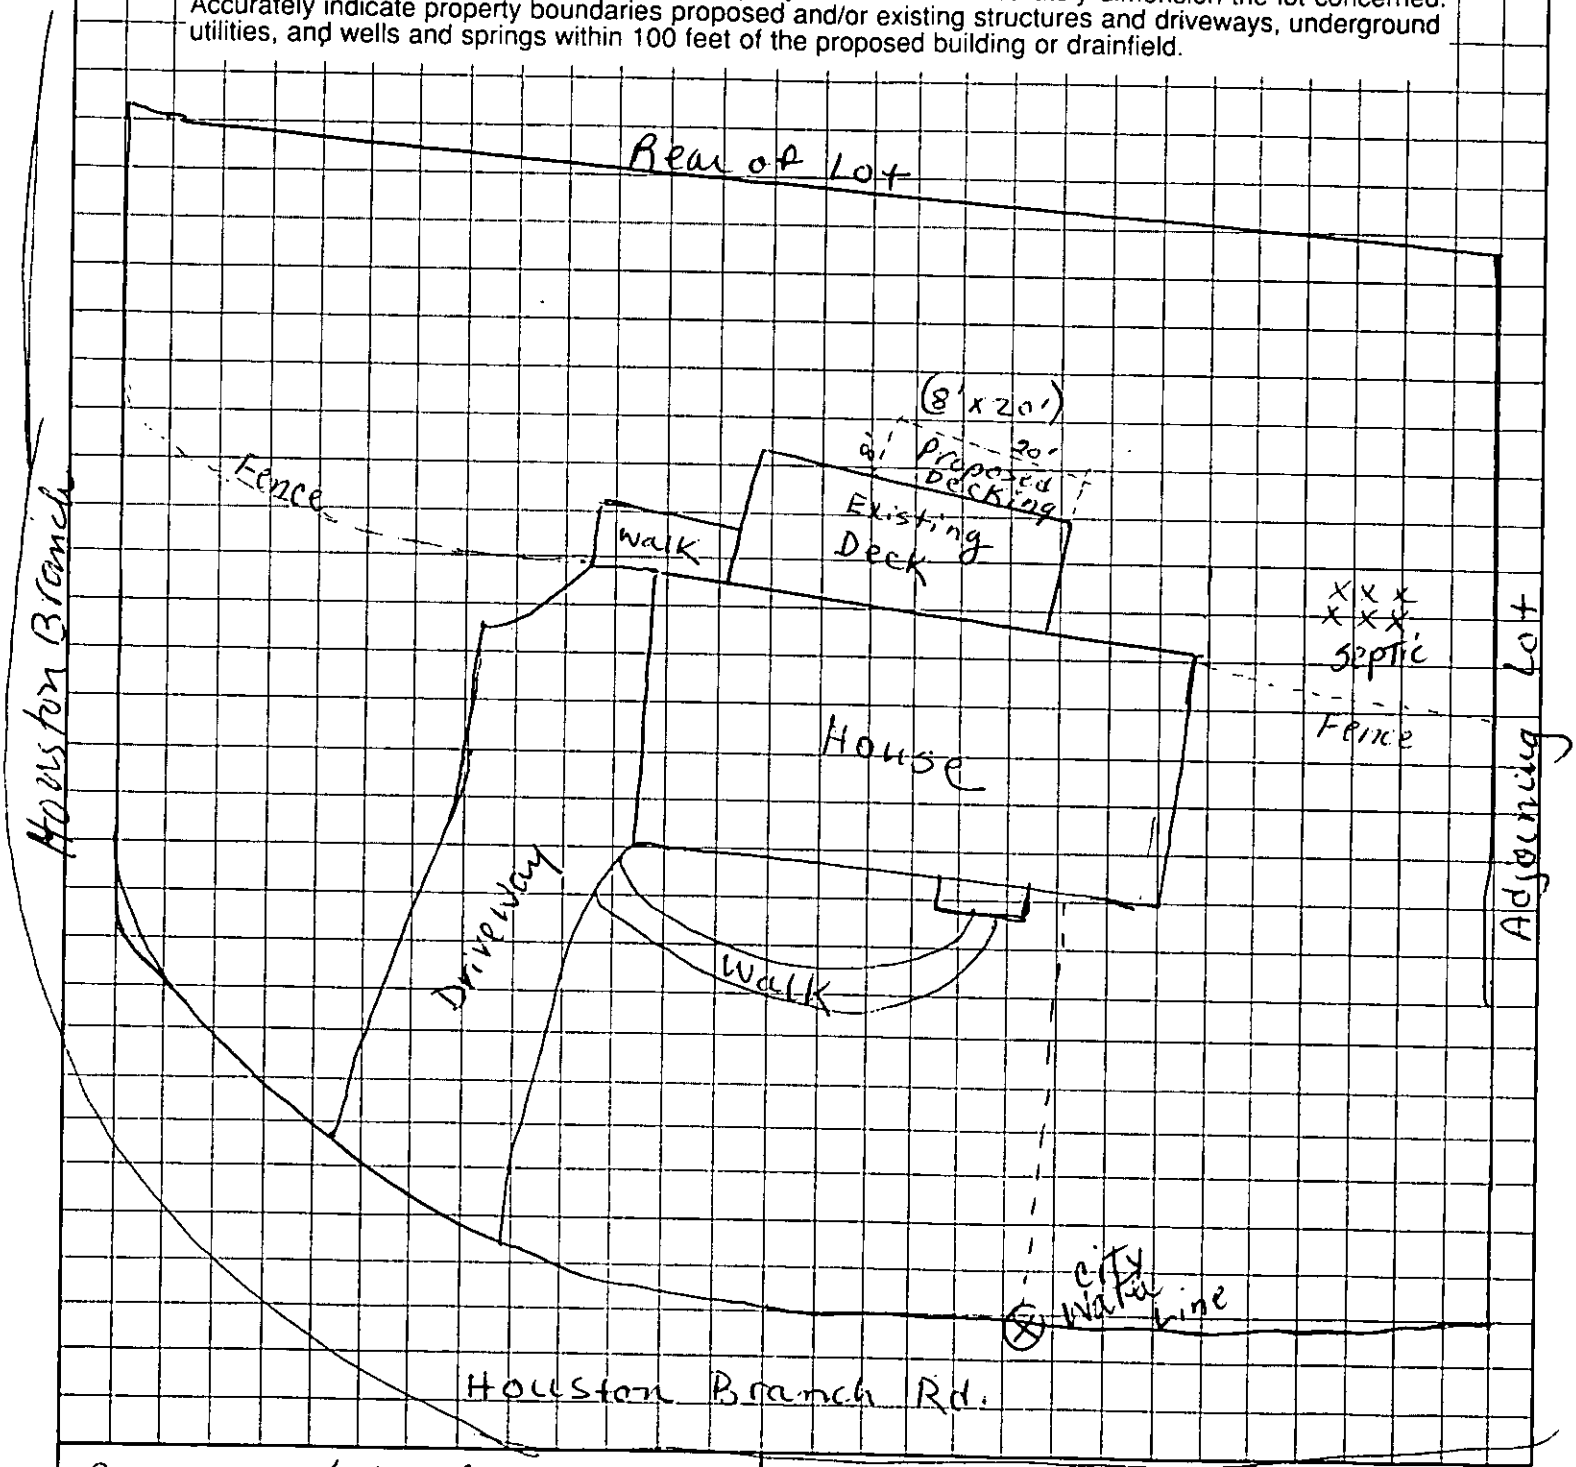

Dorothy M. Kirkland
OWNER/AGENT SIGNATURE

DATE 7/29/99

APPROVAL DATE _____

White - Health Department's Copy

Canary - E.H.S. Copy

Pink - Owner's Copy

Mecklenburg County Groundwater & Wastewater Services
700 N. Tryon St., Suite 211 Charlotte, NC 28202
Phone: (704) 336-5103 Fax: (704) 336-6894

NC DENR
Division of Environmental Health
On-Site Wastewater Section

OPERATION PERMIT for an ON-SITE WASTEWATER TREATMENT & DISPOSAL SYSTEM

File #: 5340 Permit #: _____ Tax Parcel #: 139 271 45

Property Owner: Tina Moody

Job Location Address: 10501 Russett Place

City: Charlotte State: NC Zip Code: 28227

Operation Permit Issuance Date: 6/1/06 Contractor Name: RCS

Permitted Design Flow: 360 GPD

Liquid Capacity of Septic Tank: 1500 gallons

Liquid Capacity of Dosing Tank: NA gallons

Effluent Pump Model: NA

Drainfield Installation ☐ N/A

Trench Depth: 24-36 inches

Trench Width: 3 feet

Line Spacing: 9 feet (O.C.)

Total line length: 200 feet

# of Lines: 3 @ 2(40) 1(100') feet Large Diameter pipe

Depth of Media: 10 inches (Type) pipe

Depth of Cover: 12 inches

Distribution Device: D-Box

Bed Installation *(For Repair Installations ONLY.)* ☒ N/A

Bed Depth: _____ inches

Bed Width: _____ feet

Total line length: _____ feet

# of Lines: _____ @ _____ feet

Depth of Media: _____ inches (Type) _____

Depth of Cover: _____ inches

Distribution Device: _____

Water Supply Source

☐ Municipal ☒ Private Well ☐ Community Well

☐ Other _____

System Installation Setbacks

Distance from Building Foundation: >5 feet

Distance from Property Line: >10' feet

Distance from Water Supply Source: >50' feet


Inspection Dates

Tank(s) Inspected: Existing

Excavation Inspected: 6/1/06

Pump & Controls Inspected: NA

SKETCH OF SYSTEM INSTALLATION
(As-Built Drawing)

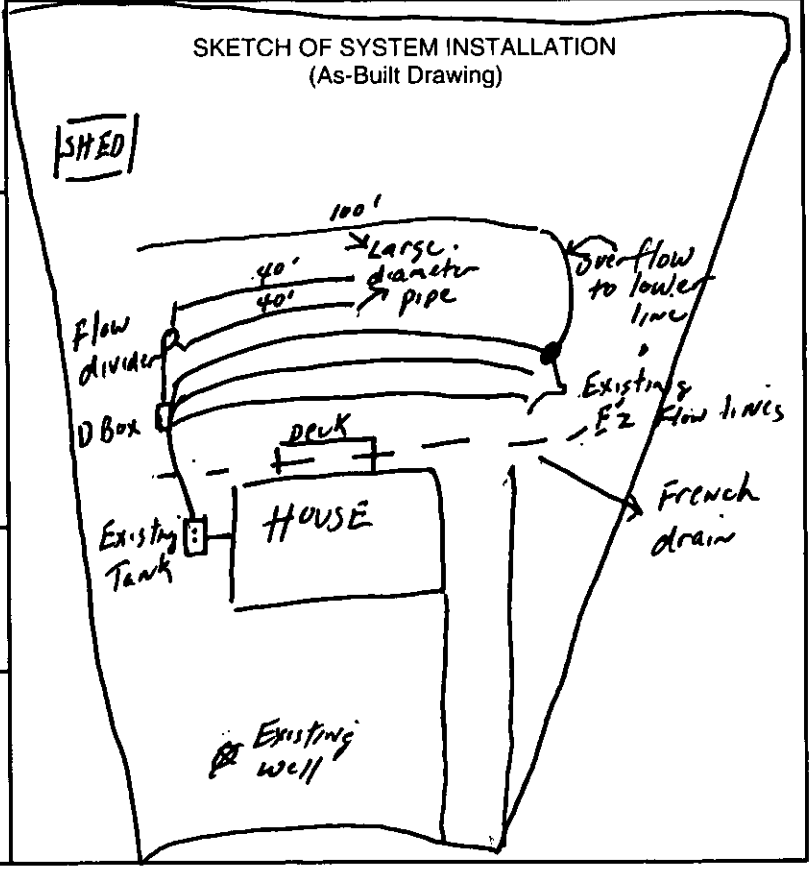

The undersigned has inspected the Septic Tank System described above, and certifies it has been ☐ installed ☐ altered ☒ repaired ☐ as detailed in the plot above ☐ in accordance with the permit issued and meets the provisions of 15A NCAC 18A. 1900, "Laws and Rules for Sewage Treatment and Disposal Systems" in effect on the date of issuance of the permit. The issuance of this Operation Permit does not in any way guarantee that the system will operate properly or relieve any person now or hereafter owning, controlling, or using such system from any liability resulting from the failure of the system to operate properly. This document is issued subject to those restrictions and conditions shown on the permit(s) and the provisions of 15A NCAC 18A. 1900 in addition to those listed below under "Comments." This document shall be null and void if any information contained in the application is untrue or if any additions are made to the property which would increase the requirements for said system.

Notice: Disturbance of the designated repair area may result in the Suspension or Revocation of this permit.

Comments: System Classification & Type: Type IIIF Large Diameter Pipe / Repair to the Existing System

DENR Authorized Agent: Philo S. Walker Signature: Philo S. Walker RS