

2224 CPCC LN

21507209

1/9/2008

duponbj

Groundwater and Wastewater Services File Imaging Project
May 2007
Barcode Font = IDAutomationHC39M

File 61795

North Carolina - Department of Environment and Natural Resources - Division of Water Quality - Groundwater Section - 1636 Mail Service Center - Raleigh, NC 27699-1639 - Phone No. (919) 733-3221

WELL ABANDONMENT RECORD

WELL CONTRACTOR Tommy Bolyard with EDPS

WELL CONTRACTOR CERTIFICATION # 3307

1. WELL USE (Check Applicable Box): Residential ☒ Municipal ☐ Industrial ☐ Agricultural ☐ Monitoring ☐ Recovery ☐ Heat Pump Water Injection ☐ Other ☐ If Other, List Use: _____

2. WELL LOCATION: (Show a sketch of the location on back of form.)
Nearest Town: Matthews County Union
2224 CPCC Lane, Matthews, North Carolina 28105
(Road Name and Number, Community, Subdivision , Lot No.) Quadrangle No.

3. OWNER: Hendrick Automotive Group

4. ADDRESS: 6000 Monroe Road Suite 100

5. TOPOGRAPHY: ☐ draw, ☒ slope, ☐ hilltop, ☐ valley, ☐ flat (circle one)

6. TOTAL DEPTH: 82' DIAMETER 2"

7. CASING REMOVED:

feet	diameter
NA	NA

8. DISINFECTION: 1 tbsp.
(Amount of 70% hypochlorite used:)

9. SEALING MATERIAL:

Neat Cement	Sand Cement
bags of cement 2	bags of cement
gallons of water 5	gallons of water

Other
Type material
Amount

10. EXPLAIN METHOD EMPLACEMENT OF MATERIAL.
Tremie

SEP # 10000172

WELL DIAGRAM: Draw a detailed sketch of the well showing total depth, depth and diameter of screens remaining in the well, gravel interval, intervals of casing perforations, and depths and types of fill materials used.

11. DATE WELL ABANDONED 11/4/05

I do hereby certify that this well was abandoned in accordance with 15A NCAC 2C well construction standards, and that a copy of the record has been provided to the well owner.

Signature of person abandoning the well _____ Date 11/15/05

WELL LOCATION: Draw a location sketch on the reverse of this sheet, showing the direction and distance of the well to at least two (2) nearby reference points such as roads, intersections and streams. Identify roads with State Highway road identification numbers.

Submit original to the Division of Water Quality, Groundwater Section, one copy to the owner within 30 days from completion of abandonment.

GW-30 Revised 12/99

SEPTIC FEE: _____
DATE: _____
CRT [ ]

PERMIT APPLICATION FOR A RESIDENTIAL SITE IMPROVEMENT PERMIT / CONSTRUCTION AUTHORIZATION FOR ON-SITE WASTEWATER SYSTEM NEW WELL INSTALLATION OR REPAIR OF EXISTING WELL MECKLENBURG COUNTY GROUNDWATER & WASTEWATER SERVICES

FILE # 6179B App # 172

WELL FEE: _____
DATE: _____
CRT [ ]

SEPTIC / TYPE APPLICATION: [X] NONE [ ] NEW SYSTEM [ ] ALTERATION [ ] REPAIR [ ] MODIFY PLOT PLAN

WELL / TYPE APPLICATION: [ ] NONE [ ] NEW WELL [ ] MAJOR REPAIR [X] ABANDONMENT

JOB LOCATION INFORMATION:

TAX/PARCEL #: 21507209
STREET ADDRESS: 2224 CPCC LANE
CITY: MATTHEWS
STATE: NC ZIP: 28105
SUBDIVISION OR MOBILE HOME PARK NAME:
LOT #:
TOWNSHIP:

[ ] 0-MECKLENBURG [ ] 4-PINEVILLE
[ ] 1-CHARLOTTE [X] 5-MATTHEWS
[ ] 2-DAVIDSON [ ] 6-HUNTERSVILLE
[ ] 3-CORNELIUS [ ] 7-MINT HILL

BUILDING INFORMATION: Philo

TYPE OF BUILDING:

[ ] SINGLE MOBILE HOME (S) [ ] MODULAR HOME (M)
[ ] DOUBLE WIDE (D) [ ] MULTIPLE FAMILY (U)
[X] HOUSE (H) [ ] OTHER

HEATED SQUARE FOOTAGE:
NUMBER OF BEDROOMS: THE HOME IS
NUMBER OF OCCUPANTS: VACANT AND IS SCHEDULED FOR DEMOLITION.

FOUNDATION FOR RESIDENCE:

[ ] CONCRETE SLAB [ ] BASEMENT WITH PLUMBING
[X] CRAWLSPACE [ ] BASEMENT WITH NO PLUMBING

IF PLANNING TO EXPAND/ALTER THE EXISTING SYSTEM INDICATE THE FOLLOWING CHANGES:

NUMBER OF BEDROOMS TO BE ADDED: NUMBER OF ADDITIONAL OCCUPANTS IN THE RESIDENCE:
WILL THERE BE A HOME BUSINESS IN THE RESIDENCE? [ ] YES [ ] NO TYPE:

WATER SUPPLY: MUNICIPAL WATER IS AVAILABLE IN THE AREA OF THE SITE.

[ ] MUNICIPAL (M) [ ] PUBLIC (C) [ ] PRIVATE WELL (P) [ ] SHARED WELL (S) [ ] OTHER 'SPRINGS' (O)

PROPOSED USE OF WELL: [ ] N/A [ ] IRRIGATION [ ] POTABLE [ ] GEOTHERMAL [X] OTHER (ABANDON)

ARE ANY OF THE FOLLOWING LOCATED ON THE PROPERTY? IF SO, PLEASE SHOW LOCATION ON SITE PLAN/PLAT.

BURIED CABLES, LANDFILLS, STUMPHOLES	[ ] YES	[X] NO	WELLS, SPRINGS, OR WATER LINES	[X] YES	[ ] NO
EXISTING WASTEWATER SYSTEMS	[ ] YES	[X] NO	DESIGNATED WETLANDS	[ ] YES	[X] NO
EASEMENTS OR RIGHT-OF-WAYS	[ ] YES	[X] NO	GRADING/SOIL REMOVAL PERFORMED	[ ] YES	[X] NO

PROPERTY OWNER:

NAME: HENDRICK AUTOMOTIVE GROUP
ADDRESS: 6000 MONROE ROAD, SUITE 100
CITY: CHARLOTTE
STATE: NC ZIP: 28212
HOME PHONE: WORK PHONE: 704 568-5550
MOBILE PHONE: FAX: 704 566-3306

LEGAL AGENT FOR PROPERTY OWNER, IF APPLICABLE:

NAME: CAROLINA ENVIRONMENTAL ASSOCIATES
ADDRESS: PO BOX 473628
CITY: CHARLOTTE
STATE: NC ZIP: 28247
HOME PHONE: WORK PHONE: 704 540-9665
MOBILE PHONE: FAX: 704 540-9605

WHAT DATE WAS THE PROPERTY ORIGINALLY DEEDED AND RECORDED? PURCHASED 9/30/04; DB/PG - 17817/732
WHAT IS THE ANTICIPATED CLOSING DATE FOR THIS PROPERTY? N/A

*An Improvement Permit is subject to suspension or revocation if site plans or the intended use change or if information submitted in this application is falsified or changed. The undersigned, owner, or legal agent for the owner, of the property described above as the "Job Location" has read the foregoing application, acknowledges that the contents of same are true, and authorizes the Mecklenburg County Health Department to enter onto the property for the purpose of processing this request.


Owner's/Agent's Signature Date

NORTH CAROLINA DEPARTMENT OF ENVIRONMENT & NATURAL RESOURCES DIVISION OF ENVIRONMENTAL HEALTH ON-SITE WASTEWATER SECTION

*A Well Permit is subject to suspension or revocation if site plans or the intended use change or if information submitted in this application is falsified or changed. The undersigned, owner, or legal agent for the owner, of the property described above as the "Job Location" has read the foregoing application, acknowledges that the contents of same are true, and authorizes the Mecklenburg County Health Department to enter onto the property for the purpose of processing this request.

Carol A. Hewett /CEA 9/16/05
Owner's/Agent's Signature Date

MECKLENBURG COUNTY HEALTH DEPARTMENT
GROUNDWATER & WASTEWATER SERVICES
700 N. TRYON ST., SUITE 211
CHARLOTTE, NC 28202 704-336-5103 / FAX: 704-336-6894

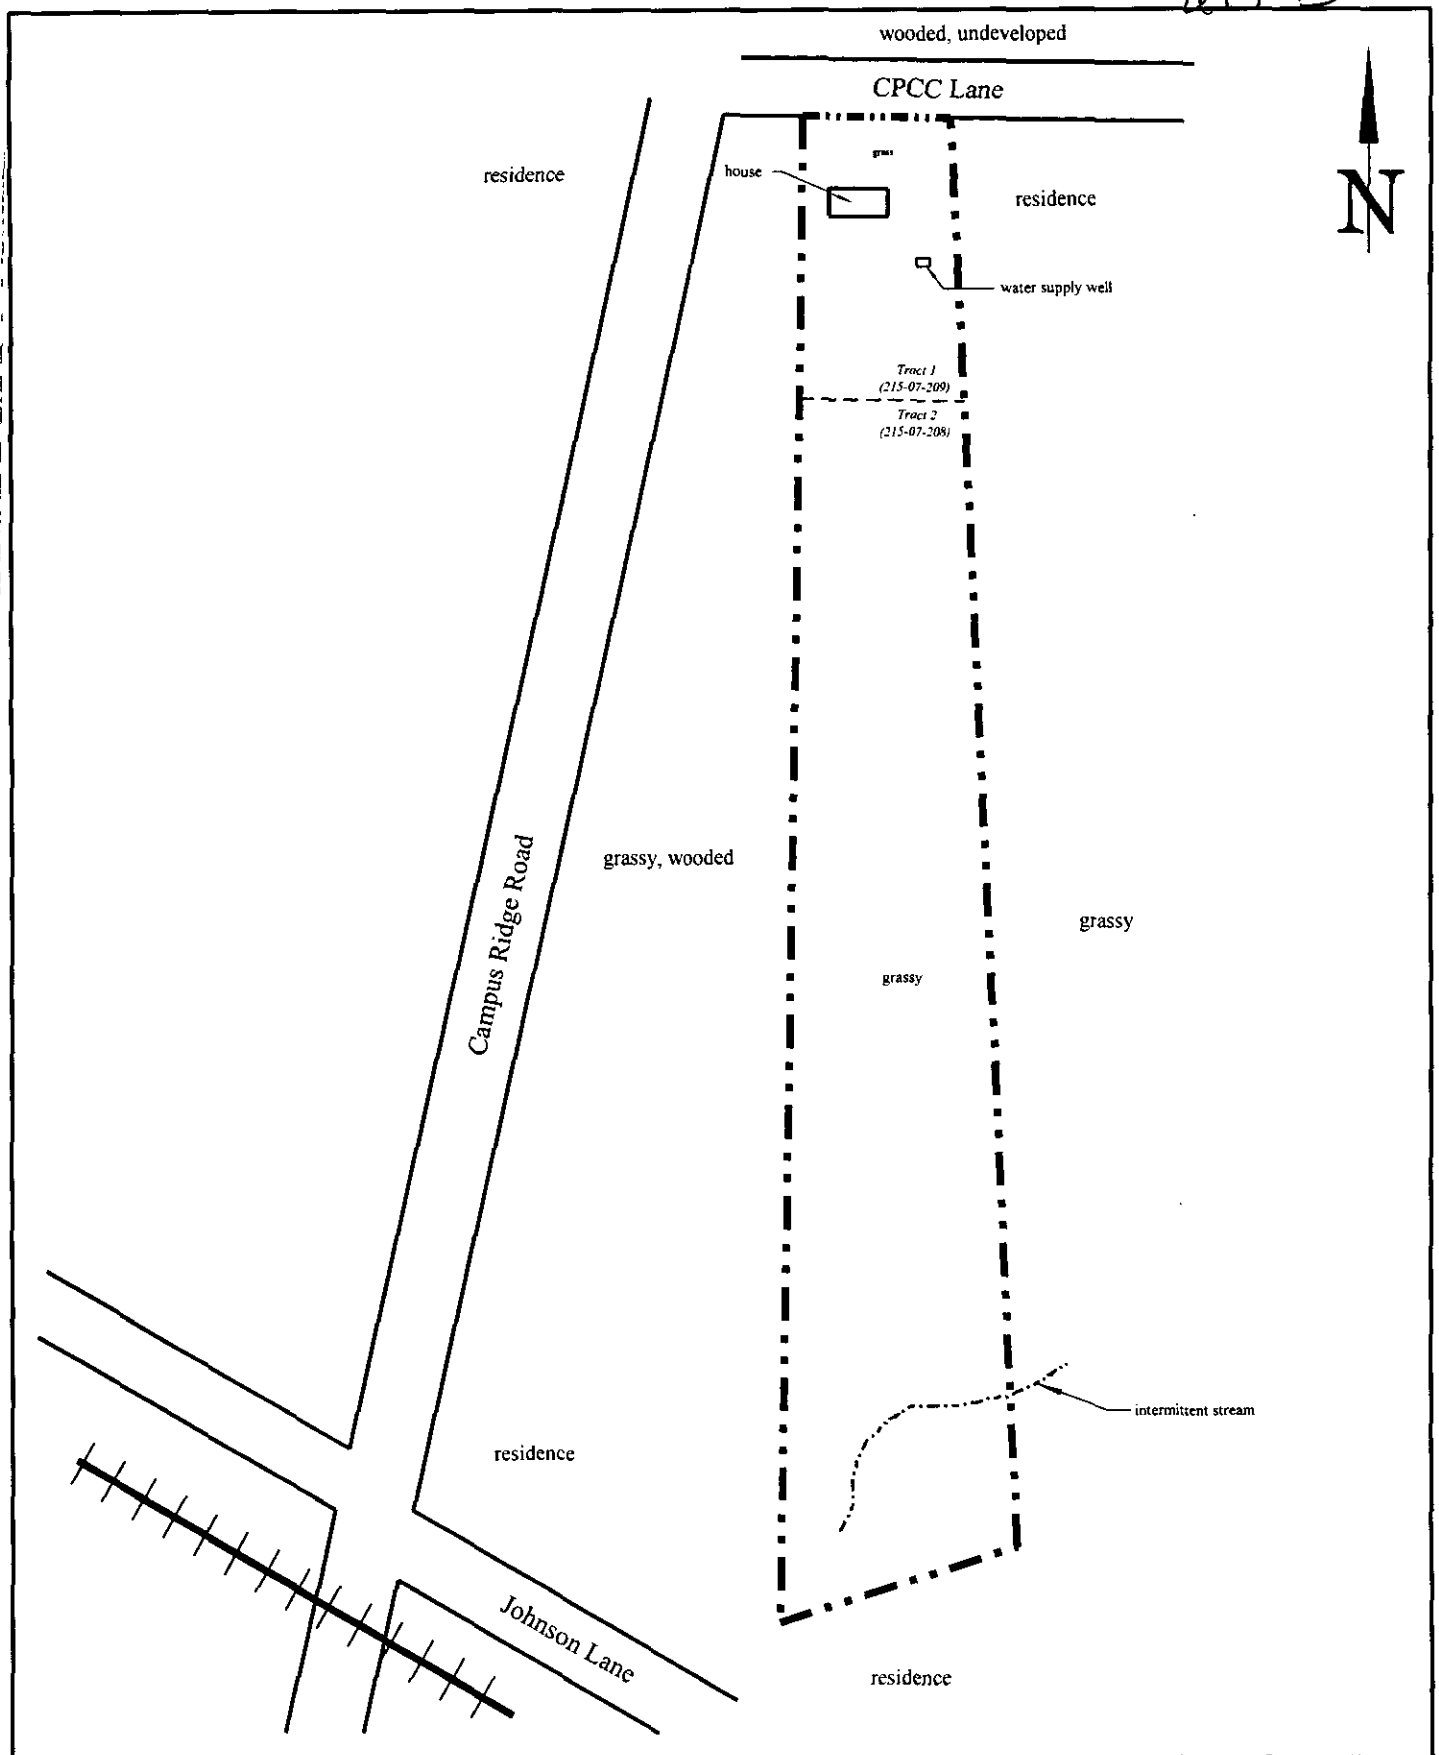

Carolina Environmental Associates, Inc.	FIGURE Site Map 2224 CPCC Lane Matthews, North Carolina	SCALE (feet) 0 100 200	Project No: 10.255.010 Date: 9/16/05 Drawing No: SM-2224