
Date Issued 20 April 77 Serial No. 0680 ICAR(S) Permit No. 12296 12297

T. C. No. 011-013-20

Map Date

MECKLENBURG COUNTY
DEPARTMENT OF ENVIRONMENTAL HEALTH
INSTALLATION, CONSTUCTION, ALTERATION, AND/OR REPAIR PERMIT
(Individual Septic Tank System with Subsurface, Soil Absorption, Effluent Discharge)

Permission is hereby given to __ Install or Construct, ✓ Alter or Repair the individual septic tank wastewater treatment system with subsurface, soil absorption, effluent discharge as specified herein at the described location. This permit is granted based upon the information supplied in application _____, dated _____ and this permit shall be void and of no effect if the information provided in the application is not true or is erroneous. All work shall be completed on or before 20 April 77, after which date this permit shall be null and void.

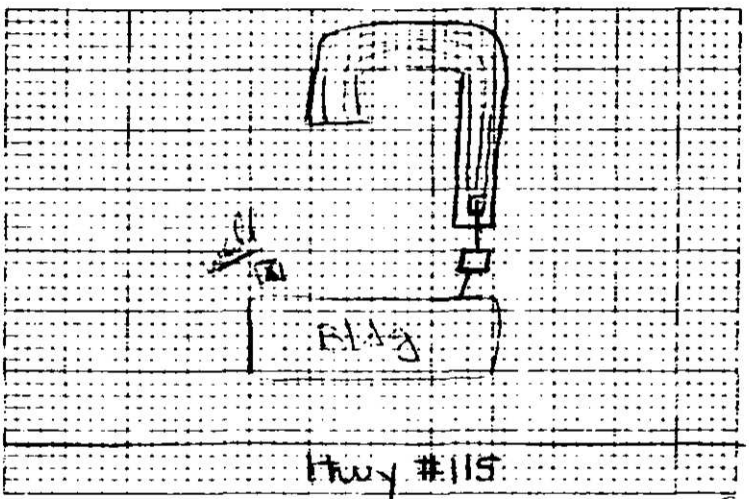

PLOT OF SYSTEM

Permeability Rate _____

Liquid Capacity of Tank 1500 Gal

Tank Construction Precast Concrete

Absorption and or Nitrification Lines

Total Line Length 1000 Ft

Number of Lines 6

Distance from House 10'

Distance from Property Line 10'

Distance from Well 50'

NAME OF OWNER Mecklenburg Georgie (Pops Grill)

LOCATION OF PROPERTY Hwy #115

The system shall meet all of the construction requirements as set forth in the Regulations of the Mecklenburg County Health Commission which are in effect on the date of the granting of this permit. A certificate of approval must be issued by the Environmental Health Director before any system can be covered up or otherwise rendered uninspectable or can be used. **The issuance of this permit does not in any way guatantee that the system anticipated to be constructed will operate properly, or relieve any person** Comments: now or hereafter owning, controlling or using such system from any liability resulting from the failure of the system to operate properly.

Division or Section Head

C M Reynolds
Environmentalist

* If this permit is for the installation or construction of a new system, it must be signed by the division or a section head of the Department of Environmental Health in order to be valid. Only the signature of the Environmentalist is required where an existing system is being altered or repaired.

EHD-5-76

Environmental Health Department's Copy

Date Issued 29 April 77 Serial No. 0679

C of A (s) No. [illegible]

C. No. 011-015-20

MECKLENBURG COUNTY
DEPARTMENT OF ENVIRONMENTAL HEALTH
ENVIRONMENTAL HEALTH DIVISION

CERTIFICATE OF APPROVAL
(Individual Septic Tank System with Subsurface, Soil Absorption, Effluent Discharge)

Name of Owner Eleanor G. (Pops Grill)
LAST FIRST MIDDLE

Location of Property Hwy #115

Application Number _____ Permit Number _____

Inspection Date:

Liquid Capacity of Tank 1500 gal Tank Material Precast Concrete

Total Length of Drain Tile 1000' Number of Lines 5

Depth of Filter Material 34" Cover Depth 36" To 48"

Water Supply Source well Distance from Water Source 50'+

Excavation Inspected 29 April 77 DATE Tank Inspected 29 April 77 DATE

Nitrification Field Inspected 29 April 77 DATE

Washing Machine Line Inspected, If Applicable _____ DATE _____

The undersigned has inspected the Individual Septic Tank System with subsurface, soil absorption, effluent discharge as described above and it has been _____ installed or constructed, _____ altered or repaired in accordance with the permit issued and the regulations of the Mecklenburg County Health Commission in effect on the date of issuance of the permit. The issuance of this Certificate of Approval does not in any way guarantee that the system will operate properly or relieve any person now or hereafter owning, controlling, or using such system from any liability resulting from the failure of the system to operate properly. This Certificate of Approval is issued subject to those restrictions and conditions shown on the permit in addition to those listed below under comments. This Certificate of Approval shall be null and void if any information contained in the application is untrue or if any additions are made to the property which would increase the requirements for said system.

Comments: _____

A. M. Reynolds
Environmentalist

EHD-S-76

Environmental Health Department's Copy


Date Issued 26 Apr 77

C of A (s) No. 12296 12297

T. C. No. 011-013-20

MECKLENBURG COUNTY
DEPARTMENT OF ENVIRONMENTAL HEALTH

PLOT PLAN SHEET

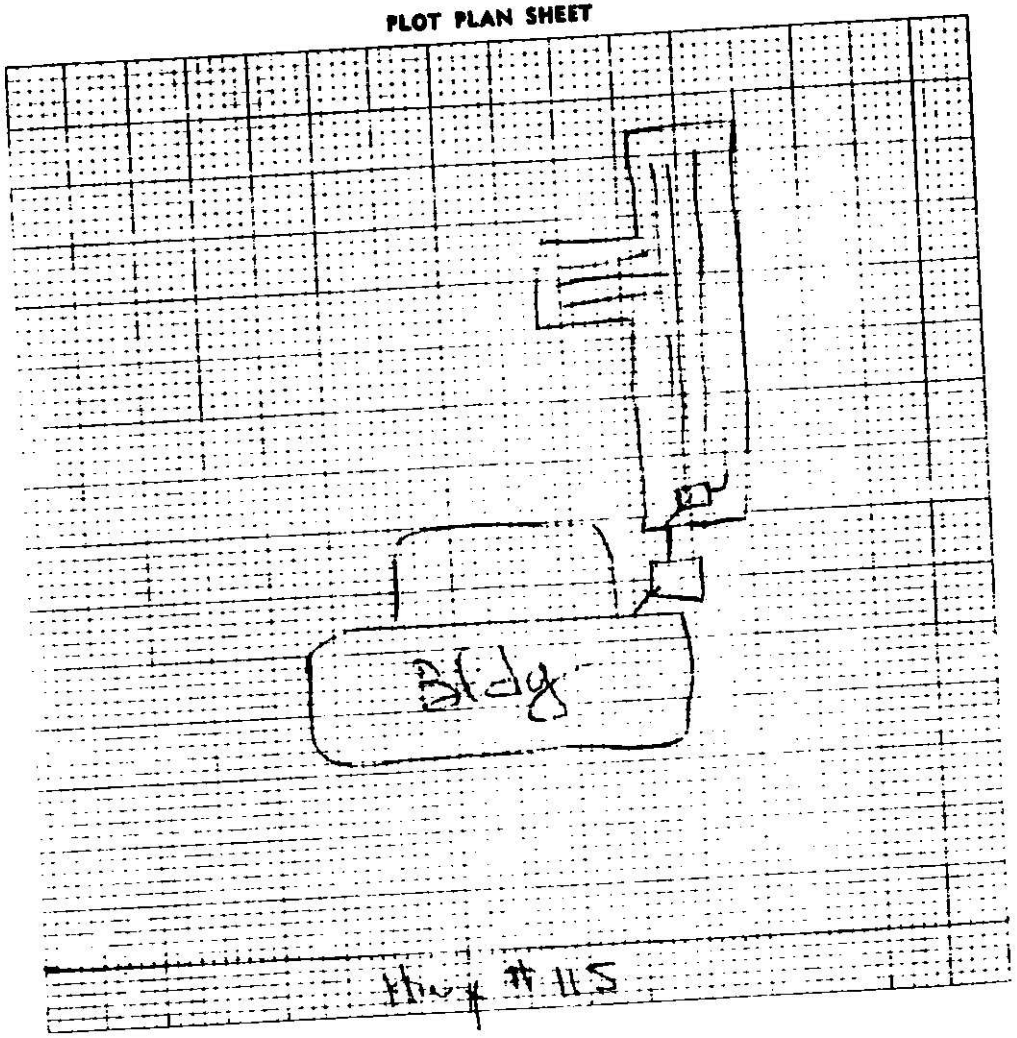

PLOT PLAN

ACCURATE DIAGRAM OF SYSTEM AS INSTALLED

J. M. Reynolds

Environmentalist

EHD-5-76

Environmental Health Department's Copy