

8238 CURICO LN

19713132

6/12/08

thomatc

Groundwater and Wastewater Services File Imaging Project
May 2007
Barcode Font = IDAutomationHC39M

EHS DC

Reviewer ICR

6494 B County Permit Review Worksheet

PROPOSED

Rule or Law		1	2	3	4	5	6	7	8	9	10
	Permit Application										
.1937(d)	Is the Application complete	✓									
.1937(d)	Is there a Site plan/Plat with application	✓									
.1937(d)	Is the Facilityshown?	✓									
.1937(d)	Are appurtenances shown	✓									
	Site Evaluation Information										
.1939 (a)(1)	Topography and Landscape Position Recorded?	✓									
.1940 (a-g)	Slope % Recorded?	✓									
.1939 (a)(2)	Texture Class Recorded?	✓									
.1939 (a)(2)	Structure type Recorded?	✓									
.1939 (a)(2)	Consistence Recorded?	✓									
.1939 (a)(3)	Mineralogy Recorded?	✓									
.1939 (a)(4)	Soil Wetness Condition Recorded?	✓									
.1939 (a)(5)	Soil Depth to Rock or Parent Material Recorded When Encountered?	✓									
.1939 (a)(6)	Depth to Restrictive Horizons Recorded When Encountered?	✓									
.1937(m)	Sufficient Available Space Recorded?	✓									
.1939(a) & .1945(b)	Are the Profile Locations Shown?	✓									
	Are the S/PS Profiles in system & in repair area?	✓									
	Number of auger borings made:	✓									
.1939(d), .1955, .1956, .1957	Were sufficient auger borings made?	✓									
	LTAR	.3									
	IP/CA										
G.S. 130A-336(a) & .1937(g)	Proposed System Type stated-Initial	✓									
.1945(b)	Proposed System Type stated-Repair	✓									
G.S. 130A-336(a)(3)	System location identifiable by setbacks - Initial	✓									
.1937(g) & .1945(b)	System components shown - Initial	✓									
.1945(b)	Repair area shown	✓									
.1937 (f)(g)	Does System design match facility, flow & WW characteristics?	✓									
.1937 (f)(g)	Is System design consistent with soil/site conditions?	✓									
.1937 (f)(g)	Is the System located in the approved area?	✓									
G.S. 130A-336(a)	Is the Design flow (gpd) indicated?	✓									
G.S. 130A-336(a)	Number of Bedrooms, employees, seats, etc. indicated?	✓									
.1937(g)	Trench depth indicated?	✓									
.1937(g)	Trench width indicated?	✓									
.1937(g)	Trench length indicated?	✓									
G.S. 130A-336(a)(1)	Proposed/existing well shown?	✓									
G.S. 130A-336(a)(1)	Property line lengths shown?	✓									
G.S. 130A-336(a)	Facility/appurtenance setbacks shown from fixed points?	✓									
	OP										
.1937(i)	System type as described in table V(a) of rule .1961	✓									
.1937(i)	Conditions for system performance, operation, maintenance, monitoring and reporting.	✓									

If system design is incorrect or inconsistent with site conditions, indicate why for each below

X32378 CC

GWS – RES. APP 07/05

SEPTIC FEE: 200
DATE: 5/14/06
CRT [ ]

PERMIT APPLICATION FOR A RESIDENTIAL SITE IMPROVEMENT PERMIT / CONSTRUCTION AUTHORIZATION FOR ON-SITE WASTEWATER SYSTEM NEW WELL INSTALLATION OR REPAIR OF EXISTING WELL MECKLENBURG COUNTY GROUNDWATER & WASTEWATER SERVICES

WELL FEE: _____
DATE: _____
CRT [ ]

FILE # 1643/13

SEPTIC / TYPE APPLICATION: ☐ NONE ☒ NEW SYSTEM ☐ ALTERATION ☐ REPAIR ☐ MODIFY PLOT PLAN

WELL / TYPE APPLICATION: ☐ NONE ☐ NEW WELL ☐ MAJOR REPAIR ☐ ABANDONMENT

JOB LOCATION INFORMATION:

TAX/PARCEL #: Portion of 19713105
STREET ADDRESS: 9820 Brief Road
CITY: Charlotte
STATE: NC **ZIP:** 28227
SUBDIVISION OR MOBILE HOME PARK NAME: Undecided
LOT #: 12
TOWNSHIP:

☐ 0-MECKLENBURG ☐ 4-PINEVILLE
☐ 1-CHARLOTTE ☐ 5-MATTHEWS
☐ 2-DAVIDSON ☐ 6-HUNTERSVILLE
☐ 3-CORNELIUS ☒ 7-MINT HILL

BUILDING INFORMATION:

TYPE OF BUILDING:

☐ SINGLE MOBILE HOME (S) ☐ MODULAR HOME (M)
☐ DOUBLE WIDE (D) ☐ MULTIPLE FAMILY (U)
☒ HOUSE (H) ☐ OTHER

HEATED SQUARE FOOTAGE: n/a
NUMBER OF BEDROOMS: 4
NUMBER OF OCCUPANTS: n/a

FOUNDATION FOR RESIDENCE:

☐ CONCRETE SLAB ☐ BASEMENT WITH PLUMBING
☒ CRAWLSPACE ☐ BASEMENT WITH NO PLUMBING

IF PLANNING TO EXPAND/ALTER THE EXISTING SYSTEM INDICATE THE FOLLOWING CHANGES:

NUMBER OF BEDROOMS TO BE ADDED: NUMBER OF ADDITIONAL OCCUPANTS IN THE RESIDENCE:

WILL THERE BE A HOME BUSINESS IN THE RESIDENCE? ☐ YES ☐ NO TYPE:

WATER SUPPLY:

☐ MUNICIPAL (M) ☐ PUBLIC (C) ☐ PRIVATE WELL (P) ☒ SHARED WELL (S) ☐ OTHER 'SPRINGS' (O)

PROPOSED USE OF WELL: ☐ N/A ☐ IRRIGATION ☐ POTABLE ☐ GEOTHERMAL ☐ OTHER

ARE ANY OF THE FOLLOWING LOCATED ON THE PROPERTY? IF SO, PLEASE SHOW LOCATION ON SITE PLAN/PLAT.

BURIED CABLES, LANDFILLS, STUMPHOLES	☐ YES	☒ NO	WELLS, SPRINGS, OR WATER LINES	☐ YES	☒ NO
EXISTING WASTEWATER SYSTEMS	☐ YES	☒ NO	DESIGNATED WETLANDS	☐ YES	☒ NO
EASEMENTS OR RIGHT-OF-WAYS	☐ YES	☒ NO	GRADING/SOIL REMOVAL PERFORMED	☐ YES	☒ NO

PROPERTY OWNER:

NAME: Angela B. Page
ADDRESS: 9900 Brief Road
CITY: Charlotte
STATE: NC ZIP: 28227
HOME PHONE: 704.545.6375 WORK PHONE:
MOBILE PHONE: FAX:

LEGAL AGENT FOR PROPERTY OWNER, IF APPLICABLE:

NAME: J. Scot Collins
ADDRESS: 1101 Lester Mullis Road
CITY: Indian Trail
STATE: NC ZIP: 28079
HOME PHONE: 704.248.8493 WORK PHONE: 704.641.4470
MOBILE PHONE: FAX: 704.753.5898

WHAT DATE WAS THE PROPERTY ORIGINALLY DEEDED AND RECORDED? n/a
WHAT IS THE ANTICIPATED CLOSING DATE FOR THIS PROPERTY? within 30 days

*An Improvement Permit is subject to suspension or revocation if site plans or the intended use change or if information submitted in this application is falsified or changed. The undersigned, owner, or legal agent for the owner, of the property described above as the "Job Location" has read the foregoing application, acknowledges that the contents of same are true, and authorizes the Mecklenburg County Health Department to enter onto the property for the purpose of processing this request.

J. Scot Collins 5/15/06
Owner's/Agent's Signature Date


NORTH CAROLINA DEPARTMENT OF
ENVIRONMENT & NATURAL RESOURCES DIVISION
OF ENVIRONMENTAL HEALTH ON-SITE
WASTEWATER SECTION

*A Well Permit is subject to suspension or revocation if site plans or the intended use change or if information submitted in this application is falsified or changed. The undersigned, owner, or legal agent for the owner, of the property described above as the "Job Location" has read the foregoing application, acknowledges that the contents of same are true, and authorizes the Mecklenburg County Health Department to enter onto the property for the purpose of processing this request.

Owner's/Agent's Signature Date

MECKLENBURG COUNTY HEALTH DEPARTMENT
GROUNDWATER & WASTEWATER SERVICES
700 N. TRYON ST., SUITE 211
CHARLOTTE, NC 28202 704-336-5103 / FAX: 704-336-6894

Lot #12

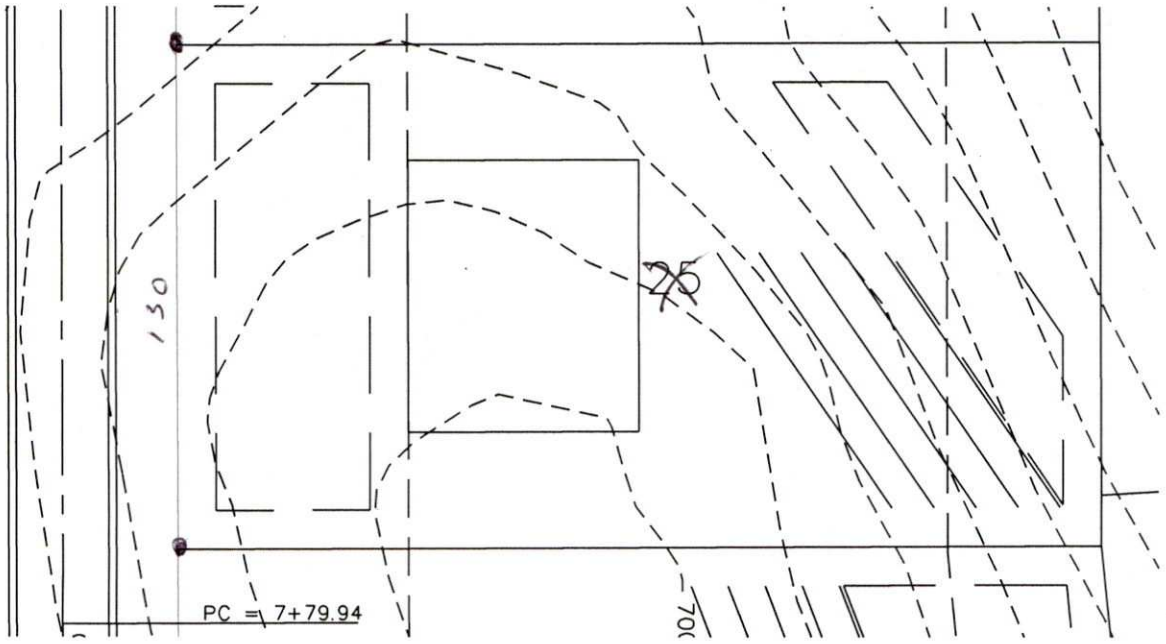

Department of Environment, Health, and Natural Resources
Division of Environmental Health
On-site Wastewater Section

Sheet: 1 of 2
Property ID: PO 197-131-05
Lot #: 12
File #: 6494B
Code: 2

SOIL/SITE EVALUATION
for ON-SITE WASTEWATER SYSTEM

Owner: Angela B . Page
Applicant: J. Scot Collins
Address: 9900 Brief Road, Charlotte, N. C., 28227
Date Evaluated: 5/31/06
Proposed Facility: Residence
Design Flow (.1949): 480gpd
Property Size: .71a
Location of Site: Off Brief Road
Property Recorded:

Water Supply:	[ ] Public	[ ] Individual	[ ] Well	[ ] Spring	[x] Other
Evaluation Method:	[x] Auger Boring		[ ] Pit	[ ] Cut	shared
Type of Wastewater:	[x] Sewage		[ ] Industrial Process	[ ] Mixed	

PROFILE #	.1940 Landscape Position/ Slope%	Horizon Depth (IN.)	SOIL MORPHOLOGY .1941 .1941 Structure/ Texture	.1941 Consistence Mineralogy	OTHER PROFILE FACTORS .1942 Soil Wetness/ Color	.1943 Soil Depth (IN.)	.1956 Sapro Class	.1944 Restr Horiz	Profile Class & LTAR
1	LS, 6	0-12	GR/SCL	FR/SEXP/SS/SP	>45" TO SOIL WETNESS	45	N/A	NONE	PS, IV
		12-45	SBK/C	FI/SEXP/S/P					.275GPD/FT^2
2	LS, 8	0-8	GR/CL	FR/SEXP/SS/SP	>33" TO SOIL WETNESS	33+	"	"	US, IV
		8-33	SBK/C	FI/SEXP/S/P					.3GPD/FT^2
		BORING TERMINATED AT 33", FLOATER ROCK							
3	"	0-10	GR/CL	FR/SEXP/SS/SP	>48" TO SOIL WWETNESS	48+	"	"	PS, IV
		10-48	SBK/C	FI/SEXP/S/P					.3GPD/FT^2
4	"	0-8	GR/CL	FR/SEXP/SS/SP	"	"	"	"	"
		8-48	SBK/C	FI/SEXP/S/P					

Description	Initial System	Repair System
Available Space (.1945)	PS	PS
System Type(s)	I Hg	I Hg
Site LTAR	.3GPD/FT^2	.3GPD/FT^2


Other Factors (.1946):
Site Classification (.1948): PROVISIONALLY SUITABLE
Evaluated By: W. R. Marlin, LSS, 6/1/2006, W. R. Marlin
Others Present:

COMMENTS:
100% repair

Landscape Position	Group	Texture	.1955 LTAR	Structure
R-Ridge	I	S-Sand	1.2 - 0.8	SG-Single Grain
SS-Shoulder Slope		LS-Loamy Sand		M-Massive
LS-Linear Slope				CR-Crumb
FS-Food Slope	II	SL-Sandy Loam	0.8 - 0.6	GR-Granular
NS-Nose Slope		L-Loam		SBK-Subangular Blocky
HS-Head Slope				ABK-Angular Blocky
CC-Concave Slope	III	SI-Silt	0.6 - 0.3	PL-Platy
CV-Convex Slope		SICL-Silty Clay Loam		PR-Prismatic
T-Terrace				
FP-Flood Plain		CL-Clay Loam		
		SCL-Sandy Clay Loam		
	IV	SC-Sandy Clay	0.4 - 0.1	
		SIC-Silty Clay		
		C-Clay		

Consistence Moist	Consistence Wet	Mineralogy
VFR-Very Friable	NS-Non-Sticky	SEXP-Slightly Expansive
FR-Friable	SS-Slightly Sticky	EXP-Expansive
FI-Firm	S-Sticky	
VFI-Very Firm	VS-Very Sticky	
EFI-Extremely Firm	NP-Non-Plastic	
	SP-Slightly Plastic	
	P-Plastic	
	VP-Very Plastic	

Sketch of Soil Evaluation Locations

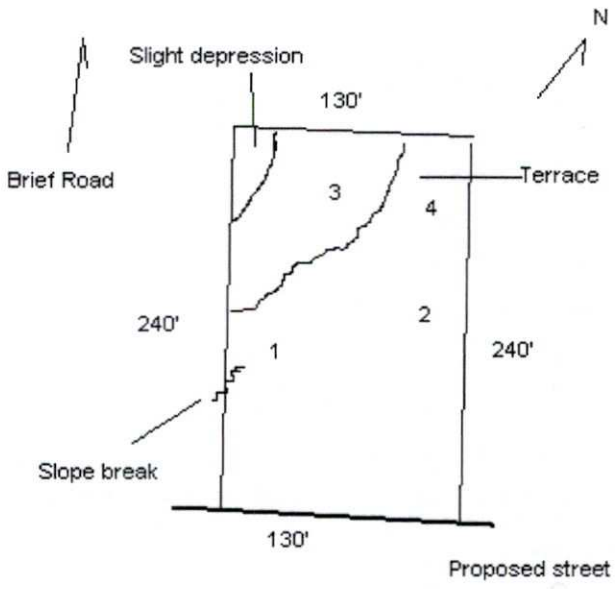

Mecklenburg County Groundwater & Wastewater Services
700 N. Tryon St, Suite 211 Charlotte, NC 28202
Phone: (704) 336-5103 Fax: (704) 336-6894

NC DENR
Division of Environmental Health
On-Site Wastewater Section

IMPROVEMENT PERMIT for a RESIDENTIAL ON-SITE WASTEWATER TREATMENT & DISPOSAL SYSTEM

Permit #: **30000810** GWS File #: **6494B** Tax Parcel #: **197-131-05**

- This IMPROVEMENT PERMIT is subject to revocation if site plans or the intended use change. There is to be **NO** grading, filling, or disturbance of the soil in the area of the septic tank system or repair area.
- CONSTRUCTION AUTHORIZATION must be obtained prior to receiving a Building Permit. The Construction Authorization is **NOT** transferable. Do not clear, grade, fill or disturb soil prior to obtaining a Construction Authorization.
- Domestic-type wastewater only. No industrial process wastewater may be discharged into the system.

I. This Improvement Permit Shall: Expire in Five (5) Years **Expiration Date (If Applicable):** 12/15/2011

Type of Installation: Residential - New System Lot Number: 12

Structure Type: HOUSE Size (ft^2): 0 # Bedrooms: 4 # Occupants: 3

Building Foundation: Crawl Space Water Supply: Municipal

II. Initial System Type: Innovative or Experimental **System Classification:** IIIg

Initial System Specifications:

Design Flow (gpd):	480	LTAR (gpd/ft^2):	0.3	Septic Tank Size (gal):	1500	Pump Tank Size (gal):	N/A
Trench Width (ft):	3	Trench Spacing (ft):	9	Absorption Area (ft^2):	1200	Total Trench Length (ft):	400
Maximum Trench Depth (in):	30	Depth of Media (in):	N/A	Distribution Device:	Distribution Box		

III. Repair System Type: Innovative or Experimental **System Classification:** IIIg

Repair System Specifications:

Design Flow (gpd):	480	LTAR (gpd/ft^2):	0.3	Septic Tank Size (gal):	1500	Pump Tank Size (gal):	N/A
Trench Width (ft):	3	Trench Spacing (ft):	9	Absorption Area (ft^2):	1200	Total Trench Length (ft):	400
Maximum Trench Depth (in):	30	Depth of Media (in):	N/A	Distribution Device:	Distribution Box		

IV. Permit Conditions/Comments:

(Please See the Following Page for Permit Conditions.)

The undersigned, an authorized agent of the MECKLENBURG COUNTY HEALTH DEPARTMENT, certifies that the Department is issuing an IMPROVEMENT PERMIT for the above referenced property. This permit is being issued in accordance with the *Laws and Rules For Sewage Treatment, and Disposal Systems* and is subject to the following provisions:

- No work shall be conducted on the septic system until an INSTALLATION APPROVAL is granted by the Department.
- The septic system installer shall be a registered septic contractor with Mecklenburg County Health Department.
- The permitted system shall be installed in accordance with the included PLOT PLAN.
- This IMPROVEMENT PERMIT is transferable.

DENR Authorized Agent: David Cornelius Owner/Legal Agent: _____
Print Name

Signature: _____ Signature: _____

Date Issued: 12/15/2006

Mecklenburg County Groundwater & Wastewater Services
700 N. Tryon St, Suite 211 Charlotte, NC 28202
Phone: (704) 336-5103 Fax: (704) 336-6894

NC DENR
Division of Environmental Health
On-Site Wastewater Section

IMPROVEMENT PERMIT for a RESIDENTIAL ON-SITE WASTEWATER TREATMENT & DISPOSAL SYSTEM

Permit #: **30000810** GWS File #: **6494B**

IV. Permit Conditions/Comments:

- All components of the septic system must be installed in accordance with the required setbacks listed on the corresponding plot plan.
- All components of the septic system must be located at least 100 ft. (50 ft. minimum) from all private wells.

The undersigned, an authorized agent of the MECKLENBURG COUNTY HEALTH DEPARTMENT, certifies that the Department is issuing an IMPROVEMENT PERMIT for the above referenced property. This permit is being issued in accordance with the *Laws and Rules For Sewage Treatment and Disposal Systems* and is subject to the following provisions:

- No work shall be conducted on the septic system until an INSTALLATION APPROVAL is granted by the Department.
- The septic system installer shall be a registered septic contractor with Mecklenburg County Health Department.
- The permitted system shall be installed in accordance with the included PLOT PLAN.
- This IMPROVEMENT PERMIT is transferable.

DENR Authorized Agent: David Cornelius

Signature: _____

Date Issued: 12/15/2006

Owner/Legal Agent: _____
Print Name

Signature: _____

PROPOSED PLOT PLAN


SCALE 1"=50'
LOT # ~~12~~ 25

HEALTH DEPARTMENT
ENVIRONMENTAL HEALTH DIVISION
700 NORTH TRYON ST., SUITE 211
CHARLOTTE, NC 28202
PHONE (704) 336-5103

FILE: 6494B

TC: 197-131-05

Draw in and name all roads adjoining the property. Draw in and accurately dimension the lot concerned. Accurately indicate property boundaries proposed and/or existing structures and driveways, underground utilities, and wells and springs within 100 feet of the proposed building or drainfield.

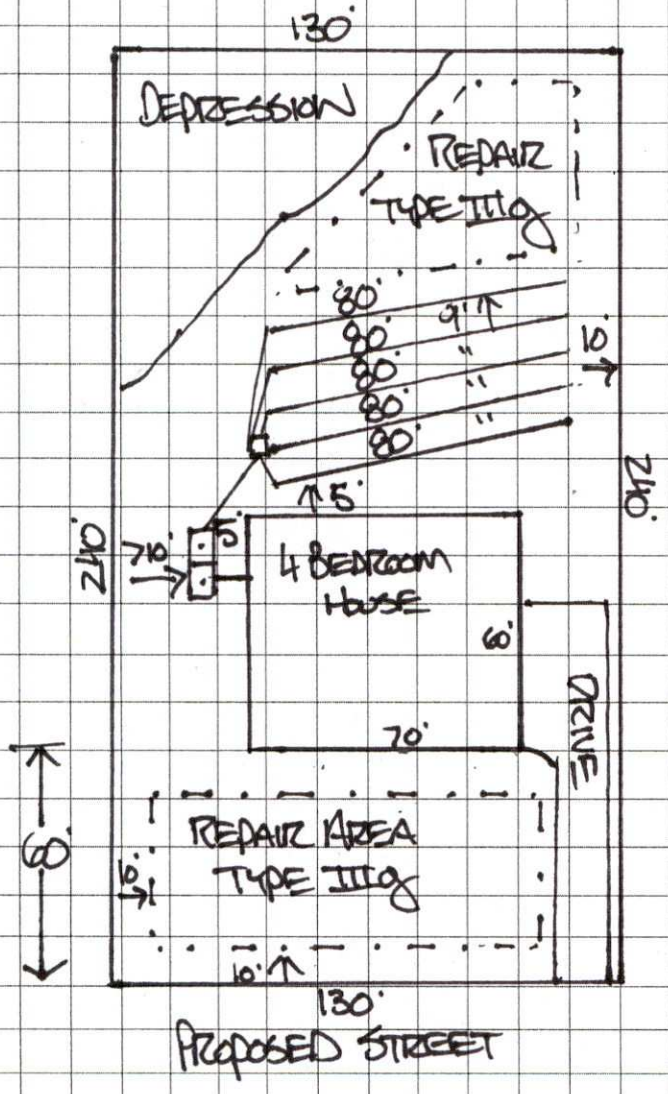

- SEPTIC SYSTEM DESIGN FOR A 4 BEDROOM HOUSE
- 480 GALLONS PER DAY
- LTAR = 0.3
- TOTAL LINEAR FT = 400
- INNOVATIVE, 25% REDUCTION
- TYPE - IIIg
- INSTALL - 5 LINES @ 80'
- PLACE LINES LEVEL, ON CONTOUR & ON 9' CENTERS.
- 1500 GAL SEPTIC TANK
- DISTRIBUTION - D-BOX
- REPAIR AREA - IIIg

SETBACKS:
KEEP ALL PART OF SYSTEM:
> 5' FROM HOUSE FOUNDATION
> 10' FROM PROPERTY LINES

OWNER/AGENT SIGNATURE

DATE

APPROVAL DATE

White - Health Department's Copy Canary - E.H.S. Copy Pink - Owner's Copy

FEE: 300.00
DATE: 12/20/2007

CONSTRUCTION AUTHORIZATION FOR AN ON-SITE WASTEWATER TREATMENT & DISPOSAL SYSTEM

MECKLENBURG COUNTY
GROUNDWATER & WASTEWATER SERVICES

FILE NUMBER: 6494B

PERMIT NUMBER: 30000810

PARCEL NUMBER: 19713132

JOB LOCATION INFORMATION

ADDRESS: 8238 CURICO LN

CITY: CHARLOTTE **STATE: NC** **ZIP:** 28227

ISSUED TO: Angela B. Page

CONSTRUCTION AUTHORIZATION ISSUANCE DATE: 12/20/2007

CONSTRUCTION AUTHORIZATION CONDITIONS

1. WASTEWATER SYSTEM CONSTRUCTION AND INSTALLATION MUST MEET ALL CONDITIONS AND SPECIFICATIONS AS SET FORTH IN IMPROVEMENT PERMIT NUMBER 30000810, AND THE ATTACHED SITE PLAN WITH SYSTEM DETAILS. CONSTRUCTION AND INSTALLATION MUST ALSO MEET ALL REQUIREMENTS SET FORTH IN THE RULES GOVERNING SANITARY SEWAGE COLLECTION, TREATMENT, AND DISPOSAL AND ANY OTHER APPLICABLE RULES AND LAWS.

2. AN INSTALLATION APPROVAL MUST BE SECURED PRIOR TO INSTALLATION OF THE SEPTIC TANK SYSTEM. THE INSTALLER OF THE SYSTEM SHALL BE A REGISTERED SEPTIC TANK CONTRACTOR WITH THE MECKLENBURG COUNTY HEALTH DEPARTMENT.

3. ANY ALTERATION IN SITE OR SOIL CONDITIONS (INCLUDING LOCATION OF STRUCTURES AND APPURTENANCES) OR MODIFICATION IN USE, DESIGN WASTEWATER FLOW, OR WASTEWATER CHARACTERISTICS AS SPECIFIED IN THE ASSOCIATED IMPROVEMENT PERMIT AND APPLICATION, MAY SUBJECT THIS CONSTRUCTION AUTHORIZATION AND ASSOCIATED PERMIT(S) TO REVOCATION.

4. THIS CONSTRUCTION AUTHORIZATION AS PROVIDED IN G.S. 130A-335(f) AND G.S. 130A-336(b) SHALL BE VALID FOR A PERIOD EQUAL TO THE VALIDITY OF THE IMPROVEMENT PERMIT, NOT TO EXCEED 60 MONTHS.
   *CONSTRUCTION AUTHORIZATION EXPIRATION DATE: 12/15/2011

Mecklenburg County Groundwater & Wastewater Services
700 N. Tryon St., Suite 211 Charlotte, NC 28202
Phone: (704) 336-5103 Fax: (704) 336-6894

NC DENR
Division of Environmental Health
On-Site Wastewater Section

INSTALLATION APPROVAL for an ON-SITE WASTEWATER TREATMENT & DISPOSAL SYSTEM

File #: 6448 B Permit #: 30000810 Tax Parcel #: 197-131-05

Property Owner: First Legacy Homes

Job Location Address: 8238 Curico Dr. Lot # 25

City: MINT HILL State: NC Zip Code: _____

Installation Approval Issuance Date: 02-14-08

Permission is hereby given to ☒ install ☐ alter ☐ repair an on-site wastewater treatment & and disposal system, with subsurface soil absorption and effluent discharge, as specified herein at the described location. This approval is granted based upon the application information submitted to our office. All work shall be completed on or before 03-14-08, after which date this approval shall be null and void. The system shall meet all of the construction requirements of 15A NCAC 18A. 1900 which are in effect on the date of granting this approval. An **Operation Permit** must be obtained from the Mecklenburg County Health Department before any system can be covered up or placed into service. The issuance of this permit does not in any way guarantee that the system anticipated to be constructed will operate properly, or relieve any person now of hereafter owning, controlling or using such system from any liability resulting from the failure of the system to operate properly.

***NOTICE: This system shall not be installed while soils are in a wet condition.**

Permitted Design Flow: 480 GPD

Site LTAR: 0,3 GPD/ft² (For new installations only.)

Liquid Capacity of Septic Tank: 1500 gallons

Liquid Capacity of Dosing Tank: N/A gallons

Drainfield Design ☐ N/A

Trench Depth: 36 inches

Trench Width: 3 feet

Line Spacing: 9 feet (O.C.)

Total line length: 400 feet

# of Lines: 5 @ 80 feet

Depth of Media: 12 inches (Type) EZ FLOW

Distribution Device: D-Box

Bed Design *(For Repair Installations ONLY.)* ☒ N/A

Bed Depth: _____ inches

Bed Width: _____ feet

Total line length: _____ feet

# of Lines: _____ @ _____ feet

Depth of Media: _____ inches (Type) _____

Distribution Device: _____

Water Supply Source

☒ Municipal ☐ Private Well ☐ Community Well

☐ Other _____


Minimum System Setbacks

Distance from Building Foundation: 5 feet

Distance from Property Line: 10 feet

Distance from Water Supply Source: 10 feet

SKETCH OF SYSTEM LAYOUT
(Proposed Layout)

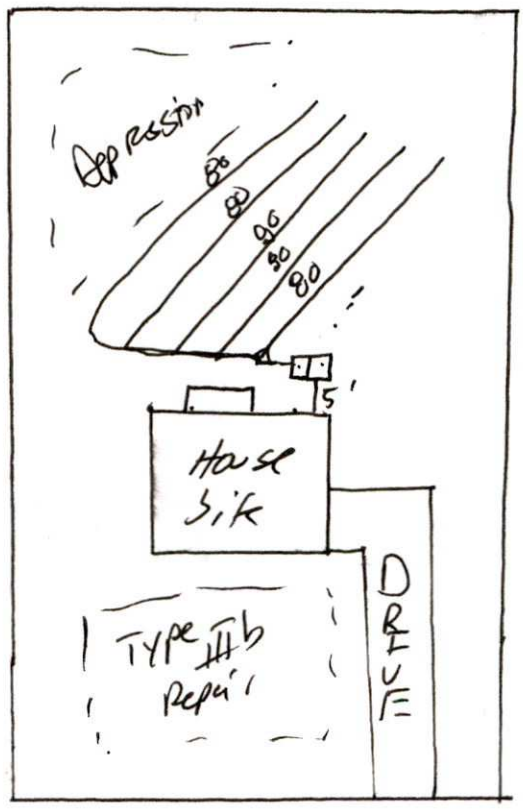

Comments: System Classification & Type: IIIg

DENR Authorized Agent: Jeremy Michael Signature: Jeremy Michael

Mecklenburg County Groundwater & Wastewater Services
700 N. Tryon St., Suite 211 Charlotte, NC 28202
Phone: (704) 336-5103 Fax: (704) 336-6894

NC DENR
Division of Environmental Health
On-Site Wastewater Section

OPERATION PERMIT for an ON-SITE WASTEWATER TREATMENT & DISPOSAL SYSTEM

File #: 6494B Permit #: 30000810 Tax Parcel #: 197131-32

Property Owner: Angela B. Page

Job Location Address: 8238 CURICO LN.

City: CHARLOTTE State: NC Zip Code: 28227

Operation Permit Issuance Date: 05-08-2008 Contractor Name: Stevens Trucking & Septic Tank

Permitted Design Flow: 480 GPD

Liquid Capacity of Septic Tank: 1500 gallons

Liquid Capacity of Dosing Tank: N/A gallons

Effluent Pump Model: N/A

Drainfield Installation ☐ N/A

Trench Depth: 30 inches

Trench Width: 3 feet

Line Spacing: 9 feet (O.C.)

Total line length: 400 feet

# of Lines: 6 @ _____ feet

Depth of Media: 12 inches (Type) EZ Flow

Depth of Cover: 18 inches

Distribution Device: Drop Boxes

Line lengths Top to Bottom
50', 60', 80', 30'
110', 70'
various lengths

Bed Installation *(For Repair Installations ONLY.)* ☒ N/A

Bed Depth: _____ inches

Bed Width: _____ feet

Total line length: _____ feet

# of Lines: _____ @ _____ feet

Depth of Media: _____ inches (Type) _____

Depth of Cover: _____ inches

Distribution Device: _____

Water Supply Source

☒ Municipal ☐ Private Well ☐ Community Well

☐ Other _____

System Installation Setbacks

Distance from Building Foundation: 5 feet

Distance from Property Line: 10 feet

Distance from Water Supply Source: 10 feet


Inspection Dates

Tank(s) Inspected: 05-08-2008

Excavation Inspected: 05-08-2008

Pump & Controls Inspected: N/A

SKETCH OF SYSTEM INSTALLATION
(As-Built Drawing)

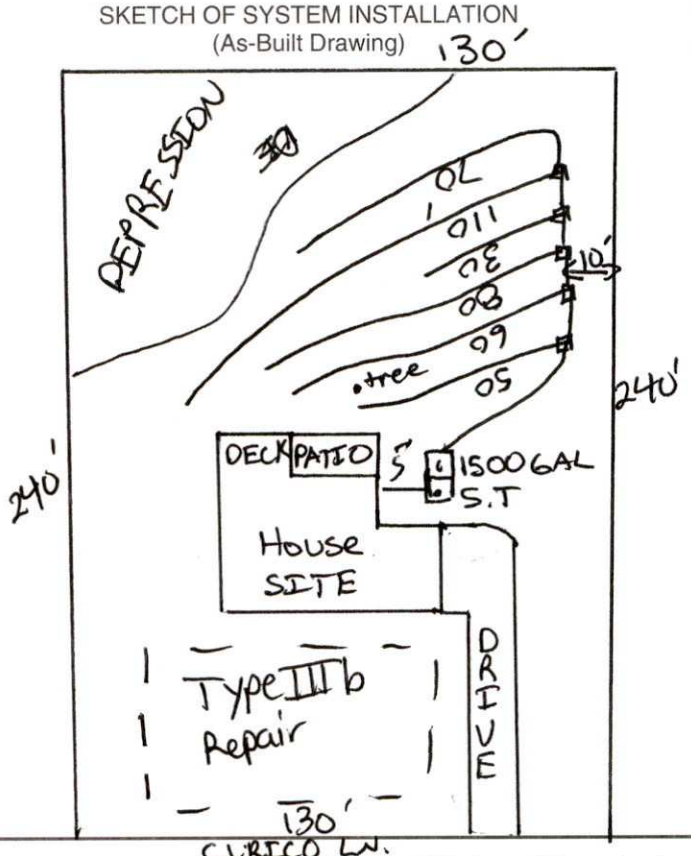

The undersigned has inspected the Septic Tank System described above, and certifies it has been ☐ installed ☐ altered ☐ repaired ☐ as detailed in the plot above ☐ in accordance with the permit issued and meets the provisions of 15A NCAC 18A. 1900, "Laws and Rules for Sewage Treatment and Disposal Systems" in effect on the date of issuance of the permit. The issuance of this Operation Permit does not in any way guarantee that the system will operate properly or relieve any person now or hereafter owning, controlling, or using such system from any liability resulting from the failure of the system to operate properly. This document is issued subject to those restrictions and conditions shown on the permit(s) and the provisions of 15A NCAC 18A. 1900 in addition to those listed below under "Comments." This document shall be null and void if any information contained in the application is untrue or if any additions are made to the property which would increase the requirements for said system.

Notice: Disturbance of the designated repair area may result in the Suspension or Revocation of this permit.

Comments: System Classification & Type: IIIg

EZ1203H, G, NA, NA. (3HRS) JAM

DENR Authorized Agent: Jeremy Michael Signature: Jeremy Michael

Mecklenburg County Groundwater & Wastewater Services
700 N. Tryon St., Suite 211 Charlotte, NC 28202
Phone: (704) 336-5103 Fax: (704) 336-6894

NC DENR
Division of Environmental Health
On-Site Wastewater Section

OPERATION PERMIT for an
ON-SITE WASTEWATER TREATMENT & DISPOSAL SYSTEM

File #: 6494B Permit #: 30000810 Tax Parcel #: 197-131-32

Property Owner: Angela B. Page

Job Location Address: 8238 CURICO LN.

City: Charlotte State: NC Zip Code: 28227

OPERATION PERMIT CONDITIONS:

I. Performance: System shall perform in accordance with 15A NCAC 18A .1961.

II. Monitoring: System shall be monitored as required by 15A NCAC 18A .1961.

III. Maintenance: Ground absorption sewage treatment and disposal systems shall be checked, and the contents of the septic tank removed, periodically from all compartments, to ensure proper operation of the system. The contents shall be pumped whenever the solids level is found to be more than 1/3 of the liquid depth in any compartment.

IV. Operation: System shall be operated in accordance with 15A NCAC 18A .1961.

System Classification: IIIg

*Operation Permits for Type V and VI systems expire five (5) years from the date of issuance (in accordance with Table V(a)). The system owner must contact GWS six (6) months prior to expiration for permit renewal.

Subsurface system operator required: Yes ☐ No ☒

☐ This type of system requires the system owner to maintain a contract with a certified operator to perform system inspection, maintenance, and reporting as required in 15A NCAC 18A .1961. and Table V(a). The system owner is responsible for all fees associated with these services.

☒ System does not require inspection by GWS on a routine frequency.

☐ System requires inspection by GWS once every five (5) years. The system owner is responsible for all fees associated with the inspection.

☐ System requires inspection by GWS once every three (3) years. The system owner is responsible for all fees associated with the inspection.

☐ System requires inspection by GWS once every twelve (12) months. The system owner is responsible for all fees associated with the inspection.

☐ System requires inspection by GWS once every six (6) months. The system owner is responsible for all fees associated with the inspection.

V. Other:

DENR Authorized Agent: Jeremy Michael Date: 05-08-2008

Signature: Jeremy Michael