163A
#11313

MECKLENBURG COUNTY
HEALTH DEPARTMENT

APPLICATION FOR A RESIDENTIAL SITE IMPROVEMENT PERMIT/ CONSTRUCTION AUTHORIZATION FOR AN ON-SITE WASTEWATER SYSTEM, NEW WELL INSTALLATION, OR REPAIR OF EXISTING WELL

1. SEPTIC / TYPE APPLICATION: ○ N/A ○ NEW SYSTEM ○ ALTERATION ◉ REPAIR ○ MODIFIED PLOT PLAN

2. WELL / TYPE APPLICATION: ○ N/A ○ NEW WELL ○ MAJOR REPAIR ○ ABANDONMENT

3. JOB LOCATION INFORMATION:

TAX PARCEL NUMBER: 195-101-19
STREET ADDRESS: 14024 Thompson Rd
CITY: Mint Hill
STATE: NC **ZIP:** 28227
SUBDIVISION NAME:
LOT #: **LOT SIZE (acres):** 1.52

TOWNSHIP:
○ MECKLENBURG ○ CORNELIUS ○ HUNTERSVILLE
○ DAVIDSON ○ CHARLOTTE ○ PINEVILLE
○ MATTHEWS ◉ MINT HILL

4. BUILDING INFORMATION:

BUILDING TYPE:
○ SINGLE MOBILE HOME ○ MODULAR HOME
○ DOUBLE WIDE ○ MULTIPLE FAMILY
◉ HOUSE ○ OTHER

HEATED SQUARE FOOTAGE: 2,319
NUMBER OF BEDROOMS: 3
NUMBER OF OCCUPANTS: 4

FOUNDATION TYPE:
○ CONCRETE SLAB ○ BASEMENT WITH PLUMBING
◉ CRAWL SPACE ○ BASEMENT WITH NO PLUMBING

5. IF PLANNING TO EXPAND OR ALTER THE EXISTING SEPTIC SYSTEM PLEASE COMPLETE THE FOLLOWING SECTION: ☐ N/A

NUMBER OF BEDROOMS TO BE ADDED: _____ NUMBER OF ADDITIONAL OCCUPANTS IN THE RESIDENCE: _____

6. WATER SUPPLY: ○ MUNICIPAL ○ PRIVATE WELL ○ PUBLIC WELL ○ SHARED WELL ○ OTHER

7. PROPOSED USE OF WELL: ○ N/A ○ IRRIGATION ○ POTABLE (DRINKING WATER) ○ OTHER

8. PLEASE INDICATE AND RANK DESIRED SEPTIC SYSTEM TYPE(S) IN ORDER OF PREFERENCE *(1-MOST DESIRED 5-LEAST DESIRED):*

☐ N/A ☐ ANY TYPE ☐ CONVENTIONAL ☐ ACCEPTED ☐ INNOVATIVE ☐ ALTERNATIVE ☐ OTHER

8A. RANK: ____ ____ ____ ____ ____

9. DO ANY OF THE FOLLOWING APPLY TO THE PROPERTY IN QUESTION? IF "YES" PLEASE ATTACH SUPPORTING DOCUMENTATION.

BURIED CABLES, LANDFILLS, STUMPHOLES	○ YES ◉ NO	GRADING/SOIL REMOVAL PERFORMED	○ YES ◉ NO
EXISTING WASTEWATER (SEPTIC) SYSTEMS	◉ YES ○ NO	JURISDICTIONAL WETLANDS	○ YES ◉ NO
WELLS, SPRINGS, OR WATER LINES	◉ YES ○ NO	APPROVAL REQUIRED BY ANY OTHER PUBLIC AGENCY	○ YES ◉ NO
EASEMENTS OR RIGHT-OF-WAYS	○ YES ◉ NO	WASTEWATER OTHER THAN DOMESTIC SEWAGE	○ YES ◉ NO
CHEMICAL/PETROLEUM STORAGE TANKS	○ YES ◉ NO	KNOWN UNDERGROUND CONTAMINATION	○ YES ○ NO
WASTE STORAGE	○ YES ◉ NO	GROUNDWATER USE RESTRICTIONS/VARIANCES	○ YES ◉ NO

10. WHAT DATE WAS THE PROPERTY ORIGINALLY DEEDED AND RECORDED? 1/15/85 ☐ UNKNOWN

11. WHAT IS THE ANTICIPATED CLOSING DATE FOR THIS PROPERTY? 7/15/20 ☐ N/A

12. PROPERTY OWNER:

NAME: Lila Peggy Collins
ADDRESS: 14024 Thompson Rd
CITY: Mint Hill
STATE: NC ZIP: 28227
WORK PHONE:
MOBILE PHONE:
FAX:
E-MAIL:

13. OWNER'S LEGAL REPRESENTATIVE, IF APPLICABLE:

NAME: Peggy Sue Johnson (POA)
ADDRESS: 6063 Grand Hill Lane
CITY: Denver
STATE: NC ZIP: 28037
WORK PHONE:
MOBILE PHONE: (704) 236-2010
FAX:
E-MAIL: susie.johnson@allentate.com

MECKLENBURG COUNTY – GROUNDWATER & WASTEWATER SERVICES
3205 Freedom Dr. Suite 8000, Charlotte, NC 28208 OFFICE: (980) 314-1680, FAX: 704-336-6894

Revised on: 03/27/19

14. SEPTIC SYSTEM PERMIT APPLICATION:

If the information in this application is falsified, changed, or the site is altered, then the Improvement Permit and Authorization to Construct shall become invalid. I have read this application and certify that the information provided herein is true, complete and correct. Authorized county and state officials are granted right of entry to conduct necessary inspections to determine compliance with applicable laws and rules. I understand that I am solely responsible for the proper identification and labeling of all property lines and corners and making the site accessible so that a complete site evaluation can be performed. The permit is valid for either sixty (60) months or is non-expiring depending upon the documentation submitted: complete site plan = 60 months, complete plat = non-expiring.

_____ (Initial here for septic system applications)

15. WELL PERMIT APPLICATION:

If the information in this application is falsified, changed, or the site is altered, then the Well Permit shall become invalid. I have read this application and certify that the information provided herein is true, complete and correct. Authorized county and state officials are granted right of entry to conduct necessary inspections to determine compliance with applicable laws and rules. I understand that I am solely responsible for the proper identification and labeling of all property lines and corners and making the site accessible so that a complete site evaluation can be performed. The permit is valid for a period of twelve (12) months from the date of issuance.

_____ (Initial here for well applications)

16. APPLICATION SIGNATURE SECTION:

ONLY COMPLETE APPLICATIONS WILL BE PROCESSED. A proper signature is required in order to process your application. Please review the application carefully and sign in the space provided below. A PROPOSED PLOT PLAN is required to be submitted with each application.

_____ _____

Property Owner's or Owner's Legal Representative Signature Date

---

OFFICE USE ONLY

○ SURVEY PLAT TO SCALE SUBMITTED ○ SCALED SITE PLAN SUBMITTED ○ UN-SCALED SITE PLAN SUBMITTED

SEPTIC APPLICATION FEE RECEIVED: $ _____ DATE FEE RECEIVED: _____

WELL APPLICATION FEE RECEIVED: $ _____ DATE FEE RECEIVED: _____

APPLICATION PROCESSED BY: _____

GWS FILE NUMBER ASSIGNED: _____

APPLICATION ID NUMBER ASSIGNED: _____

COMMENTS:

_____

_____

_____

_____

_____

_____

_____

_____

_____

_____

MECKLENBURG COUNTY – GROUNDWATER & WASTEWATER SERVICES
3205 Freedom Dr. Suite 8000, Charlotte, NC 28208 OFFICE: (980) 314-1680, FAX: 704-336-6894

Revised on: 03/27/19


File #: _____

PROPOSED PLOT PLAN

A drawing showing the locations of the following items is required: existing and proposed property lines with dimensions, easements or right-of-ways, proposed building pad(s) or existing building footprint(s), all appurtenances (garage, driveway, deck, pool, etc.), location of existing or proposed well(s), location of existing or proposed sewer lines and sewage disposal systems, surface water bodies, and any aboveground or underground storage tanks. Provide names for all roads that adjoin the property.

Street Address: _____ Tax Parcel #: _____

Subdivision Name: _____ Lot #: _____

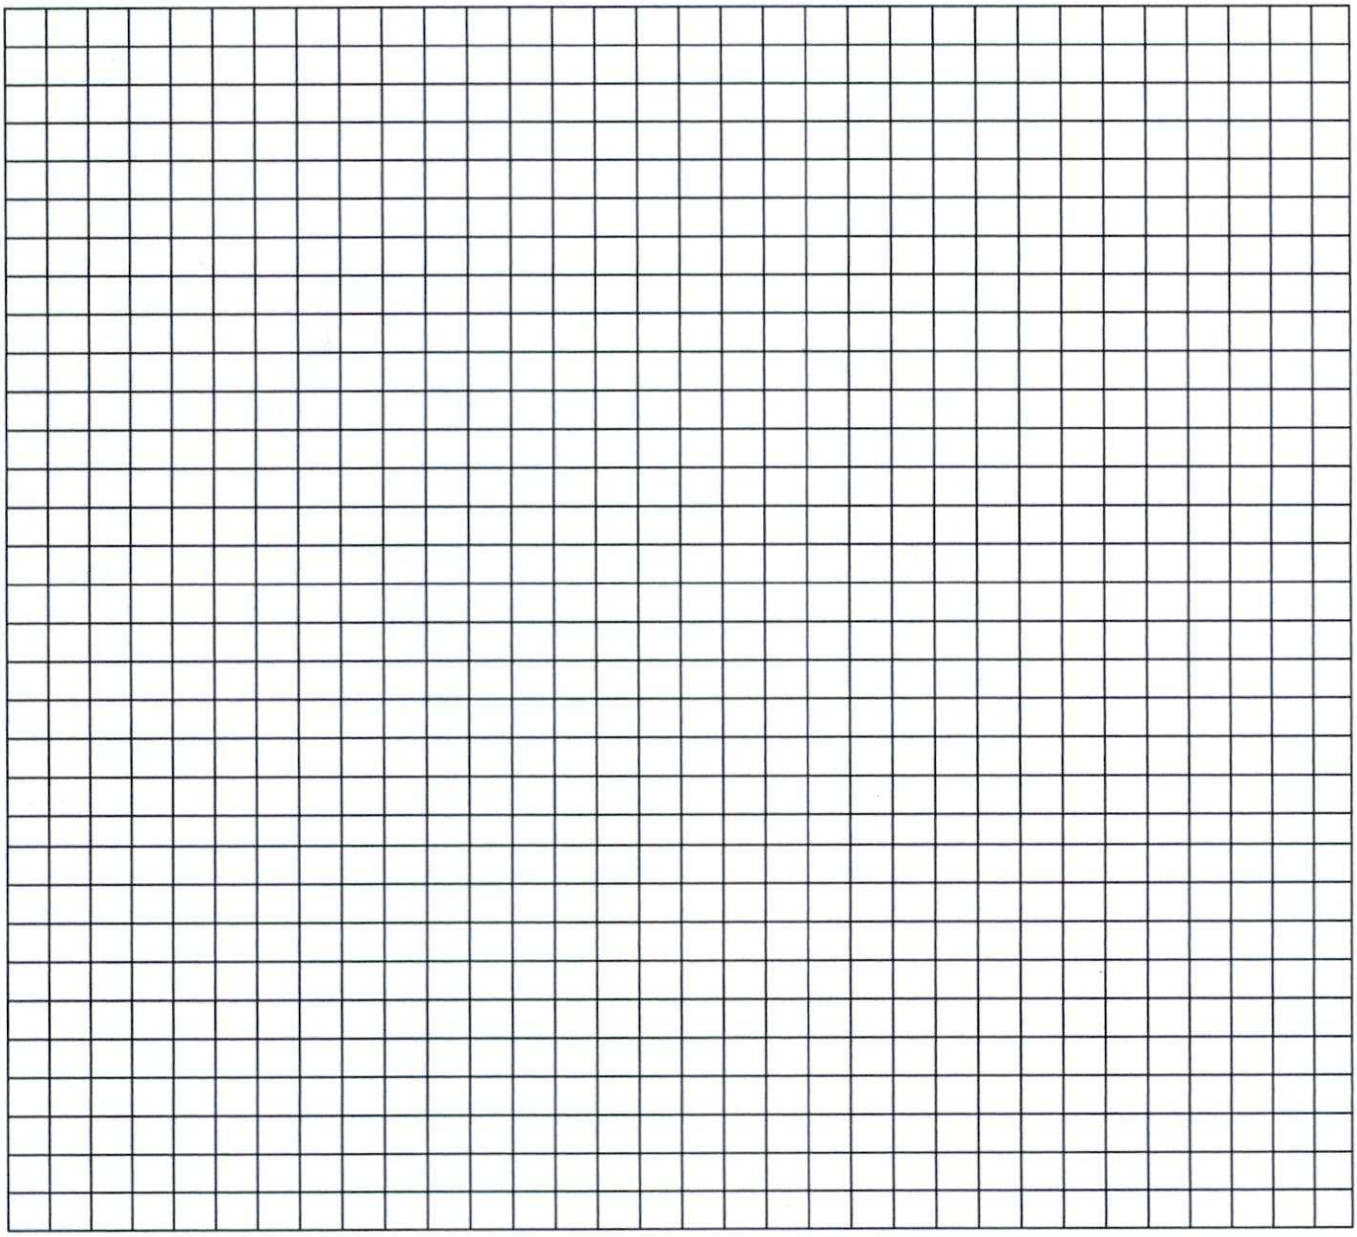

_____ _____

Property Owner's or Owner's Legal Representative Signature Date

MECKLENBURG COUNTY – GROUNDWATER & WASTEWATER SERVICES
3205 Freedom Dr. Suite 8000, Charlotte, NC 28208, OFFICE: (980) 314-1680, FAX: 704-336-6894

Revised on: 03/27/19

DEPARTMENT OF HEALTH AND HUMAN SERVICES
DIVISION OF PUBLIC HEALTH, ENVIRONMENTAL HEALTH SECTION
ON-SITE WATER PROTECTION BRANCH

Sheet 1 of 1
PROPERTY ID #:
COUNTY: Meck

195-101-19
163A

SOIL/SITE EVALUATION
for ON-SITE WASTEWATER SYSTEM
(Complete all fields in full)

OWNER: Lila Peggy Collins
ADDRESS: 14024 Thompson Rd
PROPOSED FACILITY: House
LOCATION OF SITE: Charlotte

APPLICATION DATE: 6/17/20
DATE EVALUATED: 6/17/20
PROPOSED DESIGN FLOW (.1949): 360
PROPERTY SIZE: 1.5
PROPERTY RECORDED:

WATER SUPPLY: ☑ Private ☐ Public ☐ Well ☐ Spring ☐ Other
EVALUATION METHOD: ☑ Auger Boring ☐ Pit ☐ Cut
TYPE OF WASTEWATER: ☐ Sewage ☐ Industrial Process ☐ Mixed

PROFILE #	.1940 LANDSCAPE POSITION/ SLOPE %	HORIZON DEPTH (IN.)	SOIL MORPHOLOGY (.1941) .1941 STRUCTURE/ TEXTURE	SOIL MORPHOLOGY (.1941) .1941 CONSISTENCE/ MINERALOGY	OTHER PROFILE FACTORS .1942 SOIL WETNESS/ COLOR	.1943 SOIL DEPTH	.1956 SAPRO CLASS	.1944 RESTR HORIZ	PROFILE CLASS & LTAR
1	1%	0-12	CL SS, SP, Fr	SexP	>48	48	NA	NA	.3
		12-48	CL, SS, SP, Fr	SexP					
2	1%	0-12	CL, SS, SP, Fr	SexP	>48	48	NA	NA	.3
		12-21	CL, SS, SP, Fr	SexP					
		21-48	C, SS, P, Fr	SexP					
3									
4									

DESCRIPTION	INITIAL SYSTEM	REPAIR SYSTEM
Available Space (.1945)	PS	PS
System Type(s)	1111bg	1111bg
Site LTAR	.3	.3

OTHER FACTORS (.1946):
SITE CLASSIFICATION (.1948): PS
EVALUATED BY: Bryan Davenport
OTHER(S) PRESENT:

COMMENTS:

Mecklenburg County Groundwater & Wastewater Services
3205 Freedom Dr. Suite 8000 Charlotte, NC 28208
Phone: (980) 314-1680 Fax: (704) 336-6894

NC DHHS
Division of Environmental Health
On-Site Wastewater Section

IMPROVEMENT PERMIT/CONSTRUCTION AUTHORIZATION for REPAIRING an ON-SITE WASTEWATER TREATMENT & DISPOSAL SYSTEM

File #: 163A Permit #: 11313 Tax Parcel #: 195-101-19

Property Owner: Peggy Collins

Job Location Address: 14024 Thompson Rd

City: Charlotte State: NC Zip Code: 28227

Improvement Permit Issuance Date: 6/5/20 **Construction Authorization Issuance Date:** _____

Permission is hereby given to **repair** an on-site wastewater treatment & and disposal system, with subsurface soil absorption and effluent discharge, as specified herein at the described location. This approval is granted based upon the application information submitted to our office. All work shall be completed on or before _____. The system shall meet all of the construction requirements of 15A NCAC 18A. 1900 which are in effect on the date of granting this approval. An **Operation Permit** must be obtained from the Mecklenburg County Health Department before any system can be covered up or placed into service. The issuance of this permit does not in any way guarantee that the system anticipated to be constructed will operate properly, or relieve any person now of hereafter owning, controlling or using such system from any liability resulting from the failure of the system to operate properly.

Permitted Design Flow: existing GPD

Liquid Capacity of Septic Tank: 1000 gallons

Site LTAR: existing GPD/ft²

Liquid Capacity of Dosing Tank: N/A gallons

Drainfield Design ☐ N/A

Trench Depth: _____ inches

Trench Width: _____ feet

Line Spacing: _____ feet (O.C.)

Total line length: _____ feet

# of Lines: _____ @ _____ feet

Depth of Media: _____ inches (Type) _____

Distribution Device: _____

Bed Design *(For Repair Installations ONLY.)* ☐ N/A

Bed Depth: _____ inches

Bed Width: _____ feet

Total line length: _____ feet

# of Lines: _____ @ _____ feet

Depth of Media: _____ inches (Type) _____

Distribution Device: _____

Water Supply Source

☐ Municipal ☑ Private Well ☐ Community Well

☐ Other _____


Minimum System Setbacks

Distance from Building Foundation: 13 feet

Distance from Property Line: 73 feet

Distance from Water Supply Source: 10 feet

SKETCH OF SYSTEM LAYOUT
(Proposed Layout)

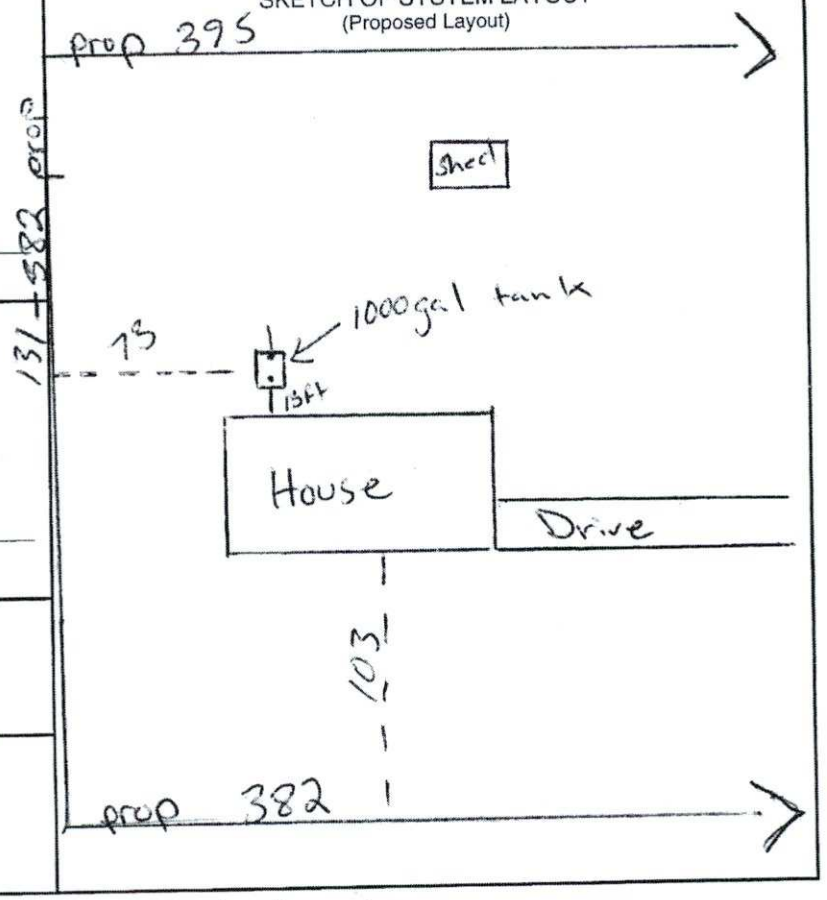

Comments: System Classification & Type: Tank IIa/6/NA/NA

new 1000 gal tank

Authorized Agent: Bryan Davenport Signature: B Davenport

Owner Signature: _____ Date: 6/5/20

DocuSign Envelope ID: FD32C968-554B-4AE8-BF93-89CB4F6F698D
Mecklenburg County Groundwater & Wastewater Services
3205 Freedom Dr. Suite 8000 Charlotte, NC 28208
Phone: (980) 314-1680 Fax: (704) 336-6894

NC DHHS
Division of Environmental Health
On-Site Wastewater Section

IMPROVEMENT PERMIT/CONSTRUCTION AUTHORIZATION for REPAIRING an ON-SITE WASTEWATER TREATMENT & DISPOSAL SYSTEM

File #: 163A Permit #: 11313 Tax Parcel #: 195-101-19

Property Owner: Peggy Collins

Job Location Address: 14024 Thompson Rd

City: Charlotte State: NC Zip Code: 28227

Improvement Permit Issuance Date: 6/5/20 **Construction Authorization Issuance Date:** _____

Permission is hereby given to **repair** an on-site wastewater treatment & and disposal system, with subsurface soil absorption and effluent discharge, as specified herein at the described location. This approval is granted based upon the application information submitted to our office. All work shall be completed on or before _____. The system shall meet all of the construction requirements of 15A NCAC 18A. 1900 which are in effect on the date of granting this approval. An **Operation Permit** must be obtained from the Mecklenburg County Health Department before any system can be covered up or placed into service. The issuance of this permit does not in any way guarantee that the system anticipated to be constructed will operate properly, or relieve any person now of hereafter owning, controlling or using such system from any liability resulting from the failure of the system to operate properly.

Permitted Design Flow: existing GPD

Liquid Capacity of Septic Tank: 1000 gallons

Site LTAR: existing GPD/ft²

Liquid Capacity of Dosing Tank: N/A gallons

Drainfield Design ☑ N/A

Trench Depth: _____ inches

Trench Width: _____ feet

Line Spacing: _____ feet (O.C.)

Total line length: _____ feet

# of Lines: _____ @ _____ feet

Depth of Media: _____ inches (Type) _____

Distribution Device: _____

Bed Design *(For Repair Installations ONLY.)* ☑ N/A

Bed Depth: _____ inches

Bed Width: _____ feet

Total line length: _____ feet

# of Lines: _____ @ _____ feet

Depth of Media: _____ inches (Type) _____

Distribution Device: _____

Water Supply Source

☐ Municipal ☑ Private Well ☐ Community Well

☐ Other _____


Minimum System Setbacks

Distance from Building Foundation: 13 feet

Distance from Property Line: 73 feet

Distance from Water Supply Source: 10 feet

SKETCH OF SYSTEM LAYOUT
(Proposed Layout)

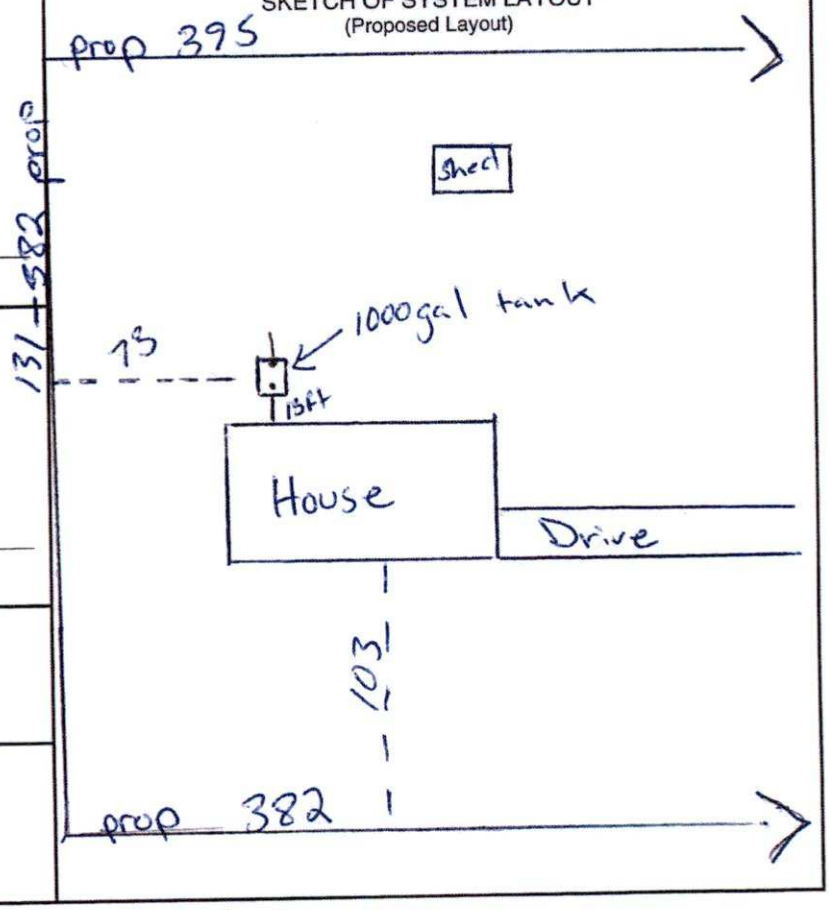

Comments: System Classification & Type: Tank IIa/6/NA/NA

new 1000 gal tank

Authorized Agent: Bryan Davenport Signature: B Davenport

Owner Signature: DocuSigned by: Peggy Johnson 10DCCA20494D42B... POA Lila Peggy Collins Date: 6/5/20

Mecklenburg County Groundwater & Wastewater Services
3205 Freedom Dr. Suite 8000 Charlotte, NC 28208
Phone: (980) 314-1680 Fax: (704) 336-6894

Soil Report

NC DHHS
Division of Environmental Health
On-Site Wastewater Section

IMPROVEMENT PERMIT/CONSTRUCTION AUTHORIZATION for REPAIRING an ON-SITE WASTEWATER TREATMENT & DISPOSAL SYSTEM

File #: 163A Permit #: 11313 Tax Parcel #: 195-101-19

Property Owner: Peggy Collins

Job Location Address: 14024 Thompson Rd

City: Charlotte State: NC Zip Code: 28227

Improvement Permit Issuance Date: 6/18/20 **Construction Authorization Issuance Date:** _____

Permission is hereby given to **repair** an on-site wastewater treatment & and disposal system, with subsurface soil absorption and effluent discharge, as specified herein at the described location. This approval is granted based upon the application information submitted to our office. All work shall be completed on or before _____. The system shall meet all of the construction requirements of 15A NCAC 18A. 1900 which are in effect on the date of granting this approval. An **Operation Permit** must be obtained from the Mecklenburg County Health Department before any system can be covered up or placed into service. The issuance of this permit does not in any way guarantee that the system anticipated to be constructed will operate properly, or relieve any person now of hereafter owning, controlling or using such system from any liability resulting from the failure of the system to operate properly.

Permitted Design Flow: 360 GPD Site LTAR: .3 GPD/ft²

Liquid Capacity of Septic Tank: 1000 gallons Liquid Capacity of Dosing Tank: 1000 gallons

Drainfield Design ☐ N/A

Trench Depth: 36 inches

Trench Width: 3 feet

Line Spacing: 9 feet (O.C.)

Total line length: 300 feet

# of Lines: 3 @ 100 feet

Depth of Media: 12 inches (Type) #5 Red

Distribution Device: Pressure Man

Bed Design *(For Repair Installations ONLY.)* ☑ N/A

Bed Depth: _____ inches

Bed Width: _____ feet

Total line length: _____ feet

# of Lines: _____ @ _____ feet

Depth of Media: _____ inches (Type) _____

Distribution Device: _____

Water Supply Source

☐ Municipal ☑ Private Well ☐ Community Well

☐ Other _____


Minimum System Setbacks

Distance from Building Foundation: 14 feet

Distance from Property Line: 40 feet

Distance from Water Supply Source: 10± feet

SKETCH OF SYSTEM LAYOUT
(Proposed Layout)

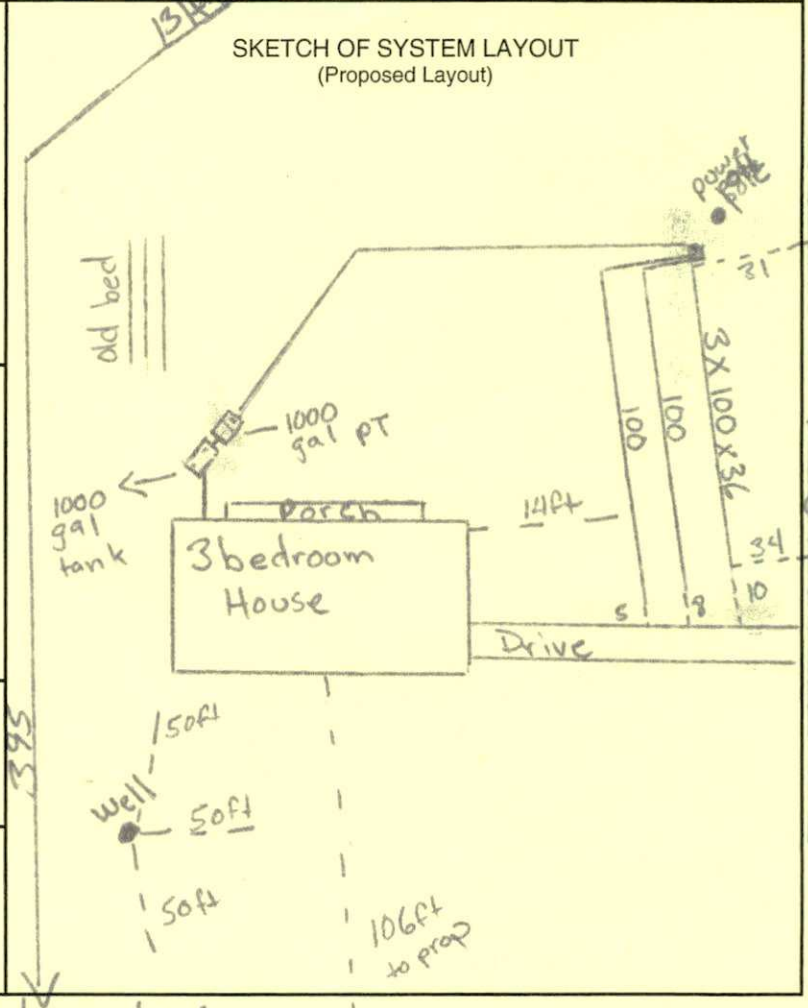

Comments: System Classification & Type: III bg / P / NA / NA

Authorized Agent: Bryan Davenport Signature: Bryan Davenport

Owner Signature: _____ Date: _____

DocuSign Envelope ID: F7CE7F45-2AB2-4539-B118-7C70E60061AE
Mecklenburg County Groundwater & Wastewater Services
3205 Freedom Dr. Suite 8000 Charlotte, NC 28208
Phone: (980) 314-1680 Fax: (704) 336-6894

NC DHHS
Division of Environmental Health
On-Site Wastewater Section

IMPROVEMENT PERMIT/CONSTRUCTION AUTHORIZATION for
REPAIRING an ON-SITE WASTEWATER TREATMENT & DISPOSAL SYSTEM

File #: 163A Permit #: 11313 Tax Parcel #: 195-101-19

Property Owner: Peggy Collins

Job Location Address: 14024 Thompson Rd

City: Charlotte State: NC Zip Code: 28227

Improvement Permit Issuance Date: 6/18/20 **Construction Authorization Issuance Date:** _____

Permission is hereby given to **repair** an on-site wastewater treatment & and disposal system, with subsurface soil absorption and effluent discharge, as specified herein at the described location. This approval is granted based upon the application information submitted to our office. All work shall be completed on or before _____. The system shall meet all of the construction requirements of 15A NCAC 18A. 1900 which are in effect on the date of granting this approval. An **Operation Permit** must be obtained from the Mecklenburg County Health Department before any system can be covered up or placed into service. The issuance of this permit does not in any way guarantee that the system anticipated to be constructed will operate properly, or relieve any person now of hereafter owning, controlling or using such system from any liability resulting from the failure of the system to operate properly.

Permitted Design Flow: 360 GPD Site LTAR: .3 GPD/ft²

Liquid Capacity of Septic Tank: 1000 gallons Liquid Capacity of Dosing Tank: 1000 gallons


Drainfield Design ☐ N/A
Trench Depth: 36 inches
Trench Width: 3 feet
Line Spacing: 9 feet (O.C.)
Total line length: 300 feet
# of Lines: 3 @ 100 feet
Depth of Media: 12 inches (Type) 25% Red
Distribution Device: Pressure Man

Bed Design *(For Repair Installations ONLY.)* ☑ N/A
Bed Depth: _____ inches
Bed Width: _____ feet
Total line length: _____ feet
# of Lines: _____ @ _____ feet
Depth of Media: _____ inches (Type) _____
Distribution Device: _____

Water Supply Source
☐ Municipal ☑ Private Well ☐ Community Well
☐ Other _____

Minimum System Setbacks
Distance from Building Foundation: 14 feet
Distance from Property Line: 40 feet
Distance from Water Supply Source: 10± feet

SKETCH OF SYSTEM LAYOUT
(Proposed Layout)

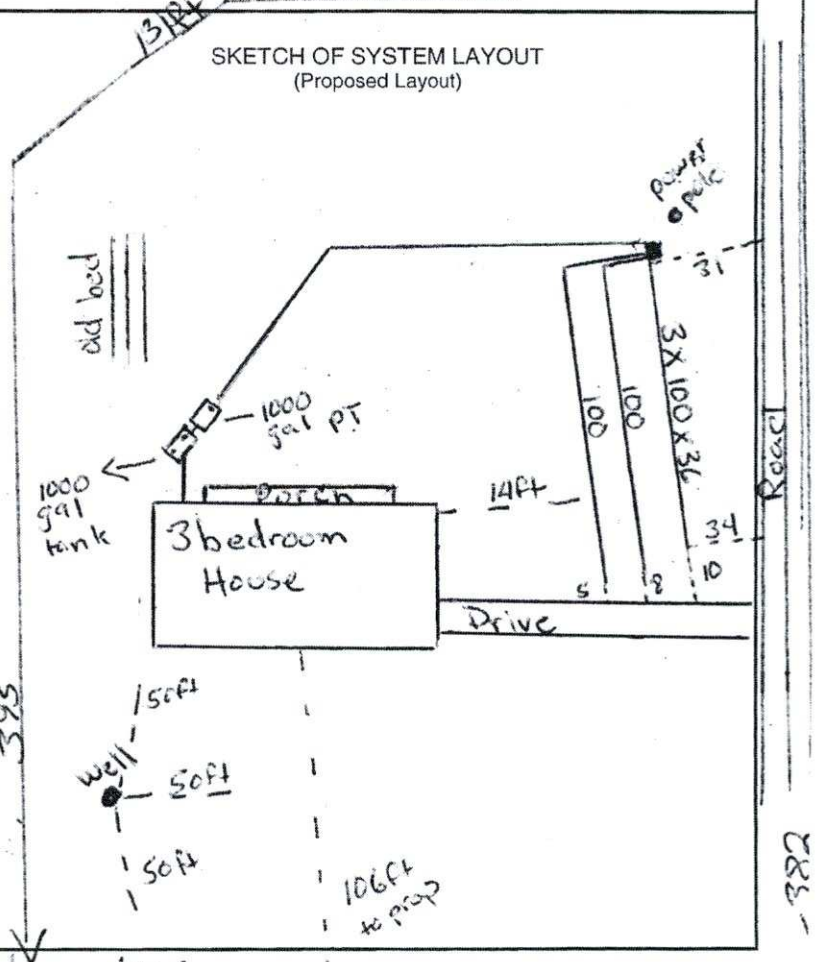

Comments: System Classification & Type: III bg /P/ NA /NA

Authorized Agent: Bryan Davenport Signature: Bryan Davenport

Owner Signature: DocuSigned by: Peggy Sue Johnson 10DCCA20494D42B... Poa Lila Collins Date: 6/18/2020

Mecklenburg County Groundwater & Wastewater Services
3205 Freedom Dr. Suite 8000 Charlotte, NC 28208
Phone: (980) 314-1680 Fax: (704) 336-6894

NC DHHS
Division of Environmental Health
On-Site Wastewater Section

IMPROVEMENT PERMIT/CONSTRUCTION AUTHORIZATION for REPAIRING an ON-SITE WASTEWATER TREATMENT & DISPOSAL SYSTEM

File #: 163A Permit #: 11313 Tax Parcel #: 195-101-19

Property Owner: Peggy Collins

Job Location Address: 14024 Thompson Rd

City: Charlotte State: NC Zip Code: 28227

Improvement Permit Issuance Date: 6/18/20 **Construction Authorization Issuance Date:** 6/18/20

Permission is hereby given to **repair** an on-site wastewater treatment & and disposal system, with subsurface soil absorption and effluent discharge, as specified herein at the described location. This approval is granted based upon the application information submitted to our office. All work shall be completed on or before _____. The system shall meet all of the construction requirements of 15A NCAC 18A. 1900 which are in effect on the date of granting this approval. An **Operation Permit** must be obtained from the Mecklenburg County Health Department before any system can be covered up or placed into service. The issuance of this permit does not in any way guarantee that the system anticipated to be constructed will operate properly, or relieve any person now of hereafter owning, controlling or using such system from any liability resulting from the failure of the system to operate properly.

Permitted Design Flow: 360 GPD Site LTAR: .3 GPD/ft²

Liquid Capacity of Septic Tank: 1000 gallons Liquid Capacity of Dosing Tank: 1000 gallons

Drainfield Design ☐ N/A

Trench Depth: 36 inches

Trench Width: 3 feet

Line Spacing: 9 feet (O.C.)

Total line length: 300 feet

# of Lines: 3 @ 100 feet

Depth of Media: 12 inches (Type) 25% Red

Distribution Device: Pressure Man

Bed Design *(For Repair Installations ONLY.)* ☑ N/A

Bed Depth: _____ inches

Bed Width: _____ feet

Total line length: _____ feet

# of Lines: _____ @ _____ feet

Depth of Media: _____ inches (Type) _____

Distribution Device: _____

Water Supply Source

☐ Municipal ☑ Private Well ☐ Community Well

☐ Other _____


Minimum System Setbacks

Distance from Building Foundation: 14 feet

Distance from Property Line: 40 feet

Distance from Water Supply Source: 10± feet

SKETCH OF SYSTEM LAYOUT
(Proposed Layout)

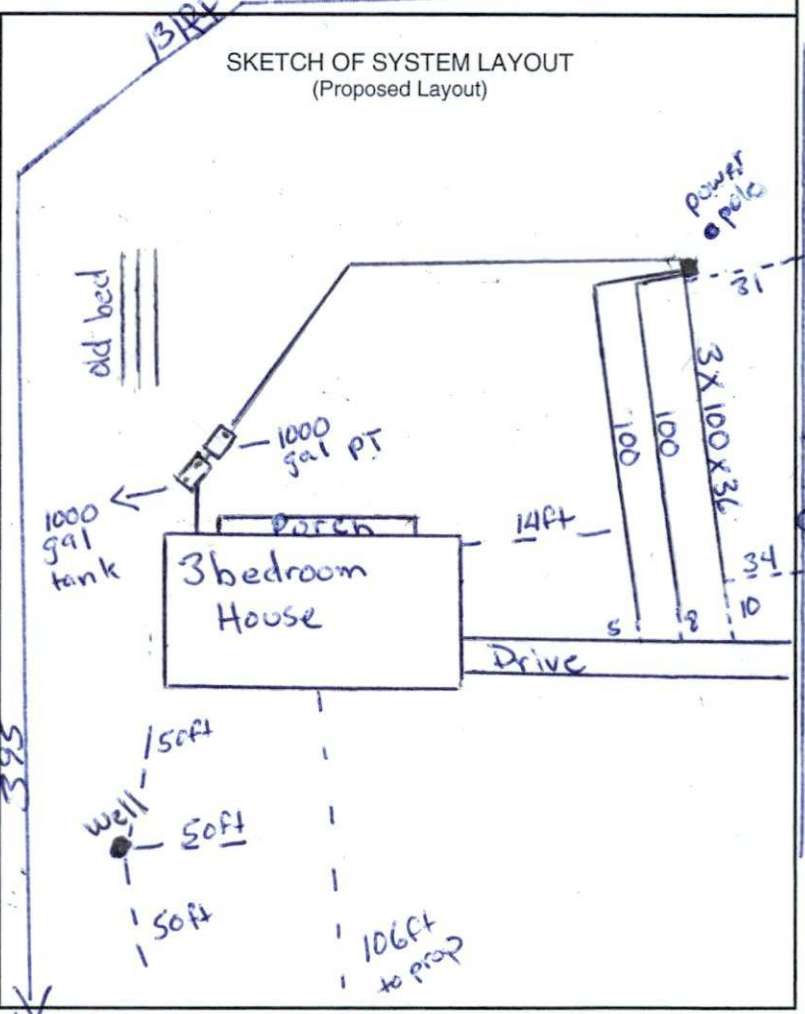

Comments: System Classification & Type: III bg / P / NA / NA

Authorized Agent: Bryan Davenport Signature: Bryan Davenport

Owner Signature: _____ Date: _____

Mecklenburg County Groundwater & Wastewater Services
3205 Freedom Dr. Suite 8000, Charlotte, NC 28208
Phone: (980) 314-1680 Fax: (704) 336-6894

NC DHHS
Division of Environmental Health
On-Site Wastewater Section

OPERATION PERMIT for an ON-SITE WASTEWATER TREATMENT & DISPOSAL SYSTEM

File #: 163A Permit #: 11313 Tax Parcel #: 195-101-19

Property Owner: Peggy Collins

Job Location Address: 14024 Thompson Rd

City: Charlotte State: NC Zip Code: 28227

Operation Permit Issuance Date: 8/13/20 Contractor Name: Jimmy Lowery

Permitted Design Flow: existing GPD Liquid Capacity of Dosing Tank: 1000 gallons

Liquid Capacity of Septic Tank: 1000 gallons Tank Manufacture infiltrator Effluent Pump Model: Liberty Pump 283 1/3 hp

Drainfield Installation ☐ N/A

Trench Depth: 36 inches

Trench Width: 3 feet

Line Spacing: 9 feet (O.C.)

Total line length: 300 feet

# of Lines: 3 @ 100 feet

Depth of Media: 12 inches (Type) 25% Rd Quick 4

Depth of Cover: 22 inches

Distribution Device: Pressure Man.

Bed Installation *(For Repair Installations ONLY.)* ☑ N/A

Bed Depth: _____ inches

Bed Width: _____ feet

Total line length: _____ feet

# of Lines: _____ @ _____ feet

Depth of Media: _____ inches (Type) _____

Depth of Cover: _____ inches

Distribution Device: _____

Water Supply Source

☑ Municipal ☐ Private Well ☐ Community Well

☐ Other _____

System Installation Setbacks

Distance from Building Foundation: 11 feet

Distance from Property Line: 32 feet

Distance from Water Supply Source: 10 feet


Inspection Dates

Tank(s) Inspected: 8/12/20

Excavation Inspected: 8/12/20

Pump & Controls Inspected: 8/12/20

SKETCH OF SYSTEM INSTALLATION
(As-Built Drawing)

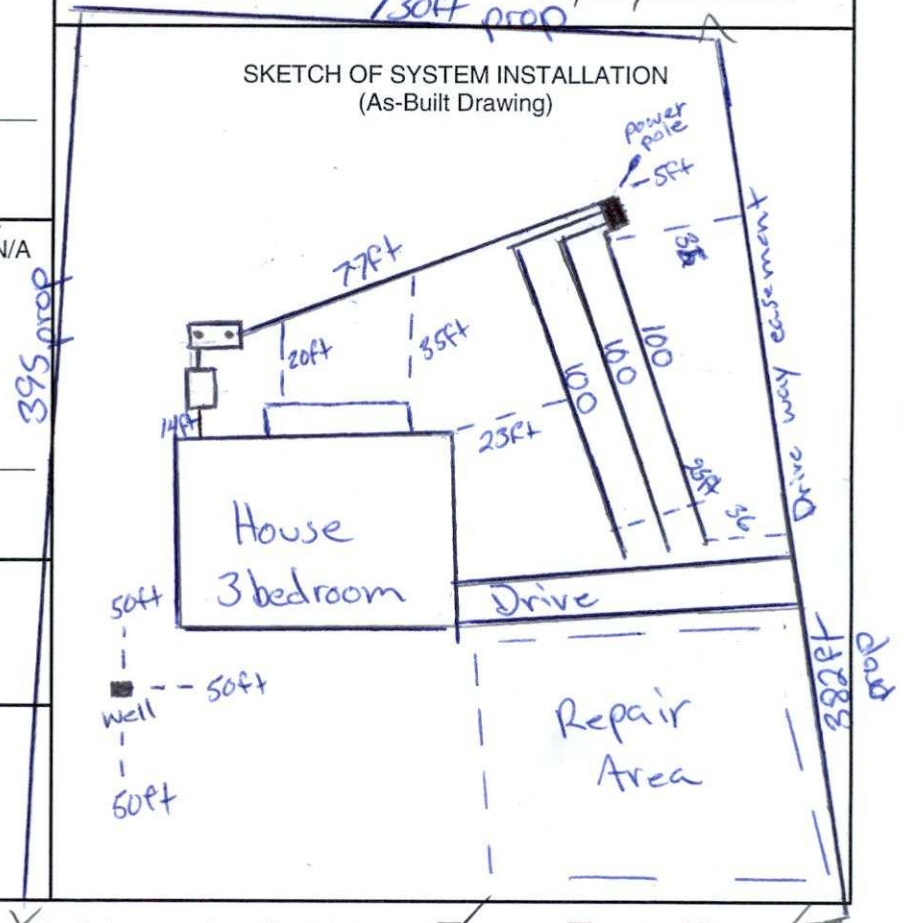

The undersigned has inspected the Septic Tank System described above, and certifies it has been ☑ installed ☐ altered ☐ repaired ☐ as detailed in the plot above ☑ in accordance with the permit issued and meets the provisions of 15A NCAC 18A. 1900, "Laws and Rules for Sewage Treatment and Disposal Systems" in effect on the date of issuance of the permit. The issuance of this Operation Permit does not in any way guarantee that the system will operate properly or relieve any person now or hereafter owning, controlling, or using such system from any liability resulting from the failure of the system to operate properly. This document is issued subject to those restrictions and conditions shown on the permit(s) and the provisions of 15A NCAC 18A. 1900 in addition to those listed below under "Comments." This document shall be null and void if any information contained in the application is untrue or if any additions are made to the property which would increase the requirements for said system.

Notice: Disturbance of the designated repair area may result in the Suspension or Revocation of this permit.

Comments: System Classification & Type: III bg / P / Na / Na

DENR Authorized Agent: Bryan Davenport Signature: Bryan Davenport

Mecklenburg County Groundwater & Wastewater Services
3205 Freedom Dr. Suite 8000, Charlotte, NC 28208
Phone: (980) 314-1680 Fax: (704) 336-6894

NC DHHS
Division of Environmental Health
On-Site Wastewater Section

OPERATION PERMIT for an
ON-SITE WASTEWATER TREATMENT & DISPOSAL SYSTEM

File #: 163A Permit #: 11313 Tax Parcel #: 195-101-19

Property Owner: _____

Job Location Address: 14024 Thompson Rd

City: Charlotte State: NC Zip Code: 28227

OPERATION PERMIT CONDITIONS:

I. Performance: System shall perform in accordance with 15A NCAC 18A .1961.

II. Monitoring: System shall be monitored as required by 15A NCAC 18A .1961.

III. Maintenance: Ground absorption sewage treatment and disposal systems shall be checked, and the contents of the septic tank removed, periodically from all compartments, to ensure proper operation of the system. The contents shall be pumped whenever the solids level is found to be more than 1/3 of the liquid depth in any compartment.

IV. Operation: System shall be operated in accordance with 15A NCAC 18A .1961.

System Classification: IIIbg

*Operation Permits for Type V and VI systems expire five (5) years from the date of issuance (in accordance with Table V(a)). The system owner must contact GWS six (6) months prior to expiration for permit renewal.

Subsurface system operator required: Yes ☐ No ☐

☐ This type of system requires the system owner to maintain a contract with a certified operator to perform system inspection, maintenance, and reporting as required in 15A NCAC 18A .1961. and Table V(a). The system owner is responsible for all fees associated with these services.

☐ System does not require inspection by GWS on a routine frequency.

☐ System requires inspection by GWS once every five (5) years. The system owner is responsible for all fees associated with the inspection.

☐ System requires inspection by GWS once every three (3) years. The system owner is responsible for all fees associated with the inspection.

☐ System requires inspection by GWS once every twelve (12) months. The system owner is responsible for all fees associated with the inspection.

☐ System requires inspection by GWS once every six (6) months. The system owner is responsible for all fees associated with the inspection.

V. Other:

_____

_____

_____

_____

DENR Authorized Agent: Bryan Davenport Date: 8/13/20

Signature: Bryan Davenport

C of A (s) No. 163-A

Date Issued 9-10-85 Serial 7860 T. C. No. 195-101-19 CRT

MECKLENBURG COUNTY
DEPARTMENT OF ENVIRONMENTAL HEALTH
CERTIFICATE OF COMPLETION
CERTIFICATE OF APPROVAL
(Individual Septic Tank System with Subsurface, Soil Absorption, Effluent Discharge)

Name of Owner Collins (LAST) Lila (FIRST) (MIDDLE)

Location of Property 14024 Thompson Rd.

Application Number — Permit Number —

Inspection Data:

Liquid Capacity of Tank 1500 Tank Material PVC

Total Length of Drain Tile 400' Number of Lines 4

Depth of Filter Material 12" Cover Depth 12"-18"

Water Supply Source well Distance from Water Source 750'

Excavation Inspected 9-10-85 (DATE) Tank Inspected 9-10-85 (DATE)

Nitrification Field Inspected 9-10-85 (DATE)

Washing Machine Line Inspected, If Applicable — (DATE)

The undersigned has inspected the Individual Septic Tank System with subsurface, soil absorption, effluent discharge as described above and it has been ✓ installed or constructed, _____ altered or repaired in accordance with the permit issued and the regulations of the Mecklenburg County Health Commission in effect on the date of issuance of the permit. The issuance of this Certificate of Approval does not in any way guarantee that the system will operate properly or relieve any person now or hereafter owning, controlling, or using such system from any liability resulting from the failure of the system to operate properly. This Certificate of Approval is issued subject to those restrictions and conditions shown on the permit(s) in addition to those listed below under comments. This Certificate of Approval shall be null and void if any information contained in the application is untrue or if any additions are made to the property which would increase the requirements for said system.

Comments: 1985, 1500ST, Con, 1200SFT, 12 G, Cecil

D. R. Ferguson
Environmentalist

EHD-5-74

Environmental Health Department's Copy

Date Issued 9-4-85

Serial No. 08450


ICAR (S) Permit No. 163-A

T. C. No. 195-101-19

Map Date 1

MECKLENBURG COUNTY
DEPARTMENT OF ENVIRONMENTAL HEALTH
INSTALLATION, CONSTUCTION, ALTERATION, AND/OR REPAIR PERMIT
(Individual Septic Tank System with Subsurface, Soil Absorption, Effluent Discharge)

Permission is hereby given to ✓ Install or Construct, ____ Alter or Repair the individual septic tank wastewater treatment system with subsurface, soil absorption, effluent discharge as specified herein at the described location. This permit is granted based upon the information supplied in application 163-A, dated 3-26-85 and this permit shall be void and of no effect if the information provided in the application is not true or is erroneous. All work shall be completed on or before 10-4-85, after which date this permit shall be null and void.

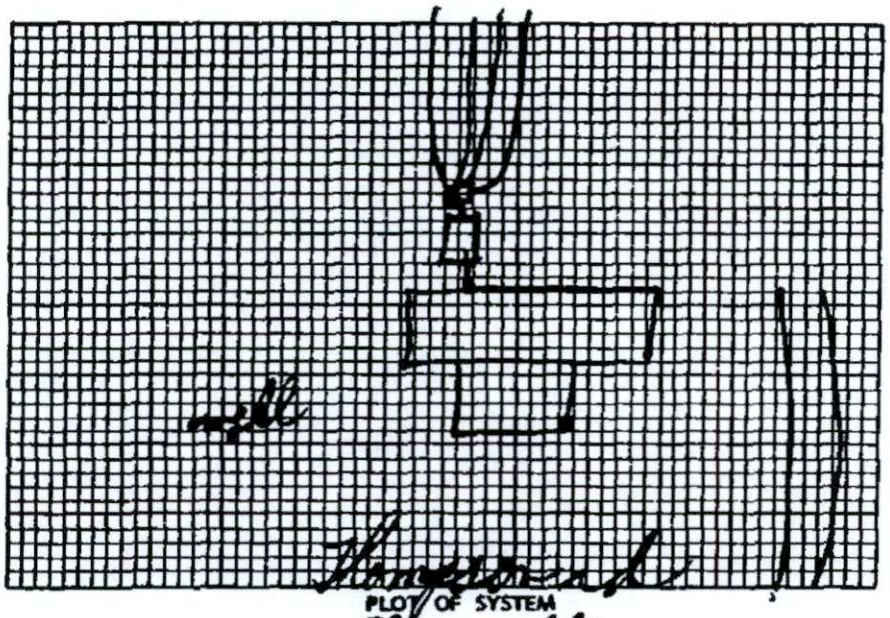

PLOT OF SYSTEM

Permeability Rate PR.

Liquid Capacity of Tank 1500

Tank Construction RCC

Absorption and/or Nitrification Lines:

Total Line Length 400'

Number of Lines 4

Distance from House 5'

Distance from Property Line 10'

Distance from Well 150

NAME OF OWNER Lila Collins

LOCATION OF PROPERTY 14024 Thompson Rd.

The system shall meet all of the construction requirements as set forth in the Regulations of the Mecklenburg County Health Commission which are in effect on the date of the granting of this permit. A certificate of approval must be issued by the Environmental Health Director before any system can be covered up or otherwise rendered uninspectable or can be used. The issuance of this permit does not in any way guarantee that the system anticipated to be constructed will operate properly, or relieve any person now or hereafter owning, controlling or using such system from any liability resulting from the failure of the system to operate properly.

4 lines 3'X100'X12" stone

Comments:

B. Sandifer
Division or Section Head

B. R. Ferguson
Environmentalist

* If this permit is for the installation or construction of a new system, it must be signed by the division or a section head of the Department of Environmental Health in order to be valid. Only the signature of the Environmentalist is required where an existing system is being altered or repaired.

EHD-S-76

Environmental Health Department's Copy

Date Issued 4-16-85

Serial No. 8394

SIR No. 163A

T. C. No. 195-101-19

Map Date Lot

MECKLENBURG COUNTY
DEPARTMENT OF ENVIRONMENTAL HEALTH

TO THE BUILDING INSPECTION DEPARTMENT

APPROVAL OF LOT FOR INSTALLATION OF AN INDIVIDUAL SEPTIC TANK WITH SUBSURFACE, SOIL ABSORPTION, EFFLUENT DISCHARGE

NAME OF OWNER Collins, (LAST) Lila (FIRST) P. (MIDDLE)

ADDRESS OF OWNER 7735 Newell-Hickory Grove Rd., Charlotte, NC ZIP 28215

LOCATION OF LOT 14024 Thompson Road (STREET OR COUNTY ROAD)

SUBDIVISION _____ LOT NO _____ BLOCK NO. _____

MAP BOOK NO. _____ PAGE NO. _____

The above specified lot is approved by the Mecklenburg County Department of Environmental Health for the installation of an individual septic tank system with subsurface, soil absorption, effluent discharge based on the soil investigation, on an on-site inspection of the said lot; and upon the information supplied in the "Application for an Installation, Construction, Alteration, and/or Repair Permit", number 163A. This approval is subject to the following terms and conditions:

1. That the nitrification field be installed, constructed, altered and/or repaired in the same area where the soil investigation was run.
2. That an "Installation, Construction, Alteration, and/or Repair Permit" be issued and in full force and effect when the system is installed, constructed, altered, and/or repaired and that the system be installed in accordance with same.

This approval may be revoked and the building inspection department requested to revoke any building permit(s) which have been issued to authorize construction on the said lot if at any time it is determined that any information contained in the "Application for an Installation, Construction, Alteration, and/or Repair Permit" is not correct or is untrue or that the septic-tank system is not being installed, constructed, altered and/or repaired in accordance with a valid Installation, Construction, Alteration, and/or Repair Permit.

Cynthia G. Bass
Environmentalist

Environmental Health Director, or Authorized Section Head

EHD-S-74

Environmental Health Department's Copy

Serial No. 6212

SIR No. 163A

Date Issued 4-16-85

T. C. No. 195-101-19

Map Date


MECKLENBURG COUNTY
DEPARTMENT OF ENVIRONMENTAL HEALTH
SOIL INVESTIGATION REPORT

NAME OF OWNER Collins, (LAST) Lila (FIRST) P. (MIDDLE)

ADDRESS OF OWNER 7735 Newell-Hickory Grove Rd., Charlotte, NC ZIP 28215

LOCATION OF PROPERTY Thompson Road (STREET OR COUNTY ROAD)

SUBDIVISION _____ LOT NO. _____ BLOCK NO. _____

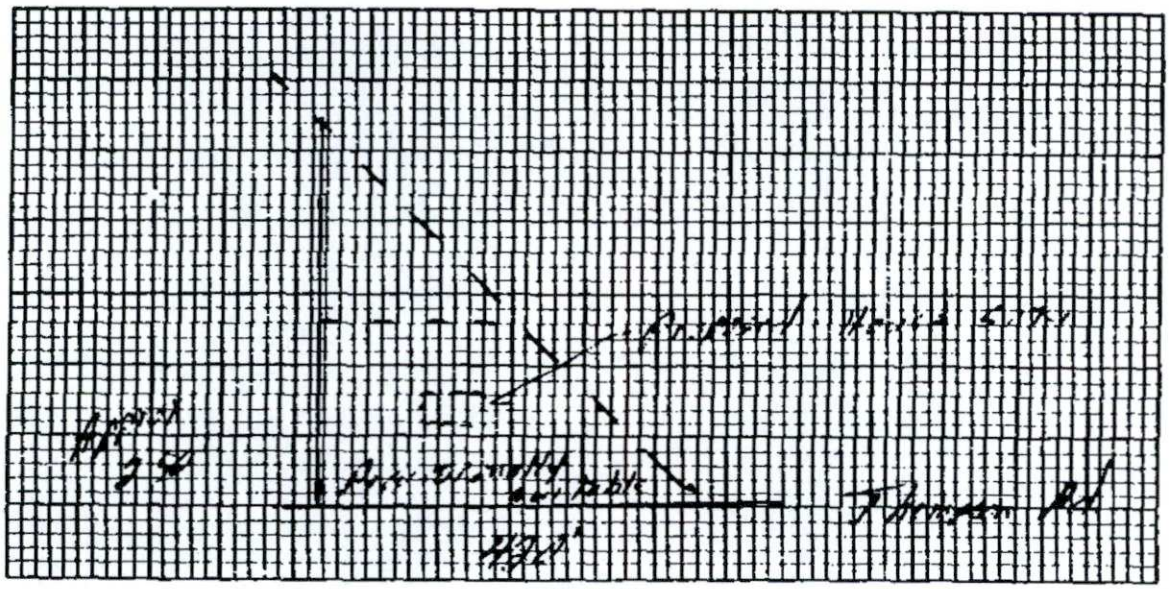

PLOT PLAN

This is to certify that a soil investigation and on-site investigation was made by the Mecklenburg County Department of Environmental Health on the lot described above. The said investigation was conducted on that portion of the lot as indicated on the above plot. The permeability rate determined by the investigation was PROVISIONALLY SUITABLE. The said lot is approved for the installation of an individual septic tank wastewater treatment system with subsurface, soil absorption effluent discharge subject to the following terms and conditions:

1. A permit to install, construct, alter, or repair the specific system shall be obtained from the Mecklenburg County Department of Environmental Health prior to the beginning of any construction of buildings, or of the wastewater treatment system on the said lot.
2. The size of the septic tank wastewater treatment system which must be installed will be determined by the Mecklenburg County Department of Environmental Health prior to installation based on the permeability rate obtained above, and on the size and type of building constructed thereon.
3. This approval is valid only if the system is installed in the immediate area indicated as acceptable for system installation on the above plot.
4. This approval is void if any grading, filling, or construction (including the drilling of a well) is performed on the lot which, in the opinion of the Mecklenburg County Department of Environmental Health, renders the area indicated as acceptable for system installation unsuitable for installation, construction alteration, and/or repair of such a system.

This approval is granted based on the laws of the State of North Carolina and the rules and regulations of the North Carolina Department of Human Resources, Division of Health Services and the Mecklenburg County Health Commission which were in effect on the date of issuance and is void if at any time in the future, prior to completion of the system, these laws, rules and regulations are changed such that this approval would not have been granted had the new or revised laws, rules, and regulations been in effect on the issue date.

William R. Mackey
Soil Scientist

J. R. Johnson
Environmental Health Director or Authorized Section Head

EHD-5-76

Environmental Health Department's Copy

DEPARTMENT OF ENVIRONMENTAL HEALTH
MECKLENBURG COUNTY, NORTH CAROLINA

SITE EVALUATION

S.I.R. NO. 163-A

T.C. NO. 195-101-19

(Ground Absorption Sewage Disposal)

OWNER: Lila Peggy Collins PLAT NO:
ADDRESS: 1735 Merrill Kirkpatrick Dr. LOT SIZE: Approx 1.5 Acres
Charlotte, N.C. 28215
LOCATION OF SITE: Thompson Road

FACTORS	AREA 1	AREA 2	AREA 3	AREA 4
1. SLOPE (%)	S PS U (2-10%)	S PS U	S PS U	S PS U
2. SOIL TEXTURE (12-36 inches) Sandy, Loamy, Clayey (Note 2-1 Clay)	S PS (clay) U	S PS U	S PS U	S PS U
3. SOIL STRUCTURE (12-36 inches)	S PS (Blocky) U	S PS U	S PS U	S PS U
4. SOIL DEPTH (inches)	S (PS) (>36") U	S PS U	S PS U	S PS U
5. RESTRICTIVE HORIZONS (Inches) (Impervious strata, Rock)	S (PS) (>36" to Saprolite) U	S PS U	S PS U	S PS U
6. SOIL DRAINAGE/GROUNDWATER (external and internal)	S (PS) (>36" to ground water) U	S PS U	S PS U	S PS U
7. OTHER (Specify)	S PS U	S PS U	S PS U	S PS U
8. SOIL GROUP	IVA			
9. SITE CLASSIFICATION	Provisionally Suitable			
10. SOIL SERIES	Cecil-Lloyd			


S - Suitable PS - Provisionally Suitable U - Unsuitable

**See Diagram on Back (includes: soil areas, property lines, roads, streams, gullies, wet areas, fill areas, wells, water bodies, slopes)

Recommendations/Comments:

Described by: William R. Markin
Title: Soil Scientist

Date: 4-15-85

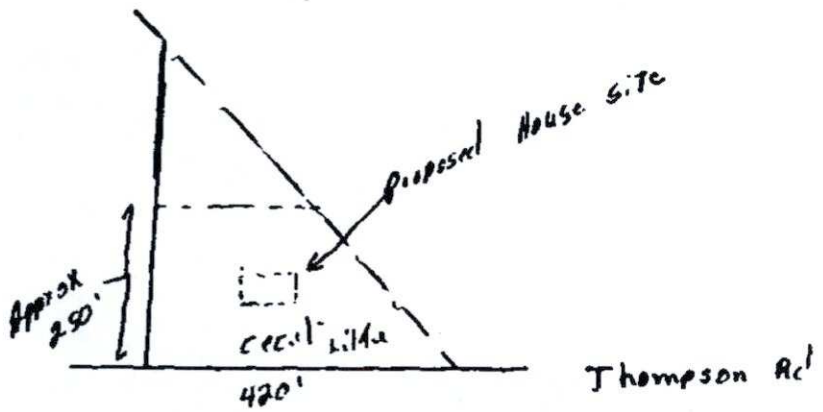
Proposed House Site
420'
Thompson Rd

Date Received 3-28-85

RECEIVED
MAR 28 1985
ENVIRONMENTAL HEALTH

SIR No. 163 A.
T. C. No. 195-101-19
Map Date L

MECKLENBURG COUNTY
DEPARTMENT OF ENVIRONMENTAL HEALTH

APPLICATION FOR SOIL INVESTIGATION

1) NAME OF OWNER Collins (LAST) Lisa (FIRST) Peggy (MIDDLE)

2) ADDRESS OF OWNER 7735 Newell Hickory Gr. Rd. Charlotte ZIP 28215

3) PHONE NO. Home 537-0973 Office _____


4) LOCATION OF PROPERTY Thompson Rd Rd # 3125 (STREET OR COUNTY ROAD)

5) SUBDIVISION _____ LOT NO. _____ BLOCK NO. _____

MAP BOOK NO. 195 PAGE NO. 10

6) DEED REFERENCE: DEED BOOK 4150 PAGE NO. 0539

Application is hereby made to the Mecklenburg County Department of Environmental Health for the conduct of a soil investigation and an on site inspection of the lot hereinabove described for the purpose of determining if the lot is suitable for the installation of an individual septic tank wastewater treatment system with subsurface, soil absorption, effluent discharge.

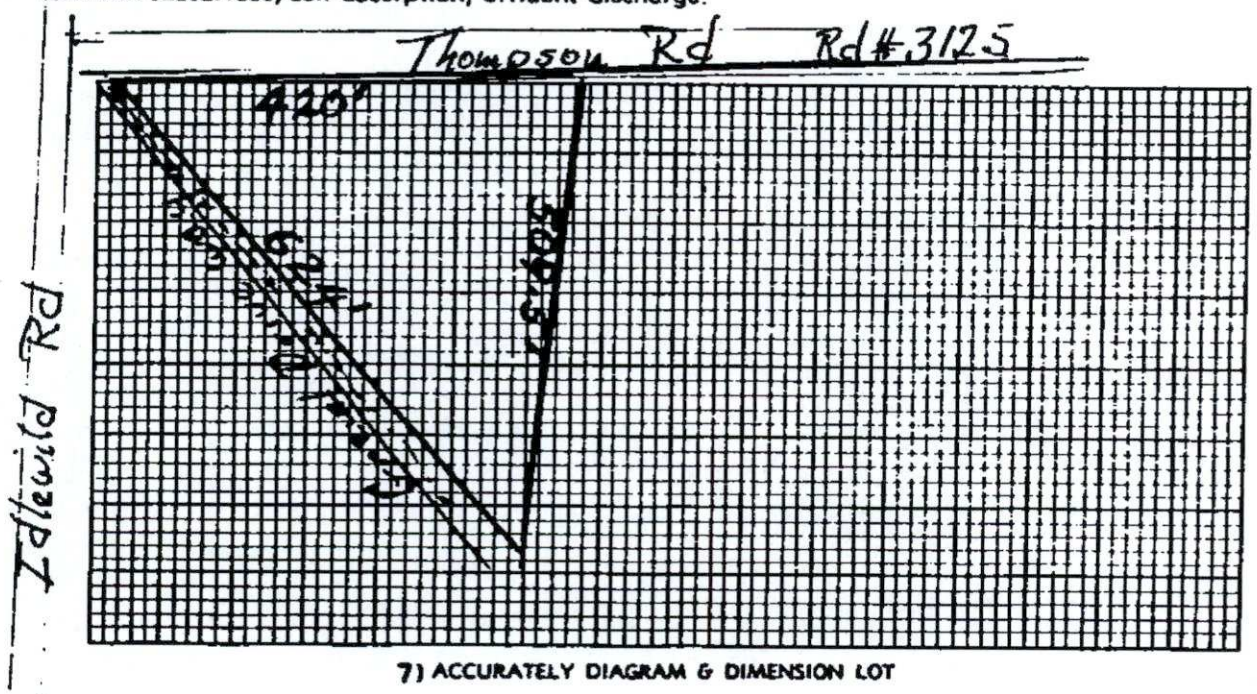

7) ACCURATELY DIAGRAM & DIMENSION LOT

Lisa Peggy Collins
OWNER Jakes & Collins

EHD-5-76

Environmental Health Department's Copy

Date Received 3-25-85 — RECEIVED — MAR 26 1985 — Environmental Health — SEE INSTRUCTIONS ON BACK

ICAR(S) Application No. 163 A

T. C. No. 195-101-19


Map Date L

MECKLENBURG COUNTY
DEPARTMENT OF ENVIRONMENTAL HEALTH

Application for an
Installation, Construction, Alteration, and/or Repair Permit
(Individual Septic Tank System with Subsurface, Soil Absorption, Effluent Discharge)

The owner of that property described hereinafter hereby applies to the Mecklenburg County Department of Environmental Health for a permit to:

1) ✓ Install or Construct 2) _____ Alter or Repair an individual septic tank wastewater treatment system with a subsurface, soil absorption, effluent discharge.

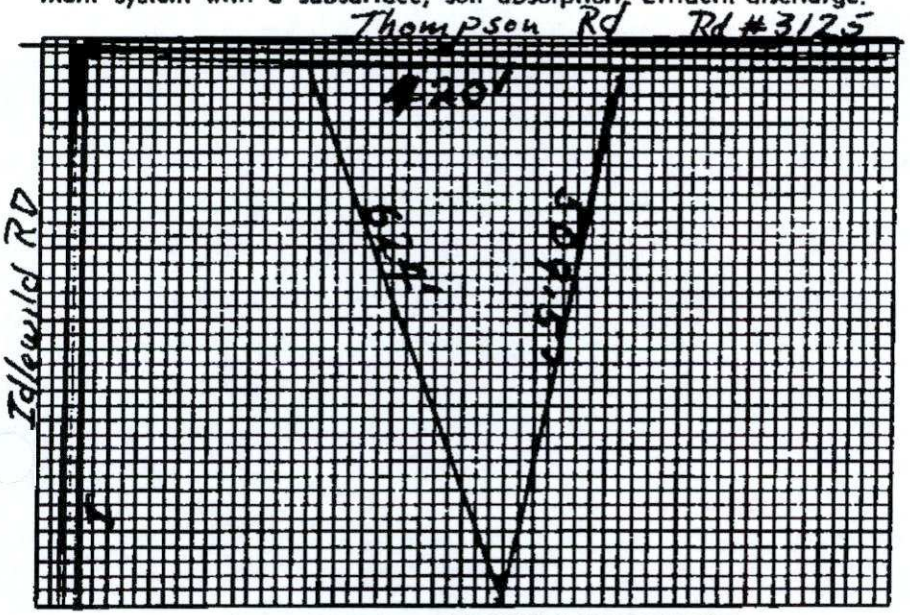

3) PLOT PLAN (ACCURATELY DIMENSIONED)

Mobile Home ____Yes ____No
Residence ✓Yes ____No
4) No. of Bedrooms 4 3 plus
5) Business Use — Max No Employees ____
6) Washing Machine ✓Yes ____No
7) Garbage Disposal ____Yes ____No
8) Dishwasher ✓Yes ____No
9) Water Supply:
A) Individual Well ✓
B) Governmental System ____
C) Community System:
1. Well source ____
2. Governmental source ____
10) Sewage System:
House located within 200 feet of public sewer ____Yes ____No
House located within 200 feet of community sewer ____Yes ____No
11) FHA Case No. ____
12) VA Case No. ____

13) NAME OF OWNER Collins (LAST) Lila (FIRST) Peggy (MIDDLE)

14) ADDRESS OF OWNER 7735 Nowell Hickory Grove Rd

15) PHONE NO. Home 537-0973 Office ____

16) LOCATION OF SYSTEM 14024 Thompson Rd Rd #3125 (STREET OR COUNTY ROAD)

17) SUBDIVISION ____ Lot No. ____ Block No. ____

Map Book No. 195 Page No. 10

18) DEED REFERENCE — DEED BOOK 4150 AT PAGE 0539

19) HAS A SOIL INVESTIGATION BEEN RUN? ____ YES ____ NO DATE RUN ____

20) PTR NUMBER (See Instructions) ____

The undersigned person hereby agrees that he has read the foregoing application and that the contents of same are true. It is understood that any permit applied for herein shall be void and of no effect if any of the above facts are not true.

March 26-85
DATE OF APPLICATION

Lila Peggy Gaffe Collins
OWNER James B. Collins

EHD-S-76

Environmental Health Department's Copy

Groundwater & Wastewater Services: Septic Project File & D

GWS File #:	136A
WASPS App #:	11313
Primary ES assigned to project:	Bryan Davenport
Secondary ES assigned to project:	
Project Type:	Repair
Site Evaluation Information: .1939(a)(1) - Topography and Landscape Position Recorded?	Yes
Site Evaluation Information: .1940(a-g) - Slope % Recorded?	Yes
Site Evaluation Information: .1939(a)(2) - Texture Class Recorded?	Yes
Site Evaluation Information: .1939(a)(2) - Structure Type Recorded?	Yes
Site Evaluation Information: .1939 (a)(2) - Consistence Recorded?	Yes
Site Evaluation Information: .1939(a)(2) - Mineralogy Recorded?	Yes
Site Evaluation Information: .1939(a)(3) - Soil Wetness Condition Recorded?	Yes
Site Evaluation Information: .1939(a)(4) - Soil Depth to Rock or Parent Material Recorded when Encountered?	Yes
Site Evaluation Information: .1939(a)(5) - Depth to Restrictive Horizons Recorded when Encountered?	Yes
Site Evaluation Information: .1939(a)(6) - Sufficient Available Space Recorded?	Yes
Site Evaluation Information: .1937(m) - Are the Profile Locations Shown?	Yes
Site Evaluation Information: .1939(a) - Are the S/PS Profiles in system & in repair area?	Yes
Site Evaluation Information: .1939(d), .1955, .1956, .1957 - LTAR	Yes
Improvement Permit/Construction Authorization: .1937(g), 130A-336(a) - Proposed System Type stated - Initial	N/A
Improvement Permit/Construction Authorization: .1945(b) - Proposed System Type stated - Repair	Yes
Improvement Permit/Construction Authorization: 130A-336(a)(3) - System location identifiable by setbacks - Initial	N/A
Improvement Permit/Construction Authorization: .1937(g), .1945(b) - System components shown - Initial	N/A
Information Permit/Construction Authorization: .1945(b) - Repair area shown	Yes
Improvement Permit/Construction Authorization: .1937(f)(g) - Does System design match facility, flow & WW characteristics?	Yes
Improvement Permit/Construction Authorization: .1937(f)(g) - Is System design consistent with soil/site conditions?	Yes
Improvement Permit/Construction Authorization: .1937(f)(g) - Is the System located in the approved area?	Yes
Improvement Permit/Construction Authorization: 130A-336(a) - Number of Bedrooms, employees, seats, etc. indicated?	Yes
Improvement Permit/Construction Authorization: .1937 (g) - Trench depth correct?	Yes
Improvement Permit/Construction Authorization: .1937(g) - Trench width correct?	Yes
Improvement Permit/Construction Authorization: .19379(g) - Trench length correct?	Yes
Improvement Permit/Construction Authorization: 130A-336(a)(1) - Proposed/existing well shown?	Yes

Repair
Septic file Complete

Improvement Permit/Construction Authorization: 130A-336(a)(1) - Property line lengths shown?	Yes
Improvement Permit/Construction Authorization: 130A-336(a) - Facility/appurtenance setbacks shown from fixed points?	Yes
Corrections/modifications needed?	No
Comments:	2020 Repair
IA issued date:	8/12/2020
OP Issued date:	8/13/2020
Review performed by:	Jeremy Michelone
Date performed:	8/13/2020

Created at 8/13/2020 3:31 PM by Michelone, Jeremy
Last modified at 8/13/2020 3:31 PM by Michelone, Jeremy

Close