Mecklenburg County Groundwater & Wastewater Services
700 N. Tryon St., Suite 211 Charlotte, NC 28202
Phone: (704) 336-5103 Fax: (704) 336-6894

NC DENR
Division of Environmental Health
On-Site Wastewater Section

OPERATION PERMIT for an ON-SITE WASTEWATER TREATMENT & DISPOSAL SYSTEM

File #: B432B Permit #: _____ Tax Parcel #: 19320207

Property Owner: Larry Fisher

Job Location Address: 9032 Boyd Dr.

City: Charlotte State: NC Zip Code: 28105

Operation Permit Issuance Date: 5-4-2012 Contractor Name: Stanley Septic

Permitted Design Flow: 240 GPD

Liquid Capacity of Septic Tank: 1500 gallons

Liquid Capacity of Dosing Tank: N/A gallons

Effluent Pump Model: N/A

Drainfield Installation ☐ N/A

Trench Depth: 36 inches

Trench Width: 3 feet

Line Spacing: 9 feet (O.C.)

Total line length: 210 feet

# of Lines: 3 @ 70 feet

Depth of Media: 12 inches (Type) Quick 4 Chambers

Depth of Cover: 24 inches

Distribution Device: D-BOX

Bed Installation *(For Repair Installations ONLY.)* ☒ N/A

Bed Depth: _____ inches

Bed Width: _____ feet

Total line length: _____ feet

# of Lines: _____ @ _____ feet

Depth of Media: _____ inches (Type) _____

Depth of Cover: _____ inches

Distribution Device: _____

Water Supply Source

☐ Municipal ☒ Private Well ☐ Community Well

☐ Other _____

System Installation Setbacks

Distance from Building Foundation: 13 feet

Distance from Property Line: 10 feet

Distance from Water Supply Source: 50'+ feet


Inspection Dates

Tank(s) Inspected: 5-4-2012

Excavation Inspected: 5-4-2012

Pump & Controls Inspected: N/A

SKETCH OF SYSTEM INSTALLATION
(As-Built Drawing)

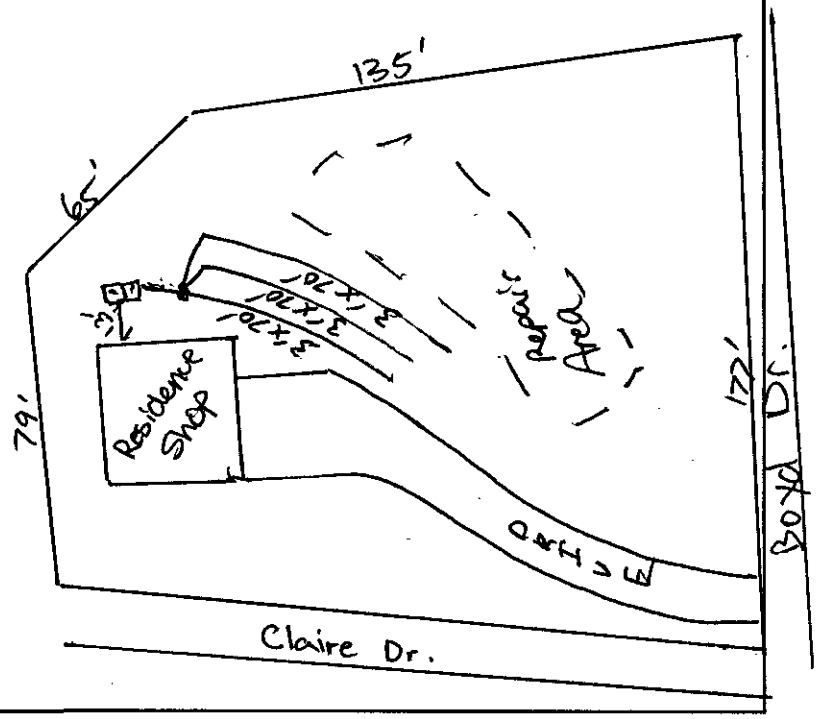

The undersigned has inspected the Septic Tank System described above, and certifies it has been ☒ installed ☐ altered ☐ repaired ☒ as detailed in the plot above ☐ in accordance with the permit issued and meets the provisions of 15A NCAC 18A. 1900, "Laws and Rules for Sewage Treatment and Disposal Systems" in effect on the date of issuance of the permit. The issuance of this Operation Permit does not in any way guarantee that the system will operate properly or relieve any person now or hereafter owning, controlling, or using such system from any liability resulting from the failure of the system to operate properly. This document is issued subject to those restrictions and conditions shown on the permit(s) and the provisions of 15A NCAC 18A. 1900 in addition to those listed below under "Comments." This document shall be null and void if any information contained in the application is untrue or if any additions are made to the property which would increase the requirements for said system.

Notice: Disturbance of the designated repair area may result in the Suspension or Revocation of this permit.

Comments: System Classification & Type: III g I&A, G, NA, NA

DENR Authorized Agent: Jeremy Michael Signature: Jeremy Michael REHS.

Mecklenburg County Groundwater & Wastewater Services
700 N. Tryon St., Suite 211 Charlotte, NC 28202
Phone: (704) 336-5103 Fax: (704) 336-6894

NC DENR
Division of Environmental Health
On-Site Wastewater Section

OPERATION PERMIT for an
ON-SITE WASTEWATER TREATMENT & DISPOSAL SYSTEM

File #: 8432B Permit #: _____ Tax Parcel #: 193-202-07

Property Owner: Larry Fisher

Job Location Address: 9032 Boyd Dr.

City: Charlotte State: NC Zip Code: 28105

OPERATION PERMIT CONDITIONS:

I. Performance: System shall perform in accordance with 15A NCAC 18A .1961.

II. Monitoring: System shall be monitored as required by 15A NCAC 18A .1961.

III. Maintenance: Ground absorption sewage treatment and disposal systems shall be checked, and the contents of the septic tank removed, periodically from all compartments, to ensure proper operation of the system. The contents shall be pumped whenever the solids level is found to be more than 1/3 of the liquid depth in any compartment.

IV. Operation: System shall be operated in accordance with 15A NCAC 18A .1961.

System Classification: IIIg

*Operation Permits for Type V and VI systems expire five (5) years from the date of issuance (in accordance with Table V(a)). The system owner must contact GWS six (6) months prior to expiration for permit renewal.

Subsurface system operator required: Yes ☐ No ☑

☐ This type of system requires the system owner to maintain a contract with a certified operator to perform system inspection, maintenance, and reporting as required in 15A NCAC 18A .1961. and Table V(a). The system owner is responsible for all fees associated with these services.

☑ System does not require inspection by GWS on a routine frequency.

☐ System requires inspection by GWS once every five (5) years. The system owner is responsible for all fees associated with the inspection.

☐ System requires inspection by GWS once every three (3) years. The system owner is responsible for all fees associated with the inspection.

☐ System requires inspection by GWS once every twelve (12) months. The system owner is responsible for all fees associated with the inspection.

☐ System requires inspection by GWS once every six (6) months. The system owner is responsible for all fees associated with the inspection.

V. Other:

_____

_____

_____

_____

DENR Authorized Agent: Jeremy Michael Date: 05/04/2012

Signature: Jeremy Michael REHS

Mecklenburg County Groundwater & Wastewater Services
700 N. Tryon St., Suite 211 Charlotte, NC 28202
Phone: (704) 336-5103 Fax: (704) 336-6894

NC DENR
Division of Environmental Health
On-Site Wastewater Section

INSTALLATION APPROVAL for an
ON-SITE WASTEWATER TREATMENT & DISPOSAL SYSTEM

File #: 8432B Permit #: _____ Tax Parcel #: 193-202-07

Property Owner: Larry Fisher

Job Location Address: 9032 Boyd Dr.

City: Charlotte State: NC Zip Code: _____

Installation Approval Issuance Date: 05/04/2012

Permission is hereby given to ☒ install ☐ alter ☐ repair an on-site wastewater treatment & and disposal system, with subsurface soil absorption and effluent discharge, as specified herein at the described location. This approval is granted based upon the application information submitted to our office. All work shall be completed on or before _____, after which date this approval shall be null and void. The system shall meet all of the construction requirements of 15A NCAC 18A. 1900 which are in effect on the date of granting this approval. An **Operation Permit** must be obtained from the Mecklenburg County Health Department before any system can be covered up or placed into service. The issuance of this permit does not in any way guarantee that the system anticipated to be constructed will operate properly, or relieve any person now of hereafter owning, controlling or using such system from any liability resulting from the failure of the system to operate properly.

***NOTICE: This system shall not be installed while soils are in a wet condition.**

Permitted Design Flow: 240 GPD

Site LTAR: 0.3 GPD/ft² (For new installations only.)

Liquid Capacity of Septic Tank: 1500 gallons

Liquid Capacity of Dosing Tank: N/A gallons

Drainfield Design ☐ N/A

Trench Depth: 36 inches

Trench Width: 3 feet

Line Spacing: 9 feet (O.C.)

Total line length: 210 feet

# of Lines: 3 @ 70 feet

Depth of Media: 36 inches (Type) _____

Distribution Device: D-Box

Bed Design *(For Repair Installations ONLY.)* ☒ N/A

Bed Depth: _____ inches

Bed Width: _____ feet

Total line length: _____ feet

# of Lines: _____ @ _____ feet

Depth of Media: _____ inches (Type) _____

Distribution Device: _____

Water Supply Source

☐ Municipal ☒ Private Well ☐ Community Well

☐ Other _____

Minimum System Setbacks

Distance from Building Foundation: 5 feet

Distance from Property Line: 10 feet

Distance from Water Supply Source: 50'+ feet

SKETCH OF SYSTEM LAYOUT
(Proposed Layout)

Install per plot plan on file.

Comments: System Classification & Type: III g

DENR Authorized Agent: Jeremy Michael Signature: Jeremy Michael R.E.H.S.

Mecklenburg County Groundwater & Wastewater Services
700 N. Tryon St, Suite 211 Charlotte, NC 28202
Phone: (704) 336-5103 Fax: (704) 336-6894

NC DENR
Division of Environmental Health
On-Site Wastewater Section

IMPROVEMENT PERMIT for a RESIDENTIAL ON-SITE WASTEWATER TREATMENT & DISPOSAL SYSTEM

Permit #: **30005419** GWS File #: **8432B** Tax Parcel #: **193-202-07**

- *This IMPROVEMENT PERMIT is subject to revocation if site plans or the intended use change. There is to be* **NO** grading, filling, or disturbance of the soil in the area of the septic tank system or repair area.
- CONSTRUCTION AUTHORIZATION must be obtained prior to receiving a Building Permit. The Construction Authorization is **NOT** transferable. Do not clear, grade, fill or disturb soil prior to obtaining a Construction Authorization.
- Domestic-type wastewater only. No industrial process wastewater may be discharged into the system.

I. This Improvement Permit Shall: Expire in Five (5) Years **Expiration Date (If Applicable):** 2/2/2017

Type of Installation: Residential - New System Lot Number: 0

Structure Type: HOUSE Size (ft^2): 800 # Bedrooms: 1 # Occupants: 1

Building Foundation: Concrete Slab Water Supply: Municipal

II. Initial System Type: Approved **System Classification:** IIIg

Initial System Specifications:

Design Flow (gpd):	240	LTAR (gpd/ft^2):	0.3	Septic Tank Size (gal):	1500	Pump Tank Size (gal):	N/A
Trench Width (ft):	3	Trench Spacing (ft):	9	Absorption Area (ft^2):	600	Total Trench Length (ft):	200
Maximum Trench Depth (in):	36	Depth of Media (in):	12	Distribution Device:	Distribution Box		

III. Repair System Type: Approved **System Classification:** IIIg

Repair System Specifications:

Design Flow (gpd):	240	LTAR (gpd/ft^2):	0.3	Septic Tank Size (gal):	1500	Pump Tank Size (gal):	N/A
Trench Width (ft):	3	Trench Spacing (ft):	9	Absorption Area (ft^2):	600	Total Trench Length (ft):	200
Maximum Trench Depth (in):	36	Depth of Media (in):	12	Distribution Device:	Distribution Box		

IV. Permit Conditions/Comments:

(Please See the Following Page for Permit Conditions.)

The undersigned, an authorized agent of the MECKLENBURG COUNTY HEALTH DEPARTMENT, certifies that the Department is issuing an IMPROVEMENT PERMIT for the above referenced property. This permit is being issued in accordance with the *Laws and Rules For Sewage Treatment, and Disposal Systems* and is subject to the following provisions:

- No work shall be conducted on the septic system until an INSTALLATION APPROVAL is granted by the Department.
- The septic system installer shall be a registered septic contractor with Mecklenburg County Health Department.
- The permitted system shall be installed in accordance with the included PLOT PLAN.
- This IMPROVEMENT PERMIT is transferable.

DENR Authorized Agent: Jeremy Michael Owner/Legal Agent: _____
Print Name

Signature: Jeremy Michael REHS Signature: _____

Date Issued: 2/2/2012

Mecklenburg County Groundwater & Wastewater Services
700 N. Tryon St, Suite 211 Charlotte, NC 28202
Phone: (704) 336-5103 Fax: (704) 336-6894

NC DENR
Division of Environmental Health
On-Site Wastewater Section

IMPROVEMENT PERMIT for a RESIDENTIAL ON-SITE WASTEWATER TREATMENT & DISPOSAL SYSTEM

Permit #: **30005419** GWS File #: **8432B**

IV. Permit Conditions/Comments:

- All components of the septic system must be installed in accordance with the required setbacks listed on the corresponding plot plan.
- All components of the septic system must be located at least 100 ft. (50 ft. minimum) from all private wells.
- All waterlines must be located a minimum of 10 ft. from any part of the septic system.
- Flow from all gutters and downspouts shall be directed not to discharge water onto or across any part of the septic system.
- Foundation drains shall be constructed not to discharge water onto or across any part of the septic system.

The undersigned, an authorized agent of the MECKLENBURG COUNTY HEALTH DEPARTMENT, certifies that the Department is issuing an IMPROVEMENT PERMIT for the above referenced property. This permit is being issued in accordance with the *Laws and Rules For Sewage Treatment and Disposal Systems* and is subject to the following provisions:

- No work shall be conducted on the septic system until an INSTALLATION APPROVAL is granted by the Department.
- The septic system installer shall be a registered septic contractor with Mecklenburg County Health Department.
- The permitted system shall be installed in accordance with the included PLOT PLAN.
- This IMPROVEMENT PERMIT is transferable.

DENR Authorized Agent: Jeremy Michael


Signature: Jeremy Michael REHS

Date Issued: 2/2/2012

Owner/Legal Agent: _____
Print Name

Signature: _____

SOIL EVALUATION LOCATIONS FOR
9032 Boyd Dr. Matthews NC 28105
WAPSPS APPLICATION # 5378

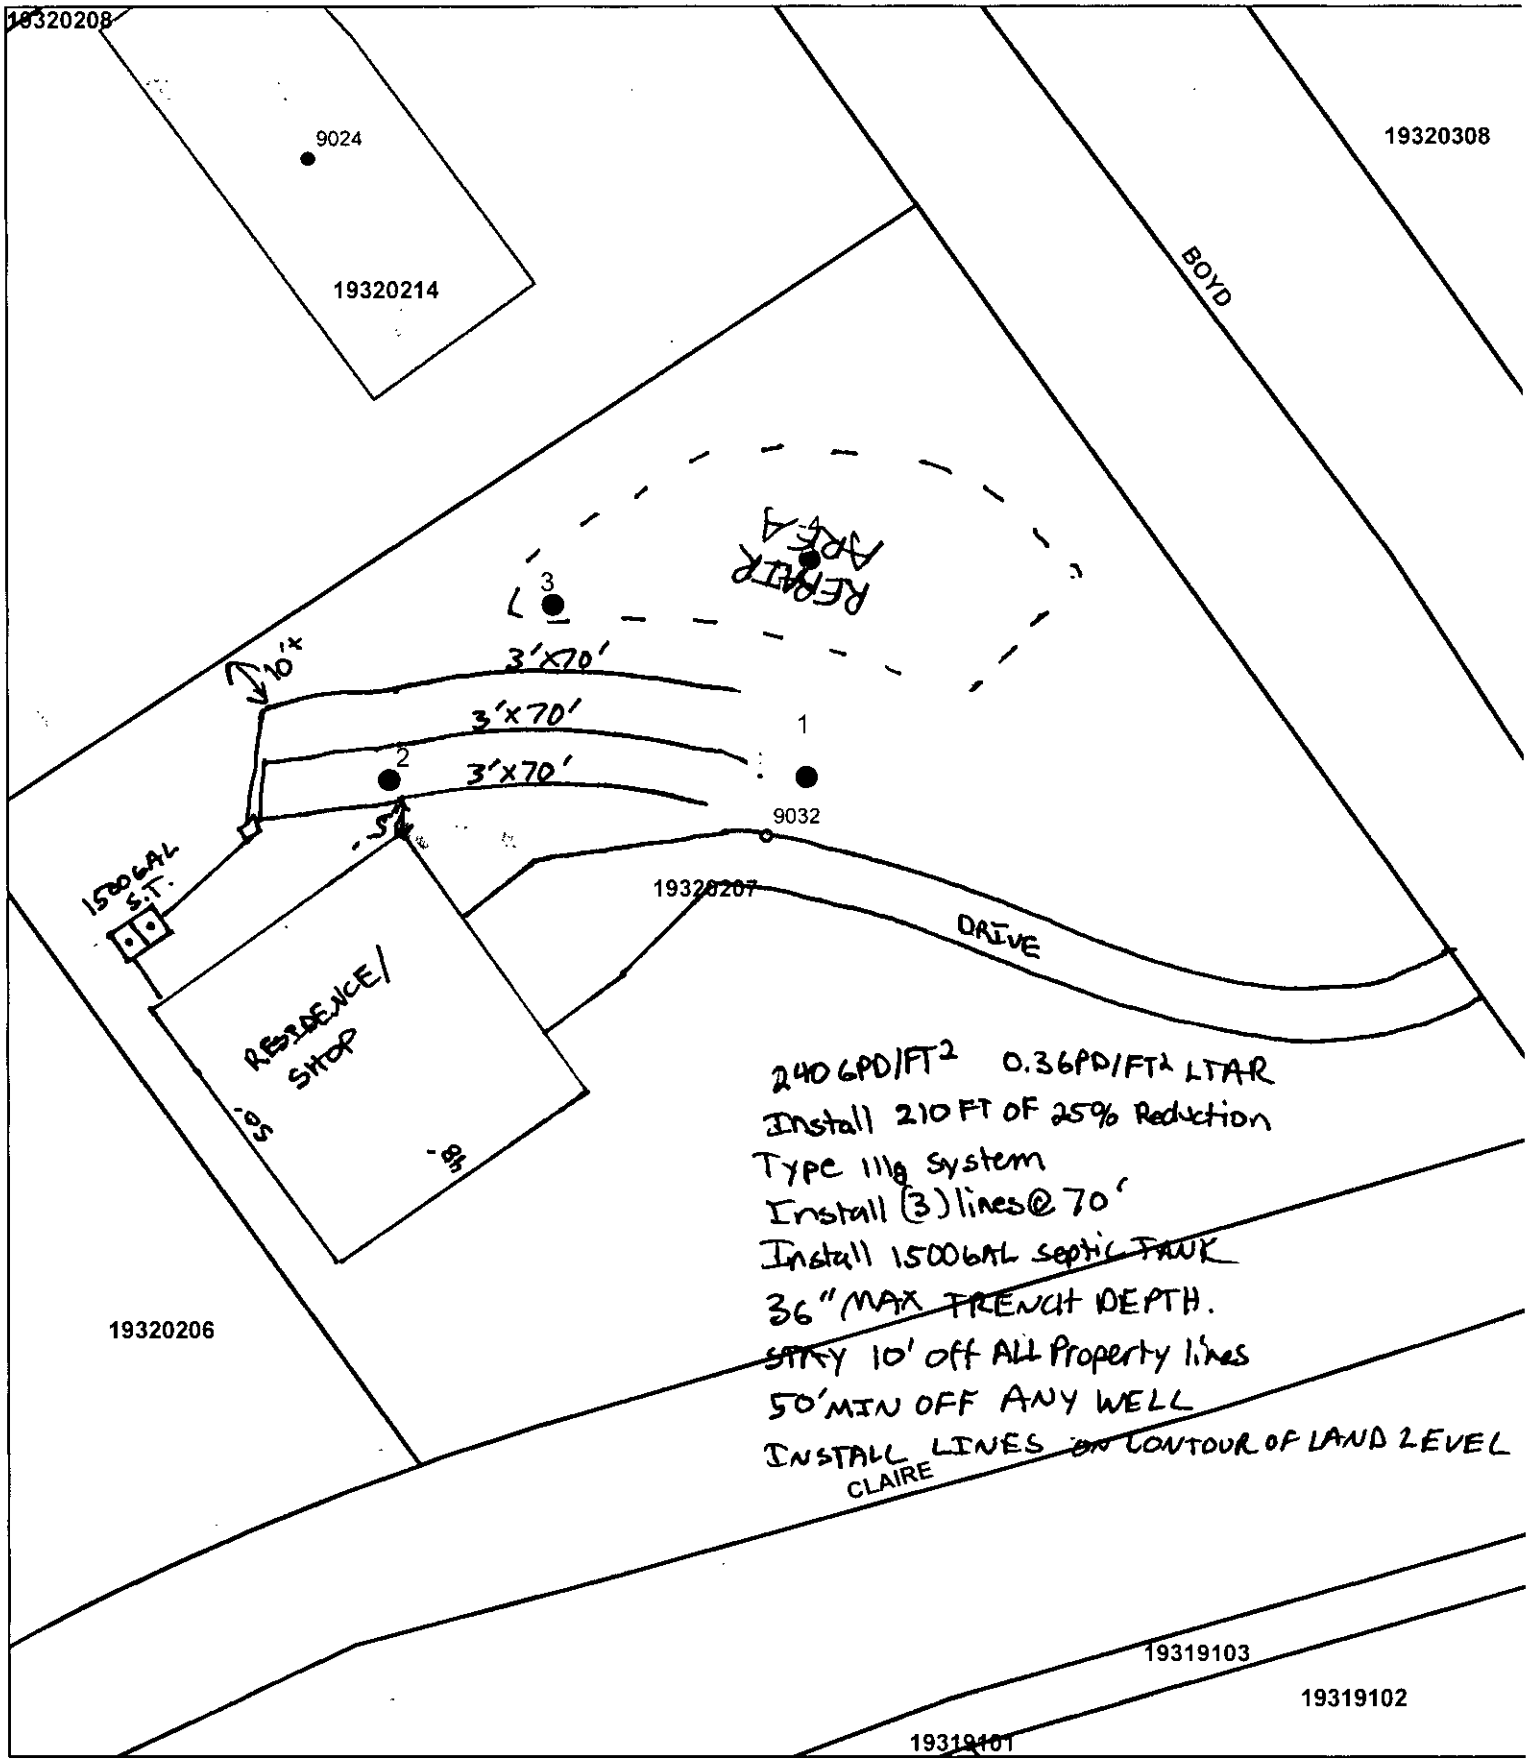

Map Created By: J. Michael
Map Created On: 02/01/2012
Jeremy Michael REHS

0 12.5 25 50 Feet
SCALE 1" = 30'

Department of Environment, Health, and Natural Resources
Division of Environmental Health
On-site Wastewater Section

Sheet: 1 OF 1
Property ID: 193-202-07
Lot #: 36+45
File #: 8432B
AppID: 5419

SOIL/SITE EVALUATION
for ON-SITE WASTEWATER SYSTEM

Owner: Larry Fisher
Applicant: Larry Fisher
Address: 9033 Scenic Drive Matthews NC 28105
Date Evaluated: 2/1/2012
Proposed Facility: Residence
Design Flow (.1949): 240 GPD
Property Size: 1
Location of Site: 9032 Boyd Dr. Matthews NC 28105
Property Recorded:
Water Supply: [X] Public [] Individual [] Well [ ] Spring [ ] Other
Evaluation Method: [X] Auger Boring [ ] Pit [ ] Cut
Type of Wastewater: [X] Sewage [ ] Industrial Process [ ] Mixed

PROFILE #	1940 Landscape Position/ Slope%	Horizon Depth (IN.)	SOIL MORPHOLOGY 1941 1941 Structure/ Texture	1941 Consistence Mineralogy	b PROFILE FACTORS 1942 Soil Wetness/ Color	1943 Soil Depth (IN.)	1956 Sapro Class	1944 Restr Horiz	Profile Class & LTAR
1	LS 4-5%	0-48	SBK/C	S/P/FI/SEXP		48"			PS, IV 0.3 GPD/FT^2
2	LS 4-5%	0-36 36-48	SBK/C ABK/C	S/P/FI/SEXP S/P/FI/SEXP		48"			PS, IV 0.3 GPD/FT^2
3	LS 4-5%	0-48	SBK/C	S/P/FI/SEXP		48"			PS, IV 0.3 GPD/FT^2
4	LS 4-5%	0-48	SBK/C	S/P/FI/SEXP		48"			PS, IV 0.3 GPD/FT^2

Description	Initial System	Repair System
Available Space (.1945)	PS	PS
System Type(s)	IIIg	IIIg
Site LTAR	0.3	0.3

Other Factors (.1946):
Soil Evaluation By: Jeremy Michael
Others Present: Jeremy Michael REHS
Site Classification (.1948): PS
Site Evaluation By: Jeremy Michael
Others Present:

COMMENTS:

Landscape Position	Group	Texture	.1955 LTAR	Structure
R-Ridge	I	S-Sand	1.2 - 0.8	SG-Single Grain
SS-Shoulder Slope		LS-Loamy Sand		M-Massive
LS-Linear Slope				CR-Crumb
FS-Foot Slope	II	SL-Sandy Loam	0.8 - 0.6	GR-Granular
NS-Nose Slope		L-Loam		SBK-Subangular Blocky
HS-Head Slope				ABK-Angular Blocky
CC-Concave Slope	III	SI-Silt	0.6 - 0.3	PL-Platy
CV-Convex Slope		SICL-Silty Clay Loam		PR-Prismatic
T-Terrace				
FP-Flood Plain		CL-Clay Loam		
		SCL-Sandy Clay Loam		
	IV	SC-Sandy Clay	0.4 - 0.1	
		SIC-Silty Clay		
		C-Clay		

Consistence Moist	Consistence Wet	Mineralogy
VFR-Very Friable	NS-Non-Sticky	SEXP-Slightly Expansive
FR-Friable	SS-Slightly Sticky	EXP-Expansive
FI-Firm	S-Sticky	
VFI-Very Firm	VS-Very Sticky	
EFI-Extremely Firm	NP-Non-Plastic	
	SP-Slightly Plastic	
	P-Plastic	
	VP-Very Plastic	

Sketch of Soil Evaluation Locations

