Supervisor/Administrative Professional Checklist

Repair

New Septic ☐ **New Well** ☐ **Use Existing** ☐ **Alteration** ☐ **Modified Plot Plan** ☐

New Septic Fees Paid:

IP ($250.00) _____ Initials/Date

CA ($200.00) _____ Initials/Date

OP ($200.00) _____ Initials/Date

Tank Replacement Only.

(CA and OP fees need to be paid before a building permit can be issued)

New Well Fee Paid: $550.00 _____ Initials/Date

Use Existing Fee Paid: $100.00 _____ Initials/Date

Alteration Fee Paid: $300.00 (Total) $200 (If use existing was paid)_____ Initials/Date

Modified Plot Plan Fee Paid: $100.00 _____ Initials/Date

Floor plans need to be submitted and reviewed before CA can be issued. ☐ Reviewed ☐ ____

This site is served by septic and well. Verify each is complete before final hold is released. ☐

Septic file completed. ☒ 10/10/19 Well file completed. ☐ _____

Send permit for signature. ☐ Signature received. ☐ _____

This septic system requires a certified operator contract before final hold is released. ☐

Certified operator contract is on file. ☐ _____

Septic File Complete

#10710
10433B

MECKLENBURG COUNTY
HEALTH DEPARTMENT

APPLICATION FOR A RESIDENTIAL SITE IMPROVEMENT PERMIT/ CONSTRUCTION AUTHORIZATION FOR AN ON-SITE WASTEWATER SYSTEM, NEW WELL INSTALLATION, OR REPAIR OF EXISTING WELL

1. SEPTIC / TYPE APPLICATION: ○ N/A ☒ NEW SYSTEM ○ ALTERATION ☒ REPAIR ○ MODIFIED PLOT PLAN

2. WELL / TYPE APPLICATION: ○ N/A ○ NEW WELL ○ MAJOR REPAIR ○ ABANDONMENT

3. JOB LOCATION INFORMATION:
TAX PARCEL NUMBER: 11124108
STREET ADDRESS: 3700 CAMP STEWART Rd
CITY: CHARLOTTE
STATE: NC ZIP: NC
SUBDIVISION NAME: NONE
LOT #: N/A LOT SIZE (acres): .95
TOWNSHIP:
☒ MECKLENBURG ○ CORNELIUS ○ HUNTERSVILLE
○ DAVIDSON ○ CHARLOTTE ○ PINEVILLE
○ MATTHEWS ○ MINT HILL

4. BUILDING INFORMATION:
BUILDING TYPE:
○ SINGLE MOBILE HOME ○ MODULAR HOME
○ DOUBLE WIDE ○ MULTIPLE FAMILY
☒ HOUSE ○ OTHER _____
HEATED SQUARE FOOTAGE: 1230
NUMBER OF BEDROOMS: 3
NUMBER OF OCCUPANTS: 2
FOUNDATION TYPE:
○ CONCRETE SLAB ○ BASEMENT WITH PLUMBING
☒ CRAWL SPACE ○ BASEMENT WITH NO PLUMBING

5. IF PLANNING TO EXPAND OR ALTER THE EXISTING SEPTIC SYSTEM PLEASE COMPLETE THE FOLLOWING SECTION: ☒ N/A

NUMBER OF BEDROOMS TO BE ADDED: _____ NUMBER OF ADDITIONAL OCCUPANTS IN THE RESIDENCE: _____

6. WATER SUPPLY: ○ MUNICIPAL ☒ PRIVATE WELL ○ PUBLIC WELL ○ SHARED WELL ○ OTHER _____

7. PROPOSED USE OF WELL: ○ N/A ○ IRRIGATION ○ POTABLE (DRINKING WATER) ○ OTHER _____

8. PLEASE INDICATE AND RANK DESIRED SEPTIC SYSTEM TYPE(S) IN ORDER OF PREFERENCE *(1-MOST DESIRED 5-LEAST DESIRED)*:

☐ N/A ☒ ANY TYPE ☒ CONVENTIONAL ☒ ACCEPTED ☐ INNOVATIVE ☐ ALTERNATIVE ☐ OTHER _____

8A. RANK: 1 2 ___ ___ ___

9. DO ANY OF THE FOLLOWING APPLY TO THE PROPERTY IN QUESTION? IF "YES" PLEASE ATTACH SUPPORTING DOCUMENTATION.

BURIED CABLES, LANDFILLS, STUMPHOLES	○ YES ☒ NO	GRADING/SOIL REMOVAL PERFORMED	○ YES ☒ NO
EXISTING WASTEWATER (SEPTIC) SYSTEMS	☒ YES ○ NO	JURISDICTIONAL WETLANDS	○ YES ☒ NO
WELLS, SPRINGS, OR WATER LINES	☒ YES ○ NO	APPROVAL REQUIRED BY ANY OTHER PUBLIC AGENCY	○ YES ☒ NO
EASEMENTS OR RIGHT-OF-WAYS	○ YES ☒ NO	WASTEWATER OTHER THAN DOMESTIC SEWAGE	○ YES ☒ NO
CHEMICAL/PETROLEUM STORAGE TANKS	○ YES ☒ NO	KNOWN UNDERGROUND CONTAMINATION	○ YES ☒ NO
WASTE STORAGE	○ YES ☒ NO	GROUNDWATER USE RESTRICTIONS/VARIANCES	○ YES ☒ NO

10. WHAT DATE WAS THE PROPERTY ORIGINALLY DEEDED AND RECORDED? 8-29-19 ☐ UNKNOWN

11. WHAT IS THE ANTICIPATED CLOSING DATE FOR THIS PROPERTY? _____ ☐ N/A

12. PROPERTY OWNER:
NAME: Eric S. Gaddy
ADDRESS: 3700 CAMP STEWART Rd.
CITY: CHARLOTTE
STATE: NC ZIP: 28215
WORK PHONE: _____
MOBILE PHONE: 704-807-1763
FAX: _____
E-MAIL: egaddy2@duke-energy.com

13. OWNER'S LEGAL REPRESENTATIVE, IF APPLICABLE:
NAME: _____
ADDRESS: _____
CITY: _____
STATE: _____ ZIP: _____
WORK PHONE: _____
MOBILE PHONE: _____
FAX: _____
E-MAIL: _____

MECKLENBURG COUNTY – GROUNDWATER & WASTEWATER SERVICES
3205 Freedom Dr. Suite 8000, Charlotte, NC 28208 OFFICE: (980) 314-1680, FAX: 704-336-6894

Revised on: 03/27/19

14. SEPTIC SYSTEM PERMIT APPLICATION:

If the information in this application is falsified, changed, or the site is altered, then the Improvement Permit and Authorization to Construct shall become invalid. I have read this application and certify that the information provided herein is true, complete and correct. Authorized county and state officials are granted right of entry to conduct necessary inspections to determine compliance with applicable laws and rules. I understand that I am solely responsible for the proper identification and labeling of all property lines and corners and making the site accessible so that a complete site evaluation can be performed. The permit is valid for either sixty (60) months or is non-expiring depending upon the documentation submitted: complete site plan = 60 months, complete plat = non-expiring.

EG (Initial here for septic system applications)

15. WELL PERMIT APPLICATION:

If the information in this application is falsified, changed, or the site is altered, then the Well Permit shall become invalid. I have read this application and certify that the information provided herein is true, complete and correct. Authorized county and state officials are granted right of entry to conduct necessary inspections to determine compliance with applicable laws and rules. I understand that I am solely responsible for the proper identification and labeling of all property lines and corners and making the site accessible so that a complete site evaluation can be performed. The permit is valid for a period of twelve (12) months from the date of issuance.

_____ (Initial here for well applications)

16. APPLICATION SIGNATURE SECTION:

ONLY COMPLETE APPLICATIONS WILL BE PROCESSED. A proper signature is required in order to process your application. Please review the application carefully and sign in the space provided below. A PROPOSED PLOT PLAN is required to be submitted with each application.

Dana Baddley
Property Owner's or Owner's Legal Representative Signature

9-11-19
Date

OFFICE USE ONLY

○ SURVEY PLAT TO SCALE SUBMITTED ○ SCALED SITE PLAN SUBMITTED ○ UN-SCALED SITE PLAN SUBMITTED

SEPTIC APPLICATION FEE RECEIVED: $ _____ DATE FEE RECEIVED: _____

WELL APPLICATION FEE RECEIVED: $ _____ DATE FEE RECEIVED: _____

APPLICATION PROCESSED BY: _____

GWS FILE NUMBER ASSIGNED: _____

APPLICATION ID NUMBER ASSIGNED: _____

COMMENTS:

MECKLENBURG COUNTY – GROUNDWATER & WASTEWATER SERVICES
3205 Freedom Dr. Suite 8000, Charlotte, NC 28208 OFFICE: (980) 314-1680, FAX: 704-336-6894

Revised on: 03/27/19


File #: _____

PROPOSED PLOT PLAN

A drawing showing the locations of the following items is required: existing and proposed property lines with dimensions, easements or right-of-ways, proposed building pad(s) or existing building footprint(s), all appurtenances (garage, driveway, deck, pool, etc.), location of existing or proposed well(s), location of existing or proposed sewer lines and sewage disposal systems, surface water bodies, and any aboveground or underground storage tanks. Provide names for all roads that adjoin the property.

Street Address: 3700 Camp Stewart Rd. Tax Parcel #: _____

Subdivision Name: NC Lot #: N/A

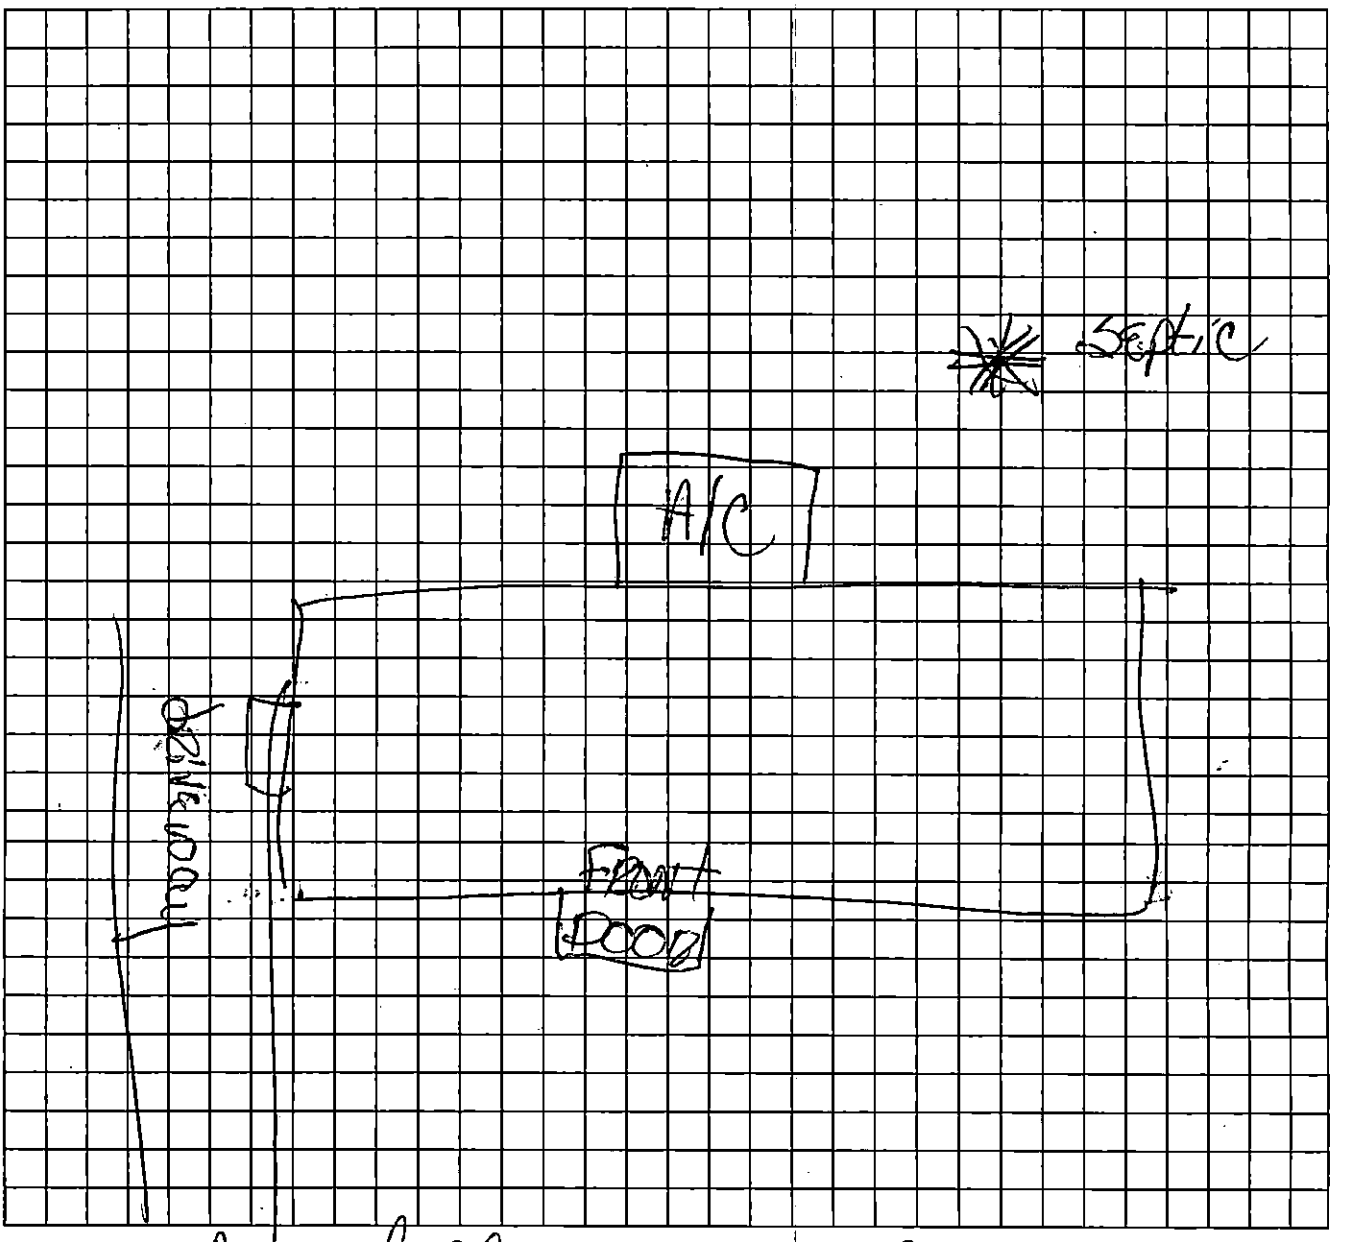

Jenya Ladd 9-12-19

Property Owner's or Owner's Legal Representative Signature Date

MECKLENBURG COUNTY – GROUNDWATER & WASTEWATER SERVICES
3205 Freedom Dr. Suite 8000, Charlotte, NC 28208, OFFICE: (980) 314-1680, FAX: 704-336-6894

Revised on: 03/27/19

Mecklenburg County Groundwater & Wastewater Services
3205 Freedom Dr. Suite 8000 Charlotte, NC 28208
Phone: (980) 314-1680 Fax: (704) 336-6894

NC DHHS
Division of Environmental Health
On-Site Wastewater Section

IMPROVEMENT PERMIT/CONSTRUCTION AUTHORIZATION for REPAIRING an ON-SITE WASTEWATER TREATMENT & DISPOSAL SYSTEM

File #: 10433b Permit #: 10710 Tax Parcel #: 11149108

Property Owner: Eric Gaddy

Job Location Address: 3700 Camp Stewart Rd

City: Charlotte State: NC Zip Code: 28

Improvement Permit Issuance Date: _____ **Construction Authorization Issuance Date:** 9-18-19

Permission is hereby given to **repair** an on-site wastewater treatment & and disposal system, with subsurface soil absorption and effluent discharge, as specified herein at the described location. This approval is granted based upon the application information submitted to our office. All work shall be completed on or before _____. The system shall meet all of the construction requirements of 15A NCAC 18A. 1900 which are in effect on the date of granting this approval. An **Operation Permit** must be obtained from the Mecklenburg County Health Department before any system can be covered up or placed into service. The issuance of this permit does not in any way guarantee that the system anticipated to be constructed will operate properly, or relieve any person now of hereafter owning, controlling or using such system from any liability resulting from the failure of the system to operate properly.

Permitted Design Flow: 360 GPD Site LTAR: NA GPD/ft²

Liquid Capacity of Septic Tank: 1000 gallons Liquid Capacity of Dosing Tank: NA gallons

Drainfield Design ☑ N/A

Trench Depth: _____ inches

Trench Width: _____ feet

Line Spacing: _____ feet (O.C.)

Total line length: _____ feet

# of Lines: _____ @ _____ feet

Depth of Media: _____ inches (Type) _____

Distribution Device: _____

Tank Only

Bed Design *(For Repair Installations ONLY.)* ☑ N/A

Bed Depth: _____ inches

Bed Width: _____ feet

Total line length: _____ feet

# of Lines: _____ @ _____ feet

Depth of Media: _____ inches (Type) _____

Distribution Device: _____

Tank only

Water Supply Source

☐ Municipal ☑ Private Well ☐ Community Well

☐ Other _____


Minimum System Setbacks

Distance from Building Foundation: 5 feet

Distance from Property Line: 10 feet

Distance from Water Supply Source: 50 feet

SKETCH OF SYSTEM LAYOUT
(Proposed Layout)

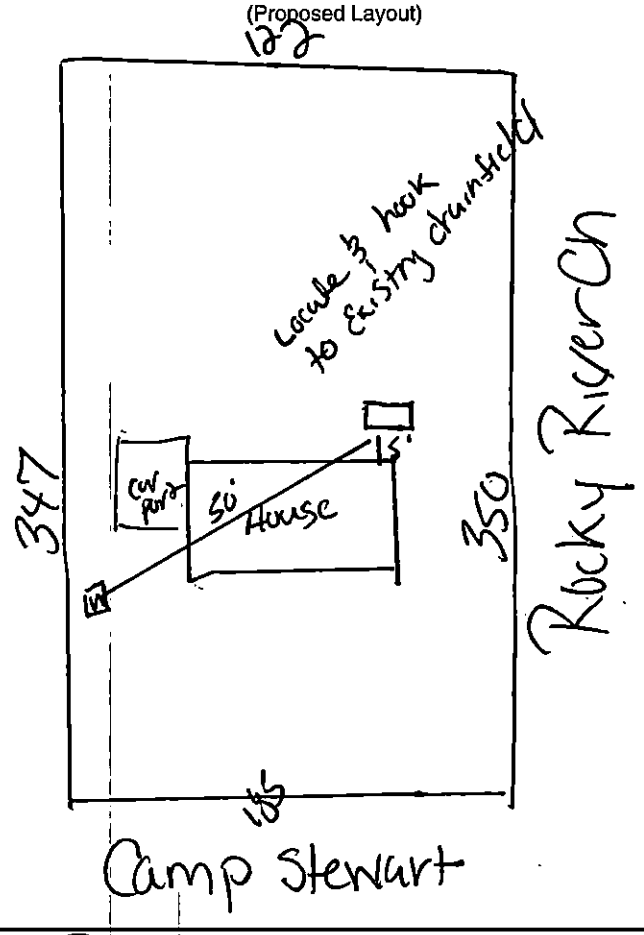

Comments: System Classification & Type: Tank Only. Pump & crush old tank. Set new 1000 gallon tank; dig to clean gravel & hook to Existing drainfield

Authorized Agent: Heather Ray Signature: Heather Ray

Owner Signature: _____ Date: _____

Mecklenburg County Groundwater & Wastewater Services
3205 Freedom Dr. Suite 8000 Charlotte, NC 28208
Phone: (980) 314-1660 Fax: (704) 336-6894

NC DHHS
Division of Environmental Health
On-Site Wastewater Section

IMPROVEMENT PERMIT/CONSTRUCTION AUTHORIZATION for REPAIRING an ON-SITE WASTEWATER TREATMENT & DISPOSAL SYSTEM

File #: 16433b Permit #: 10710 Tax Parcel #: 11149108

Property Owner: Eric Gaddy

Job Location Address: 3700 Camp Stewart Rd

City: Charlotte State: NC Zip Code: 8

Improvement Permit Issuance Date: _____ **Construction Authorization Issuance Date:** 9-18-19

Permission is hereby given to **repair** an on-site wastewater treatment & and disposal system, with subsurface soil absorption and effluent discharge, as specified herein at the described location. This approval is granted based upon the application information submitted to our office. All work shall be completed on or before _____. The system shall meet all of the construction requirements of 15A NCAC 18A. 1900 which are in effect on the date of granting this approval. An **Operation Permit** must be obtained from the Mecklenburg County Health Department before any system can be covered up or placed into service. The issuance of this permit does not in any way guarantee that the system anticipated to be constructed will operate properly, or relieve any person now of hereafter owning, controlling or using such system from any liability resulting from the failure of the system to operate properly.

Permitted Design Flow: 360 GPD Site LTAR: NA GPD/ft²

Liquid Capacity of Septic Tank: 1000 gallons Liquid Capacity of Dosing Tank: NA gallons

Drainfield Design ☐ N/A

Trench Depth: _____ inches

Trench Width: _____ feet

Line Spacing: _____ feet (O.C.)

Total line length: _____ feet

# of Lines: _____ @ _____ feet

Depth of Media: _____ inches (Type) _____

Distribution Device: _____

Tank Only

Bed Design *(For Repair Installations ONLY.)* ☑ N/A

Bed Depth: _____ inches

Bed Width: _____ feet

Total line length: _____ feet

# of Lines: _____ @ _____ feet

Depth of Media: _____ inches (Type) _____

Distribution Device: _____

Tank only

Water Supply Source

☐ Municipal ☑ Private Well ☐ Community Well

☐ Other _____


Minimum System Setbacks

Distance from Building Foundation: 5 feet

Distance from Property Line: 10 feet

Distance from Water Supply Source: 50 feet

SKETCH OF SYSTEM LAYOUT
(Proposed Layout)

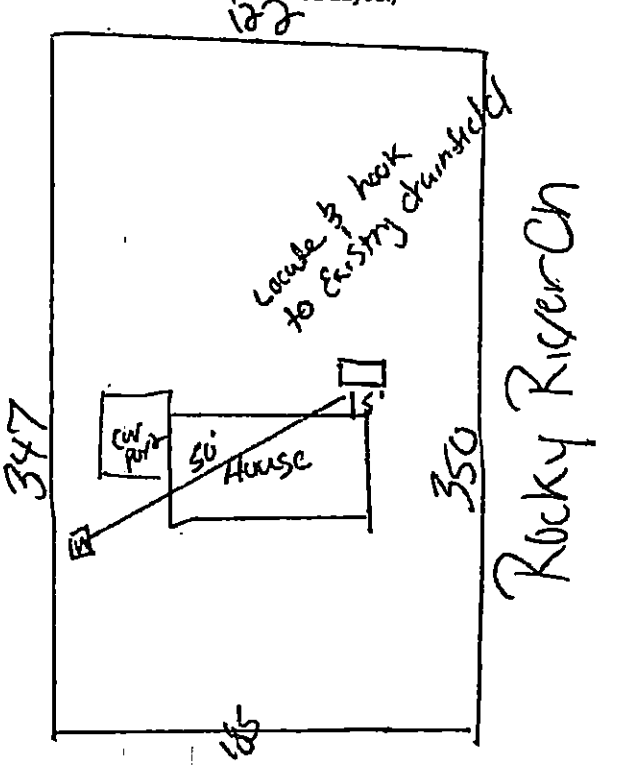

Comments: System Classification & Type: Tank Only. Pump & crush old tank. Set new 1000 gallon tank; dig to clean gravel & hook to Existing drainfield

Authorized Agent: Heather Ray Signature: Heather Ray

Owner Signature: [signature] Date: 10/4/19

Mecklenburg County Groundwater & Wastewater Services
3205 Freedom Dr. Suite 8000, Charlotte, NC 28208
Phone: (980) 314-1680 Fax: (704) 336-6894

NC DHHS
Division of Environmental Health
On-Site Wastewater Section

OPERATION PERMIT for an ON-SITE WASTEWATER TREATMENT & DISPOSAL SYSTEM

File #: 104338 Permit #: 10710 Tax Parcel #: 111 49 108

Property Owner: Eric Gaddy

Job Location Address: 3700 Camp Stewart rd

City: Charlotte State: NC Zip Code: 28215

Operation Permit Issuance Date: 10-9-19 Contractor Name: Jimmy Lowery

Permitted Design Flow: 360 GPD Liquid Capacity of Dosing Tank: Na gallons

Liquid Capacity of Septic Tank: 1000 gallons Tank Manufacture Infiltrator Effluent Pump Model: Na

Drainfield Installation ☑ N/A

Trench Depth: _____ inches

Trench Width: _____ feet

Line Spacing: _____ feet (O.C.)

Total line length: _____ feet

# of Lines: _____ @ _____ feet

Depth of Media: _____ inches (Type) _____

Depth of Cover: _____ inches

Distribution Device: _____

Bed Installation *(For Repair Installations ONLY.)* ☑ N/A

Bed Depth: _____ inches

Bed Width: _____ feet

Total line length: _____ feet

# of Lines: _____ @ _____ feet

Depth of Media: _____ inches (Type) _____

Depth of Cover: _____ inches

Distribution Device: _____

Water Supply Source

☐ Municipal ☑ Private Well ☐ Community Well

☐ Other _____

System Installation Setbacks

Distance from Building Foundation: 10 feet

Distance from Property Line: 10 feet

Distance from Water Supply Source: 50 feet


Inspection Dates

Tank(s) Inspected: 10-9-19

Excavation Inspected: 10-9-19

Pump & Controls Inspected: Na

SKETCH OF SYSTEM INSTALLATION
(As-Built Drawing)

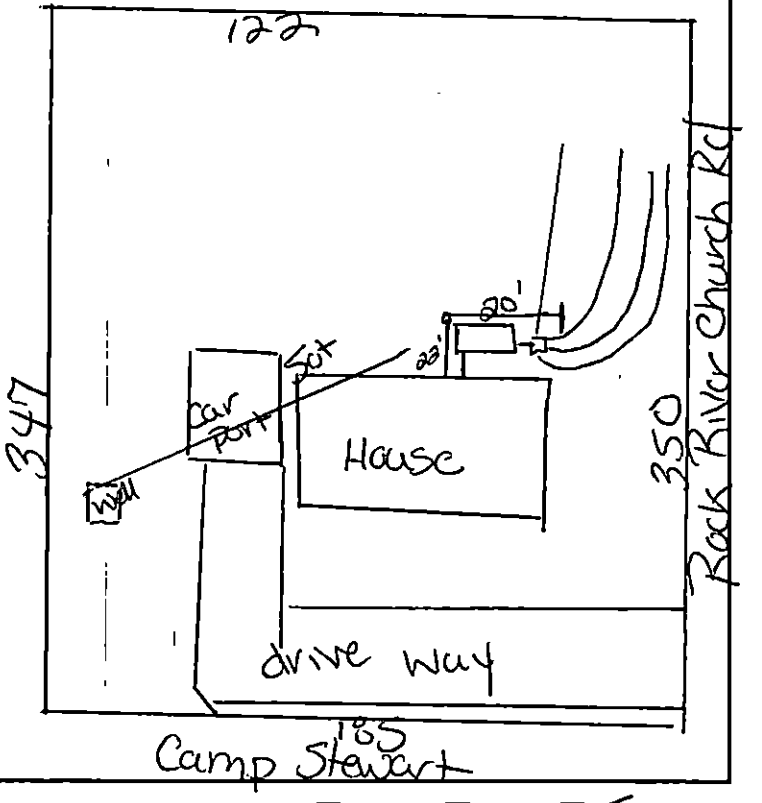

The undersigned has inspected the Septic Tank System described above, and certifies it has been ☐ installed ☐ altered ☑ repaired ☐ as detailed in the plot above ☐ in accordance with the permit issued and meets the provisions of 15A NCAC 18A. 1900, "Laws and Rules for Sewage Treatment and Disposal Systems" in effect on the date of issuance of the permit. The issuance of this Operation Permit does not in any way guarantee that the system will operate properly or relieve any person now or hereafter owning, controlling, or using such system from any liability resulting from the failure of the system to operate properly. This document is issued subject to those restrictions and conditions shown on the permit(s) and the provisions of 15A NCAC 18A. 1900 in addition to those listed below under "Comments." This document shall be null and void if any information contained in the application is untrue or if any additions are made to the property which would increase the requirements for said system.

Notice: Disturbance of the designated repair area may result in the Suspension or Revocation of this permit.

Comments: System Classification & Type: Tank only

DENR Authorized Agent: Heather Ray Signature: Heather Ray

Mecklenburg County Groundwater & Wastewater Services
3205 Freedom Dr. Suite 8000, Charlotte, NC 28208
Phone: (980) 314-1680 Fax: (704) 336-6894

NC DHHS
Division of Environmental Health
On-Site Wastewater Section

OPERATION PERMIT for an
ON-SITE WASTEWATER TREATMENT & DISPOSAL SYSTEM

File #: 104338 Permit #: 10710 Tax Parcel #: 11149108

Property Owner: Eric Gaddy

Job Location Address: 3700 Steacamp Stewart rd

City: Charlotte State: NC Zip Code: 28215

OPERATION PERMIT CONDITIONS:

I. Performance: System shall perform in accordance with 15A NCAC 18A .1961.

II. Monitoring: System shall be monitored as required by 15A NCAC 18A .1961.

III. Maintenance: Ground absorption sewage treatment and disposal systems shall be checked, and the contents of the septic tank removed, periodically from all compartments, to ensure proper operation of the system. The contents shall be pumped whenever the solids level is found to be more than 1/3 of the liquid depth in any compartment.

IV. Operation: System shall be operated in accordance with 15A NCAC 18A .1961.

System Classification: Tank only

*Operation Permits for Type V and VI systems expire five (5) years from the date of issuance (in accordance with Table V(a)). The system owner must contact GWS six (6) months prior to expiration for permit renewal.

Subsurface system operator required: Yes ☐ No ☐

☐ This type of system requires the system owner to maintain a contract with a certified operator to perform system inspection, maintenance, and reporting as required in 15A NCAC 18A .1961. and Table V(a). The system owner is responsible for all fees associated with these services.

☐ System does not require inspection by GWS on a routine frequency.

☐ System requires inspection by GWS once every five (5) years. The system owner is responsible for all fees associated with the inspection.

☐ System requires inspection by GWS once every three (3) years. The system owner is responsible for all fees associated with the inspection.

☐ System requires inspection by GWS once every twelve (12) months. The system owner is responsible for all fees associated with the inspection.

☐ System requires inspection by GWS once every six (6) months. The system owner is responsible for all fees associated with the inspection.

V. Other: Tank Replacement only

DENR Authorized Agent: Heather Ray Date: 10/9/19

Signature: Heather Ray