8248B JAM 4885

MECKLENBURG COUNTY
GROUNDWATER & WASTEWATER SERVICES

APPLICATION FOR A RESIDENTIAL SITE IMPROVEMENT PERMIT/ CONSTRUCTION AUTHORIZATION FOR AN ON-SITE WASTEWATER SYSTEM, NEW WELL INSTALLATION, OR REPAIR OF EXISTING WELL

1. SEPTIC / TYPE APPLICATION: ☐ N/A ☐ NEW SYSTEM ☑ ALTERATION ☐ REPAIR ☐ MODIFIED PLOT PLAN

2. WELL / TYPE APPLICATION: ☐ N/A ☐ NEW WELL ☐ MAJOR REPAIR ☐ ABANDONMENT

3. JOB LOCATION INFORMATION:
TAX PARCEL NUMBER: 139-302-01
STREET ADDRESS: 8200 Arlington church Rd
CITY: Charlotte
STATE: NC ZIP: 28227
SUBDIVISION NAME:
LOT #: LOT SIZE (acres): 1.457
TOWNSHIP:
☑ 0-MECKLENBURG ☐ 3-CORNELIUS ☐ 6-HUNTERSVILLE
☐ 1-CHARLOTTE ☐ 4-PINEVILLE ☐ 7-MINT HILL
☐ 2-DAVIDSON ☐ 5-MATTHEWS

4. BUILDING INFORMATION:
BUILDING TYPE:
☐ SINGLE MOBILE HOME ☐ MODULAR HOME
☐ DOUBLE WIDE ☐ MULTIPLE FAMILY
☑ HOUSE ☐ OTHER _____
HEATED SQUARE FOOTAGE:
NUMBER OF BEDROOMS: 2
NUMBER OF OCCUPANTS: 2
FOUNDATION TYPE:
☐ CONCRETE SLAB ☐ BASEMENT WITH PLUMBING
☑ CRAWL SPACE ☐ BASMENT WITH NO PLUMBING

5. IF PLANNING TO EXPAND OR ALTER THE EXISTING SEPTIC SYSTEM PLEASE COMPLETE THE FOLLOWING SECTION: ☐ N/A

NUMBER OF BEDROOMS TO BE ADDED: 1 NUMBER OF ADDITIONAL OCCUPANTS IN THE RESIDENCE: 0

6. WATER SUPPLY: ☐ MUNICIPAL ☑ PRIVATE WELL ☐ PUBLIC WELL ☐ SHARED WELL ☐ OTHER _____

7. PROPOSED USE OF WELL: ☐ N/A ☐ IRRIGATION ☒ POTABLE (DRINKING WATER) ☐ OTHER _____

8. PLEASE INDICATE AND RANK DESIRED SEPTIC SYSTEM TYPE(S) IN ORDER OF PREFERENCE *(1-MOST DESIRED 5-LEAST DESIRED).*

☑ N/A ☐ ANY TYPE ☐ CONVENTIONAL ☐ ACCEPTED ☐ INNOVATIVE ☐ ALTERNATIVE ☐ OTHER _____

8A. RANK: ____ ____ ____ ____ ____

9. DO ANY OF THE FOLLOWING APPLY TO THE PROPERTY IN QUESTION? IF "YES" PLEASE ATTACH SUPPORTING DOCUMENTATION.

BURIED CABLES, LANDFILLS, STUMPHOLES	☐ YES	☑ NO	GRADING/SOIL REMOVAL PERFORMED	☐ YES	☑ NO
EXISTING WASTEWATER (SEPTIC) SYSTEMS	☑ YES	☐ NO	JURISDICTIONAL WETLANDS	☐ YES	☑ NO
WELLS, SPRINGS, OR WATER LINES	☒ YES	☒ NO	APPROVAL REQUIRED BY ANY OTHER PUBLIC AGENCY	☐ YES	☑ NO
EASEMENTS OR RIGHT-OF-WAYS	☐ YES	☑ NO	WASTEWATER OTHER THAN DOMESTIC SEWAGE	☐ YES	☑ NO
CHEMICAL/PETROLEUM STORAGE TANKS	☐ YES	☑ NO	KNOWN UNDERGROUND CONTAMINATION	☐ YES	☑ NO
WASTE STORAGE	☐ YES	☑ NO	GROUNDWATER USE RESTRICTIONS/VARIANCES	☐ YES	☑ NO

10. WHAT DATE WAS THE PROPERTY ORIGINALLY DEEDED AND RECORDED? _____ ☑ UNKNOWN

11. WHAT IS THE ANTICIPATED CLOSING DATE FOR THIS PROPERTY? _____ ☑ N/A

12. PROPERTY OWNER:
NAME: Darlene Cooper
ADDRESS: 8200 Arlington Church Rd
CITY: Charlotte
STATE: NC ZIP: 28227
HOME PHONE:
WORK PHONE:
MOBILE PHONE:
FAX:

13. OWNER'S LEGAL REPRESENTATIVE, IF APPLICABLE:
NAME: William Caldwell
ADDRESS: 7427 Matthews Mint Hill Rd
CITY: Mint Hill
STATE: NC ZIP: 28227
HOME PHONE:
WORK PHONE: 704-201-8200
MOBILE PHONE:
FAX:

MECKLENBURG COUNTY – GROUNDWATER & WASTEWATER SERVICES
700 N. TRYON ST. SUITE 211 CHARLOTTE, NC 28202, OFFICE: 704-336-5103, FAX: 704-336-6894

Revised on: 7/1/08

14. SEPTIC SYSTEM PERMIT APPLICATION:

If the information in this application is falsified, changed, or the site is altered, then the Improvement Permit and Authorization to Construct shall become invalid. I have read this application and certify that the information provided herein is true, complete and correct. Authorized county and state officials are granted right of entry to conduct necessary inspections to determine compliance with applicable laws and rules. I understand that I am solely responsible for the proper identification and labeling of all property lines and corners and making the site accessible so that a complete site evaluation can be performed. The permit is valid for either sixty (60) months or is non-expiring depending upon the documentation submitted: complete site plan = 60 months, complete plat = non-expiring.

_____ (Initial here for septic system applications)

15. WELL PERMIT APPLICATION:

If the information in this application is falsified, changed, or the site is altered, then the Well Permit shall become invalid. I have read this application and certify that the information provided herein is true, complete and correct. Authorized county and state officials are granted right of entry to conduct necessary inspections to determine compliance with applicable laws and rules. I understand that I am solely responsible for the proper identification and labeling of all property lines and corners and making the site accessible so that a complete site evaluation can be performed. The permit is valid for a period of twelve (12) months from the date of issuance.

_____ (Initial here for well applications)

16. APPLICATION SIGNATURE SECTION:

ONLY COMPLETE APPLICATIONS WILL BE PROCESSED. A proper signature is required in order to process your application. Please review the application carefully and sign in the space provided below.

_____ _____

Property Owner's or Owner's Legal Representative Signature Date

---

OFFICE USE ONLY

☐ SURVEY PLAT TO SCALE SUBMITTED ☐ SCALED SITE PLAN SUBMITTED ☐ UN-SCALED SITE PLAN SUBMITTED

SEPTIC APPLICATION FEES RECEIVED: $ 300 w/ acct DATE FEE RECEIVED: 12/13/10

WELL APPLICATION FEES RECEIVED: $ _____ DATE FEE RECEIVED: _____

APPLICATION PROCESSED BY: gc

GWS FILE NUMBER ASSIGNED: 82498

APPLICATION ID NUMBER ASSIGNED: 4885

COMMENTS:

MECKLENBURG COUNTY – GROUNDWATER & WASTEWATER SERVICES
700 N. TRYON ST. SUITE 211 CHARLOTTE, NC 28202, OFFICE: 704-336-5103, FAX: 704-336-6894


Revised on: 7/1/08

Mecklenburg County
Land Use & Environmental Service Agency
Groundwater & Wastewater Services
700 N. Tryon St., Suite 211
Charlotte, NC 28202
Phone: (704) 336-5103
Fax: (704) 336-6894

File # 8249B
Date_____

PROPOSED PLOT PLAN

A map showing existing and proposed property lines and easements with dimensions, the location of the single family residence, non-single family residence, or other facility, and appurtenances, the site for the proposed well, and the location of existing or proposed sewer lines and/or sewage disposal systems, surface water bodies, aboveground or underground storage tanks. Name all roads adjoining the property. If this a repair indicate the type of repair.

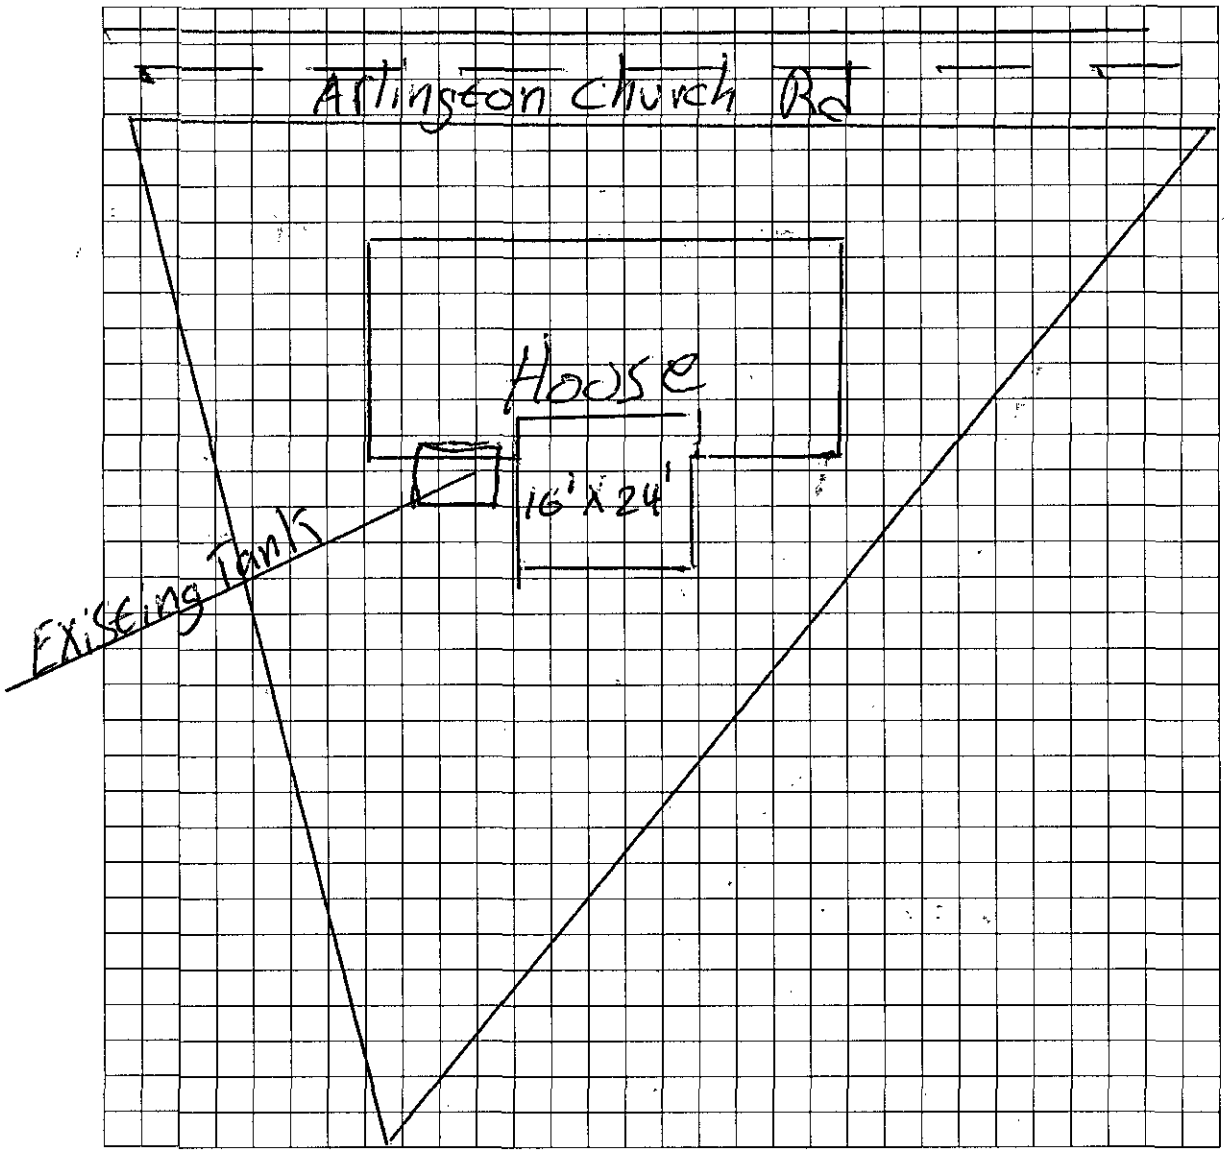

Owner/Agent Signature William B Cochran IV

Date 12-13-10

LBC 12/15/04

Department of Environment, Health, and Natural Resources
Division of Environmental Health
On-site Wastewater Section

Sheet: 1 of 2
Property ID: 139-302-01
Lot #:
File #: 8249B
AppID: 4885

SOIL/SITE EVALUATION for ON-SITE WASTEWATER SYSTEM

Owner: Darlene Cooper
Applicant: William Caldwell
Address: 8200 Arlington Church Rd.
Date Evaluated: 12/14/2010
Proposed Facility: Addition to existing
Design Flow (.1949): 360 GPD
Property Size:
Location of Site: 8200 Arlington Church Rd. Charlotte, NC 28227
Property Recorded: 1957
Water Supply: [ ] Public [X] Individual [X] Well [ ] Spring [ ] Other
Evaluation Method: [X] Auger Boring [ ] Pit [ ] Cut
Type of Wastewater: [X] Sewage [ ] Industrial Process [ ] Mixed

PROFILE #	.1940 Landscape Position/ Slope%	Horizon Depth (IN.)	SOIL MORPHOLOGY .1941 Structure/ Texture	SOIL MORPHOLOGY .1941 Consistence Mineralogy	b PROFILE FACTORS .1942 Soil Wetness/ Color	.1943 Soil Depth (IN.)	.1956 Sapro Class	.1944 Restr Horiz	Profile Class & LTAR
1	LS- 2%	0-6	GR/SCL	SS/SP/FRI/SEXP		48"			IV, PS 0.3 GPD/FT2
		6-48	SBK/C	S/P/FI/SEXP					
2	LS-2%	0-8	GR/SCL	SS/SP/FRI/SEXP		48"			IV, PS 0.3 GPD/FT2
		6-48	SBK/C	S/P/FI/SEXP					

Description	Initial System	Repair System
Available Space (.1945)	PS	PS
System Type(s)	IIIg	IIIg
Site LTAR	0.3	0.3


Other Factors (.1946):
Soil Evaluation By: Jeremy Michael
Others Present: Jeremy Michael 12/15/10
Site Classification (.1948):
Site Evaluation By: Jeremy Michael
Others Present:

COMMENTS:


Landscape Position	Group	Texture	.1955 LTAR	Structure
R-Ridge	I	S-Sand	1.2 - 0.8	SG-Single Grain
SS-Shoulder Slope		LS-Loamy Sand		M-Massive
LS-Linear Slope				CR-Crumb
FS-Foot Slope	II	SL-Sandy Loam	0.8 - 0.6	GR-Granular
NS-Nose Slope		L-Loam		SBK-Subangular Blocky
HS-Head Slope				ABK-Angular Blocky
CC-Concave Slope	III	SI-Silt	0.6 - 0.3	PL-Platy
CV-Convex Slope		SICL-Silty Clay Loam		PR-Prismatic
T-Terrace				
FP-Flood Plain		CL-Clay Loam		
		SCL-Sandy Clay Loam		
	IV	SC-Sandy Clay	0.4 - 0.1	
		SIC-Silty Clay		
		C-Clay		

Consistence Moist	Consistence Wet	Mineralogy
VFR-Very Friable	NS-Non-Sticky	SEXP-Slightly Expansive
FR-Friable	SS-Slightly Sticky	EXP-Expansive
FI-Firm	S-Sticky	
VFI-Very Firm	VS-Very Sticky	
EFI-Extremely Firm	NP-Non-Plastic	
	SP-Slightly Plastic	
	P-Plastic	
	VP-Very Plastic	

Sketch of Soil Evaluation Locations

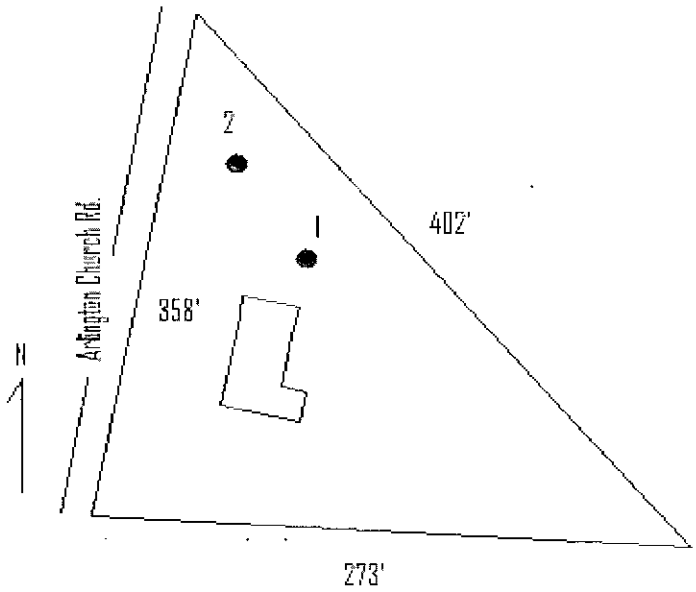

SOIL EVALUATION LOCATIONS FOR
Parcel # 139-302-01
WAPSPS APPLICATION # 4885

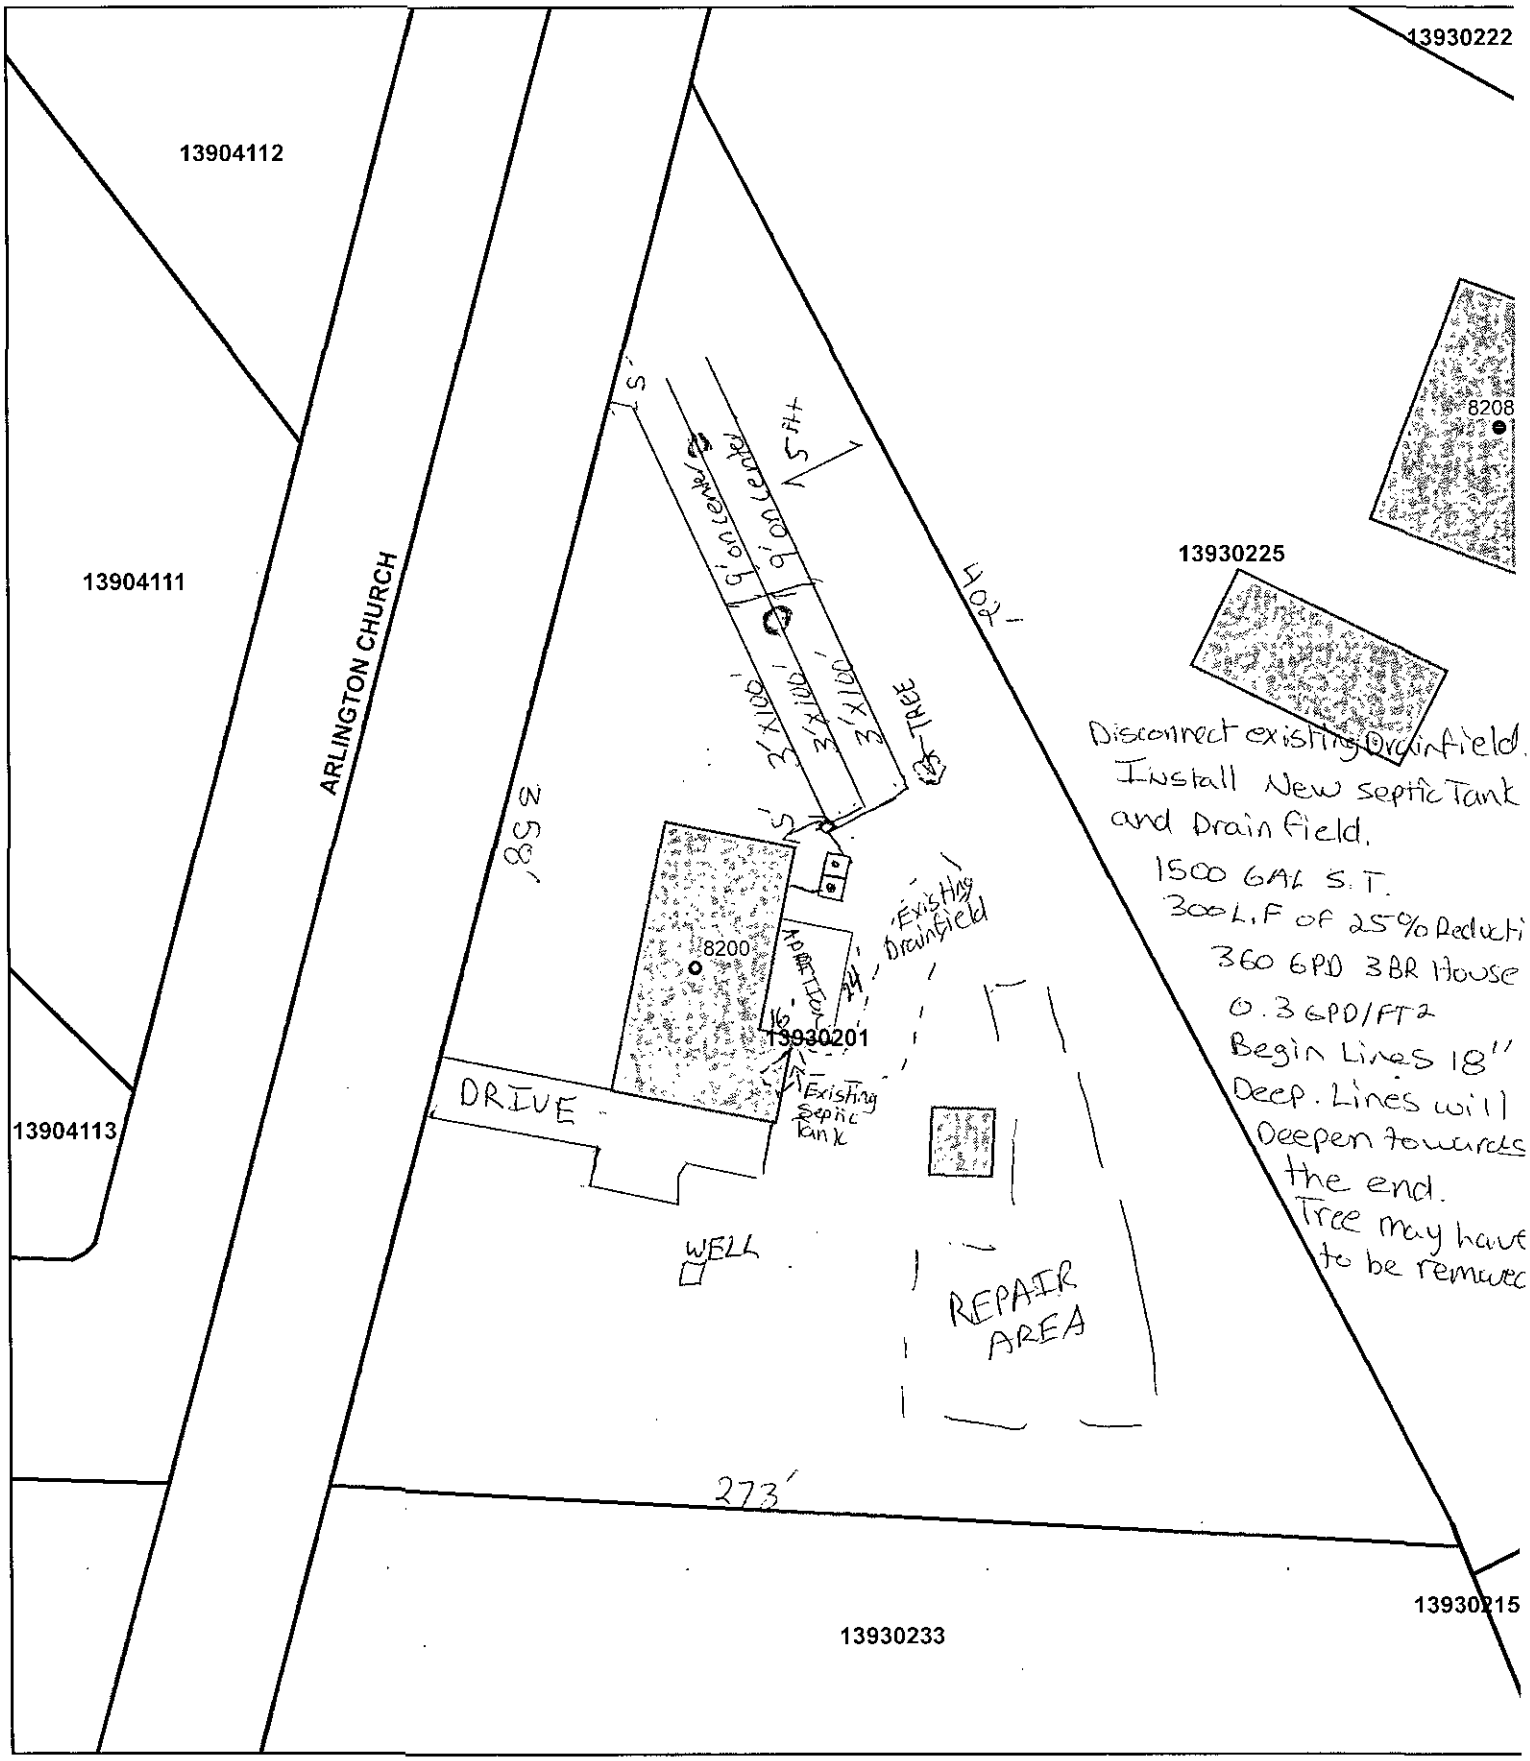

Map Created By: J. Michael
Map Created On: 12/15/2010

Jeremy Michael 12/15/2010

0 20 40 80 Feet

Auger Boring Locations

CONDITIONS OF IMPROVEMENT PERMIT for an ALTERATION TO AN EXISTING ON-SITE WASTEWATER TREATMENT & DISPOSAL SYSTEM

Permit Number: **8249B** Tax Number: **139-302-01**

- The IMPROVEMENT PERMIT is subject to revocation if site plans or the intended use change. There is to be **NO** grading, filling, or disturbance of the soil in the area of the septic tank system or repair area.
- CONSTRUCTION AUTHORIZATION must be obtained prior to receiving a Building Permit. The Construction Authorization is **NOT** transferable. Do not clear, grade, fill or disturb soil prior to obtaining a Construction Authorization.
- Domestic-type wastewater only. No industrial process wastewater may be discharged into the system.

Basement: ☐ Yes ☒ No ☐ Partial Basement

Primary Wastewater System

Type: ☐ I ☐ II ☒ III ☐ IV ☐ V ☐ VI

☐ Conventional
☐ Prefabricated, permeable block panel system
☐ Shallow Placed Conventional
☐ Low Pressure Pipe
☐ Large Diameter Pipe
☐ Fill
☐ Other Approved
☐ Innovative or Experimental:

0.3 Long-term acceptance rate (GPD/ft^2)	360 Max gallons/day wastewater flow	900 Absorption Area (ft^2)	9 Trench spacing (min. on centers) (ft)
Serviced by private well: ☒ Yes ☐ No	1500 Gallon septic tank	300 Total trench length (ft)	36 Maximum trench depth (in) (At least 12" of provisionally suitable soil must remain between trench bottom and unsuitable soil conditions.)
3 Bedrooms in residence	n/a Gallon pump tank	12 Depth of media (in)	

Any surface water present: **no** Type: Minimum separation distance (ft):

Additional conditions: **Stay 5ft off all property lines. Stay a minimum of 50ft off any well. Install drain lines level. Follow setbacks on plot plan issued with permit.**

Repair Area System

Type: ☐ I ☐ II ☒ III ☐ IV ☐ V ☐ VI

☐ Conventional
☐ Prefabricated, permeable block panel system
☐ Shallow Placed Conventional
☐ Low Pressure Pipe
☐ Large Diameter Pipe
☐ Fill
☐ Other Apporved
☐ Innovative or Experimental:

900 Absorption Area (ft^2) 300 Total trench length (ft)	12 Depth of media (in)	9 Trench spacing (min. on centers) (ft)	36 Maximum trench depth (in)

The undersigned, an authorized agent of the MECKLENBURG COUNTY HEALTH DEPARTMENT, certifies that the Department has approved the Request for the Job Location contained in this document. The approval is granted in accordance with the provisions of Laws and Rules For Sewage Treatment, and Disposal Systems in effect at the time of issuance of the permit and is subject to the following provisions:

*** No work shall be conducted on the septic tank system until an Installation Approval is granted by this Department.

*** This Improvement permit is transferable.

Jeremy Michael 12/15/2010

DENR Authorized Agent Date

Owner/Agent Signature Date

MECKLENBURG COUNTY
GROUNDWATER & WASTEWATER SERVICES
700 N. TRYON ST., SUITE 211
CHARLOTTE, NC 28202
PHONE: (704) 336-5103
FAX: (704) 336-6894

NC DENR
DIVISION OF ENVIRONMENTAL HEALTH
ON-SITE WASTEWATER SECTION

Mecklenburg County Groundwater & Wastewater Services
700 N. Tryon St., Suite 211 Charlotte, NC 28202
Phone: (704) 336-5103 Fax: (704) 336-6894

NC DENR
Division of Environmental Health
On-Site Wastewater Section

INSTALLATION APPROVAL for an ON-SITE WASTEWATER TREATMENT & DISPOSAL SYSTEM

File #: 8249B Permit #: _____ Tax Parcel #: 139-302-01

Property Owner: Darlene Cooper

Job Location Address: 8200 Arlington Church Rd.

City: Charlotte State: NC Zip Code: 28227

Installation Approval Issuance Date: 12/21/2010

Permission is hereby given to ☐ install ☒ alter ☐ repair an on-site wastewater treatment & and disposal system, with subsurface soil absorption and effluent discharge, as specified herein at the described location. This approval is granted based upon the application information submitted to our office. All work shall be completed on or before _____, after which date this approval shall be null and void. The system shall meet all of the construction requirements of 15A NCAC 18A. 1900 which are in effect on the date of granting this approval. An **Operation Permit** must be obtained from the Mecklenburg County Health Department before any system can be covered up or placed into service. The issuance of this permit does not in any way guarantee that the system anticipated to be constructed will operate properly, or relieve any person now of hereafter owning, controlling or using such system from any liability resulting from the failure of the system to operate properly.

***NOTICE: This system shall not be installed while soils are in a wet condition.**

Permitted Design Flow: 360 GPD

Site LTAR: 0.3 GPD/ft² (For new installations only.)

Liquid Capacity of Septic Tank: 1500 gallons

Liquid Capacity of Dosing Tank: N/A gallons

Drainfield Design ☐ N/A

Trench Depth: 36 inches

Trench Width: 3 feet

Line Spacing: 9 feet (O.C.)

Total line length: 300 feet

# of Lines: 3 @ 100 feet

Depth of Media: 12 inches (Type) 25% Reduction

Distribution Device: Distribution Box

Bed Design *(For Repair Installations ONLY.)* ☒ N/A

Bed Depth: _____ inches

Bed Width: _____ feet

Total line length: _____ feet

# of Lines: _____ @ _____ feet

Depth of Media: _____ inches (Type) _____

Distribution Device: _____

Water Supply Source

☐ Municipal ☒ Private Well ☐ Community Well

☐ Other _____


Minimum System Setbacks

Distance from Building Foundation: 5 feet

Distance from Property Line: 5 feet

Distance from Water Supply Source: _____ feet

SKETCH OF SYSTEM LAYOUT
(Proposed Layout)

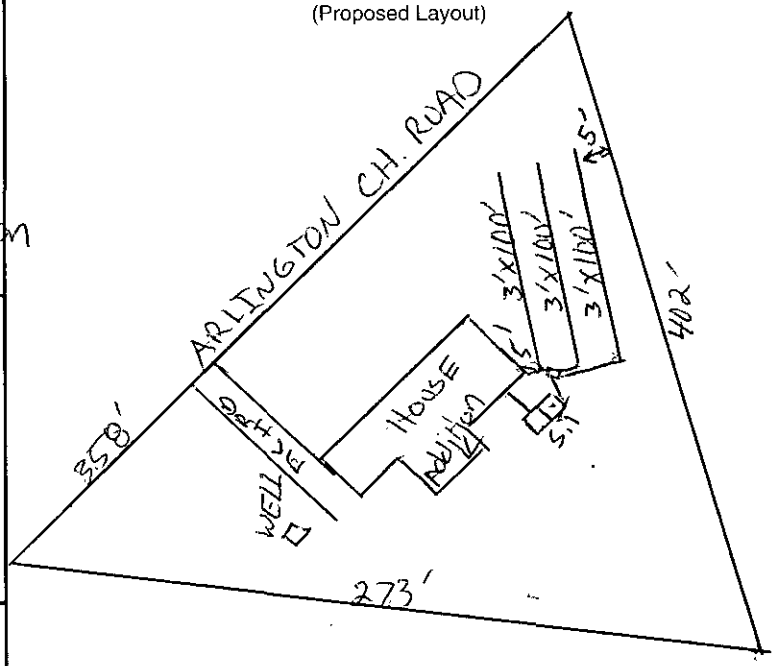

Comments: System Classification & Type: II Ig

DENR Authorized Agent: Jeremy Michael Signature: Jeremy Michael

Mecklenburg County Groundwater & Wastewater Services
700 N. Tryon St., Suite 211 Charlotte, NC 28202
Phone: (704) 336-5103 Fax: (704) 336-6894

NC DENR
Division of Environmental Health
On-Site Wastewater Section

OPERATION PERMIT for an ON-SITE WASTEWATER TREATMENT & DISPOSAL SYSTEM

File #: 8249B Permit #: _____ Tax Parcel #: 139-320-01

Property Owner: Darlene Cooper

Job Location Address: 8200 Arlington Church Rd.

City: Charlotte State: NC Zip Code: 28227

Operation Permit Issuance Date: 12/23/2010 Contractor Name: Bobby McCarver

Permitted Design Flow: 360 GPD

Liquid Capacity of Septic Tank: 1500 gallons

Liquid Capacity of Dosing Tank: N/A gallons

Effluent Pump Model: N/A

Drainfield Installation ☐ N/A

Trench Depth: 36 inches

Trench Width: 3 feet

Line Spacing: 9 feet (O.C.)

Total line length: 300 feet

# of Lines: 4 @ _____ feet (1)@60 3@80

Depth of Media: 12 inches (Type) ADS chambers

Depth of Cover: 24 inches

Distribution Device: D-Box

Inspection Dates

Tank(s) Inspected: 12/23/2010

Excavation Inspected: 12/23/2010

Pump & Controls Inspected: N/A

Bed Installation *(For Repair Installations ONLY.)* ☒ N/A

Bed Depth: _____ inches

Bed Width: _____ feet

Total line length: _____ feet


# of Lines: _____ @ _____ feet

Depth of Media: _____ inches (Type) _____

Depth of Cover: _____ inches

Distribution Device: _____

SKETCH OF SYSTEM INSTALLATION
(As-Built Drawing)

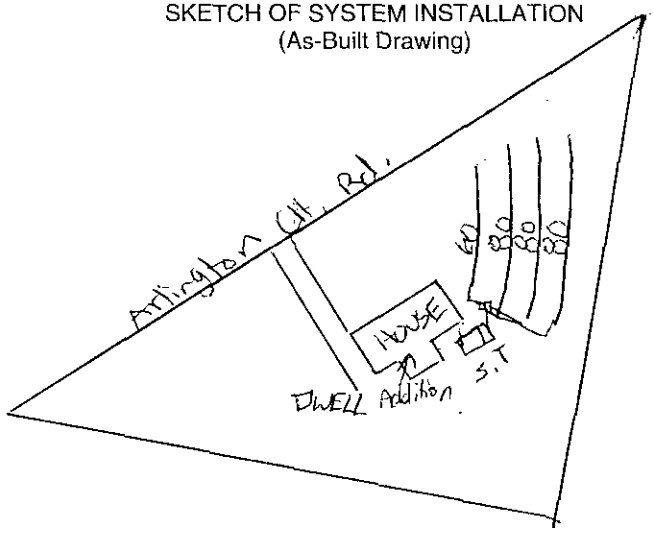

Water Supply Source

☐ Municipal ☒ Private Well ☐ Community Well

☐ Other _____

System Installation Setbacks

Distance from Building Foundation: 5 feet

Distance from Property Line: 5 feet

Distance from Water Supply Source: 100 feet

The undersigned has inspected the Septic Tank System described above, and certifies it has been ☐ installed ☒ altered ☐ repaired ☒ as detailed in the plot above ☐ in accordance with the permit issued and meets the provisions of 15A NCAC 18A. 1900, "Laws and Rules for Sewage Treatment and Disposal Systems" in effect on the date of issuance of the permit. The issuance of this Operation Permit does not in any way guarantee that the system will operate properly or relieve any person now or hereafter owning, controlling, or using such system from any liability resulting from the failure of the system to operate properly. This document is issued subject to those restrictions and conditions shown on the permit(s) and the provisions of 15A NCAC 18A. 1900 in addition to those listed below under "Comments." This document shall be null and void if any information contained in the application is untrue or if any additions are made to the property which would increase the requirements for said system.

Notice: Disturbance of the designated repair area may result in the Suspension or Revocation of this permit.

Comments: System Classification & Type: 1111g Bio 436 6, AA, UU

DENR Authorized Agent: Jeremy Michael Signature: Jeremy Michael

Mecklenburg County Groundwater & Wastewater Services
700 N. Tryon St., Suite 211 Charlotte, NC 28202
Phone: (704) 336-5103 Fax: (704) 336-6894

NC DENR
Division of Environmental Health
On-Site Wastewater Section

OPERATION PERMIT for an
ON-SITE WASTEWATER TREATMENT & DISPOSAL SYSTEM

File #: 8249B Permit #: _____ Tax Parcel #: 139-320-01

Property Owner: Darlene Cooper

Job Location Address: 8200 Arlington Church Rd.

City: Charlotte State: NC Zip Code: 28227

OPERATION PERMIT CONDITIONS:

I. Performance: System shall perform in accordance with 15A NCAC 18A .1961.

II. Monitoring: System shall be monitored as required by 15A NCAC 18A .1961.

III. Maintenance: Ground absorption sewage treatment and disposal systems shall be checked, and the contents of the septic tank removed, periodically from all compartments, to ensure proper operation of the system. The contents shall be pumped whenever the solids level is found to be more than 1/3 of the liquid depth in any compartment.

IV. Operation: System shall be operated in accordance with 15A NCAC 18A .1961.

System Classification: III g

*Operation Permits for Type V and VI systems expire five (5) years from the date of issuance (in accordance with Table V(a)). The system owner must contact GWS six (6) months prior to expiration for permit renewal.

Subsurface system operator required: Yes ☐ No ☑

☐ This type of system requires the system owner to maintain a contract with a certified operator to perform system inspection, maintenance, and reporting as required in 15A NCAC 18A .1961. and Table V(a). The system owner is responsible for all fees associated with these services.

☐ System does not require inspection by GWS on a routine frequency.

☐ System requires inspection by GWS once every five (5) years. The system owner is responsible for all fees associated with the inspection.

☐ System requires inspection by GWS once every three (3) years. The system owner is responsible for all fees associated with the inspection.

☐ System requires inspection by GWS once every twelve (12) months. The system owner is responsible for all fees associated with the inspection.

☐ System requires inspection by GWS once every six (6) months. The system owner is responsible for all fees associated with the inspection.

V. *Other:*

_____

_____

_____

_____

DENR Authorized Agent: Jeremy Michael Date: 12/23/2010

Signature: Jeremy Michael