

10008 ROBINSON CHURCH RD

10815204

4/30/08

marliwr

Groundwater and Wastewater Services File Imaging Project
May 2007
Barcode Font = IDAutomationHC39M

SEPTIC FEE: _____
DATE: _____
CRT [ ]

PERMIT APPLICATION FOR A RESIDENTIAL SITE IMPROVEMENT PERMIT / CONSTRUCTION AUTHORIZATION FOR ON-SITE WASTEWATER SYSTEM NEW WELL INSTALLATION OR REPAIR OF EXISTING WELL MECKLENBURG COUNTY GROUNDWATER & WASTEWATER SERVICES

FILE # 2464A

WELL FEE: _____
DATE: _____
CRT [ ]

SEPTIC / TYPE APPLICATION: ☐ NONE ☐ NEW SYSTEM EXISTING SYSTEM: ☐ EXPANSION/ALTERATION ☑ REPAIR

WELL / TYPE APPLICATION: ☐ NONE ☐ NEW WELL ☐ MAJOR REPAIR ☐ ABANDONMENT

JOB LOCATION INFORMATION:
TAX/PARCEL #: 10815204
STREET ADDRESS: 10008 Robinson church Rd.
CITY: Charlotte, NC.
STATE: NC ZIP: 28215.
SUBDIVISION OR MOBILE HOME PARK NAME:
LOT #:
TOWNSHIP:
☑ 0-MECKLENBURG ☐ 4-PINEVILLE
☐ 1-CHARLOTTE ☐ 5-MATTHEWS
☐ 2-DAVIDSON ☐ 6-HUNTERSVILLE
☐ 3-CORNELIUS ☐ 7-MINT HILL

BUILDING INFORMATION:
TYPE OF BUILDING:
☐ SINGLE MOBILE HOME (S) ☐ MODULAR HOME (M)
☐ DOUBLE WIDE (D) ☐ MULTIPLE FAMILY (U)
☑ HOUSE (H) ☐ OTHER
HEATED SQUARE FOOTAGE:
NUMBER OF BEDROOMS:
NUMBER OF OCCUPANTS:

FOUNDATION FOR RESIDENCE:
☐ CONCRETE SLAB ☐ BASEMENT WITH PLUMBING
☑ CRAWLSPACE ☐ BASEMENT WITH NO PLUMBING

IF PLANNING TO EXPAND/ALTER THE EXISTING SYSTEM INDICATE THE FOLLOWING CHANGES:
NUMBER OF BEDROOMS TO BE ADDED: NUMBER OF ADDITIONAL OCCUPANTS IN THE RESIDENCE:
WILL THERE BE A HOME BUSINESS IN THE RESIDENCE? ☐ YES ☑ NO TYPE:

WATER SUPPLY:
☐ MUNICIPAL (M) ☐ PUBLIC (C) ☑ PRIVATE WELL (P) ☐ SHARED WELL (S) ☐ OTHER 'SPRINGS' (O)

PROPOSED USE OF WELL: ☐ N/A ☐ IRRIGATION ☐ POTABLE ☐ GEOTHERMAL ☐ OTHER

ARE ANY OF THE FOLLOWING LOCATED ON THE PROPERTY? IF SO, PLEASE SHOW LOCATION ON SITE PLAN/PLAT.

BURIED CABLES, LANDFILLS, STUMPHOLES	☐ YES	☒ NO	WELLS, SPRINGS, OR WATER LINES	☐ YES	☒ NO
EXISTING WASTEWATER SYSTEMS	☐ YES	☒ NO	DESIGNATED WETLANDS	☐ YES	☒ NO
EASEMENTS OR RIGHT-OF-WAYS	☐ YES	☒ NO	GRADING/SOIL REMOVAL PERFORMED	☐ YES	☒ NO

PROPERTY OWNER:
NAME: Ruben Torres.
ADDRESS: 10008 Robinson church Rd.
CITY: Charlotte
STATE: NC ZIP: 28215.
HOME PHONE: 704-568-2418 WORK PHONE:
MOBILE PHONE: 704-634-8456 FAX:

LEGAL AGENT FOR PROPERTY OWNER, IF APPLICABLE:
NAME: Jose L. Fuentes
ADDRESS: 9849 Drawbridge Dr.
CITY: Charlotte.
STATE: NC ZIP: 28215.
HOME PHONE: 704-569-9192 WORK PHONE:
MOBILE PHONE: FAX:

WHAT DATE WAS THE PROPERTY ORIGINALLY DEEDED AND RECORDED?
WHAT IS THE ANTICIPATED CLOSING DATE FOR THIS PROPERTY?

*An Improvement Permit is subject to suspension or revocation if site plans or the intended use change or if information submitted in this application is falsified or changed. The undersigned, owner, or legal agent for the owner, of the property described above as the "Job Location" has read the foregoing application, acknowledges that the contents of same are true, and authorizes the Mecklenburg County Health Department to enter onto the property for the purpose of processing this request.

Mario Torres 5-13-05
Owner's/Agent's Signature Date

NORTH CAROLINA DEPARTMENT OF
ENVIRONMENT & NATURAL RESOURCES DIVISION
OF ENVIRONMENTAL HEALTH ON-SITE
WASTEWATER SECTION

*A Well Permit is subject to suspension or revocation if site plans or the intended use change or if information submitted in this application is falsified or changed. The undersigned, owner, or legal agent for the owner, of the property described above as the "Job Location" has read the foregoing application, acknowledges that the contents of same are true, and authorizes the Mecklenburg County Health Department to enter onto the property for the purpose of processing this request.

Owner's/Agent's Signature Date

MECKLENBURG COUNTY HEALTH DEPARTMENT
GROUNDWATER & WASTEWATER SERVICES
700 N. TRYON ST., SUITE 211
CHARLOTTE, NC 28202
704-336-5103 / FAX: 704-336-6894


PROPOSED PLOT PLAN

HEALTH DEPARTMENT
ENVIRONMENTAL HEALTH DIVISION
700 NORTH TRYON ST., SUITE 211
CHARLOTTE, NC 28202
PHONE (704) 336-5103

FILE: _____

TC: _____

Draw in and name all roads adjoining the property. Draw in and accurately dimension the lot concerned. Accurately indicate property boundaries proposed and/or existing structures and driveways, underground utilities, and wells and springs within 100 feet of the proposed building or drainfield.

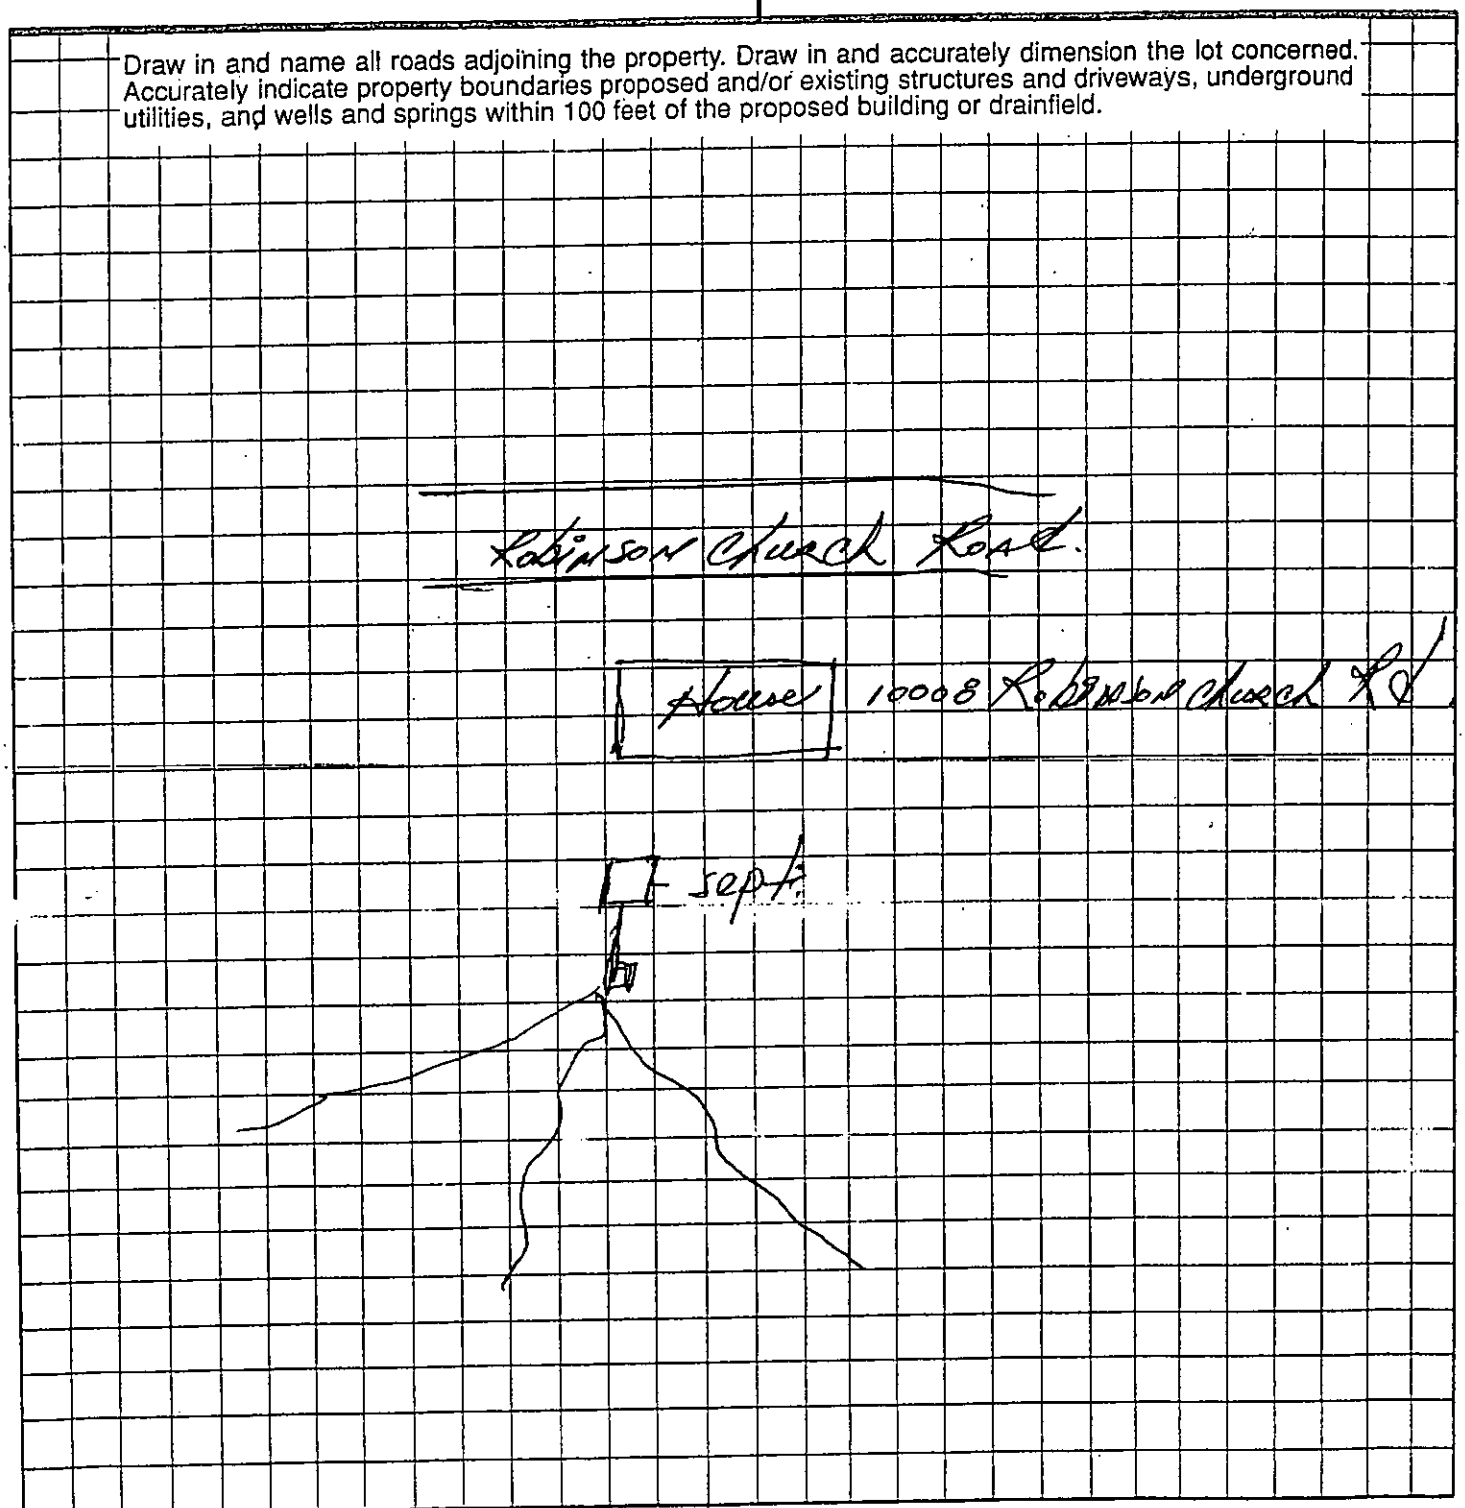

OWNER/AGENT SIGNATURE

DATE

APPROVAL DATE _____

White - Health Department's Copy

Canary - E.H.S. Copy

Pink - Owner's Copy

2400 4pc

INDIVIDUAL WATER AND WASTEWATER SYSTEMS PROGRAM
APPLICATION FOR SERVICES

Pd $30 3/7/94 Ck #1954

2464A

X CRT

Mecklenburg County Health Dept.
Environmental Health Division
c/o Hal Marshall Ctr., Suite 211
700 N. Tryon St.
Charlotte, NC 28202

(704)336-5102

PERSON FILING APPLICATION:
X NAME: Freeman (last) David (first) W. (mi)
ADDRESS: 10008 Robinson CH Rd PHONE: (704) 568-2062
CITY: Charlotte STATE: NC ZIPCODE: 28215

Date:

PROPERTY OWNER:
X NAME: same as above (last) (first) (mi)
ADDRESS: _____ PHONE: (___) _____
CITY: STATE: ZIPCODE:

PROPERTY INFORMATION (FROM ENGINEERING FORM):
X TAX/PARCEL NUMBER: 108-152-04
STREET ADDRESS: 10008 Robinson Church Rd
ZONING:

Township (check one):
[X] 0 Mecklenburg County [ ] 2 Davidson [ ] 4 Pineville [ ] 6 Huntersville
[ ] 1 Charlotte [ ] 3 Cornelius [ ] 5 Matthews [ ] 7 Mint Hill

SUBDIVISION OR MOBILE HOME PARK NAME:

LOT NUMBER: LOT SIZE (in acres):

TYPE APPLICATION (check one):

[ ] SOIL TEST - INDIVIDUAL LOT (D)
[ ] NEW CONSTRUCTION ON VACANT LOT - 4 BEDROOMS OR LESS (N)
[ ] EXCHANGE MOBILE HOME - SAME # BEDROOMS (Y)
[ ] ADDITION - INCREASE ROOMS/OCCUPANCY/MOBILE HOME SIZE (A or M)
[ ] COMMERCIAL OR INDUSTRIAL (N)
[ ] SOIL TEST DEVELOPMENT (P)
[X] ADDITION - GARAGE OR RENOVATION/NO MAJOR CHANGES (X) carport - detached
[ ] MODIFIED ALTERNATIVE/ OR RESIDENCE > 4 BEDROOMS (Z)
[ ] REPAIR TO SYSTEM (R)

RESIDENTIAL PROPERTY (Type Building, check one):
X [ ] SINGLE MOBILE HOME (S) [ ] HOUSE (H) [ ] MULTIPLE FAMILY (U)
[ ] DOUBLE WIDE (D) [ ] MODULAR HOME (M) [X] OTHER _____ (O)

NUMBER BEDROOMS: 3 NUMBER OCCUPANTS:

SYSTEM CLASSIFICATION:

COMMERCIAL/INDUSTRIAL PROPERTY:
Type Business _____ # Employees ___ Per Shift ___ ___ ___
Industrial Wastes (Y/N) ___
Underground Storage Tanks On Property (Y/N) ___ Type _____

WATER SUPPLY (check one):
[ ] Community (C) [ ] Shared Well (S)
[ ] Municipal (M) [ ] Other 'spring' (O)
X [X] Private Well (P)

FUTURE ADDITIONS - ALL PLANNED ADDITIONS MUST BE ENTERED (check all that apply):
[ ] Swimming Pool [ ] Jacuzzi [ ] Stable/Barn [ ] Workshop [ ] None
[ ] Garage [ ] Storage Building [ ] Deck/Patio [ ] Bedrooms [ ] Other

The undersigned, owner, or legal agent for the owner, of the property described above as the "JOB LOCATION" has read the foregoing application, acknowledges that the contents of same are true, and authorizes agents of the MECKLENBURG COUNTY HEALTH DEPARTMENT to enter onto the property for the purpose of processing this request.

Signed: David W. Freeman Date: X 3/17/94

NOTICE:

The undersigned, an authorized agent of the MECKLENBURG COUNTY HEALTH DEPARTMENT, certifies that the Department has approved the Request for the Job Location contained in this document. This approval is granted in accordance with the provisions of Laws And Rules For Sanitary Sewage Collection, Treatment And Disposal in effect at the time of issuance of the permit and is subject to the following provisions:

...No work shall be conducted on the septic tank system until an installation, Construction, Alteration and/or Repair approval is granted by this Department.

...This permit is not transferable.

...Keep proposed bldg. foundation min 5' from any part of septic tank system. Footing poured at time of visit and back right corner of footing must be revised to be the min 5' from septic tank system See plan.

[ ] IMPROVEMENT PERMIT - VALID 60 MONTHS FROM ISSUANCE
[ ] MOBILE HOME EXCHANGE APPROVAL - VALID 6 MONTHS FROM ISSUANCE
[ ] ADDITION/RENOVATION APPROVAL - VALID 1 YEAR FROM ISSUANCE

Susan Patterson 3-31-94
Environmentalist Date

P. Walker for S. Daniel 4/5/94
Director or Authorized Section Head Date

WWATER : 122791


PROPOSED PLOT PLAN

HEALTH DEPARTMENT
ENVIRONMENTAL HEALTH DIVISION
700 NORTH TRYON STREET
CHARLOTTE, NC 28202
PHONE (704) 336-5102

FILE: 2464A

TC: 108-152-04

Draw in and name all roads adjoining the property. Draw in and accurately dimension the lot concerned. Accurately indicate property boundaries, proposed and/or existing structures and driveways, underground utilities, and wells and springs within 100 feet of the proposed building or drainfield.

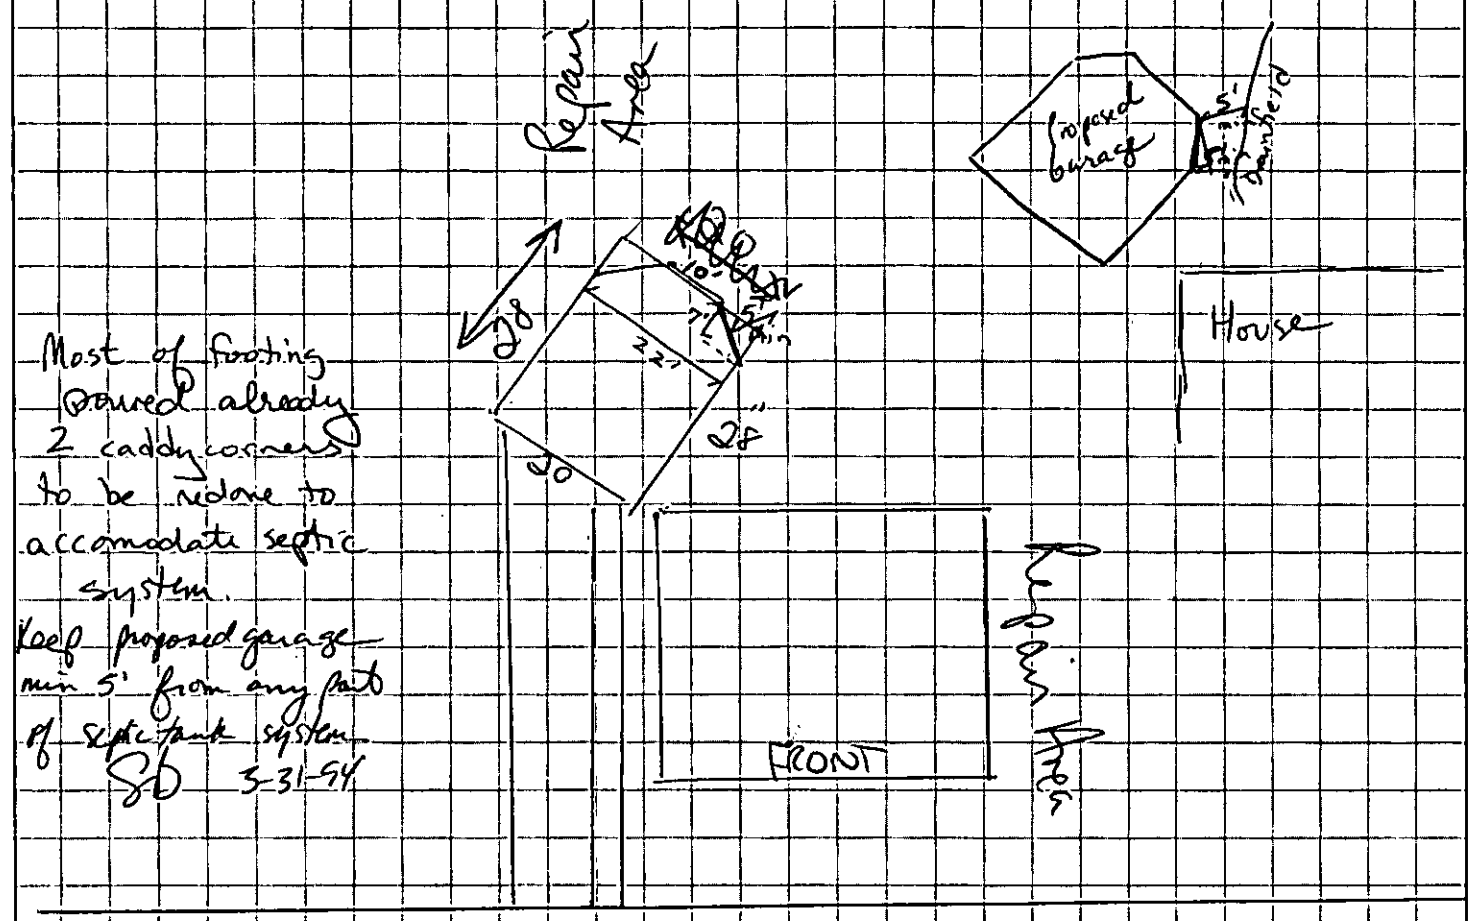

Most of footing poured already
2 caddy corners to be redone to accomodate septic system.
Keep proposed garage min 5' from any part of septic tank system
SD 5-31-94

ROBINSON CHURCH RD 100081

APPROVAL DATE _____

White - Health Department's Copy Canary - Environmentalist's Copy Pink - Owner's Copy

DATE 2/24/94

TO: CHARLOTTE-MECKLENBURG BUILDING STANDARDS
PERMIT ISSUING SECTION

FROM: MECKLENBURG COUNTY ENGINEERING

JURISDICTION Mck

108-152-04
PARCEL NUMBER

10008 Robinson Church Rd
ASSIGNED STREET ADDRESS (ADDRESS OF RECORD)

EXISTING STREET ADDRESS (IF DIFFERENT FROM ASSIGNED)

JA
PROJECT NAME (IF APPLICABLE)

THE ABOVE DESCRIBED LOCATION HAS BEEN CHECKED CONCERNING:

1. SUBDIVISION REGULATIONS	**APPROVED**	**NOT APPROVED**
2. FLOODWAY REGULATIONS	**APPROVED**	**NOT APPROVED**
3. WATERSHED PROTECTION	**APPROVED**	**NOT APPROVED**
4. COMMERCIAL DRAINAGE PLAN	**APPROVED**	**NOT APPROVED**
5. PUBLIC UTILITY EASEMENT	**PRESENT**	**NOT PRESENT**
6. PROPERTY FRONTS ON THOROUGHFARE	**YES**	**NO**
7. DRIVEWAY PERMIT REQUIRED	**YES**	**NO**
8. DOES PROJECT CONFLICT WITH ROAD PROJECT?	**YES**	**NO**

REMARKS: Carport (detached)

NOTE: THIS FORM MUST BE TURNED IN AT THE CASHIERS OFFICE WHEN PAYING PERMIT FEE. CERTIFICATE OF OCCUPANCY WILL NOT BE GRANTED UNTIL TRANSPORTATION DIVISION GRANTS FINAL APPROVAL ON DRIVEWAY(S).

ALL OTHER FORMS OBSOLETE

☐ NEW ADDRESS

SIGNED: Ponce

REVISED 1/91

No Alteration necessary

Refund $100.00

Ask Sly, Jim worked on this

No extra bedroom

uxs will remain 3 bdrm

No change in outside area of house with ~~enclosing~~ changing the garage to family room. See survey with house on it.

The (proposed placement) footing for a future detached garage. (application not made for this item) not approvable.

Mecklenburg County
Health Department

Betty S. Snow, R.N., M.A.
Health Director

M E M O R A N D U M

TO: Susan Uzzell
Accountant II

FROM: Sylvia D. Daniel, R.S.
Program Chief

Date: December 3, 1993

Ref: 2464A/10008 Robinson Church Road

SUBJECT: Refund

(Mr./Mrs./Co.) Mr. David Freeman originally paid $150.00

for a permit to do an alteration on septic system on November 19, 1993

.

A refund should be issued for $100.00 because

No alteration will be done, house will remain 3 bedrooms, all work to be contained within existing structure.

Please make check payable to: David Freeman

10008 Robinson Church Road

Charlotte, NC 28215

INDIVIDUAL WATER AND WASTEWATER SYSTEMS PROGRAM
APPLICATION FOR SERVICES

2464A

Pd 150.00 11/19/93 DT CK# 1804 [ ] CRT

Mecklenburg County Health Dept.
Environmental Health Division
c/o Hal Marshall Ctr., Suite 211
700 N. Tryon St.
Charlotte, NC 28202

(704)336-5102

Date:

PERSON FILING APPLICATION:
NAME: FREEMAN (last) DAVID (first) N (mi)
ADDRESS: 10008 ROBINSON CHURCH RD PHONE: (704) 568202
CITY: Charlotte STATE: ZIPCODE: 28215

PROPERTY INFORMATION (FROM ENGINEERING FORM):
TAX/PARCEL NUMBER: 108-152-04
STREET ADDRESS: 10008 ROBINSON CHURCH RD
ZONING:

PROPERTY OWNER:
NAME: SAME (last) (first) (mi)
ADDRESS: PHONE: (__) __
CITY: STATE: ZIPCODE:

SUBDIVISION OR MOBILE HOME PARK NAME:

Township (check one):
[ ] 0 Mecklenburg County [ ] 2 Davidson [ ] 4 Pineville [ ] 6 Huntersville
[ ] 1 Charlotte [ ] 3 Cornelius [ ] 5 Matthews [ ] 7 Mint Hill

LOT NUMBER: 3 LOT SIZE (in acres):

TYPE APPLICATION (check one):
[ ] SOIL TEST - INDIVIDUAL LOT (D)
[ ] NEW CONSTRUCTION ON VACANT LOT - 4 BEDROOMS OR LESS (N)
[ ] EXCHANGE MOBILE HOME - SAME # BEDROOMS (Y)
[ ] ADDITION - INCREASE ROOMS/OCCUPANCY/MOBILE HOME SIZE (A or M)
[ ] COMMERCIAL OR INDUSTRIAL (N)
[ ] SOIL TEST DEVELOPMENT (P)
[X] ADDITION - GARAGE OR RENOVATION/NO MAJOR CHANGES (X)
[ ] MODIFIED /ALTERNATIVE/ OR RESIDENCE > 4 BEDROOMS (Z)
[ ] REPAIR TO SYSTEM (R)

Converting Garage to Bedroom

RESIDENTIAL PROPERTY (Type Building, check one):
[ ] SINGLE MOBILE HOME (S) [X] HOUSE (H) [ ] MULTIPLE FAMILY (U)
[ ] DOUBLE WIDE (D) [ ] MODULAR HOME (M) [ ] OTHER _____ (O)

NUMBER BEDROOMS: 3 NUMBER OCCUPANTS:
SYSTEM CLASSIFICATION:

COMMERCIAL/INDUSTRIAL PROPERTY:
Type Business _____ # Employees ___ Per Shift ___ ___ ___
Industrial Wastes (Y/N) ___
Underground Storage Tanks On Property (Y/N) ___ Type _____

WATER SUPPLY (check one):
[ ] Community (C) [ ] Shared Well (S)
[ ] Municipal (M) [ ] Other 'spring' (O)
[X] Private Well (P)

FUTURE ADDITIONS - ALL PLANNED ADDITIONS MUST BE ENTERED (check all that apply):
[ ] Swimming Pool [ ] Jacuzzi [ ] Stable/Barn [ ] Workshop [ ] None
[ ] Garage [ ] Storage Building [ ] Deck/Patio [ ] Bedrooms [ ] Other

The undersigned, owner, or legal agent for the owner, of the property described above as the "JOB LOCATION" has read the foregoing application, acknowledges that the contents of same are true, and authorizes agents of the MECKLENBURG COUNTY HEALTH DEPARTMENT to enter onto the property for the purpose of processing this request.

Signed: [signature] Date: 11/19/93

NOTICE:

The undersigned, an authorized agent of the MECKLENBURG COUNTY HEALTH DEPARTMENT, certifies that the Department has approved the the Request for the Job Location contained in this document. This approval is granted in accordance with the provisions of Laws And Rules For Sanitary Sewage Collection, Treatment And Disposal in effect at the time of issuance of the permit and is subject to the following provisions:

...No work shall be conducted on the septic tank system until an installation, Construction, Alteration and/or Repair approval is granted by this Department.

...This permit is not transferable.

[ ] IMPROVEMENT PERMIT - VALID 60 MONTHS FROM ISSUANCE
[ ] MOBILE HOME EXCHANGE APPROVAL - VALID 6 MONTHS FROM ISSUANCE
[ ] ADDITION/RENOVATION APPROVAL - VALID 1 YEAR FROM ISSUANCE

[signature]
Environmentalist 12-8-93 Date

Director or Authorized Section Head Date

...Application changed to converting garage to a family room - House to stay a 3 bedroom house. Therefore use existing system. No change in outside dimensions of house therefore septic system check irrelevant. See plans submitted.


(A Footing had been poured for a future detached garage and that footing cannot be approved due to closeness of septic system)

WWATER : 122791

COPY

THIS IS TO CERTIFY THAT ON THE 25th DAY OF Sept. 1987 I, SURVEYED THE PROPERTY SHOWN ON THIS PLAT, AND THAT THE TITLE LINES AND THE WALLS OF THE BUILDINGS IF ANY ARE SHOWN HEREON.

SIGNED Jack R. Chrisco
REGISTERED SURVEYOR

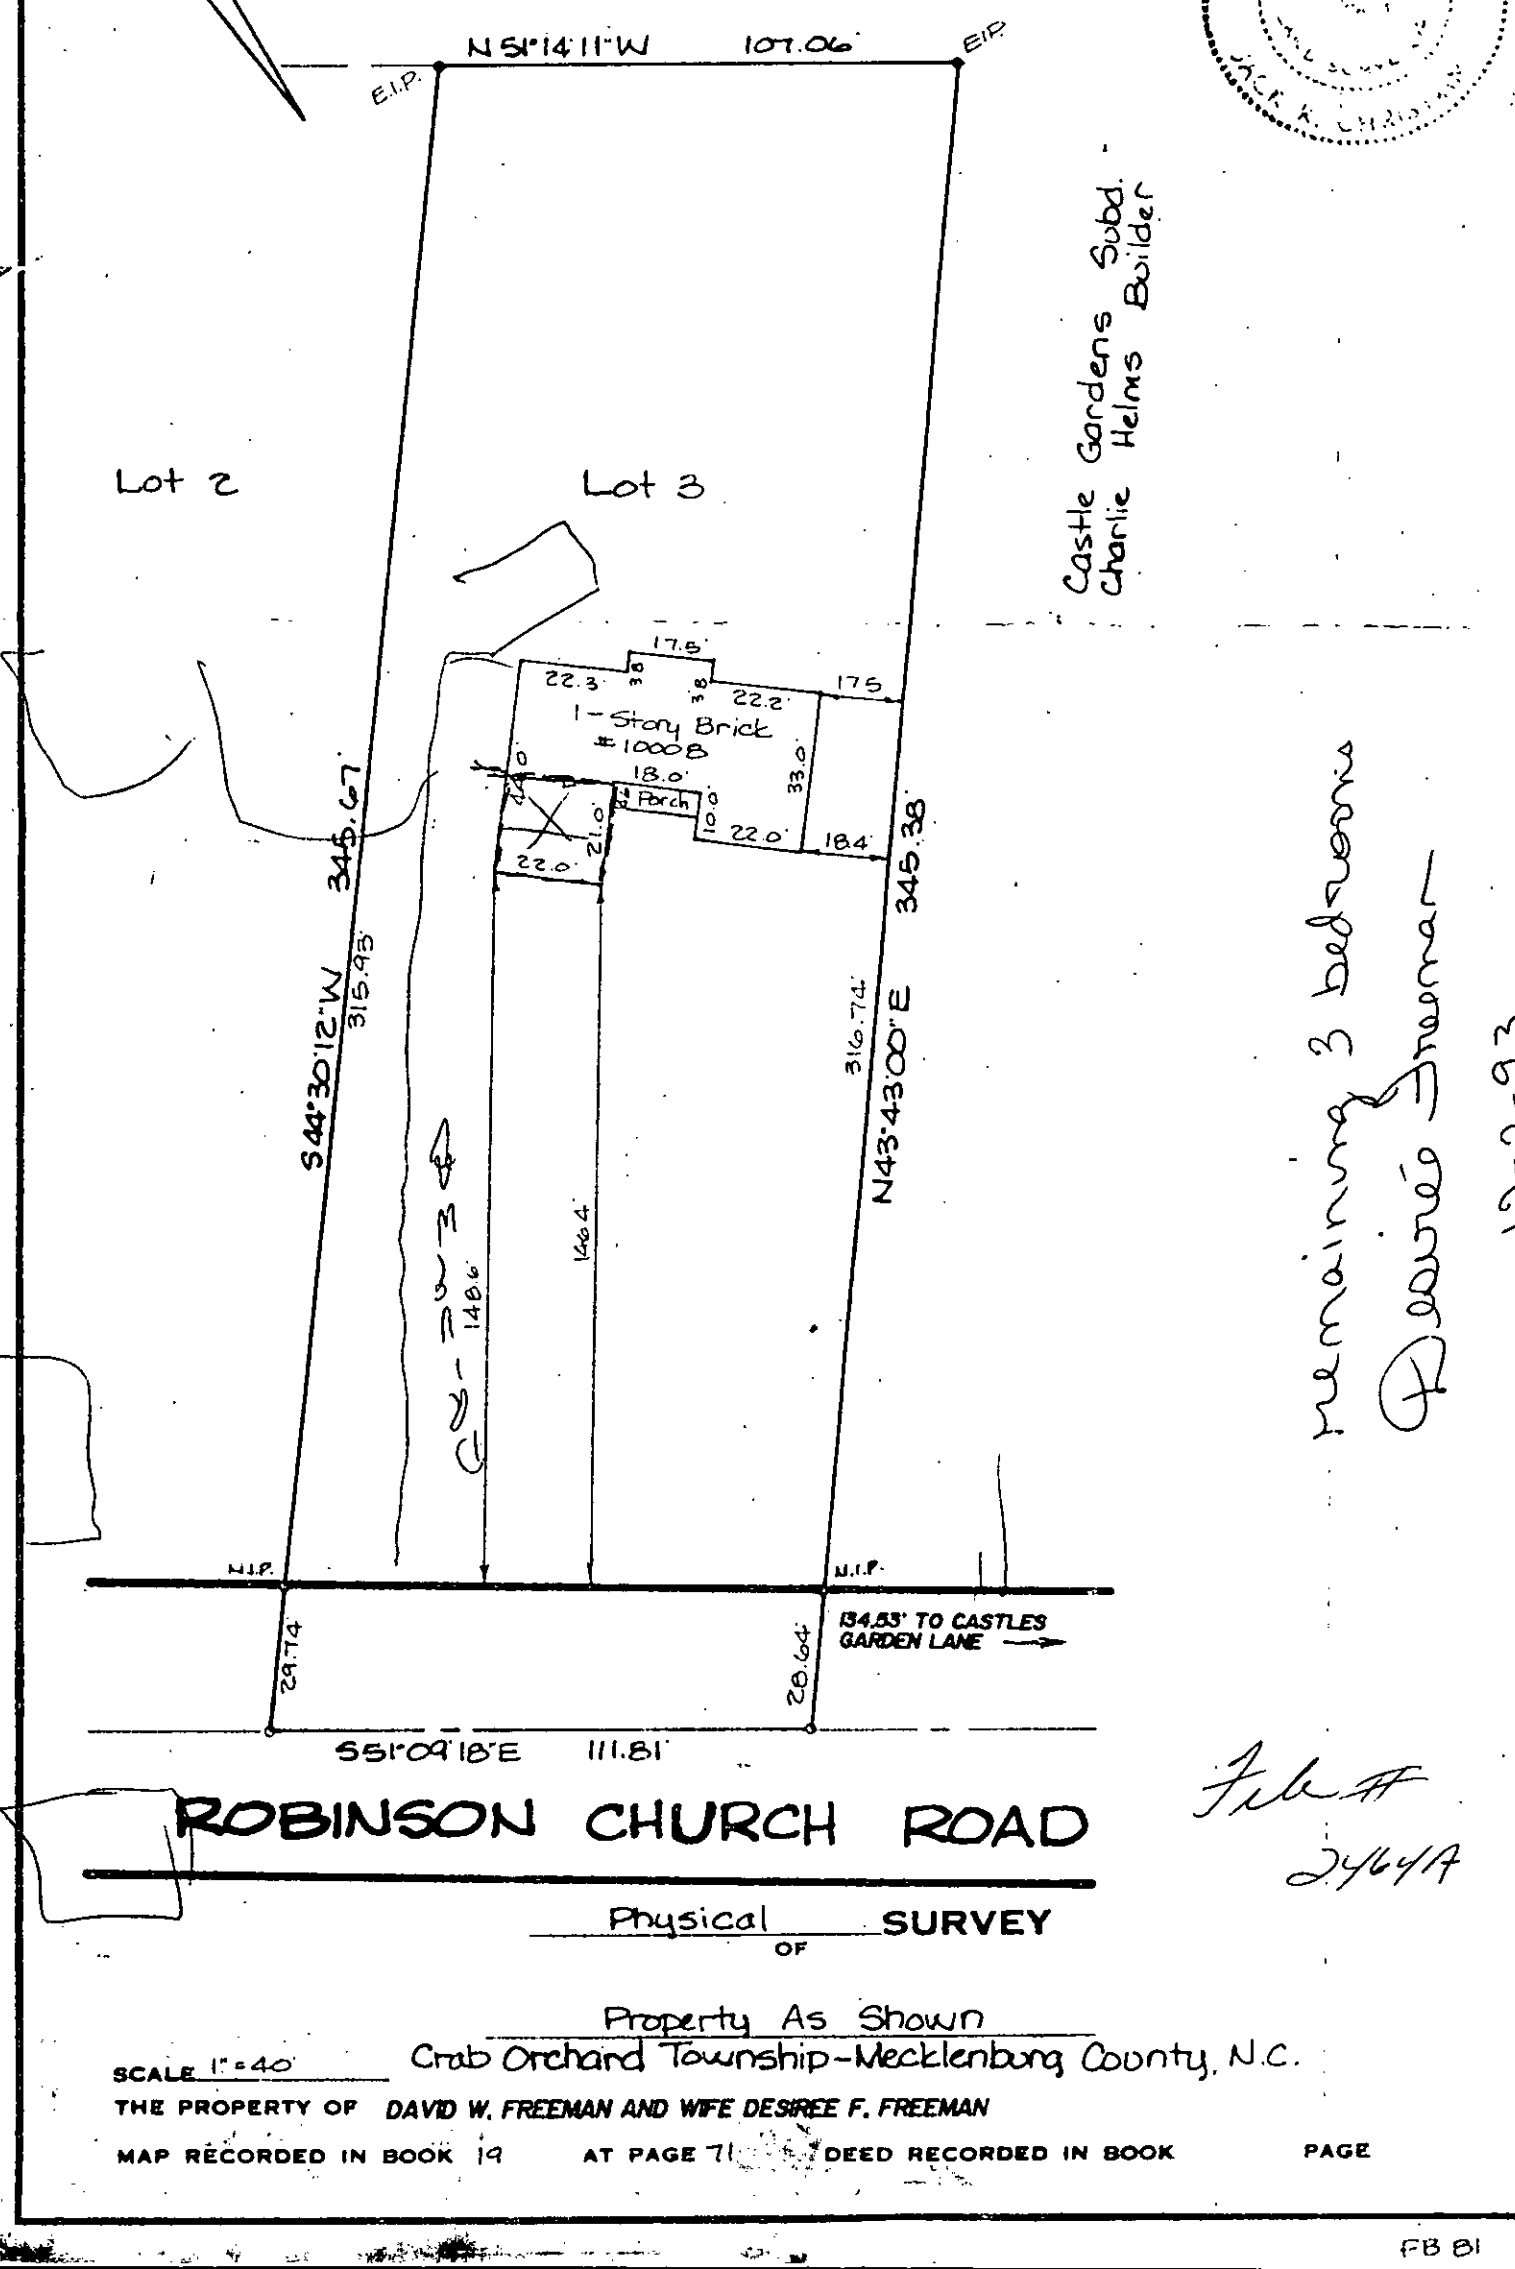

ROBINSON CHURCH ROAD

Physical SURVEY
OF

Property As Shown
Crab Orchard Township-Mecklenburg County, N.C.

SCALE 1" = 40'

THE PROPERTY OF *DAVID W. FREEMAN AND WIFE DESIREE F. FREEMAN*

MAP RECORDED IN BOOK 19 AT PAGE 71 DEED RECORDED IN BOOK PAGE

Castle Gardens Subd.
Charlie Helms Builder

Remains 3 bedrooms

12-2-93


Filed
2464

FB 81

THIS IS TO CERTIFY THAT ON THE 25th DAY OF Sept. 1987 I, SURVEYED THE PROPERTY SHOWN ON THIS PLAT. AND THAT THE TITLE LINES AND THE WALLS OF THE BUILDINGS IF ANY ARE SHOWN HEREON.

SIGNED Jack R. Christian
REGISTERED SURVEYOR

NORTH CAROLINA
SEAL
L-2624
JACK R. CHRISTIAN

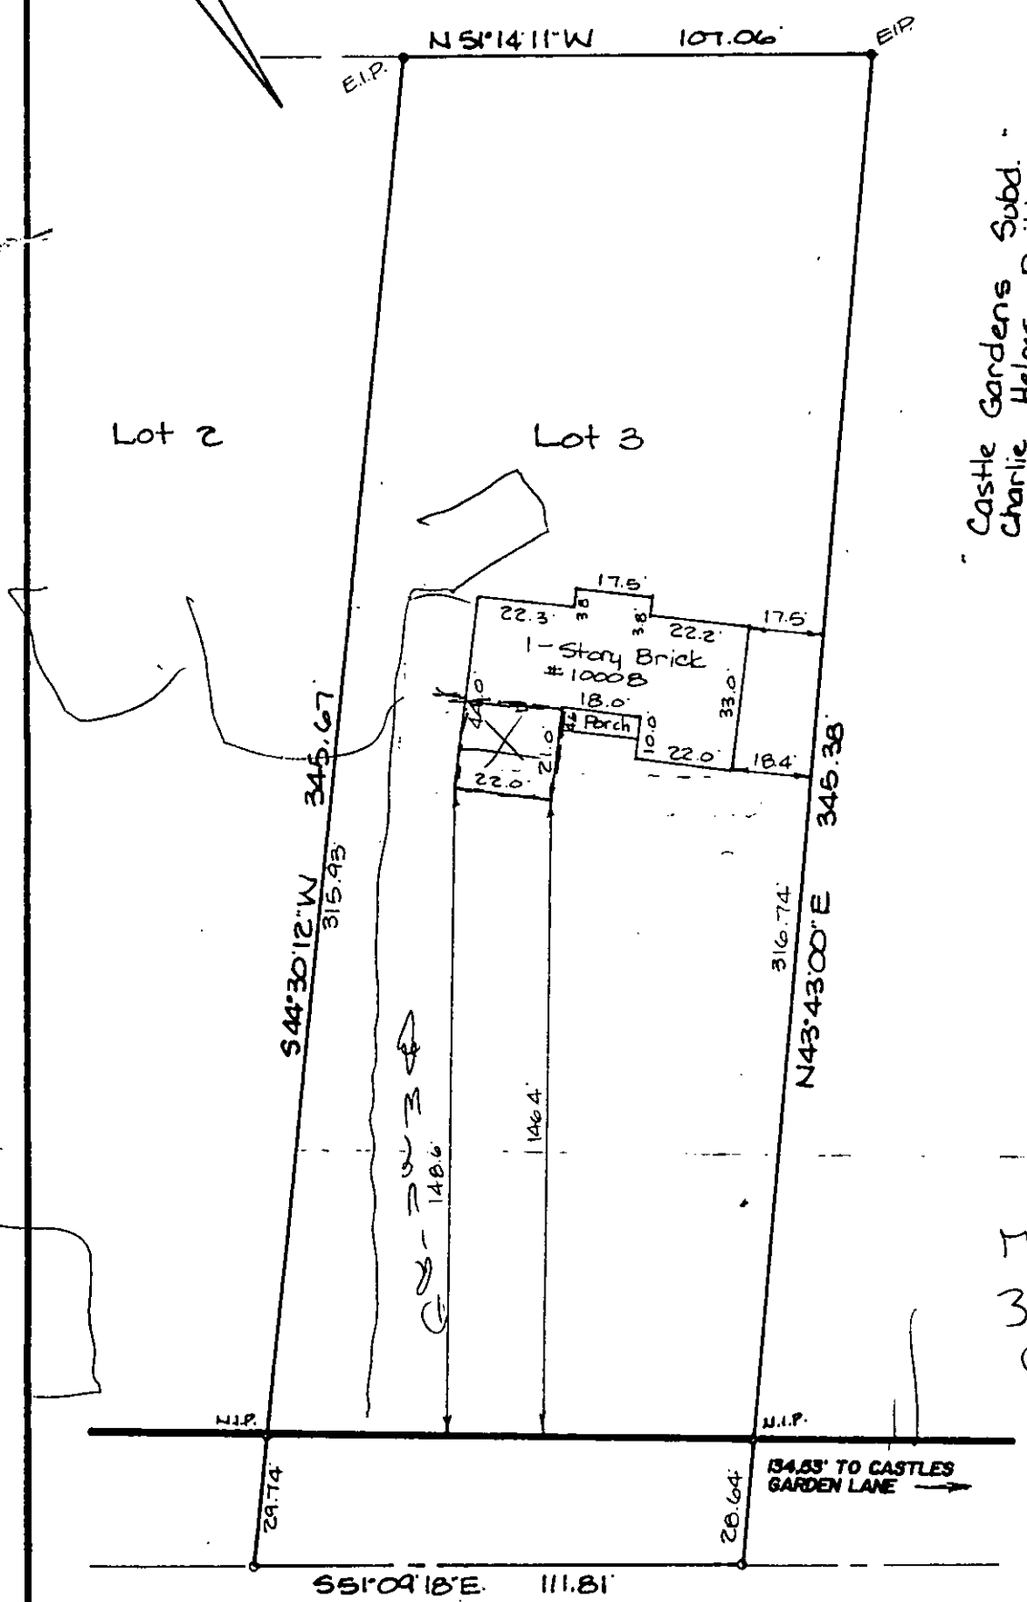

remaining
3 bedroom
Desiree Freeman
12-2-93

Physical SURVEY
OF

Property As Shown
Crab Orchard Township - Mecklenburg County, N.C.


SCALE 1" = 40'


THE PROPERTY OF DAVID W. FREEMAN AND WIFE DESIREE F. FREEMAN

MAP RECORDED IN BOOK 19 AT PAGE 71 DEED RECORDED IN BOOK PAGE

Filed
2464

FB. 81

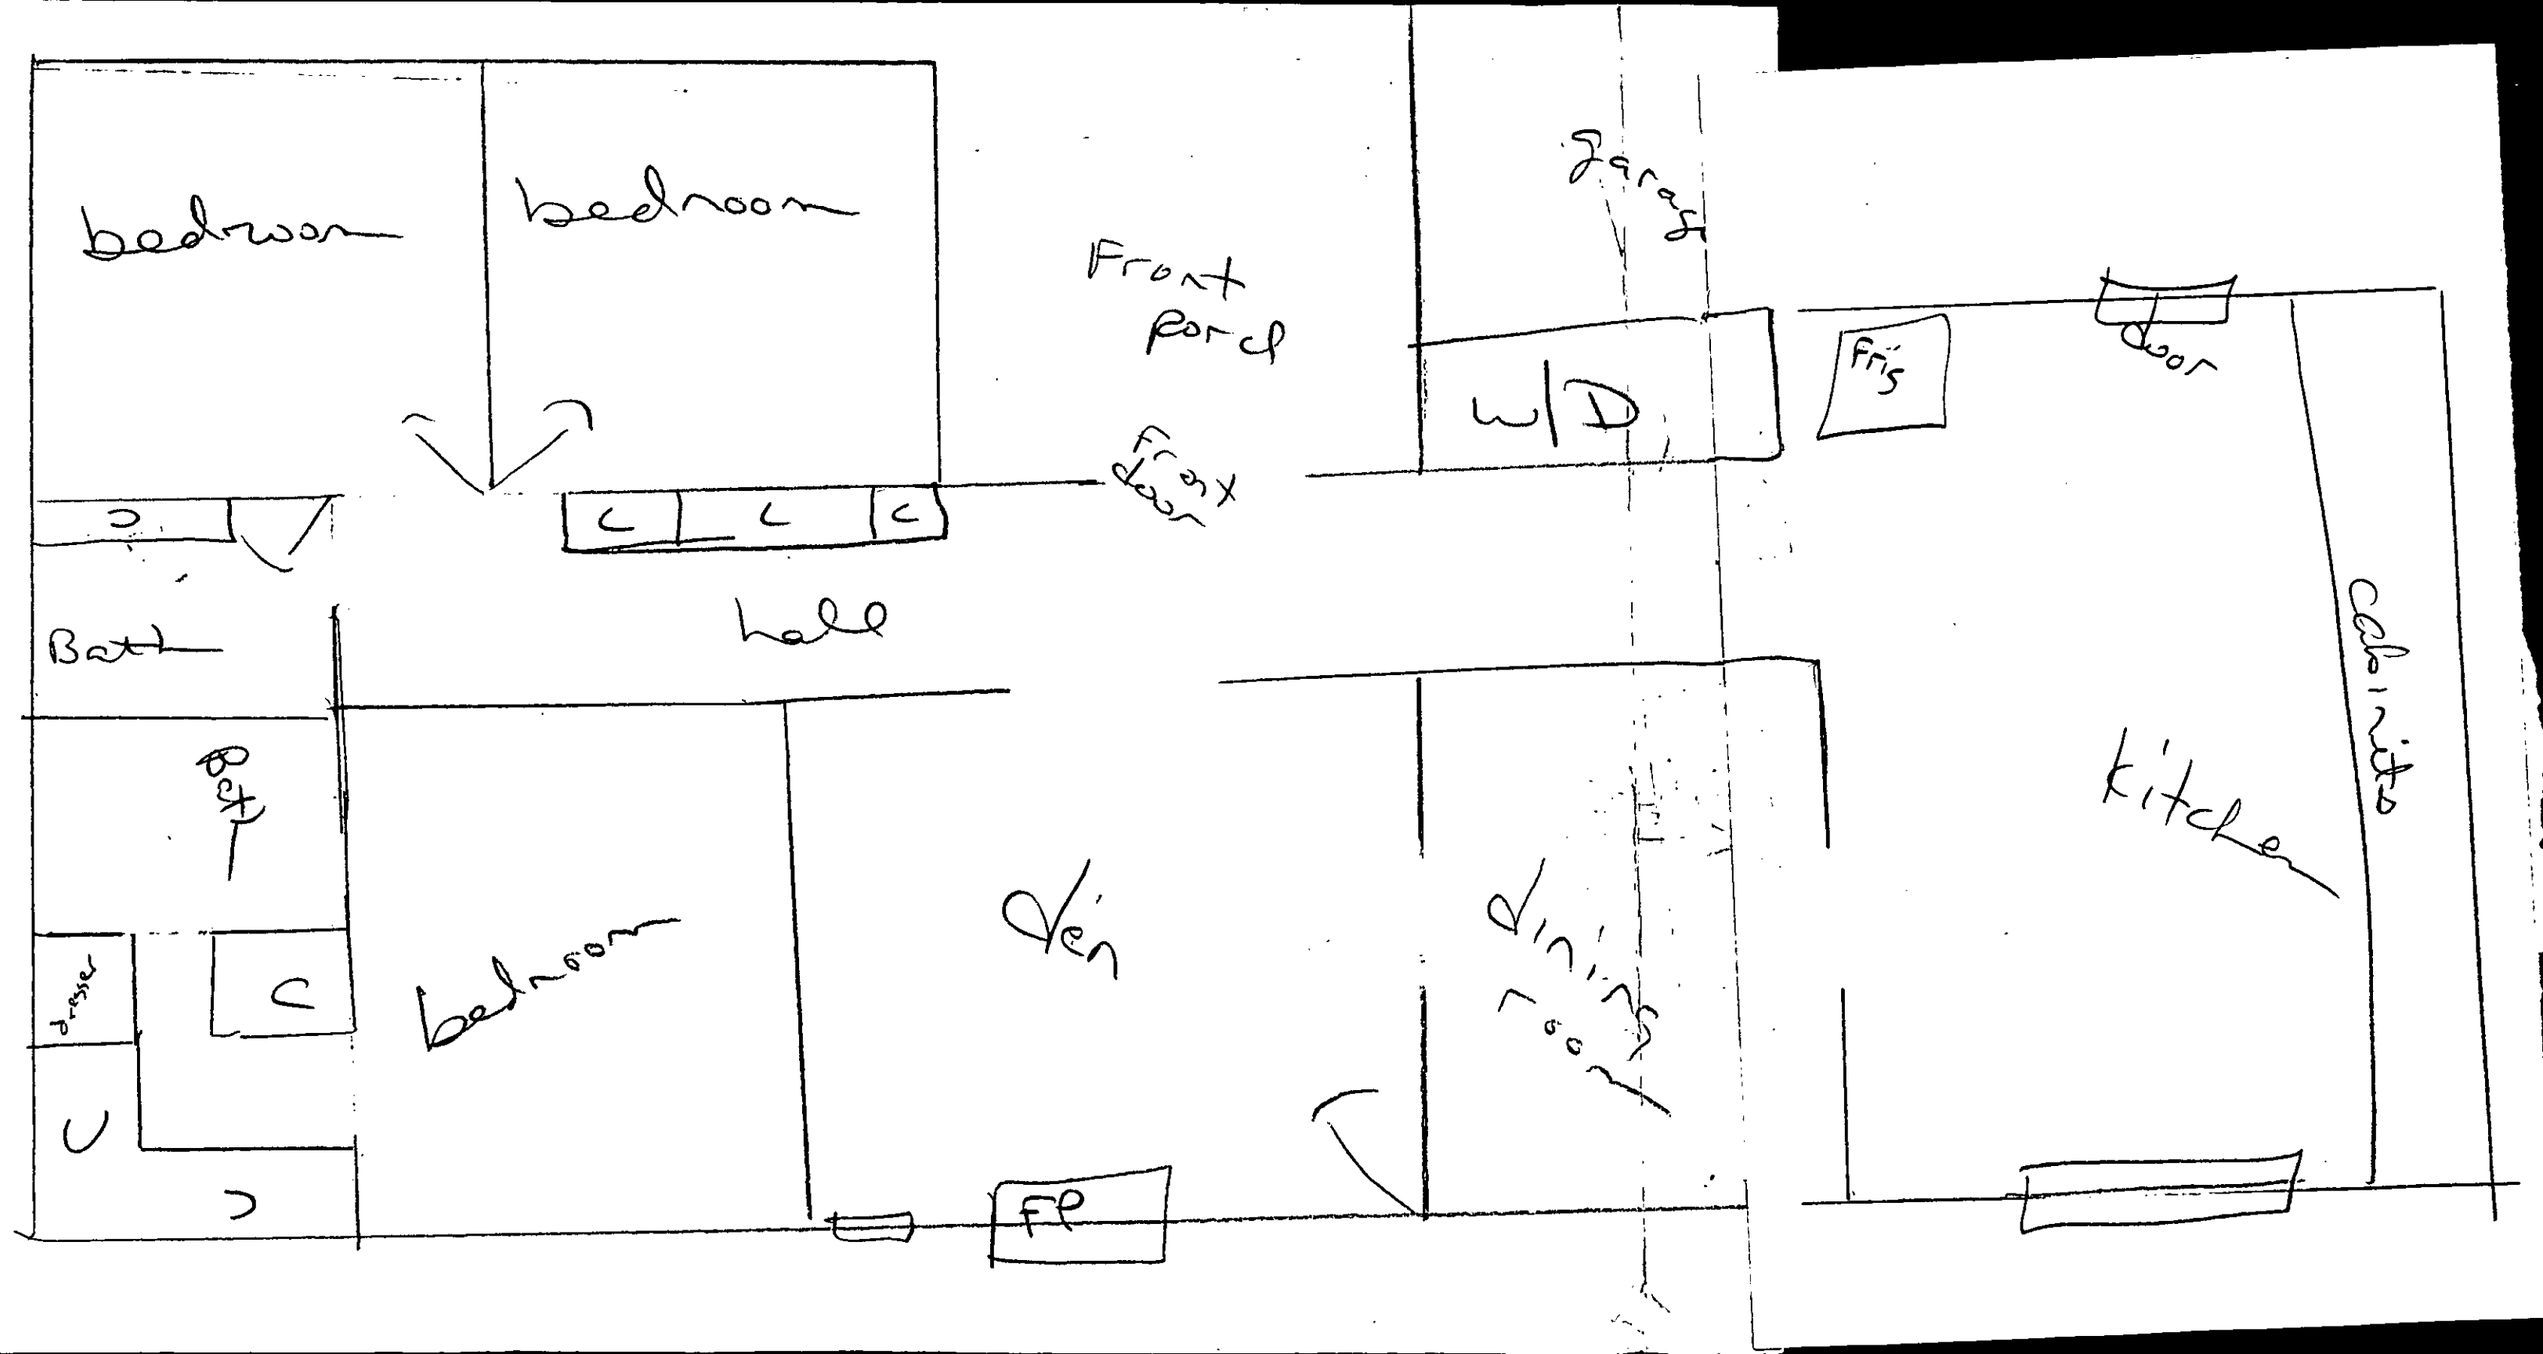
bedroom
bedroom
Front porch
Garage
W/D
Fris
Door
Front Door
C
C
C
Hall
Bath
Cabinets
Bath
kitchen
Den
Dining room
C
dresser
bedroom
FP

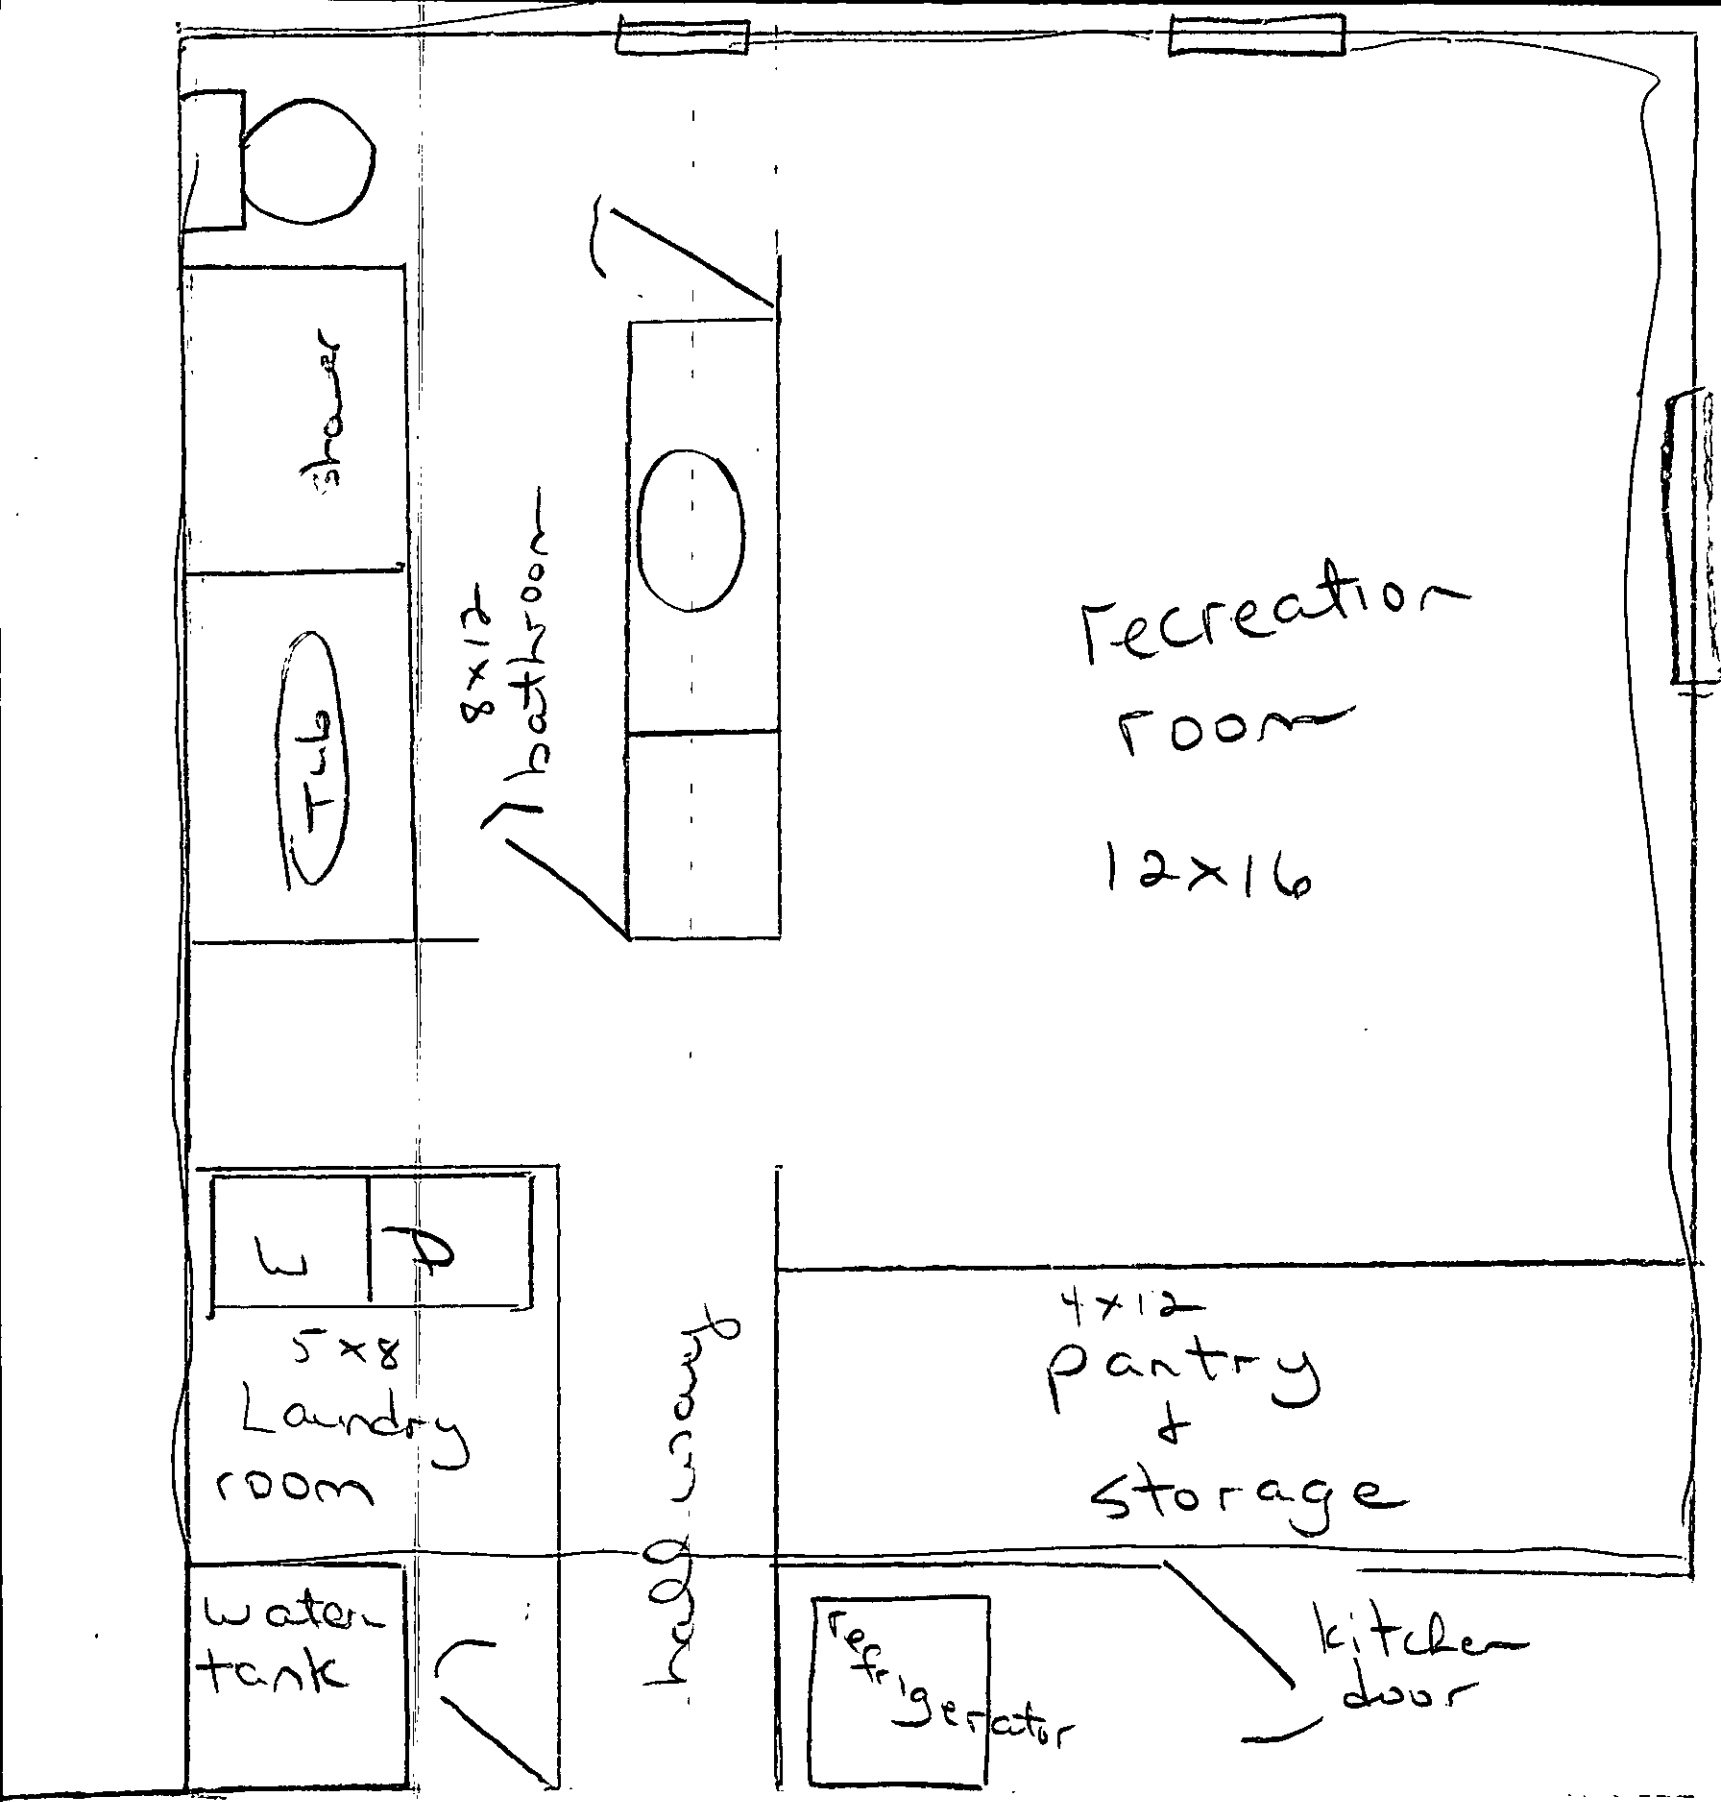
shower
Tub
8x12
bathroom
Recreation
room
12x16
L
P
5x8
Laundry
room
4x12
pantry
&
storage
water
tank
refrigerator
kitchen
door
inside house
hall way
dining
room
kitchen
revised
plan submitted
12-2-93
by Mrs. Freeman.

CERTIFICATE OF COMPLETION/OPERATION PERMIT

MECKLENBURG COUNTY ENVIRONMENTAL HEALTH
1200 BLYTHE BOULEVARD
CHARLOTTE, NC 28203
PHONE (704) 376-4603

FILE: 2464-A DATE: 10-8-87
PO
TC: 108-101-07 ☐ L ☑ CRT
SERIAL № 10604

Name of Owner W.K. Gladden Co. Juris.:
Address of Property 10008 Robinson Church Rd.

Inspection Data:

Tank Material Tcc
Total Length of Drainfield 400'
Number of Lines 4 @ 100'
Cover Depth 18"-24"
Water Supply Source well
Distance to Water Source > 50'
Excavation Inspected 10-8-87
Tank(s) Inspected 10-8-87
Wash Line Inspected
High Water Alarm Inspected

PLOT

Design: 1987, 1600ST, 2BR, 1200SFT, 12", cecil CTR# 103

The undersigned has inspected the Septic Tank System described above, and certifies it has been
☑ installed or constructed ☐ altered or repaired
☑ in accordance with the permit issued ☐ as detailed in the plot above
and meets the provisions of 10 NCAC 10A .1900, "Laws And Rules For Sanitary Sewage Collection, Treatment, And Disposal" in effect on the date of issuance of the permit. The issuance of this
☑ Certificate of Completion ☐ Operation Permit
does not in any way guarantee that the system will operate properly or relieve any person now or hereafter owning, controlling, or using such system from any liability resulting from the failure of the system to operate properly. This document is issued subject to those restrictions and conditions shown on the permit(s) and the provisions of 10 NCAC 10A .1900 in addition to those listed below under "COMMENTS." This document shall be null and void if any information contained in the application is untrue or if any additions are made to the property which would increase the requirements for said system.

COMMENTS:

D.R. Ferguson
Environmentalist


Mecklenburg County services are available without regard to ethnic origin, sex, or disability.

INSTALLATION, CONSTRUCTION, ALTERATION, AND/OR REPAIR PERMIT

1200 BLYTHE BOULEVARD
CHARLOTTE, NC 28203
PHONE (704) 376-4603

FILE: 2464-A DATE: 10-1-87
TC: 108-101-07 ☐ L
SERIAL № 11308

Permission is hereby given to ✓ Install or Construct, _____ Alter or Repair the individual septic tank wastewater treatment system with subsurface, soil absorption, effluent discharge as specified herein at the described location. This permit is granted based upon the information supplied in the application dated 11-12-86. All work shall be completed on or before 10-1-87, after which date this permit shall be null and void. The system shall meet all of the construction requirements of 10 NCAC 10A .1900 which are in effect on the date of the granting of this permit. A Certificate of Completion or an Operation Permit must be obtained from the Mecklenburg County Department of Environmental Health before any system can be covered up or placed into service. The issuance of this permit does not in any way guarantee that the system anticipated to be constructed will operate properly, or relieve any person now or hereafter owning, controlling or using such system from any liability resulting from the failure of the system to operate properly.

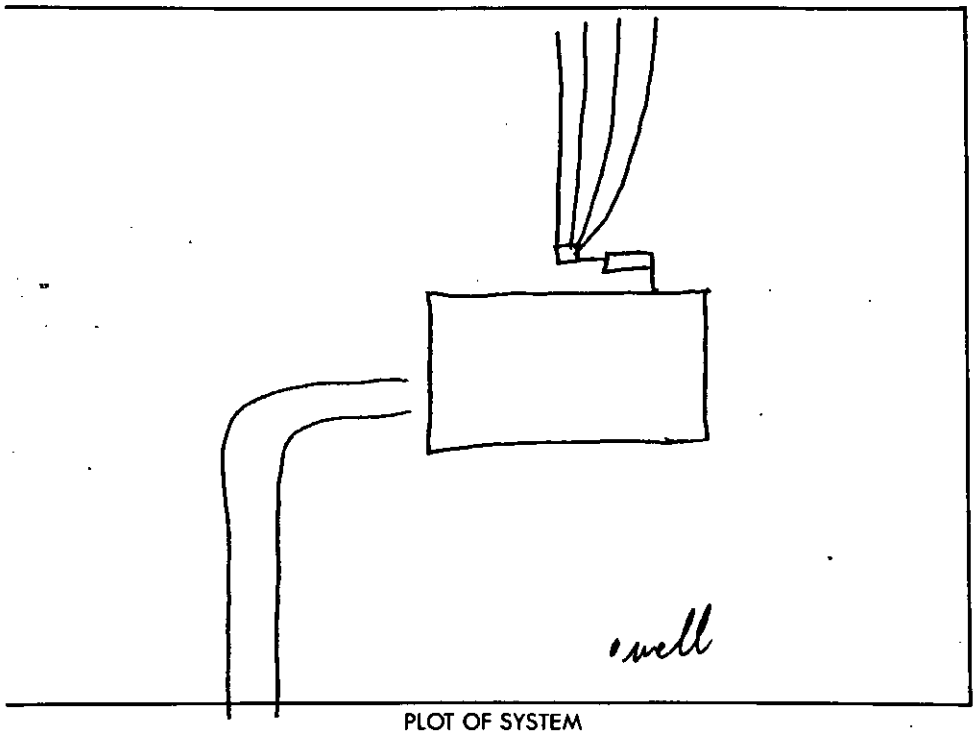

PLOT OF SYSTEM

Liquid Capacity of Septic Tank 1500 gallons
Liquid Capacity of Dosing Tank _____ gallons
Tank Construction PCC

Absorption and/or Nitrification Lines:
Trench Width 3 feet
Total Line Length 400 feet
Number of Lines 4
Depth of Stone 12 inches
Distance from House 5 feet
Distance from Property Line 10 feet
Distance from Well > 50 feet

NAME OF OWNER W. K. Bladden Co.
LOCATION OF PROPERTY 10008 Robinson Church Rd
Comments: 4 lines 3'x100'x12" stone

Division or Section Head

B. R. Ferguson
Environmentalist

* If this permit is for the installation or construction of a new system, it must be signed by the division or a section head of the Department of Environmental Health in order to be valid. Only the signature of the Environmentalist is required where an existing system is being altered or repaired.

WHITE - ENVIRONMENTAL HEALTH DEPARTMENT'S COPY ● CANARY - ENVIRONMENTALIST'S COPY ● PINK - OWNER OR AGENTS COPY

MECKLENBURG COUNTY ENVIRONMENTAL HEALTH
SITE EVALUATION REPORT
SERIAL NUMBER 13172

File: 2464A

Parcel: 10810107 PO

Action 4

☐ PC

Location: Robinson Church Road

Subdivision:


Lot: Lot 3 Block: Acres: .77

Owner: Charlie Helms Builders, Inc.
Address: 7907 Albemarle Road
Charlotte, NC 28212

Comments: _____

Described by: W. B. Ramsey

Date: 10-7-86

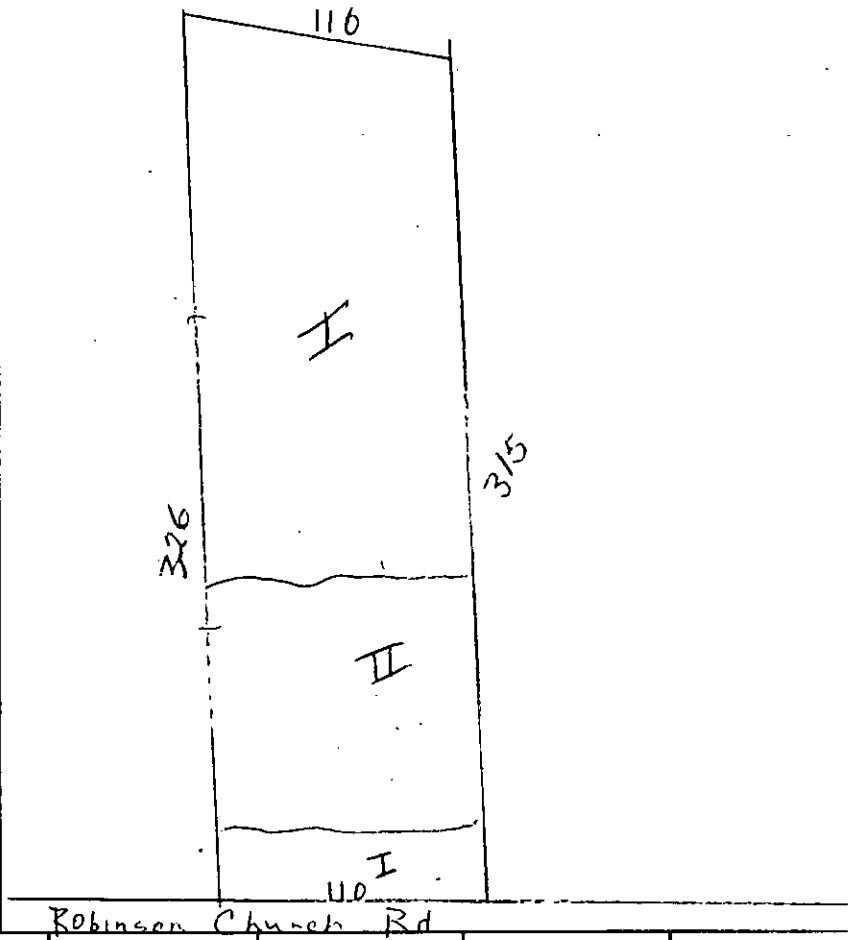

***** EVALUATION KEY *****

S = Suitable U = Unsuitable
PS = Provisionally Suitable
The "Area Classification" below indicates the suitability of areas in the diagram.

FACTORS	AREA 1	AREA 2	AREA 3	AREA 4	AREA 5	AREA 6
Topography	S (PS) U 2-4	S PS (U) Ditched-Old Mined Area	S PS U	S PS U	S PS U	S PS U
Texture	S (PS) U	S (PS) U	S PS U	S PS U	S PS U	S PS U
Structure	S (PS) U	S (PS) U	S PS U	S PS U	S PS U	S PS U
Drainage	S (PS) U	S (PS) U	S PS U	S PS U	S PS U	S PS U
Depth	S (PS) U 45-+72"	S PS (U) 0-40	S PS U	S PS U	S PS U	S PS U
Restrictive Horizons	S (PS) U	S (PS) U	S PS U	S PS U	S PS U	S PS U
Available Space	S (PS) U	S PS (U)	S PS U	S PS U	S PS U	S PS U
Other (specify)	S PS U	S PS U	S PS U	S PS U	S PS U	S PS U
Soil Group/Series	IIa Cecil	IIa Cecil				
Area Classification	S (PS) U	S PS (U)	S PS U	S PS U	S PS U	S PS U

PROPOSED PLOT PLAN


MECKLENBURG COUNTY · ENVIRONMENTAL HEALTH ·

1200 BLYTHE BOULEVARD
CHARLOTTE, NC 28203
PHONE (704) 376-4603

FILE: 2464-A

TC: _____

Draw in and name all roads adjoining the property. Draw in and accurately dimension the lot concerned. Accurately indicate property boundaries, proposed and/or existing structures and driveways, underground utilities, and wells and springs within 100 feet of the proposed building or drainfield.

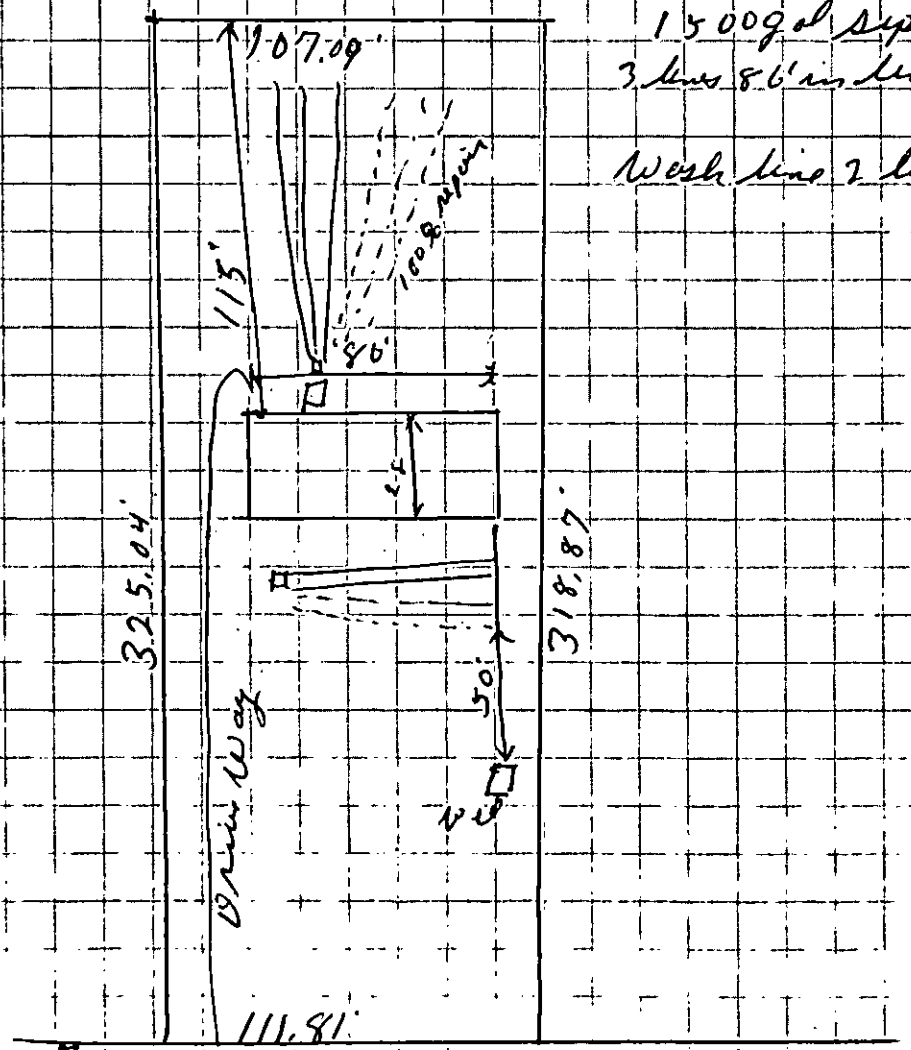

Signed: W. K. Madden

Date: 11-14-86

8:47 Clay Hucks ✓

9:02 Pam 533 5300

10:08 Veronica McBroom
563 2110 - questions on water Grainfield